

# **Annex A**


**ATHLETICS**

**STADIUM**

**AS-BUILT**

**MECHANICAL PLANS**

LEGEND AND SYMBOLS

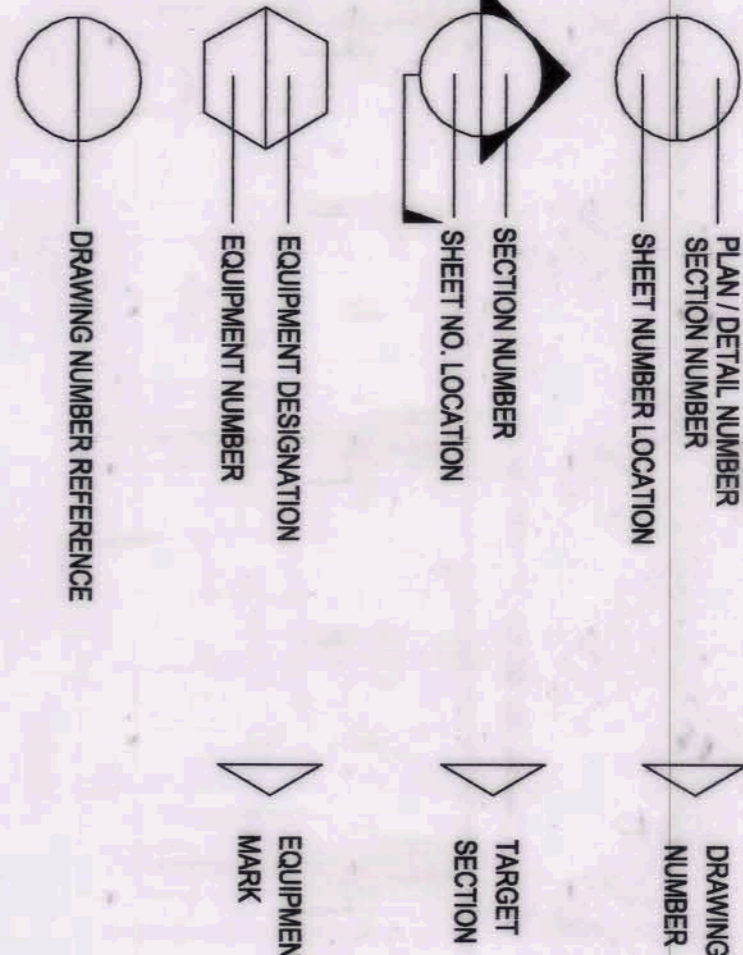

1 PERSPECTIVE  
MO-00 SCALE: NTS

TABLE OF CONTENTS


SHEET NUMBER	SHEET TITLE
MO-00	TABLE OF CONTENTS, VICINITY MAP, SITE DEV PLAN, LEGENDS & SYMBOLS, & MECHANICAL ABBREVIATIONS
M-01	EQUIPMENT SCHEDULE
M-02	EQUIPMENT SCHEDULE
M-03	EQUIPMENT SCHEDULE
M-04	EQUIPMENT SCHEDULE
M-01	GROUND FLOOR AC & VENTILATION LAYOUT
M-01A	NORTH EAST GROUND FLOOR AC & VENTILATION LAYOUT
M-01B	EAST GROUND FLOOR AC & VENTILATION LAYOUT
M-01C	SOUTH EAST GROUND FLOOR AC & VENTILATION LAYOUT
M-01D	SOUTH WEST GROUND FLOOR AC & VENTILATION LAYOUT
M-01E	WEST GROUND FLOOR AC & VENTILATION LAYOUT
M-01F	NORTH WEST GROUND FLOOR AC & VENTILATION LAYOUT
M-02	WEST SECOND FLOOR AC & VENTILATION LAYOUT
M-03	WEST THIRD FLOOR AC & VENTILATION LAYOUT
M-01	UTILITIES BUILDING VENTILATION & FUEL OIL PIPING LAYOUT
M-01	FUEL SYSTEM SCHEMATIC DIAGRAM (SOUTH WEST)
M-02	FUEL SYSTEM SCHEMATIC DIAGRAM (NORTH EAST)
M-01	CROSS SECTION
M-01	ELEVATOR LAYOUT AND SECTION
M-01	REFRIGERANT PIPING SCHEMATIC DIAGRAM
M-02	REFRIGERANT PIPING SCHEMATIC DIAGRAM
M-03	REFRIGERANT PIPING SCHEMATIC DIAGRAM
M-01	MISCELLANEOUS DETAILS
M-02	MISCELLANEOUS DETAILS

MECHANICAL ABBREVIATIONS

ACCU	AIR COOLED CONDENSING UNIT	KG	KILOGRAM
BTUH	BRITISH THERMAL UNITS PER HOUR	KWH	KITCHEN RANGE HOOD
*CDB	*CELDUS DRY BULB	KW	KILOWATT
CFM	CUBIC FEET PER MINUTE	LD	LOUVERED DOOR
CMH	CUBIC METER PER HOUR	M/MIN	CUBIC METER PER MINUTE
dB(A)	DECIBEL	MS	METER PER SECOND
EF	EXHAUST FAN	MM	MILLIMETER
EAD	EXHAUST AIR DUCT	RPM	REVOLUTION PER MINUTE
EAG	EXHAUST AIR GRILLE	RAG	RETURN AIR GRILLE
ERV	ENERGY RECOVERY VENTILATION	SAD	SUPPLY AIR DUCT
ESP	EXTERNAL STATIC PRESSURE	SAG	SUPPLY AIR GRILLE
FCU	FAN COIL UNIT	SQM	SQUARE METER
FAF	FRESH AIR FAN	TD	TRANSFER DUCT
FAD	FRESH AIR DUCT	TEF	TOILET EXHAUST FAN
FAG	FRESH AIR GRILLE	TR	TONS OF REFRIGERATION
FA	FRESH AIR INTAKE	VO	VOLUME DAMPER
FT	FEET	V/PHHZ	VOLTPHASE/HERTZ
HMMO	HEIGHT X WIDTH X DEPTH	VAV	VARIABLE REFRIGERANT VOLUME
KCAL/H	KILOCALORE/HOUR	W	WATTS

GENERAL SPECIFICATIONS:

- THE BRAND AND MODEL OF THE LISTED EQUIPMENT ARE USED ONLY TO ESTABLISH THE DIMENSIONS AND ELECTRICAL LOAD RATINGS FOR THE PURPOSE OF LOCATION AND ELECTRICAL POWER FEED SIZING. THE EQUIPMENT SUPPLIER AND/OR CONTRACTOR ARE ENCOURAGED TO PROVIDE OTHER BRANDS AND MODELS OF HIGHER EFFICIENCY. DURING THE SITE MOBILIZATION AND EARLY START OF CONSTRUCTION, THE MECHANICAL VENTILATION AND AIR CONDITIONING (MVAC) THE POWER PROVISIONS.
- THE OUTDOOR UNITS SUCH AS ACQUIS, EXHAUST FANS, AND OTHER DEVICE FOR AIR MOVEMENT SHOULD BE LOCATED AT AN AREA WHERE THE AIR MOVEMENT WILL NOT BE OBSTRUCTED. THE DIRECTION OF THE DISCHARGE AIR SHOULD ALLOW DISTANCE FOR THE HEAT & MOISTURE TO DISSIPATE INTO THE ENVIRONMENT WITHOUT ANY POSSIBLE RE-CIRCULATION BACK TO THE BUILDING. THIS ARRANGEMENT IS CRITICAL TO OBTAIN THE HIGHEST PERFORMANCE EFFICIENCY FOR THE INSTALLED AC SYSTEM AND SHALL BE TAKEN AS THE SOLE RESPONSIBILITY OF THE MVAC CONTRACTOR DURING THE CONSTRUCTION STAGE.
- THE MVAC CONTRACTOR SHOULD PROVIDE PIPING FOR EACH FCU WHERE CONDENSATION IS TO BE EXPECTED DUE TO THE NATURE OF OPERATION. THE MVAC CONTRACTOR SHALL ALSO PROVIDE THE INSULATED CONDENSATE PIPE AS WELL AS THE NECESSARY CONNECTION TO THE PLUMBING LINE AT A STUB-OUT THAT MAY BE LOCATED WITHIN 10 FEET OF THE FCU. THE MVAC CONTRACTOR COORDINATE THESE STUB-OUT PROVISIONS WITH THE PLUMBING CONTRACTOR AND MUST ALSO PROVIDE THE NECESSARY VENT AND CLEAN OUT FOR THE REGULAR CLEANING AND MAINTENANCE OF THE CONDENSATE PIPES WITHIN HIS SCOPE.
- EACH FCU SHOULD BE PROVIDED WITH ITS OWN DEDICATED ROOM SPACE TEMPERATURE SENSOR AND THE CORRESPONDING CONTROLS FOR THE AUTOMATIC OPERATION AND CAPACITY MODULATION OF THE INSTALLED AC SYSTEM SERVING THAT PARTICULAR AREA. THE LOCATION OF THE ACQU AWAY FROM THE FCU MUST BE WITHIN THE DISTANCE AND HEIGHT DIFFERENTIAL SPECIFIED BY THE MANUFACTURER. THE REFRIGERANT PIPE SIZES AND INSULATION MUST COMPLY WITH THE RECOMMENDATIONS OF THE MANUFACTURER.
- THE EXACT LOCATION OF THE FCU, AS WELL AS THE MATCHING ACQUIS SHALL BE COORDINATED WITH THE CLIENT AND HIS DUTY AUTHORIZED REPRESENTATIVES PRIOR TO INSTALLATION. THE LOCATION OF LOUVERS SHALL COMPLY WITH THE ARCHITECTURAL REQUIREMENTS.
- THE MVAC CONTRACTOR SHALL SELECT, SIZE, AND PROVIDE ALL AND ANY MATERIAL, GADGET, DEVICE, OR SUPPORT NECESSARY AND SUITABLE FOR THE EQUIPMENT. THE VIBRATION ISOLATION AND SEISMIC RESTRAINTS SHALL BE CORRECTLY SELECTED AND INSTALLED FOR ALL EQUIPMENT AND SYSTEM COMPONENTS THAT MAY PROVIDE SUCH EFFECT DUE TO THEIR MOVING PARTS OR BECAUSE OF RESONANCE OR TRANSMISSION OF SUCH MECHANICAL FORCE.
- ALL REFRIGERANT PIPING, PLUMBING, AND ELECTRICAL CONDUITS SHOULD BE PROPERLY LAID OUT AND INSTALLED WITHOUT AFFECTING THE AESTHETIC APPEARANCE OF THE BUILDING. INTERIOR AND EXTERIOR, PREFERABLY, THESE ITEMS SHOULD BE CONTAINED INSIDE A PVC MOLDING WITH PAINT FINISH AS APPROVED BY THE ARCHITECT. THE SELECTION OF PAINT COLOR MUST BE APPROVED ALSO BY THE ARCHITECT.
- THE MVAC CONTRACTOR SHALL BE RESPONSIBLE FOR THE CONSTRUCTION OF THE PIPE SLEEVES, FIRE SEALS, STEEL STRUCTURAL PLATFORMS, CONCRETE FOOTINGS AND CORRESPONDING WATER PROOFING RELATED TO HIS INSTALLATION BY RE-PLACEMENTS MUST ALL BE PROPERLY COORDINATED BY THE MVAC CONTRACTOR WITH THE TRADES WHICH COVER SUCH SCOPE.
- THE MVAC CONTRACTOR SHALL BE RESPONSIBLE FOR COORDINATING THE MVAC SYSTEM REQUIREMENTS FROM OTHER TRADES AT THE SOONEST POSSIBLE TIME. SHOULD THE CLIENT DECIDE TO PURCHASE THE EQUIPMENT SEPARATELY, THE MVAC CONTRACTOR MUST REVIEW THE DELINEATION OF WORK BETWEEN THE SUPPLIER AND HIS REMAINING. THE MVAC CONTRACTOR SHALL BE RESPONSIBLE TO PROVIDE ANY AND ALL OTHER ITEMS NECESSARY TO COMPLETE THE INSTALLATION, TESTING, AND COMMISSIONING OF THE OWNER SUPPLIED EQUIPMENT (EXCLUSIVE OF WARRANTY) AND ALL OTHER ITEMS WHICH WOULD NORMALLY BE PART OF HIS SCOPE IF HE SUPPLIES THE EQUIPMENT. THIS IS TO AVOID AND ELIMINATE POSSIBLE GRAY AREA ITEMS.
- THE SELECTION AND SIZING OF THE SYSTEMS ARE BASED ON THE OPERATING HOURS SPECIFIED BY THE CLIENT FOR THE PROJECT. THE CHOICE OF THE INDOOR UNITS MAY DIFFER IF THE APPLICATION OR OPERATING HOURS WILL CHANGE. THE CAPACITY MATCHING WITH THE OUTDOOR UNITS MAY ALSO BE AFFECTED.
- THE MVAC CONTRACTOR SHALL BE RESPONSIBLE FOR THE CONSTRUCTION OF PIPE SLEEVES, FIRE SEALS, AND CORRESPONDING WATER PROOFING RELATED TO HIS INSTALLATION BY THE EARLY EFFECTIVE COORDINATION WITH THE OTHER TRADES WHICH COVER SUCH SCOPE. ALL ACCESS PANELS AND SERVICE CLEARANCES FOR THE PREVENTIVE MAINTENANCE AS WELL AS FOR THE PERIODIC REPAIR AND PARTS REPLACEMENTS MUST ALL BE PROPERLY COORDINATED BY THE MVAC CONTRACTOR WITH THE TRADES WHICH COVER SUCH SCOPE.
- DURING THE SITE MOBILIZATION AND EARLY START OF CONSTRUCTION, THE MVAC CONTRACTOR MUST ASCERTAIN THE ACTUAL ELECTRICAL CHARACTERISTICS (V/PHHZ) THAT WILL BE PROVIDED FOR EACH OF THE MVAC EQUIPMENT. THIS IS TO ENSURE THAT ALL EQUIPMENT TO BE PURCHASED AND SELECTED WILL MATCH WITH THE POWER PROVISIONS.
- THE INTERNATIONAL BUILDING CODE (IBC) 2008 - SECTION 403.4.1 SMOKE PROOF EXIT ENCLOSURES - EVERY REQUIRED LEVEL EXIT STAIRWAY SERVING FLOORS MORE THAN 22 RMW (79FT) ABOVE THE LOWEST LEVEL OF FIRE DEPARTMENT VEHICLE ACCESS SHALL COMPLY WITH SECTIONS 909.20 AND 1002.9 REQUIRING STAIR MECHANICAL PRESSURIZATION SYSTEM.

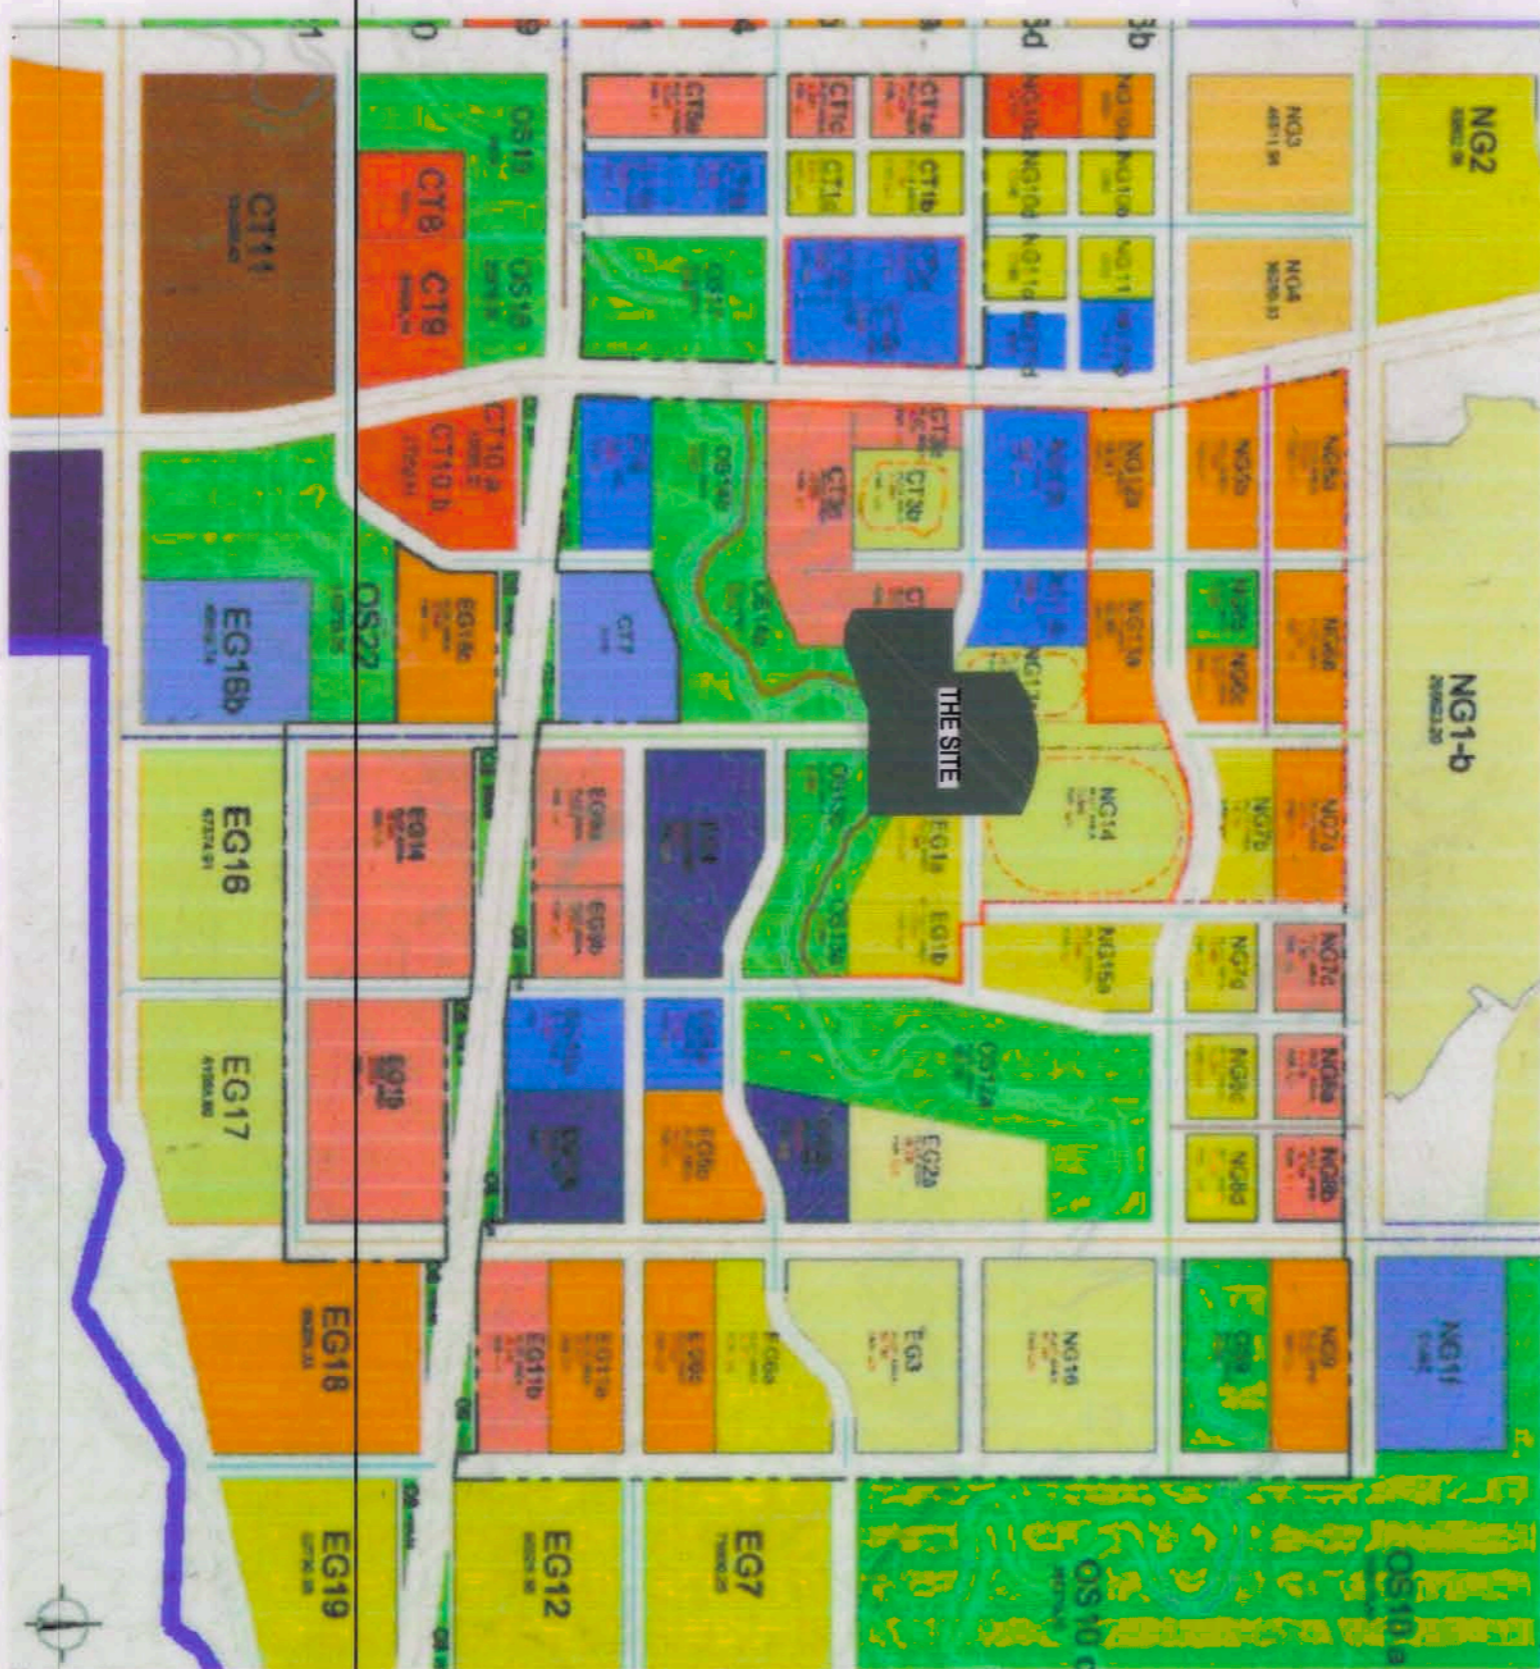

2 VICINITY MAP  
MO-00 SCALE: NTS

MECHANICAL

City / Municipality

LAND USE AND ZONING

LINE AND GRADE

ARCHITECTURAL

STRUCTURAL

SANITARY/PLUMBING

ELECTRICAL

SHEET NO.

PROJECT TITLE:  
AS-BUILT DRAWING  
NGAC PHASE 1A  
ATHLETICS STADIUM  
(MECHANICAL)  
NEW CLARK CITY, CAPAS TARLAC

SHEET CONTENTS:  
TABLE OF CONTENTS/LEGENDS  
& SYMBOLS/MECHANICAL  
ABBREVIATIONS/  
VICINITY MAP/SITE  
DEVELOPMENT

MO-00

OWNER: NGAC PHASE 1A COMPANY

PREPARED BY:

REVIEWED AND VALIDATED BY:

SUBMITTED BY:

CERTIFIED BY: INDEPENDENT CONSULTANT

BCDA  
BANGKOK DEVELOPMENT CORPORATION  
AND  
PATRICK NICHOLAS P. DAVID

HILMAR C'S  
CONSTRUCTION CORPORATION  
ANGELITO L. OLIVERES

FILIPINAS DRAVO CORPORATION  
Architecture & Engineering Consultants  
ALFREDO R. REVILLA

BANDAR HEBAT BUILDERS, INC.  
ISAAC S. DAVID

TCGI ENGINEERS  
VIRGILIO A. MADRAZO

EQUIPMENT SCHEDULE

VRV SYSTEM-GF.A (GROUND FLOOR)

FAN COIL UNIT (FCU) - WALL MOUNTED TYPE			
UNIT DESIGNATION	FOU-GF.A.3	FOU-GF.A.1 & GF.A.2	FOU-GF.A.5, GF.A.6 & GF.A.9, GF.A.10 & GF.A.11
QUANTITY	1	2	7
POWER SUPPLY	TR 0.63 KCAL/H 1,905 BTU/H 7,580	1.50 4,536 18,000	1.87 5,616 22,200
COOLING CAPACITY	TR 0.63 KCAL/H 1,905 BTU/H 7,580	1.50 4,536 18,000	1.87 5,616 22,200
POWER CONSUMPTION	KW 0.017	0.032	0.032
CASING	WHITE (D70X80.5)		
AIR FLOW RATE (HHHL)	M3/MIN 7.54.5 CFM 285.159	15.12 424.318	19.14 530.424
SOUND LEVEL (HL)	DB(A) 31.25	38.33	40.35
DIMENSION (H X W X D)	MM 285X100X277	288X100X243	288X100X243
MACHINE WEIGHT	KG 8.5	12.5	12.5
PIPING CONNECTIONS	LIQUID (FLARE) Ø 6.4 GAS (FLARE) Ø 12.7	Ø 6.4 Ø 12.7	Ø 9.5 Ø 15.3
BRAND:	VP25 (EXTERNAL DIA. 180MM INTERNAL DIA. 15)	VP25 (EXTERNAL DIA. 320MM INTERNAL DIA. 25)	SAMSUNG

FRESH AIR INTAKE (FAI)			
UNIT DESIGNATION	FAI-GF.A.1	FAI-GF.A.2	
QUANTITY	1	1	
LOCATION	GROUND FLOOR		
POWER SOURCE	TR 3.88 KCAL/H 12,045 BTU/H 47,800	3.88 12,000 47,800	
COOLING CAPACITY	TR 3.88 KCAL/H 12,045 BTU/H 47,800		
POWER CONSUMPTION	KW 0.183	0.183	
CASING	WHITE (D70X80.5)		
AIR FLOW RATE (HHHL)	M3/MIN 19.14 CFM 67.1494	14.0 40.5	
SOUND LEVEL (HL)	DB(A) 40.35		
DIMENSION (H X W X D)	MM 288X100X238		
MACHINE WEIGHT	KG 14		
PIPING CONNECTIONS	LIQUID (FLARE) Ø 9.5 GAS (FLARE) Ø 15.3	Ø 15.3	
BRAND:	VP25 (EXTERNAL DIA. 32 INTERNAL DIA. 25)	SAMSUNG	

FAN COIL UNIT (FCU) - WALL MOUNTED TYPE			
UNIT DESIGNATION	FOU-GF.B.1 TO FOU-GF.B.4		
QUANTITY	4		
POWER SUPPLY	TR 1.83 KCAL/H 5,388 BTU/H 22,200		
COOLING CAPACITY	TR 1.83 KCAL/H 5,388 BTU/H 22,200		
POWER CONSUMPTION	KW 0.032		
CASING	WHITE (D70X80.5)		
AIR FLOW RATE (HHHL)	M3/MIN 19.14 CFM 67.1494		
SOUND LEVEL (HL)	DB(A) 40.35		
DIMENSION (H X W X D)	MM 288X100X238		
MACHINE WEIGHT	KG 14		
PIPING CONNECTIONS	LIQUID (FLARE) Ø 9.5 GAS (FLARE) Ø 15.3	Ø 15.3	
BRAND:	VP25 (EXTERNAL DIA. 32 INTERNAL DIA. 25)	SAMSUNG	

FRESH AIR INTAKE (FAI)			
UNIT DESIGNATION	FAI-GF.B		
QUANTITY	1		
LOCATION	GROUND FLOOR		
POWER SOURCE	TR 3.88 KCAL/H 12,045 BTU/H 47,800		
COOLING CAPACITY	TR 3.88 KCAL/H 12,000 BTU/H 47,800		
POWER CONSUMPTION	KW 0.183		
CASING	WHITE (D70X80.5)		
AIR FLOW RATE (HHHL)	M3/MIN 19.14 CFM 67.1494		
SOUND LEVEL (HL)	DB(A) 40.35		
DIMENSION (H X W X D)	MM 288X100X238		
MACHINE WEIGHT	KG 14		
PIPING CONNECTIONS	LIQUID (FLARE) Ø 9.5 GAS (FLARE) Ø 15.3	Ø 15.3	
BRAND:	VP25 (EXTERNAL DIA. 32 INTERNAL DIA. 25)	SAMSUNG	

SPLIT TYPE SYSTEM (GROUND FLOOR)			
SPLIT TYPE FLOOR MOUNTED		FOU-GF.1 TO FOU-GF.8	
UNIT DESIGNATION	INDOOR UNIT	ACOU-GF.1 TO ACOU-GF.8	
QUANTITY		8	
POWER SOURCE	TR 4.05 KCAL/H 14,28 BTU/H 48,814		
COOLING CAPACITY RATED	TR 4.05 KCAL/H 14,28 BTU/H 48,814		
POWER CONSUMPTION	W 5.880		
COP	2.38		
CSFF	4.1		
COLOR	FRESH WHITE		
AIR FLOW RATE (H)	M3/MIN 30.2826		
SOUND PRESSURE LEVEL (HL,SL)	DB(A) 105.9889/118		
DIMENSIONS (H X W X D)	MM 1850X800X350		
MACHINE WEIGHT	KG 47		
CERTIFIED OPERATION RANGE	°CWB 14 TO 25		
COLOR	INDOOR WHITE		
COLL	MICRO CHANNEL		
COMPRESSOR	HERMETICALLY SEALED		
REFRIGERANT CHARGE (R410A)	KG 4.18		
SOUND PRESSURE LEVEL (HL,SL)	DB(A) 14 (CHARGED FOR 30M)		
PIPING CONNECTIONS	INDOOR UNIT MM 20 (O.D. 20.2 X 10.2/20) OUTDOOR UNIT MM 22.5 (O.D. 22.5 X 10.2/20)		
MAX. INTERUNIT PIPING LENGTH	M 50 (EQUIVALENT LENGTH 70M)		
MAX. INSULATION LEVEL DIFFERENCE	M 30		
BRAND:	SAMSUNG		

VRV SYSTEM-GF.C (GROUND FLOOR)

FAN COIL UNIT (FCU) - CEILING MOUNTED CASSETTE (2 WAY FLOW)			
UNIT DESIGNATION	FOU-GF.C.1 TO GF.C.5		
QUANTITY	5		
POWER SUPPLY	TR 1.50 KCAL/H 4,536 BTU/H 18,000		
COOLING CAPACITY	TR 1.50 KCAL/H 4,536 BTU/H 18,000		
POWER CONSUMPTION	KW 0.04 (2)		
CASING	HERMETICALLY SEALED		
AIR FLOW RATE (HHHL)	M3/MIN 98.5 CFM 318.220		
SOUND LEVEL (HL)	DB(A) 34.28		
DIMENSION (H X W X D)	MM 230 X 880 X 575		
MACHINE WEIGHT	KG 21		
PIPING CONNECTIONS	LIQUID (FLARE) Ø 6.4 GAS (FLARE) Ø 12.7		
BRAND:	VP25 (EXTERNAL DIA. 320MM INTERNAL DIA. 25)	SAMSUNG	

VRV SYSTEM-GF.D (GROUND FLOOR)

FAN COIL UNIT (FCU) - CEILING MOUNTED CASSETTE (2 WAY FLOW)			
UNIT DESIGNATION	FOU-GF.D.1 TO GF.D.5		
QUANTITY	5		
POWER SUPPLY	TR 1.50 KCAL/H 4,536 BTU/H 18,000		
COOLING CAPACITY	TR 1.50 KCAL/H 4,536 BTU/H 18,000		
POWER CONSUMPTION	KW 0.04 (2)		
CASING	HERMETICALLY SEALED		
AIR FLOW RATE (HHHL)	M3/MIN 98.5 CFM 318.220		
SOUND LEVEL (HL)	DB(A) 34.28		
DIMENSION (H X W X D)	MM 230 X 880 X 575		
MACHINE WEIGHT	KG 21		
PIPING CONNECTIONS	LIQUID (FLARE) Ø 6.4 GAS (FLARE) Ø 12.7		
BRAND:	VP25 (EXTERNAL DIA. 320MM INTERNAL DIA. 25)	SAMSUNG	

SPLIT TYPE SYSTEM-MDF, TELCO&FCC ROOM(GROUND FLOOR)

SPLIT TYPE WALL MOUNTED			
UNIT DESIGNATION	INDOOR UNIT	FOU-GF.1 & FOU-GF.2	
QUANTITY		2	
POWER SOURCE	TR 3.5 KCAL/H 12,000 BTU/H 41,000		
COOLING CAPACITY RATED	TR 3.5 KCAL/H 12,000 BTU/H 41,000		
POWER CONSUMPTION	W 5.880		
COP	2.38		
COLOR	PURE WHITE		
AIR FLOW RATE (H)	M3/MIN 30.2826		
SOUND PRESSURE LEVEL (HL,SL)	DB(A) 105.9889/118		
DIMENSIONS (H X W X D)	MM 1850X800X350		
MACHINE WEIGHT	KG 47		
CERTIFIED OPERATION RANGE	°CWB 14 TO 25		
COLOR	INDOOR WHITE		
COLL	MICRO CHANNEL		
COMPRESSOR	HERMETICALLY SEALED		
REFRIGERANT CHARGE (R410A)	KG 4.18		
SOUND PRESSURE LEVEL (HL,SL)	DB(A) 14 (CHARGED FOR 30M)		
PIPING CONNECTIONS	INDOOR UNIT MM 20 (O.D. 20.2 X 10.2/20) OUTDOOR UNIT MM 22.5 (O.D. 22.5 X 10.2/20)		
MAX. INTERUNIT PIPING LENGTH	M 50 (EQUIVALENT LENGTH 70M)		
MAX. INSULATION LEVEL DIFFERENCE	M 30		
BRAND:	SAMSUNG		

EQUIPMENT SCHEDULE

VRV SYSTEM-2F.A (2F FLOOR)

FAN COIL UNIT (FCU) - WALL MOUNTED TYPE				FAN COIL UNIT (FCU) - CEILING MOUNTED CASSETTE (2 WAY FLOW)			
UNIT DESIGNATION	FOU-2F-A.1	FOU-2F-A.3	FOU-2F-A.3 TO 2F-A.4	UNIT DESIGNATION	FOU-2F-A.10 TO FOU-2F-A.12	UNIT DESIGNATION	UNIT DESIGNATION
QUANTITY	2	5	2	QUANTITY	3	1	2ND FLOOR
POWER SUPPLY	TR 1.80	1.67	1.93	POWER SUPPLY	TR 1.50	TR 7.98	1PH120V/60HZ
COOLING CAPACITY	KCAL 4,536	5,060	5,536	COOLING CAPACITY	KCAL 4,536	BTU/H 85,500	
	BTU/H 18,000	20,000	23,200		BTU/H 18,000	28,02	
POWER CONSUMPTION	KW 5.28	5.90	6.80	POWER CONSUMPTION	KW 5.28	0.40	
CASING	0.032	0.032	0.032	CASING	0.014 (2)	35	
AIRFLOW RATE	M3/MIN 129	1512	1914	AIRFLOW RATE	M3/MIN 96.5	1,236	
(HHHL)	CFM 424318	530424	671494	(HHHL)	CFM 318/230	267	
SOUND LEVEL (HL)	dB(A) 39/33	42/37	47/41	SOUND LEVEL (HL)	dB(A) 38/35	UNNOISE CLOTH FILTER (LONG LIFE)	
DIMENSION (HxWxD)	MM 288X1065X243	288X1065X243	288X1060X243	DIMENSION (H x W x D)	MM 880X230X575		
MACHINE WEIGHT	KG 12.5	12.5	12.5	MACHINE WEIGHT	KG 21	47	
PIPING CONNECTIONS	LIQUID (FLARE) Ø 6.4	Ø 6.4	Ø 9.5	LIQUID (FLARE) Ø 6.4	Ø 6.4	123	
	GAS (FLARE) Ø 12.7	Ø 12.7	Ø 15.9	GAS (BRAZING) Ø 12.7	Ø 12.7	Ø 9.5	
	DRAIN MM VP25 EXTERNAL DIA. 32/INTERNAL DIA. 25)			DRAIN MM VP25 EXTERNAL DIA. 32/ INTERNAL DIA. 25)	Ø 12.7	Ø 22.2	
BRAND:	SAMSUNG	SAMSUNG	SAMSUNG	BRAND:	SAMSUNG	SAMSUNG	SAMSUNG

FAN COIL UNIT (FCU) - CEILING MOUNTED CASSETTE (2 WAY FLOW)				FAN COIL UNIT (FCU) - WALL MOUNTED TYPE			
UNIT DESIGNATION	FOU-2F-B.1 TO 2F-B.3	FOU-2F-B.4	FOU-2F-B.5	UNIT DESIGNATION	FOU-2F-B.1 TO 2F-B.3	UNIT DESIGNATION	UNIT DESIGNATION
QUANTITY	3	1	1	QUANTITY	1	1	8
POWER SUPPLY	TR 1.50	1.67	1.93	POWER SUPPLY	TR 1.50	1.67	1PH120V/60HZ
COOLING CAPACITY	KCAL 4,536	5,060	5,536	COOLING CAPACITY	KCAL 4,536	5,060	
	BTU/H 18,000	20,000	23,200		BTU/H 18,000	23,200	
POWER CONSUMPTION	KW 5.28	5.90	7.00	POWER CONSUMPTION	KW 5.28	7.00	
CASING	0.014 (2)	0.032	0.032	CASING	0.014 (2)	0.032	
AIRFLOW RATE	M3/MIN 96.5	1512	1914	AIRFLOW RATE	M3/MIN 96.5	1512	
(HHHL)	CFM 318/230	530424	671494	(HHHL)	CFM 318/230	530424	
SOUND LEVEL (HL)	dB(A) 38/35	39/33	47/41	SOUND LEVEL (HL)	dB(A) 38/35	39/33	
DIMENSION (H x W x D)	MM 880X230X575	288X1065X243	288X1065X243	DIMENSION (H x W x D)	MM 288X1065X243	288X1065X243	
MACHINE WEIGHT	KG 21	12.50	12.50	MACHINE WEIGHT	KG 12.50	12.50	
PIPING CONNECTIONS	LIQUID (FLARE) Ø 6.4	Ø 6.4	Ø 9.5	LIQUID (FLARE) Ø 6.4	Ø 6.4	Ø 9.5	
	GAS (FLARE) Ø 12.7	Ø 12.7	Ø 15.9	GAS (FLARE) Ø 12.7	Ø 12.7	Ø 15.9	
	DRAIN MM VP25 EXTERNAL DIA. 32/ INTERNAL DIA. 25)			DRAIN MM VP25 EXTERNAL DIA. 32/ INTERNAL DIA. 25)			
BRAND:	SAMSUNG	SAMSUNG	SAMSUNG	BRAND:	SAMSUNG	SAMSUNG	SAMSUNG

FAN COIL UNIT (FCU) - CEILING MOUNTED CASSETTE (ROUND FLOW)				FAN COIL UNIT (FCU) - WALL MOUNTED TYPE			
UNIT DESIGNATION	FOU-2F-B.6 TO 2F-B.13	FOU-2F-B.14	FOU-2F-B.5	UNIT DESIGNATION	FOU-2F-B.1 TO 2F-B.3	UNIT DESIGNATION	UNIT DESIGNATION
QUANTITY	8	1	1	QUANTITY	1	1	8
POWER SUPPLY	TR 2.00	1.67	1.93	POWER SUPPLY	TR 1.50	1.67	1PH120V/60HZ
COOLING CAPACITY	KCAL 6,048	5,060	5,536	COOLING CAPACITY	KCAL 4,536	5,060	
	BTU/H 24,000	20,000	23,200		BTU/H 18,000	23,200	
POWER CONSUMPTION	KW 7.00	5.90	7.00	POWER CONSUMPTION	KW 5.28	7.00	
CASING	0.066	0.032	0.032	CASING	0.014 (2)	0.032	
AIRFLOW RATE	M3/MIN 161/13.5	1512	1914	AIRFLOW RATE	M3/MIN 96.5	1,236	
(HHHL)	CFM 565/388	530424	671494	(HHHL)	CFM 318/230	267	
SOUND LEVEL (HL)	dB(A) 38/32	39/33	47/41	SOUND LEVEL (HL)	dB(A) 38/35	UNNOISE CLOTH FILTER (LONG LIFE)	
DIMENSION (H x W x D)	MM 1000 x 86 x 1000	288X1065X243	288X1065X243	DIMENSION (H x W x D)	MM 880X230X575		
MACHINE WEIGHT	KG 21.00	12.50	12.50	MACHINE WEIGHT	KG 21	47	
PIPING CONNECTIONS	LIQUID (FLARE) Ø 9.52	Ø 6.4	Ø 9.5	LIQUID (FLARE) Ø 6.4	Ø 6.4	123	
	GAS (FLARE) Ø 15.9	Ø 12.7	Ø 15.9	GAS (BRAZING) Ø 12.7	Ø 12.7	Ø 9.5	
	DRAIN MM VP25 EXTERNAL DIA. 32/INTERNAL DIA. 25)			DRAIN MM VP25 EXTERNAL DIA. 32/ INTERNAL DIA. 25)	Ø 12.7	Ø 22.2	
BRAND:	SAMSUNG	SAMSUNG	SAMSUNG	BRAND:	SAMSUNG	SAMSUNG	SAMSUNG

VRV SYSTEM-2F.B (2F FLOOR)

FAN COIL UNIT (FCU) - CEILING MOUNTED CASSETTE (2 WAY FLOW)				FAN COIL UNIT (FCU) - WALL MOUNTED TYPE			
UNIT DESIGNATION	FOU-2F-B.1 TO 2F-B.3	FOU-2F-B.4	FOU-2F-B.5	UNIT DESIGNATION	FOU-2F-B.1 TO 2F-B.3	UNIT DESIGNATION	UNIT DESIGNATION
QUANTITY	3	1	1	QUANTITY	1	1	8
POWER SUPPLY	TR 1.50	1.67	1.93	POWER SUPPLY	TR 1.50	1.67	1PH120V/60HZ
COOLING CAPACITY	KCAL 4,536	5,060	5,536	COOLING CAPACITY	KCAL 4,536	5,060	
	BTU/H 18,000	20,000	23,200		BTU/H 18,000	23,200	
POWER CONSUMPTION	KW 5.28	5.90	7.00	POWER CONSUMPTION	KW 5.28	7.00	
CASING	0.014 (2)	0.032	0.032	CASING	0.014 (2)	0.032	
AIRFLOW RATE	M3/MIN 96.5	1512	1914	AIRFLOW RATE	M3/MIN 96.5	1,236	
(HHHL)	CFM 318/230	530424	671494	(HHHL)	CFM 318/230	267	
SOUND LEVEL (HL)	dB(A) 38/35	39/33	47/41	SOUND LEVEL (HL)	dB(A) 38/35	UNNOISE CLOTH FILTER (LONG LIFE)	
DIMENSION (H x W x D)	MM 880X230X575	288X1065X243	288X1065X243	DIMENSION (H x W x D)	MM 288X1065X243	288X1065X243	
MACHINE WEIGHT	KG 21	12.50	12.50	MACHINE WEIGHT	KG 12.50	12.50	
PIPING CONNECTIONS	LIQUID (FLARE) Ø 6.4	Ø 6.4	Ø 9.5	LIQUID (FLARE) Ø 6.4	Ø 6.4	Ø 9.5	
	GAS (FLARE) Ø 12.7	Ø 12.7	Ø 15.9	GAS (FLARE) Ø 12.7	Ø 12.7	Ø 15.9	
	DRAIN MM VP25 EXTERNAL DIA. 32/ INTERNAL DIA. 25)			DRAIN MM VP25 EXTERNAL DIA. 32/ INTERNAL DIA. 25)			
BRAND:	SAMSUNG	SAMSUNG	SAMSUNG	BRAND:	SAMSUNG	SAMSUNG	SAMSUNG

FAN COIL UNIT (FCU) - CEILING MOUNTED CASSETTE (ROUND FLOW)				FAN COIL UNIT (FCU) - WALL MOUNTED TYPE			
UNIT DESIGNATION	FOU-2F-B.6 TO 2F-B.13	FOU-2F-B.14	FOU-2F-B.5	UNIT DESIGNATION	FOU-2F-B.1 TO 2F-B.3	UNIT DESIGNATION	UNIT DESIGNATION
QUANTITY	8	1	1	QUANTITY	1	1	8
POWER SUPPLY	TR 2.00	1.67	1.93	POWER SUPPLY	TR 1.50	1.67	1PH120V/60HZ
COOLING CAPACITY	KCAL 6,048	5,060	5,536	COOLING CAPACITY	KCAL 4,536	5,060	
	BTU/H 24,000	20,000	23,200		BTU/H 18,000	23,200	
POWER CONSUMPTION	KW 7.00	5.90	7.00	POWER CONSUMPTION	KW 5.28	7.00	
CASING	0.066	0.032	0.032	CASING	0.014 (2)	0.032	
AIRFLOW RATE	M3/MIN 161/13.5	1512	1914	AIRFLOW RATE	M3/MIN 96.5	1,236	
(HHHL)	CFM 565/388	530424	671494	(HHHL)	CFM 318/230	267	
SOUND LEVEL (HL)	dB(A) 38/32	39/33	47/41	SOUND LEVEL (HL)	dB(A) 38/35	UNNOISE CLOTH FILTER (LONG LIFE)	
DIMENSION (H x W x D)	MM 1000 x 86 x 1000	288X1065X243	288X1065X243	DIMENSION (H x W x D)	MM 880X230X575		
MACHINE WEIGHT	KG 21.00	12.50	12.50	MACHINE WEIGHT	KG 21	47	
PIPING CONNECTIONS	LIQUID (FLARE) Ø 9.52	Ø 6.4	Ø 9.5	LIQUID (FLARE) Ø 6.4	Ø 6.4	123	
	GAS (FLARE) Ø 15.9	Ø 12.7	Ø 15.9	GAS (BRAZING) Ø 12.7	Ø 12.7	Ø 9.5	
	DRAIN MM VP25 EXTERNAL DIA. 32/INTERNAL DIA. 25)			DRAIN MM VP25 EXTERNAL DIA. 32/ INTERNAL DIA. 25)	Ø 12.7	Ø 22.2	
BRAND:	SAMSUNG	SAMSUNG	SAMSUNG	BRAND:	SAMSUNG	SAMSUNG	SAMSUNG

AIR COOLED CONDENSING UNIT (ACCU)				ENERGY RECOVERY VENTILATOR (ERV)			
UNIT DESIGNATION	ACCU-2F-A	ERV-2F-A	ERV-2F-A	UNIT DESIGNATION	ERV-2F-A	ERV-2F-A	ERV-2F-A
QUANTITY	2	1	1	QUANTITY	1	1	1
LOCATION	2ND FLOOR	1ST FLOOR	1ST FLOOR	LOCATION	2ND FLOOR	1ST FLOOR	1ST FLOOR
REFRIGERANT	R-410A	R-410A	R-410A	REFRIGERANT	R-410A	R-410A	R-410A
POWER SUPPLY	1PH120V/60HZ	1PH120V/60HZ	1PH120V/60HZ	POWER SUPPLY	1PH120V/60HZ	1PH120V/60HZ	1PH120V/60HZ
AIR FILTER RATE & STATIC PRESSURE	ULTRA-HIGH	ULTRA-HIGH	ULTRA-HIGH	AIR FILTER RATE & STATIC PRESSURE	ULTRA-HIGH	ULTRA-HIGH	ULTRA-HIGH
HEAT EXCHANGER	HEAT EXCHANGER	HEAT EXCHANGER	HEAT EXCHANGER	HEAT EXCHANGER	HEAT EXCHANGER	HEAT EXCHANGER	HEAT EXCHANGER
MODE	LOW	LOW	LOW	MODE	LOW	LOW	LOW
ULTRA-HIGH	ULTRA-HIGH	ULTRA-HIGH	ULTRA-HIGH	ULTRA-HIGH	ULTRA-HIGH	ULTRA-HIGH	ULTRA-HIGH
POWER CONSUMPTION	KW 4.39 (2) + 8.39 (2)	4.39 (2) + 8.39 (2)	4.39 (2) + 8.39 (2)	POWER CONSUMPTION	KW 4.39 (2) + 8.39 (2)	4.39 (2) + 8.39 (2)	4.39 (2) + 8.39 (2)
CAPACITY CONTROL	% 5-100	% 5-100	% 5-100	CAPACITY CONTROL	% 5-100	% 5-100	% 5-100
CASING COLOR	NOIRY WHITE (S77.57)	NOIRY WHITE (S77.57)	NOIRY WHITE (S77.57)	CASING COLOR	NOIRY WHITE (S77.57)	NOIRY WHITE (S77.57)	NOIRY WHITE (S77.57)
MOTOR OUTPUT	0.280 x 2	0.280 x 2	0.280 x 2	MOTOR OUTPUT	0.280 x 2	0.280 x 2	0.280 x 2
SOUND LEVEL (220/230/240V)	dB(A) 38/38.5/39	38/38.5/39	38/38.5/39	SOUND LEVEL (220/230/240V)	dB(A) 38/38.5/39	38/38.5/39	38/38.5/39
TEMP. EXCHANGE EFFICIENCY	% 77.5	% 77.5	% 77.5	TEMP. EXCHANGE EFFICIENCY	% 77.5	% 77.5	% 77.5
ENTHALPY EXCHANGE EFFICIENCY (COOLING)	% 64	% 64	% 64	ENTHALPY EXCHANGE EFFICIENCY (COOLING)	% 64	% 64	% 64
INSULATING MATERIAL	SELF-EXTINGUISHABLE URETHANE FOAM	SELF-EXTINGUISHABLE URETHANE FOAM	SELF-EXTINGUISHABLE URETHANE FOAM	INSULATING MATERIAL	SELF-EXTINGUISHABLE URETHANE FOAM	SELF-EXTINGUISHABLE URETHANE FOAM	SELF-EXTINGUISHABLE URETHANE FOAM
HEAT EXCHANGER SYSTEM	AIR TO AIR CROSS FLOW TOTAL HEAT (LATENT HEAT) EXCHANGER	AIR TO AIR CROSS FLOW TOTAL HEAT (LATENT HEAT) EXCHANGER	AIR TO AIR CROSS FLOW TOTAL HEAT (LATENT HEAT) EXCHANGER	HEAT EXCHANGER SYSTEM	AIR TO AIR CROSS FLOW TOTAL HEAT (LATENT HEAT) EXCHANGER	AIR TO AIR CROSS FLOW TOTAL HEAT (LATENT HEAT) EXCHANGER	AIR TO AIR CROSS FLOW TOTAL HEAT (LATENT HEAT) EXCHANGER
OPERATION RANGE	-5 TO 49	-5 TO 49	-5 TO 49	OPERATION RANGE	-5 TO 49	-5 TO 49	-5 TO 49

AIR COOLED CONDENSING UNIT (ACCU)				ENERGY RECOVERY VENTILATOR (ERV)			
UNIT DESIGNATION	ACCU-2F-B	ERV-2F-B.1	ERV-2F-B.2	UNIT DESIGNATION	ERV-2F-B.1	ERV-2F-B.2	ERV-2F-B.2
QUANTITY	2	1	1	QUANTITY	1	1	1
LOCATION	2ND FLOOR	1ST FLOOR	1ST FLOOR	LOCATION	2ND FLOOR	1ST FLOOR	1ST FLOOR
REFRIGERANT	R-410A	R-410A	R-410A	REFRIGERANT	R-410A	R-410A	R-410A
POWER SUPPLY	1PH120V/60HZ	1PH120V/60HZ	1PH120V/60HZ	POWER SUPPLY	1PH120V/60HZ	1PH120V/60HZ	1PH120V/60HZ
AIR FILTER RATE & STATIC PRESSURE	ULTRA-HIGH	ULTRA-HIGH	ULTRA-HIGH	AIR FILTER RATE & STATIC PRESSURE	ULTRA-HIGH	ULTRA-HIGH	ULTRA-HIGH
HEAT EXCHANGER	HEAT EXCHANGER	HEAT EXCHANGER	HEAT EXCHANGER	HEAT EXCHANGER	HEAT EXCHANGER	HEAT EXCHANGER	HEAT EXCHANGER
MODE	LOW	LOW	LOW	MODE	LOW	LOW	LOW
ULTRA-HIGH	ULTRA-HIGH	ULTRA-HIGH	ULTRA-HIGH	ULTRA-HIGH	ULTRA-HIGH	ULTRA-HIGH	ULTRA-HIGH
POWER CONSUMPTION	KW 4.39 (2) + 8.39 (2)	4.39 (2) + 8.39 (2)	4.39 (2) + 8.39 (2)	POWER CONSUMPTION	KW 4.39 (2) + 8.39 (2)	4.39 (2) + 8.39 (2)	4.39 (2) + 8.39 (2)
CAPACITY CONTROL	% 5-100	% 5-100	% 5-100	CAPACITY CONTROL	% 5-100	% 5-100	% 5-100
CASING COLOR	NOIRY WHITE (S77.57)	NOIRY WHITE (S77.57)	NOIRY WHITE (S77.57)	CASING COLOR	NOIRY WHITE (S77.57)	NOIRY WHITE (S77.57)	NOIRY WHITE (S77.57)
MOTOR OUTPUT	0.280 x 2	0.280 x 2	0.280 x 2	MOTOR OUTPUT	0.280 x 2	0.280 x 2	0.280 x 2
SOUND LEVEL (NOTE 5)	dB(A) 38/38.5/39	38/38.5/39	38/38.5/39	SOUND LEVEL (NOTE 5)	dB(A) 38/38.5/39	38/38.5/39	38/38.5/39
TEMP. EXCHANGE EFFICIENCY	% 77.5	% 77.5	% 77.5	TEMP. EXCHANGE EFFICIENCY	% 77.5	% 77.5	% 77.5
ENTHALPY EXCHANGE EFFICIENCY (COOLING)	% 64	% 64	% 64	ENTHALPY EXCHANGE EFFICIENCY (COOLING)	% 64	% 64	% 64
INSULATING MATERIAL	SELF-EXTINGUISHABLE URETHANE FOAM	SELF-EXTINGUISHABLE URETHANE FOAM	SELF-EXTINGUISHABLE URETHANE FOAM	INSULATING MATERIAL	SELF-EXTINGUISHABLE URETHANE FOAM	SELF-EXTINGUISHABLE URETHANE FOAM	SELF-EXTINGUISHABLE URETHANE FOAM
HEAT EXCHANGER SYSTEM	AIR TO AIR CROSS FLOW TOTAL HEAT (LATENT HEAT) EXCHANGER	AIR TO AIR CROSS FLOW TOTAL HEAT (LATENT HEAT) EXCHANGER	AIR TO AIR CROSS FLOW TOTAL HEAT (LATENT HEAT) EXCHANGER	HEAT EXCHANGER SYSTEM	AIR TO AIR CROSS FLOW TOTAL HEAT (LATENT HEAT) EXCHANGER	AIR TO AIR CROSS FLOW TOTAL HEAT (LATENT HEAT) EXCHANGER	AIR TO AIR CROSS FLOW TOTAL HEAT (LATENT HEAT) EXCHANGER
OPERATION RANGE	-5 TO 49	-5 TO 49	-5 TO 49	OPERATION RANGE	-5 TO 49	-5 TO 49	-5 TO 49

POWER SOURCE		3PH280-415V/60Hz		TR		12.79 + 15.83	
COOLING CAPACITY		KCAL/H		KW		45 + 58	
POWER CONSUMPTION		BTU/H		KW		153,450 + 191,100	
CAPACITY CONTROL		%		%		4.39 (2) + 6.39 (2)	
CASING COLOR		MORY WHITE (97.5%)		FAN TYPE		ULTRA-HIGH	
COMPRESSOR		HERMETICALLY SEALED SCROLL TYPE		MOTOR OUTPUT		AIRFLOW RATE	
AIRFLOW RATE		M3/MIN		MOTOR OUTPUT		STATIC PRESSURE	
DIMENSIONS (H x W x D)		MM		MOTOR OUTPUT		BYPASS MODE	
MACHINE WEIGHT		KG		MOTOR OUTPUT		HEAT EXCHANGER	
SOUND LEVEL		DB(A)		MOTOR OUTPUT		MODE	
OPERATION RANGE		°CDB		MOTOR OUTPUT		BYPASS MODE	
REFRIGERANT		R-410A		MOTOR OUTPUT		ULTRA-HIGH	
CHANGE		KG		MOTOR OUTPUT		HIGH	
LIQUID		MM		MOTOR OUTPUT		LOW	
GAS		MM		MOTOR OUTPUT		ULTRA-HIGH	
BRAND:		SAMSUNG		MOTOR OUTPUT		W	

REFRIGERANT		R-410A		FAN TYPE		ULTRA-HIGH	
CHANGE		KG		MOTOR OUTPUT		STATIC PRESSURE	
LIQUID		MM		MOTOR OUTPUT		BYPASS MODE	
GAS		MM		MOTOR OUTPUT		HEAT EXCHANGER	
BRAND:		SAMSUNG		MOTOR OUTPUT		MODE	

REFRIGERANT		R-410A		FAN TYPE		ULTRA-HIGH	
CHANGE		KG		MOTOR OUTPUT		STATIC PRESSURE	
LIQUID		MM		MOTOR OUTPUT		BYPASS MODE	
GAS		MM		MOTOR OUTPUT		HEAT EXCHANGER	
BRAND:		SAMSUNG		MOTOR OUTPUT		MODE	

EQUIPMENT SCHEDULE

VRV SYSTEM-3F.A (3F FLOOR)

FAN COIL UNIT (FCU) - WALL MOUNTED TYPE									
UNIT DESIGNATION	QUANTITY	FCU-3F-A.3, 3F-A.4, 3F-A.6 & 3F-A.7	FCU-3F-A.2 & 3F-A.5	FCU-3F-A.1					
POWER SUPPLY	4	1PH/208V/230/60HZ	2	1					
COOLING CAPACITY	TR	1.00	1.50	1.67					
	KCAL/h	3,024	4,536	5,060					
	BTU/h	12,000	18,000	20,000					
	KW	3.52	5.30	5.90					
POWER CONSUMPTION	KW	0.017	0.032	0.032					
CASING	WHITE (3.078.50.5)								
AIR FLOW RATE (H/H/L)	M³/MIN	8.5/5.5	12/9	15/12					
CFM		300/194	424/318	530/424					
SOUND LEVEL (H/L)	dB(A)	38/28	39/33	42/27					
DIMENSION (H X W X D)	MM	285X320X227	285X1065X243	285X1065X243					
MACHINE WEIGHT	KG	9.0	12.5	12.5					
PIPING CONNECTIONS	LIQUID (FLARE)	Ø 6.4	Ø 6.4	Ø 6.4					
	GAS (FLARE)	Ø 12.7	Ø 12.7	Ø 12.7					
	DRAIN	MM	Ø 12.7	Ø 12.7					
BRAND:	SAMSUNG								

FAN COIL UNIT (FCU) - CEILING MOUNTED CASSETTE (ROUND FLOW)									
UNIT DESIGNATION	QUANTITY	FCU-3F-A.8							
POWER SUPPLY	1	1PH/208V/230/60HZ							
COOLING CAPACITY	TR	1.50	4.536	5.060					
	KCAL/h	4,536	18,000						
	BTU/h	18,000							
	KW	5.28							
POWER CONSUMPTION	KW	0.085							
CASING	GALVANIZED STEEL PLATE								
AIR FLOW RATE (H/H/L)	M³/MIN	16/13.5/11							
CFM		565/477/388							
SOUND LEVEL (H/L)	dB(A)	33/29							
DIMENSION (H X W X D)	MM	1000X66X1000							
MACHINE WEIGHT	KG	21							
PIPING CONNECTIONS	LIQUID (FLARE)	Ø 6.4							
	GAS (FLARE)	Ø 12.7							
	DRAIN	MM	Ø 12.7						
BRAND:	SAMSUNG								

FRESH AIR INTAKE (FAI)									
UNIT DESIGNATION	QUANTITY	FAI-3F-A.1 & 3F-A.2							
LOCATION	2	3RD FLOOR							
POWER SOURCE	1PH/208V/230V/60HZ								
COOLING CAPACITY	TR	3.88	12.045	47.80					
	KCAL/h	12,045	47,800	14,000					
	BTU/h	47,800	14,000	0.183					
	KW	14.00	0.183						
POWER CONSUMPTION	KW	0.183							
CASING	GALVANIZED STEEL PLATE								
FAN	AIR FLOW RATE ESP	M³/MIN	CFM	Pa					
		219	635						
AIR FILTER	SYNTHETIC FIBER UNWOVEN CLOTH FILTER (LONG LIFE)								
SOUND LEVEL DIMENSIONS (FANX2)	dB(A)	33							
MACHINE WEIGHT	KG	380X1000X900							
PIPE CONNECTIONS	LIQUID (FLARE)	Ø9.5							
	GAS (BRAZING)	Ø15.9							
	DRAIN	Ø12.7							
BRAND:	SAMSUNG								

AIR COOLED CONDENSING UNIT (ACCU)									
UNIT DESIGNATION	QUANTITY	ACCU-3F-A							
POWER SOURCE	2	3PH/380-400V/60HZ							
COOLING CAPACITY	TR	9.55 + 9.55	33.60 + 33.60	28.879 + 28.879					
	KCAL/h			114.576 + 114.576					
	BTU/h			6.39 (2)					
	KW			7.00					
POWER CONSUMPTION	%								
CAPACITY CONTROL									
CASING COLOR									
COMPRESSOR	TYPE	HERMETICALLY SEALED SCROLL TYPE							
AIR FLOW RATE	M³/MIN	6.39 (2)	157+233	169+233					
DIMENSIONS (H X W X D)	MM			(1685X80X765) (2)					
MACHINE WEIGHT	KG			210 + 210					
SOUND LEVEL	dB(A)			61 (2)					
OPERATION RANGE	°CDB			-5 TO 49					
REFRIGERANT	TYPE			R-410A					
CHARGE	KG			6.5+6.5					
LIQUID	MM			Ø 12.7 (BRAZING)					
PIPE CONNECTIONS	GAS			Ø 28.6 (BRAZING)					
BRAND:	SAMSUNG								

VRV SYSTEM-3F.C (3F FLOOR)

FAN COIL UNIT (FCU) - WALL MOUNTED TYPE				FAN COIL UNIT (FCU) - CEILING MOUNTED CASSETTE (ROUND FLOW)				FRESH AIR INTAKE (FAI)				AIR COOLED CONDENSING UNIT (ACCU)			
UNIT DESIGNATION	QUANTITY	FCU-3F C.1 TO 3F C.5	FCU-3F C.6	UNIT DESIGNATION	QUANTITY	FCU-3F C.7 & 3F C.8		UNIT DESIGNATION	QUANTITY	FAI-3F C		UNIT DESIGNATION	QUANTITY	ACCU-3F C	
POWER SUPPLY	1			POWER SUPPLY	2			POWER SOURCE	1			POWER SOURCE	1		
	5							LOCATION	3RD FLOOR						
TR	1PH/220V/240/60HZ			TR	1PH/220V/240/60HZ			TR	3RD FLOOR			TR	14.32		
KCAL/h	1.87			KCAL/h	1.50			KCAL/h	3.88			KW	50.40		
BTU/h	3,024			BTU/h	4,536			BTU/h	12,046			KCAL/h	43,302		
KW	5.90			KW	4.780			KW	14			BTU/h	171,864		
POWER CONSUMPTION	0.032			POWER CONSUMPTION	0.085			POWER CONSUMPTION	0.183			POWER CONSUMPTION	6.39 (2)		
	WHITE (3.078.50.5)			CASING	STEEL PLATE			CASING	STEEL PLATE			CAPACITY CONTROL	%		
AIR FLOW RATE	M³/MIN	8.5/5.5	15/12	AIR FLOW RATE	M³/MIN	15/11		AIR FLOW RATE	M³/MIN	9.0		COMPRESSOR	TYPE		
(H/H/L)	CFM	300/194	530/424	(H/H/L)	CFM	530/388		RATE	CFM	318		MOTOR	KW	6.39 (2)	
SOUND LEVEL (H/L)	dB(A)	38/28	42/37	SOUND LEVEL (H/L)	dB(A)	39/33		ESP	Pa	219		OUTPUT	M³/MIN	157 + 165	
DIMENSION (H X W X D)	MM	285X310X227	285X1065X243	DIMENSION (H X W X D)	MM	1000X66X1000		AIR FILTER		SYNTHETIC FIBER UNWOVEN (CLOTH FILTER (LONG LIFE)			MM	(1.657X1285X765)	
MACHINE WEIGHT	KG	9.0	12.5	MACHINE WEIGHT	KG	21		SOUND LEVEL	dB(A)	33			KG	307	
LIQUID (FLARE)	Ø 6.4			LIQUID (FLARE)	Ø 6.4			DIMENSIONS (HxWxD)	MM	380X1000X900			DB(A)	64	
GAS (FLARE)	Ø 12.7			GAS (FLARE)	Ø 12.7			MACHINE WEIGHT	KG	75			°CDB	-5 TO 49	
PIPING CONNECTIONS	Ø 12.7			PIPING CONNECTIONS	Ø 12.7			LIQUID (FLARE)	Ø 8.5			REFRIGERANT	TYPE	R-410A	
DRAIN	MM			DRAIN	MM			GAS (BRAZING)	Ø 15.9				CHANGE	KG	5.9+6.0
													LIQUID	MM	Ø 15.9 (BRAZING)
													GAS	MM	Ø 28.6 (BRAZING)
BRAND:	SAMSUNG			BRAND:	SAMSUNG			BRAND:	SAMSUNG			BRAND:	SAMSUNG		

VRV SYSTEM-3F.B (3F FLOOR)

FAN COIL UNIT (FCU) - CEILING MOUNTED CASSETTE (ROUND FLOW)				ENERGY RECOVERY VENTILATOR (ERV)			
UNIT DESIGNATION		FCU-3F-B.1 & 3F-B.2		UNIT DESIGNATION		ERV-3F-B	
QUANTITY	2			QUANTITY	1	3RD FLOOR	
POWER SUPPLY	1PH/208V/230/60HZ			LOCATION	2.88	R-401A	
TR		4.00		REFRIGERANT			
KCAL/H		12,000		POWER SUPPLY			
BTU/H		48,000		ULTRA-HIGH		AIR FLOW RATE	
KW		14.07		ULTRA-HIGH		STATIC PRESSURE	
KW		0.97		ULTRA-HIGH		AIR FLOW RATE	
GALVANIZED STEEL PLATE				LOW		STATIC PRESSURE	
AIR FLOW RATE (H/H/L)		32/28/20		HEAT EXCHANGER		W	
CFM		1112.45/947.58		MODE		LOW	
DB(A)		43/32		ULTRA-HIGH		W	
DIMENSION (H X W X D)		1000X66X1000		MODE		LOW	
MACHINE WEIGHT		24		ULTRA-HIGH		W	
GAS (FLARE)		Ø 9.5		BYPASS MODE		W	
LIQUID (FLARE)		Ø 15.9		LOW		LOW	
CONNECTIONS		VP25 EXTERNAL DIA. 32/ INTERNAL DIA. 25		FAN TYPE			
DRAIN		MM		MOTOR OUTPUT			
SAMSUNG				HEAT EXCHANGER			
AIR COOLED CONDENSING UNIT (ACCU)				MODE			
QUANTITY		1		ULTRA-HIGH			
UNIT DESIGNATION		ACCU-3F-B		ULTRA-HIGH			
POWER SOURCE		3PH/380-400V/60HZ		ULTRA-HIGH			
TR		9.54		ULTRA-HIGH			
KW		33.80		ULTRA-HIGH			
KCAL/H		28.846		ULTRA-HIGH			
BTU/H		114.576		ULTRA-HIGH			
KW		6.39		ULTRA-HIGH			
CAPACITY CONTROL		15-100		ULTRA-HIGH			
CASING COLOR		MORRY WHITE (R7.5/1)		ULTRA-HIGH			
TYPE		HERMETICALLY SEALED SCROLL TYPE		ULTRA-HIGH			
MOTOR OUTPUT		5.2 x 1		ULTRA-HIGH			
AIR FLOW RATE		178		ULTRA-HIGH			
DIMENSIONS (H X W X D)		(1.657/2830/765)		ULTRA-HIGH			
MACHINE WEIGHT		210		ULTRA-HIGH			
SOUND LEVEL		62		ULTRA-HIGH			
DB(A)		5 TO 49		ULTRA-HIGH			
OPERATION RANGE		R4-10A		ULTRA-HIGH			
TYPE		R4-10A		ULTRA-HIGH			
CHARGE		6.5		ULTRA-HIGH			
LIQUID		Ø 12.7 (BRZ/ZN)		ULTRA-HIGH			
CONNECTIONS		Ø 28.5 (BRZ/ZN)		ULTRA-HIGH			
GAS		SAMSUNG		ULTRA-HIGH			
BRAND:		SAMSUNG		ULTRA-HIGH			

UNIT DESIGNATION		FCU-3F-B		UNIT DESIGNATION		ERV-3F-B	
QUANTITY	2			QUANTITY	1	3RD FLOOR	
POWER SUPPLY	1PH/208V/230/60HZ			LOCATION	2.88	R-401A	
TR		4.00		REFRIGERANT			
KCAL/H		12,000		POWER SUPPLY			
BTU/H		48,000		ULTRA-HIGH		AIR FLOW RATE	
KW		14.07		ULTRA-HIGH		STATIC PRESSURE	
KW		0.97		ULTRA-HIGH		AIR FLOW RATE	
GALVANIZED STEEL PLATE				LOW		STATIC PRESSURE	
AIR FLOW RATE (H/H/L)		32/28/20		HEAT EXCHANGER		W	
CFM		1112.45/947.58		MODE		LOW	
DB(A)		43/32		ULTRA-HIGH		W	
DIMENSION (H X W X D)		1000X66X1000		MODE		LOW	
MACHINE WEIGHT		24		ULTRA-HIGH		W	
GAS (FLARE)		Ø 9.5		BYPASS MODE		W	
LIQUID (FLARE)		Ø 15.9		LOW		LOW	
CONNECTIONS		VP25 EXTERNAL DIA. 32/ INTERNAL DIA. 25		FAN TYPE			
DRAIN		MM		MOTOR OUTPUT			
SAMSUNG				HEAT EXCHANGER			
AIR COOLED CONDENSING UNIT (ACCU)				MODE			
QUANTITY		1		ULTRA-HIGH			
UNIT DESIGNATION		ACCU-3F-B		ULTRA-HIGH			
POWER SOURCE		3PH/380-400V/60HZ		ULTRA-HIGH			
TR		9.54		ULTRA-HIGH			
KW		33.80		ULTRA-HIGH			
KCAL/H		28.846		ULTRA-HIGH			
BTU/H		114.576		ULTRA-HIGH			
KW		6.39		ULTRA-HIGH			
CAPACITY CONTROL		15-100		ULTRA-HIGH			
CASING COLOR		MORRY WHITE (R7.5/1)		ULTRA-HIGH			
TYPE		HERMETICALLY SEALED SCROLL TYPE		ULTRA-HIGH			
MOTOR OUTPUT		5.2 x 1		ULTRA-HIGH			
AIR FLOW RATE		178		ULTRA-HIGH			
DIMENSIONS (H X W X D)		(1.657/2830/765)		ULTRA-HIGH			
MACHINE WEIGHT		210		ULTRA-HIGH			
SOUND LEVEL		62		ULTRA-HIGH			
DB(A)		5 TO 49		ULTRA-HIGH			
OPERATION RANGE		R4-10A		ULTRA-HIGH			
TYPE		R4-10A		ULTRA-HIGH			
CHARGE		6.5		ULTRA-HIGH			
LIQUID		Ø 12.7 (BRZ/ZN)		ULTRA-HIGH			
CONNECTIONS		Ø 28.5 (BRZ/ZN)		ULTRA-HIGH			
GAS		SAMSUNG		ULTRA-HIGH			
BRAND:		SAMSUNG		ULTRA-HIGH			

EQUIPMENT SCHEDULE

TOILET EXHAUST FANS (TEF) - GROUND FLOOR					
UNIT DESIGNATION	TEF-GF 1, GF 6, GF 7, GF 12, GF 13, GF 18, GF 19, GF 24, GF 25 & GF 30	TEF-GF 2, GF 5, GF 8, GF 11, GF 14, GF 17, GF 20, GF 23, GF 26, GF 29, 3F 3 & 3F 4	TEF-GF 3, GF 4, GF 9, GF 10, GF 15, GF 16, GF 21, GF 22, GF 27 & GF 28	TEF-2F 1 & 2F 2	TEF-3F 1 & 3F 2
QTY.	10	12	10	2	2
LOCATION	GROUND FLOOR	GROUND AND 3RD FLOOR	GROUND FLOOR	2ND FLOOR	3RD FLOOR
POWER SUPPLY (V/PH/Hz)	338-400/3/60	220/1/60	220/1/60	230/1/60	230/1/60
AIR VOLUME (CFM)	COMPUTED	1484	714	495	214
	SELECTED	2648	842	706	390
EXTERNAL STATIC PRESSURE (Pa)	150	160	250	250	200
TYPE	IN-LINE CABINET	CASSETTE	IN-LINE CABINET (CENTRIFUGAL)	IN-LINE CABINET (CENTRIFUGAL)	CASSETTE
CONSUMPTION (KW)	1.45	0.065	0.38	.3	0.065
FAN SPEED (R.P.M)	864	439	1167	1155	509
NOISE db (A)	53.1	42	60.8	60.4	42
WEIGHT (Kg)	80	9.7	24	18	10.4
BRAND:	NIAGARA				

EXHAUST FAN (EF) - UTILITY BUILDING SOUTH WEST					
UNIT DESIGNATION	EF-U 1 & EF-U 2	EF-U 3, EF-U 4 & EF-U 5	EF-U 6 & EF-U 7	EF-U 8, EF-U 9 & EF-U 10	
QTY.	2	3		2	3
LOCATION	METERING VAULT	TRANSFORMER ROOM		LVS	GENSET
POWER SUPPLY (V/PH/Hz)	230 / 1 / 60	230 / 1 / 60		230 / 1 / 60	230 / 1 / 60
AIR VOLUME (CFM)	COMPUTED	1000	8293	2200	8116
	SELECTED	1530	4179	3769	4240
EXTERNAL STATIC PRESSURE (Pa)	10	10	40		40
TYPE	WALL MOUNTED	WALL MOUNTED	WALL MOUNTED	WALL MOUNTED	WALL MOUNTED
CONSUMPTION (KW)	0.17	0.326	0.325		0.326
FAN SPEED (R.P.M)	1400	1575	1400		1575
NOISE db (A)	63	51	54		51
WEIGHT (Kg)	6.1	22.5	19		22.5
BRAND:	NIAGARA				

EXHAUST FANS (EF) - GROUND, SECOND & THIRD FLOOR

UNIT DESIGNATION	EF-GF 1, GF 2, GF 4, & GF 5	EF-GF 13, GF 14, GF 15, GF 16 & 2F 2	EF-GF 12	EF-GF 10, GF 11, & GF 17	EF-2F 1	EF-3F 1
QTY.	5	5	1	3	1	1
LOCATION	GROUND FLOOR	GROUND & 2ND FLOOR	GROUND FLOOR	GROUND FLOOR	2ND FLOOR	3RD FLOOR
POWER SUPPLY (V/PH/Hz)	220/1/60	220/1/60	230/1/60	230/1/60	230/1/60	230/1/60
AIR VOLUME (CFM)	COMPUTED	124	103	252	400	200
	SELECTED	194	230	294	706	365
EXTERNAL STATIC PRESSURE (Pa)	50	80	200	250	200	220
TYPE	CASSETTE	CASSETTE	CASSETTE	IN-LINE CABINET (CENTRIFUGAL)IN-LINE CABINET (CENTRIFUGAL)IN-LINE CABINET (CENTRIFUGAL)		
CONSUMPTION (KW)	0.048	0.065	0.065	0.375	0.128	0.19
FAN SPEED (R.P.M)	760	540	509	1155	997	1058
NOISE db (A)	38	42	42	60.4	56.3	57.8
WEIGHT (Kg)	10.4	5.6	10.4	18	14	18
BRAND:	NIAGARA					

KITCHEN RANGEHOOD (KRH) - THIRD FLOOR

UNIT DESIGNATION	KRH-3F 1				
QTY.	1				
LOCATION	3RD FLOOR				
POWER SUPPLY (V/PH/Hz)	230/1/60				
AIR VOLUME (CFM)	160				
EXTERNAL STATIC PRESSURE (Pa)	100				
TYPE	KITCHEN RANGEHOOD				
CONSUMPTION (KW)	0.127				
FAN SPEED (R.P.M)	905				
NOISE db (A)	38				
WEIGHT (Kg)	18				
BRAND:	NIAGARA				

FRESH AIR FANS (FAF) & EXHAUST FAN (EF) - GROUND FLOOR


UNIT DESIGNATION	FAF-E3.1, FAF-E3.2, EF-E3.1 & EF-E3.2	EF-GF 6 TO EF-GF 9 & FAF-GF 3 TO FAF-GF 6
QTY.		8
LOCATION		GROUND FLOOR
POWER SUPPLY (V/PH/Hz)		380-400 / 3 / 60
AIR VOLUME (CFM)		2648
EXTERNAL STATIC PRESSURE (Pa)		2700
TYPE		VANE AXIAL
CONSUMPTION (KW)		2.20
FAN SPEED (R.P.M)		1750
NOISE db (A)		92
WEIGHT (Kg)		44
BRAND:		NIAGARA

EXHAUST FAN (EF) - UTILITY BUILDING NORTH EAST

UNIT DESIGNATION	EF-U 11, EF-U 12 & EF-U 13	EF-U 14, EF-U 15 & EF-U 16	EF-U 17 & EF-U 18	EF-U 19, EF-U 20 & EF-U 21
QTY.	3	3	2	3
LOCATION	PUMP ROOM	GENSET ROOM	LVS	TRANSFORMER ROOM
POWER SUPPLY (V/PH/Hz)	230 / 1 / 60	230 / 1 / 60	230 / 1 / 60	230 / 1 / 60
AIR VOLUME (CFM)	COMPUTED	7940	8116	2200
	SELECTED	5650	5650	3769
EXTERNAL STATIC PRESSURE (Pa)	40	40	40	40
TYPE	WALL MOUNTED	WALL MOUNTED	WALL MOUNTED	WALL MOUNTED
CONSUMPTION (KW)	0.326	0.326	0.325	0.326
FAN SPEED (R.P.M)	768	768	1400	1575
NOISE db (A)	51	51	54	51
WEIGHT (Kg)	22.5	22.5	19	22.5
BRAND:	NIAGARA			

NOTE:  
EF-GF 1 TO GF 5, EF-U 3 TO U 5, EF-U 8 TO U 16, EF-U 19 TO U 21, EF-E3.1 TO ES2 AND FAF-E3.1 TO ES2  
CHANGE IN CAPACITY DUE TO TCGI COMMENT ON NGAC-AS-ME-05 FAN VENTILATION CALCULATION. RESPONSE ON 11/05/18  
AND TCGI CLOSED FAN VENTILATION CALCULATION ITEM DATE RELEASE 11/20/18.


OWNER: NGAC PHASE 1 JV COMPANY	PREPARED BY:	REVIEWED AND VALIDATED BY:	SUBMITTED BY:	CERTIFIED BY: INDEPENDENT CONSULTANT	PROJECT TITLE:	SHEET CONTENTS:	SHEET NO.
BCDA AND PATRICK NICHOLAS P DAVID	HIL MARC'S CONSTRUCTION CORPORATION ANGELITO L. OLLERES	FILIPINAS DRAVO CORPORATION Architecture & Engineering Consultants ALFREDO R. REVILLA	BANDAR HEBAT BUILDERS, INC. ISAAC S. DAVID	TCGI ENGINEERS VIRGILIO A. MAHRAZO	AS-BUILT DRAWING NGAC PHASE 1A ATHLETICS STADIUM (MECHANICAL) NEW CLARK CITY, CAPAS TARLAC	EQUIPMENT SCHEDULE	M-104

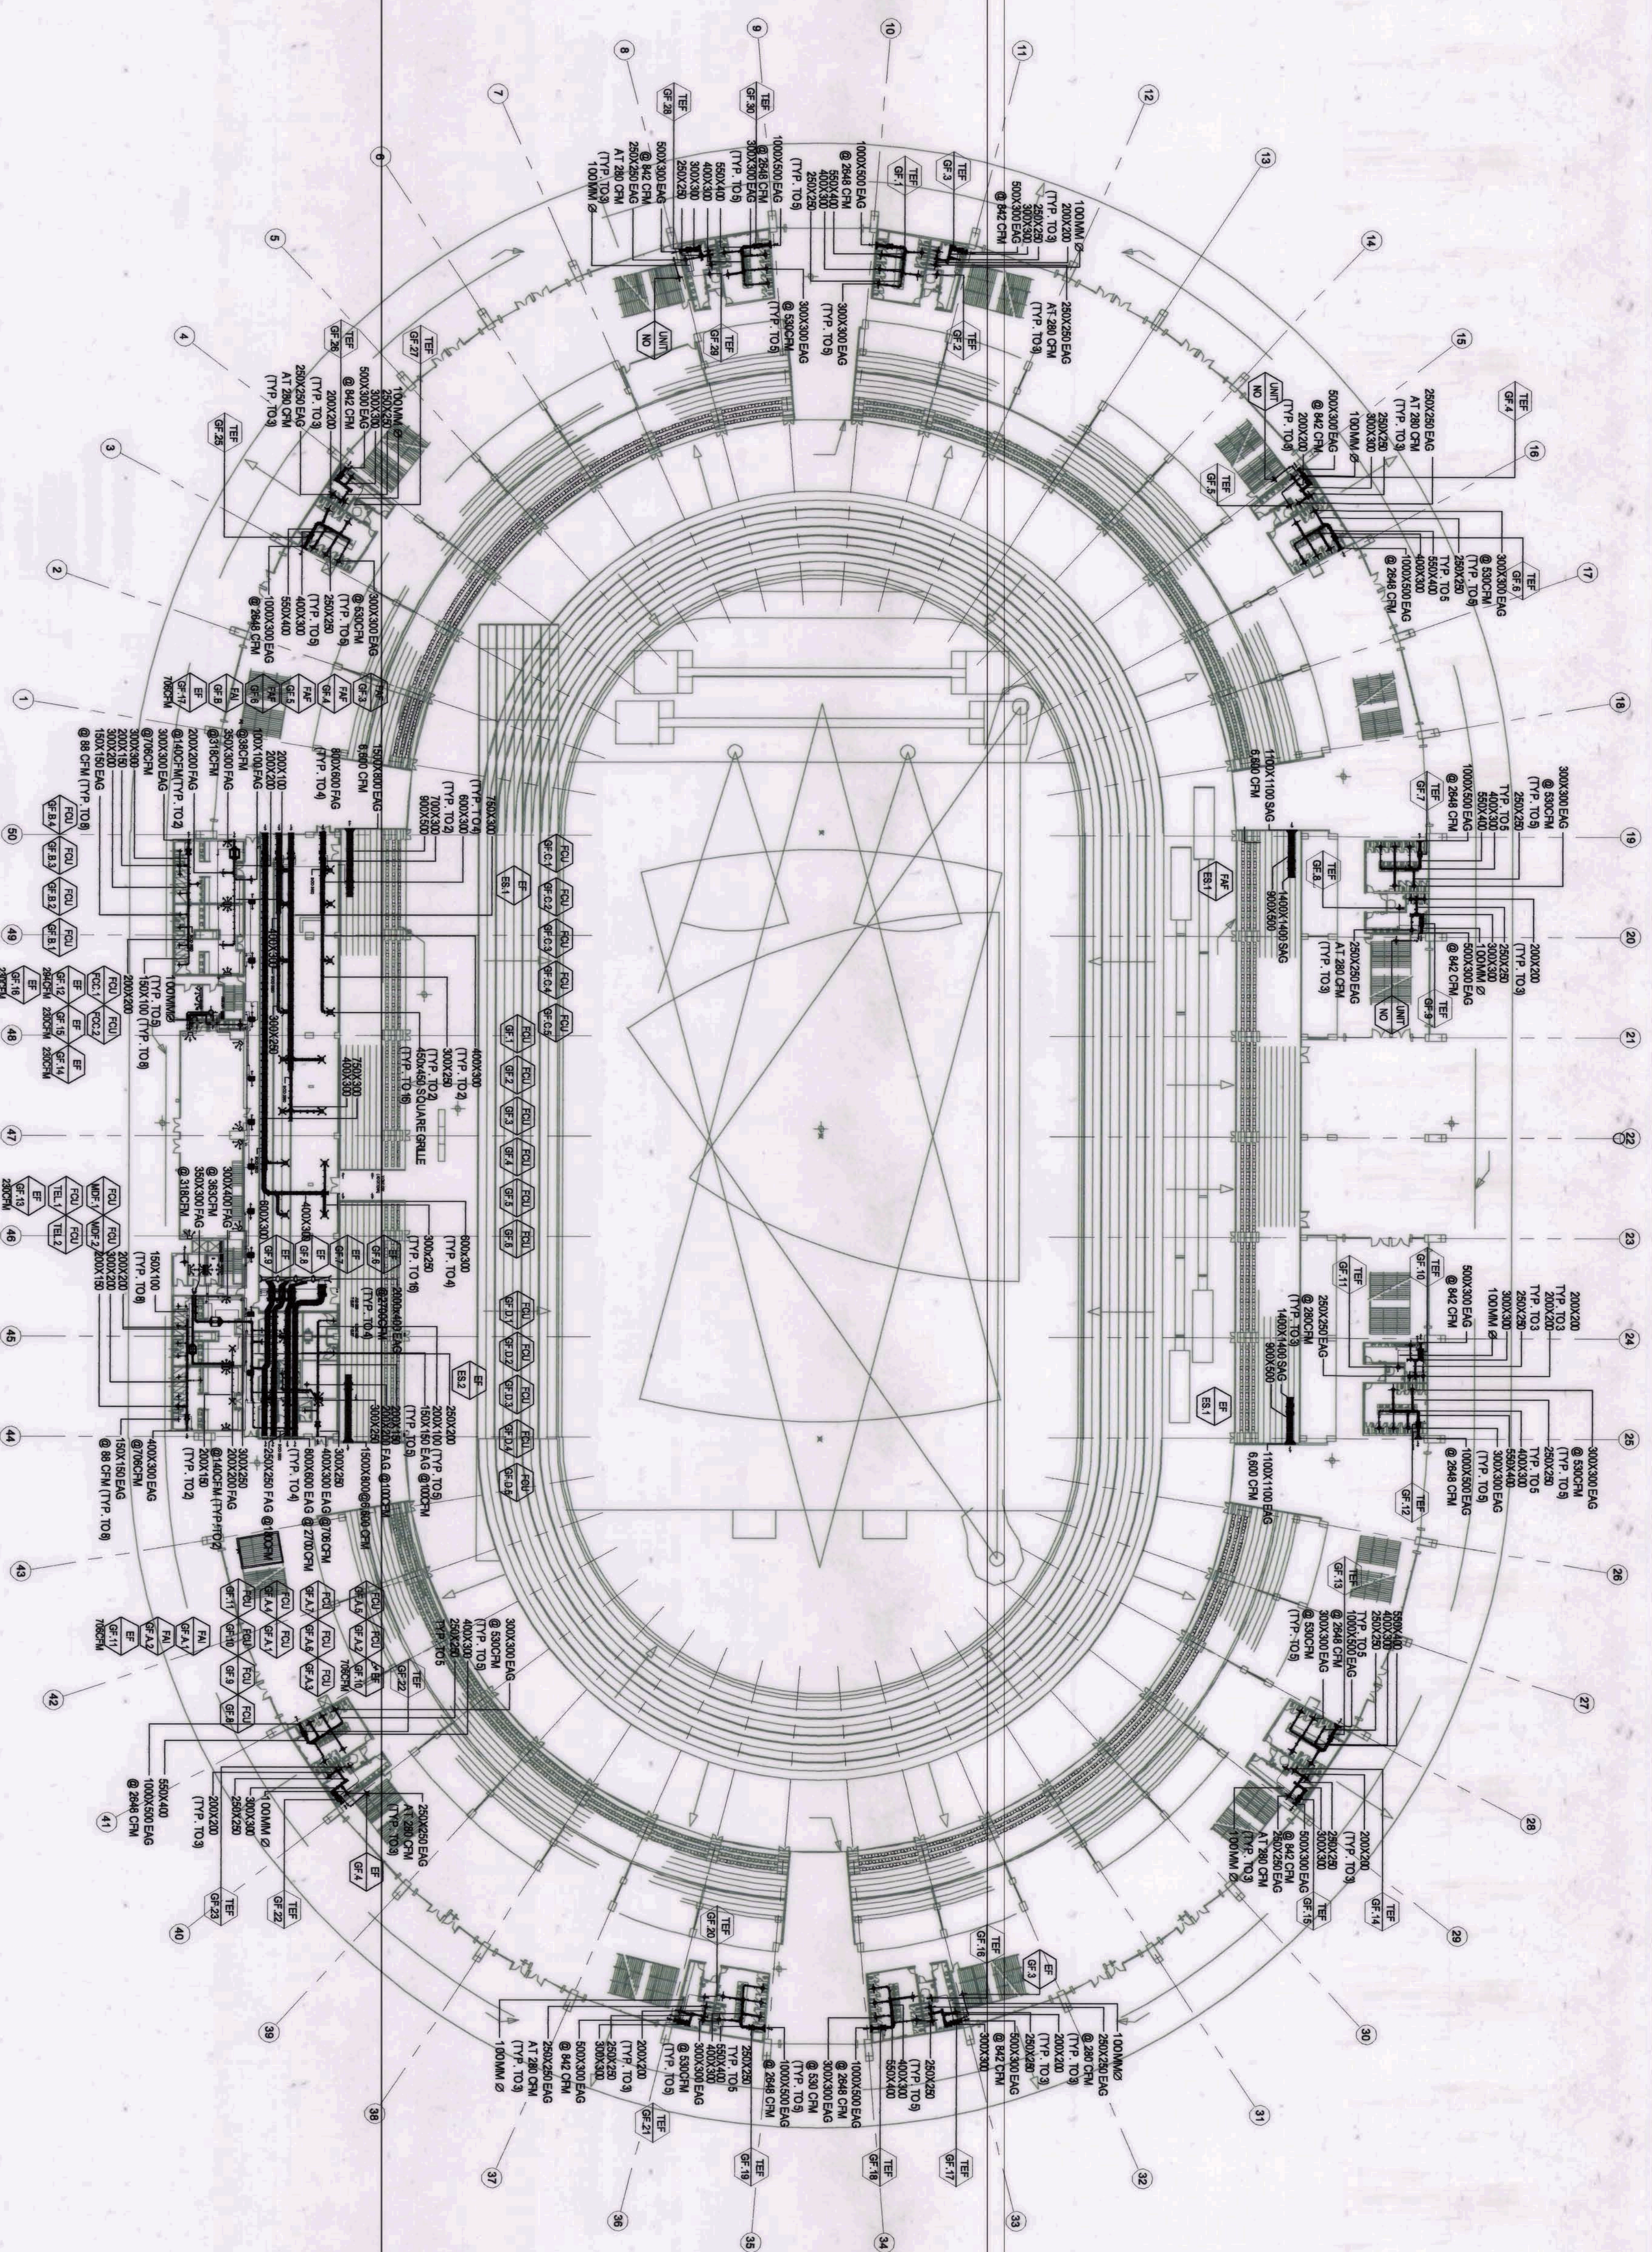

GROUND FLOOR ACNENT LAYOUT  
SCALE 1:500

OWNER: NGAC PHASE 1A COMPANY	PREPARED BY:	REVIEWED AND VALIDATED BY:	SUBMITTED BY:	CERTIFIED BY: INDEPENDENT CONSULTANT	PROJECT TITLE	SHEET CONTENTS	SHEET NO.
AND BCDA AND PATRICK NICHOLAS P. DAVID	HIL MARC'S CONSTRUCTION CORPORATION ANGELITO L. QUILES	FILIPINAS DRAVO CORPORATION Architectural & Engineering Consultants ABRERDO R. REVILLA	BANDAR HEBAT BUILDERS, INC. ISAACS DAVID	TCGI ENGINEERS VIRGILIO A. MADRADO	AS-BUILT DRAWING NGAC PHASE 1A ATHLETICS STADIUM (MECHANICAL) NEW CLARK CITY, CAPAS TARLAC	GROUND FLOOR AC & VENT LAY OUT	M2-01




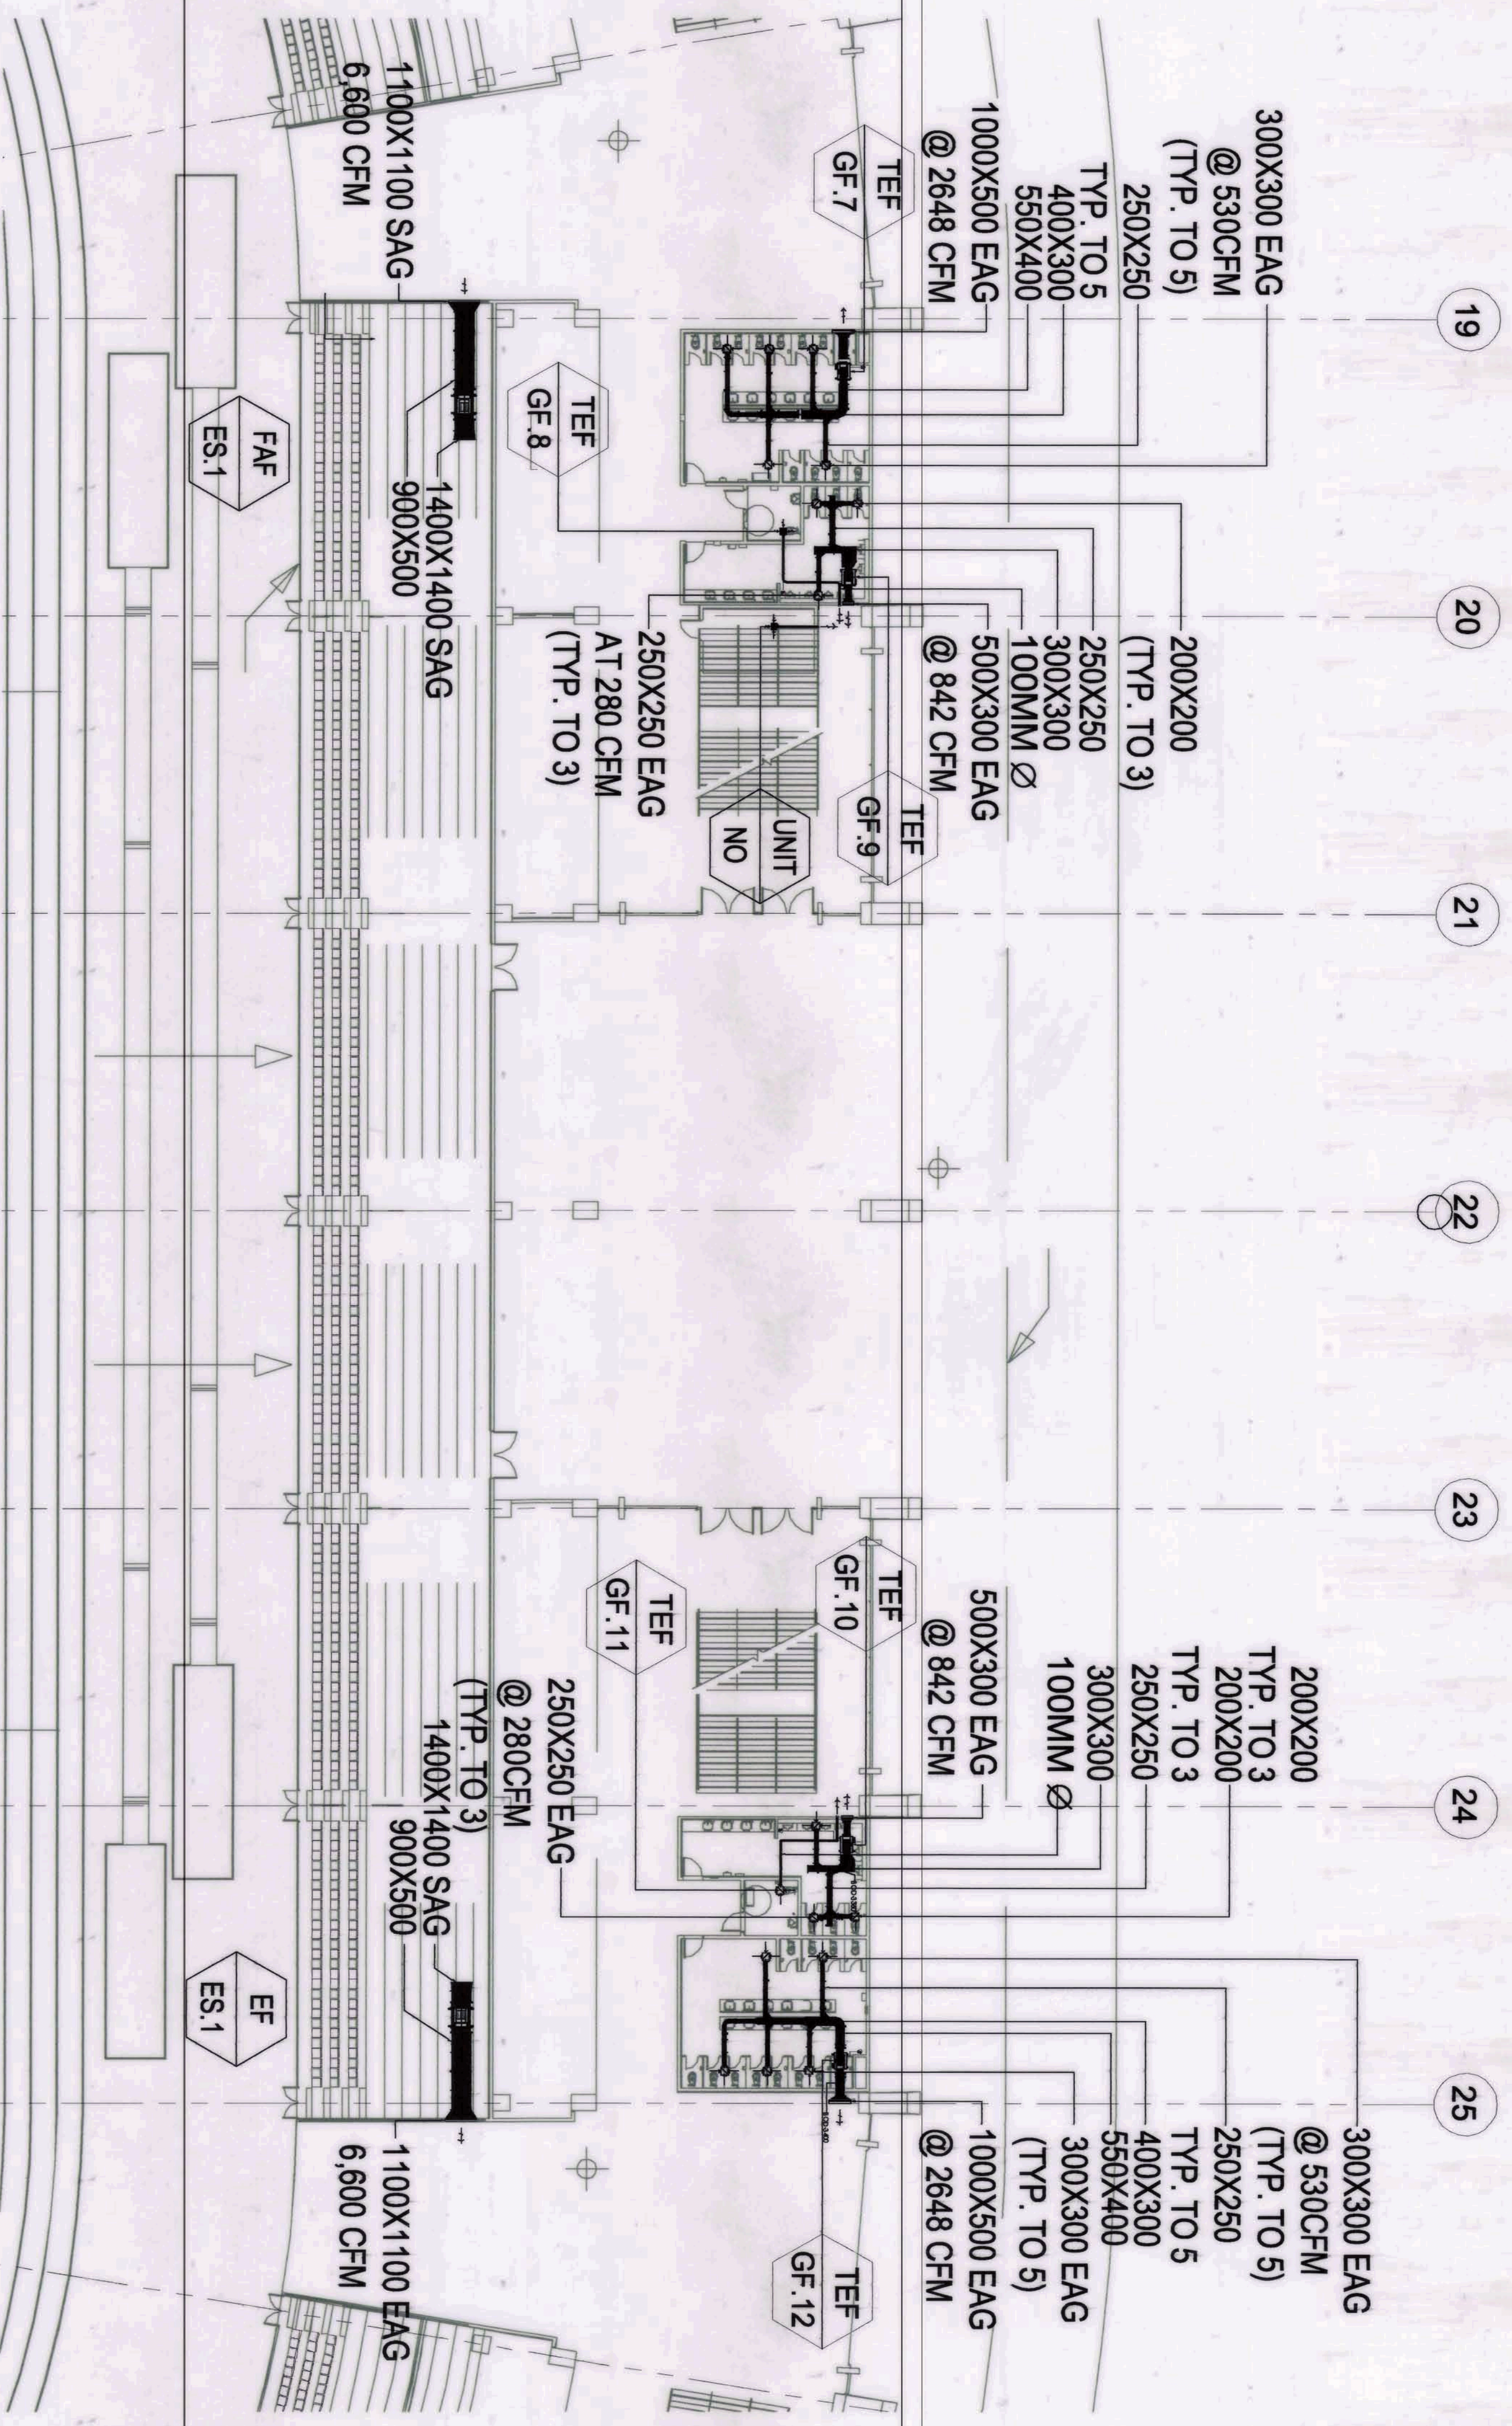

EAST GROUND  
FLOOR AC/VENT LAYOUT

SCALE 1:250

OWNER: NGAC PHASE 1 JV COMPANY		PREPARED BY:		REVIEWED AND VALIDATED BY:		SUBMITTED BY:		CERTIFIED BY: INDEPENDENT CONSULTANT		PROJECT TITLE		SHEET CONTENTS:		SHEET NO.	
<div>BCDA Bureau of Construction, Design and Supervision AND MTO CIVIL, Inc. VIVENCIO B. DIZON</div>		<div>HIL MAR C 'S CONSTRUCTION CORPORATION ANGELITO L. OLLERES</div>		<div>FILIPINAS DRAVO CORPORATION Architectural &amp; Engineering Consultants ALFREDO R. REVILLA</div>		<div>BANDAR HEBAT BUILDERS, INC. ISAAC S. DAVID</div>		<div>TCGI ENGINEERS VIRGILIO A. MADRAZO</div>		AS-BUILT DRAWING NGAC PHASE 1A ATHLETICS STADIUM (MECHANICAL) NEW CLARK CITY, CAPAS TARLAC		EAST GROUND FLOOR AC/VENT LAYOUT		M2-01B	

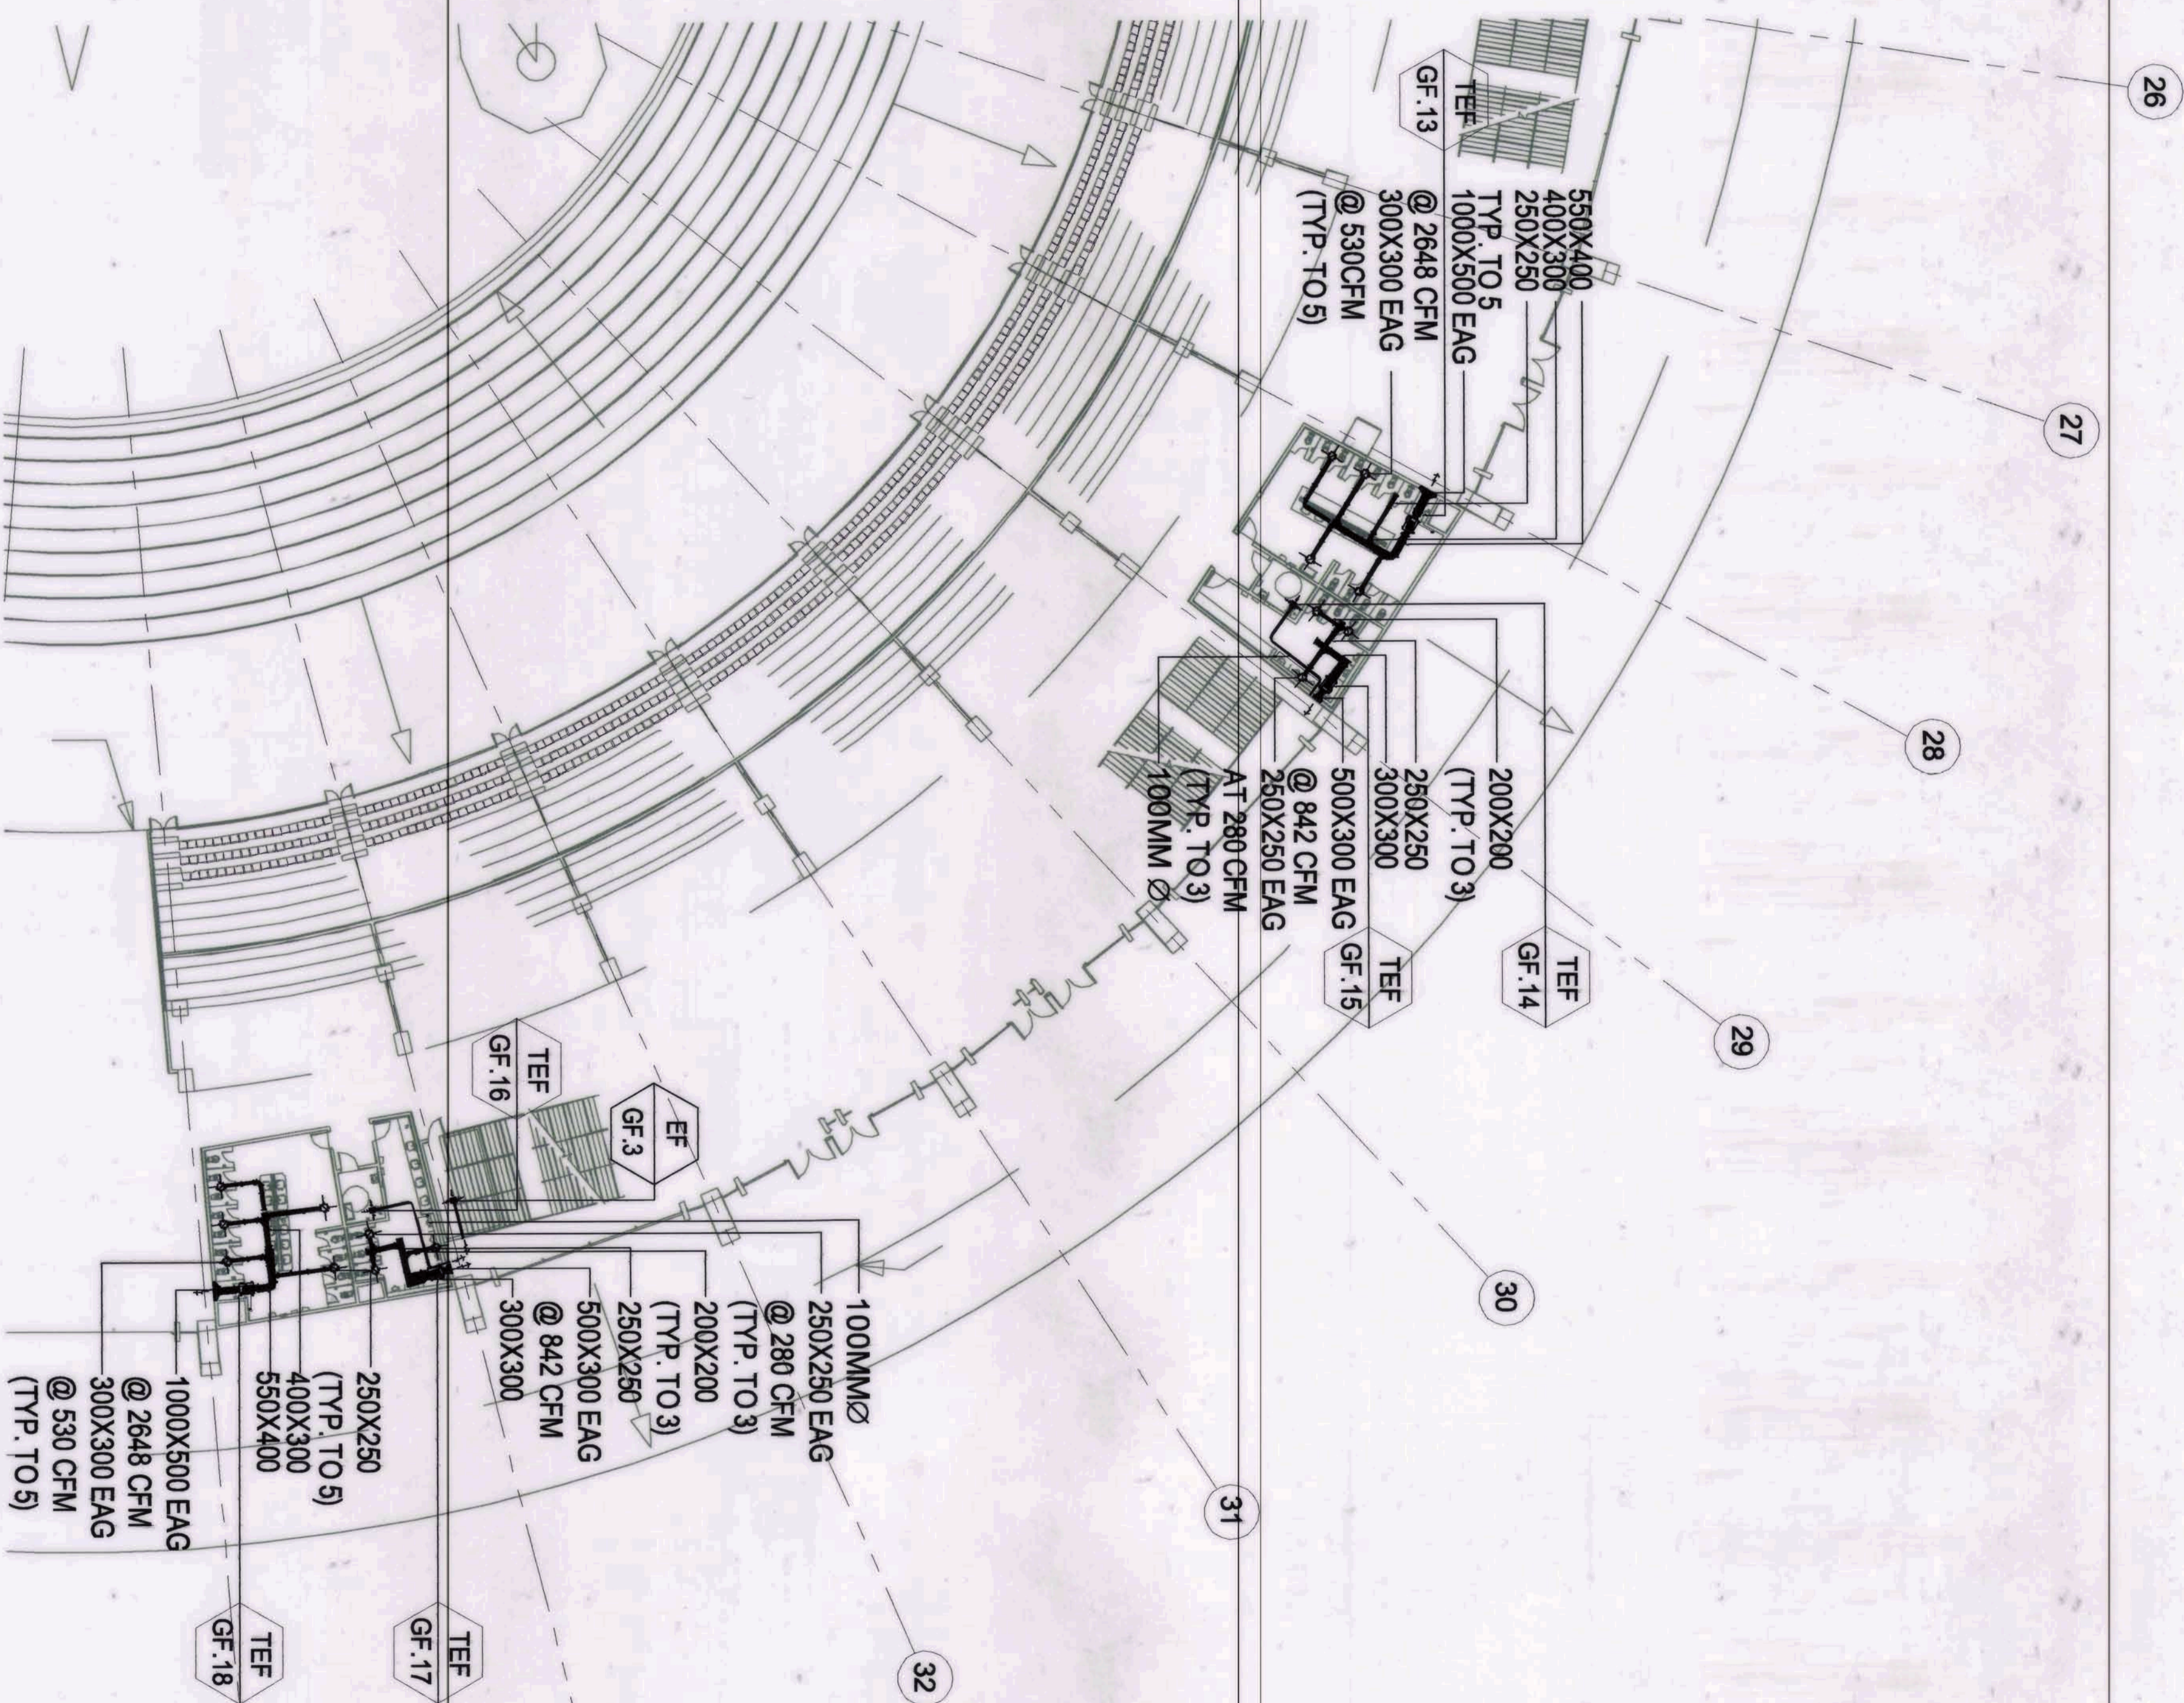


SOUTH EAST GROUND  
FLOOR AC/VENT LAYOUT

1:250


OWNER: NGAC PHASE 1 JV COMPANY	PREPARED BY:	REVIEWED AND VALIDATED BY:	SUBMITTED BY:	CERTIFIED BY INDEPENDENT CONSULTANT	PROJECT TITLE:	SHEET CONTENTS:	SHEET NO.
<div>BCDA Bureau of Construction, Demolition and Reclamation Administration AND VIVENCIO B. PIZON PROJECT MANAGER</div>	<div>HILL MARCH'S CONSTRUCTION CORPORATION 1001 N. 10th St., Suite 100, San Jose, CA 95128 TEL: (408) 294-1122 FAX: (408) 294-1123 WWW.HILLMARCHS.COM ANGELITO L. OLLERES PROJECT MANAGER</div>	<div>FLP FILIPINAS DRAYO CORPORATION P.O. Box 100, 1000 N. 10th St., Suite 100, San Jose, CA 95128 TEL: (408) 294-1122 FAX: (408) 294-1123 WWW.FILIPINASDRAYO.COM ABRERDO R. REVILLA PROJECT MANAGER</div>	<div>BANDAR HEBAT BUILDERS, INC. ISMA S. DAVID PRESIDENT</div>	<div>TCGI ENGINEERS 100 N. 10th St., Suite 100, San Jose, CA 95128 TEL: (408) 294-1122 FAX: (408) 294-1123 WWW.TCGIENGINEERS.COM VIRGILIO A. MADRADO REGISTERED</div>	AS-BUILT DRAWING NGAC PHASE 1A ATHLETICS STADIUM (MECHANICAL) NEW CLARK CITY, CAPAS TARLAC	SOUTH EAST GROUND FLOOR AC/VENT LAYOUT	M2-01C



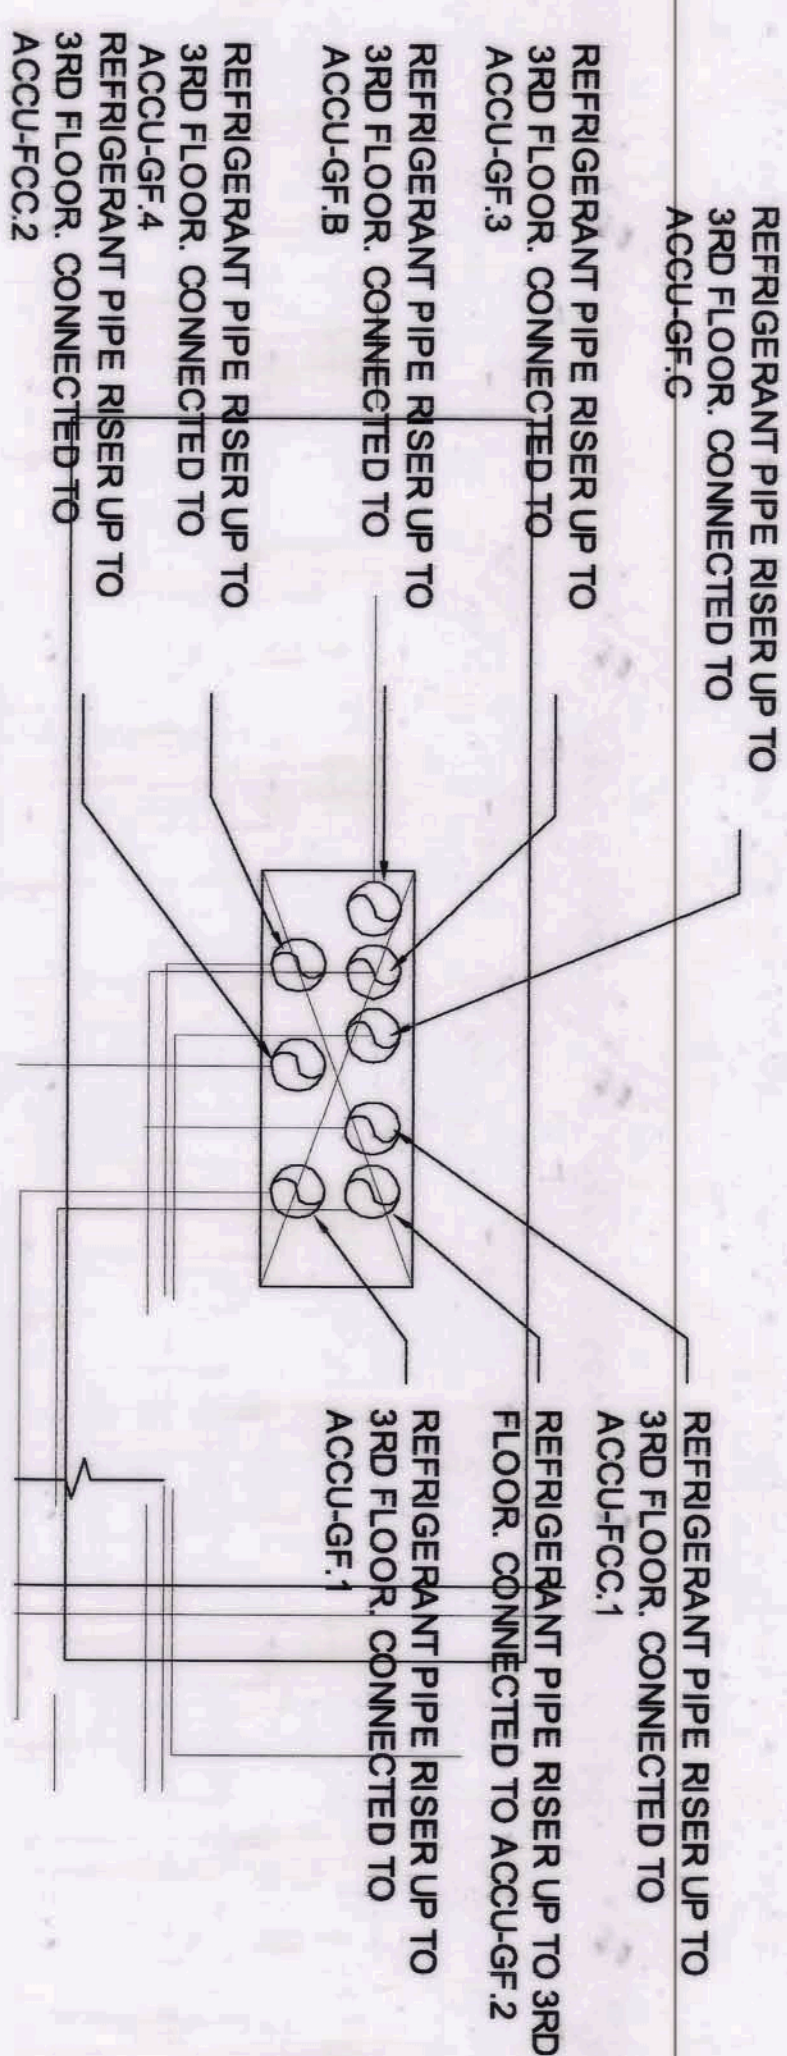


SCALE: 1/20

**RISER #1 (BLOW-UP PLAN)**

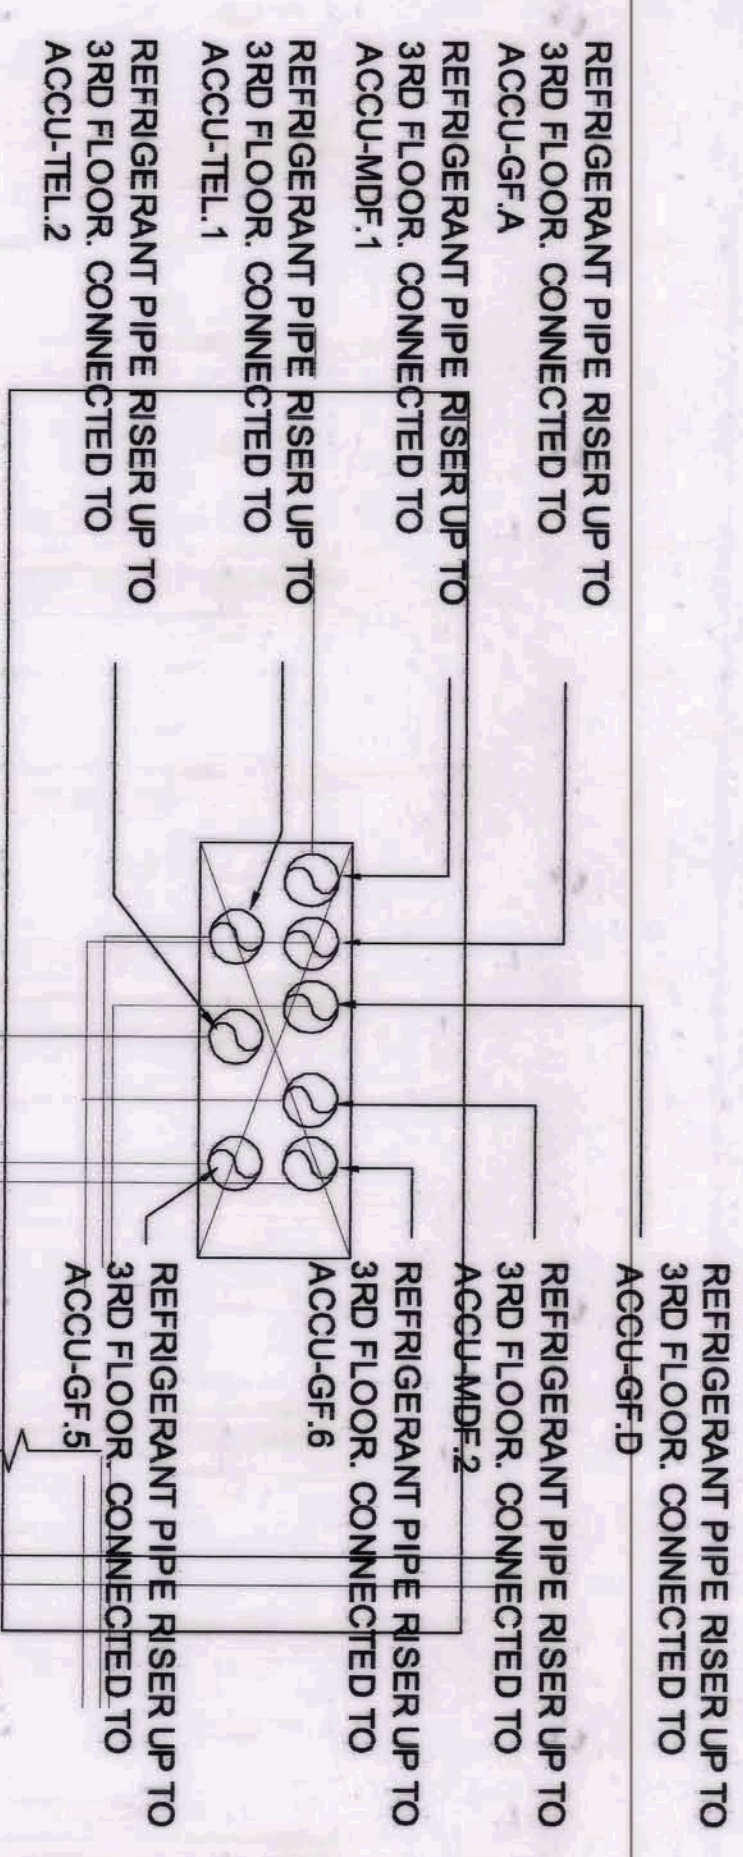

**RISER #2 (BLOW-UP PLAN)**

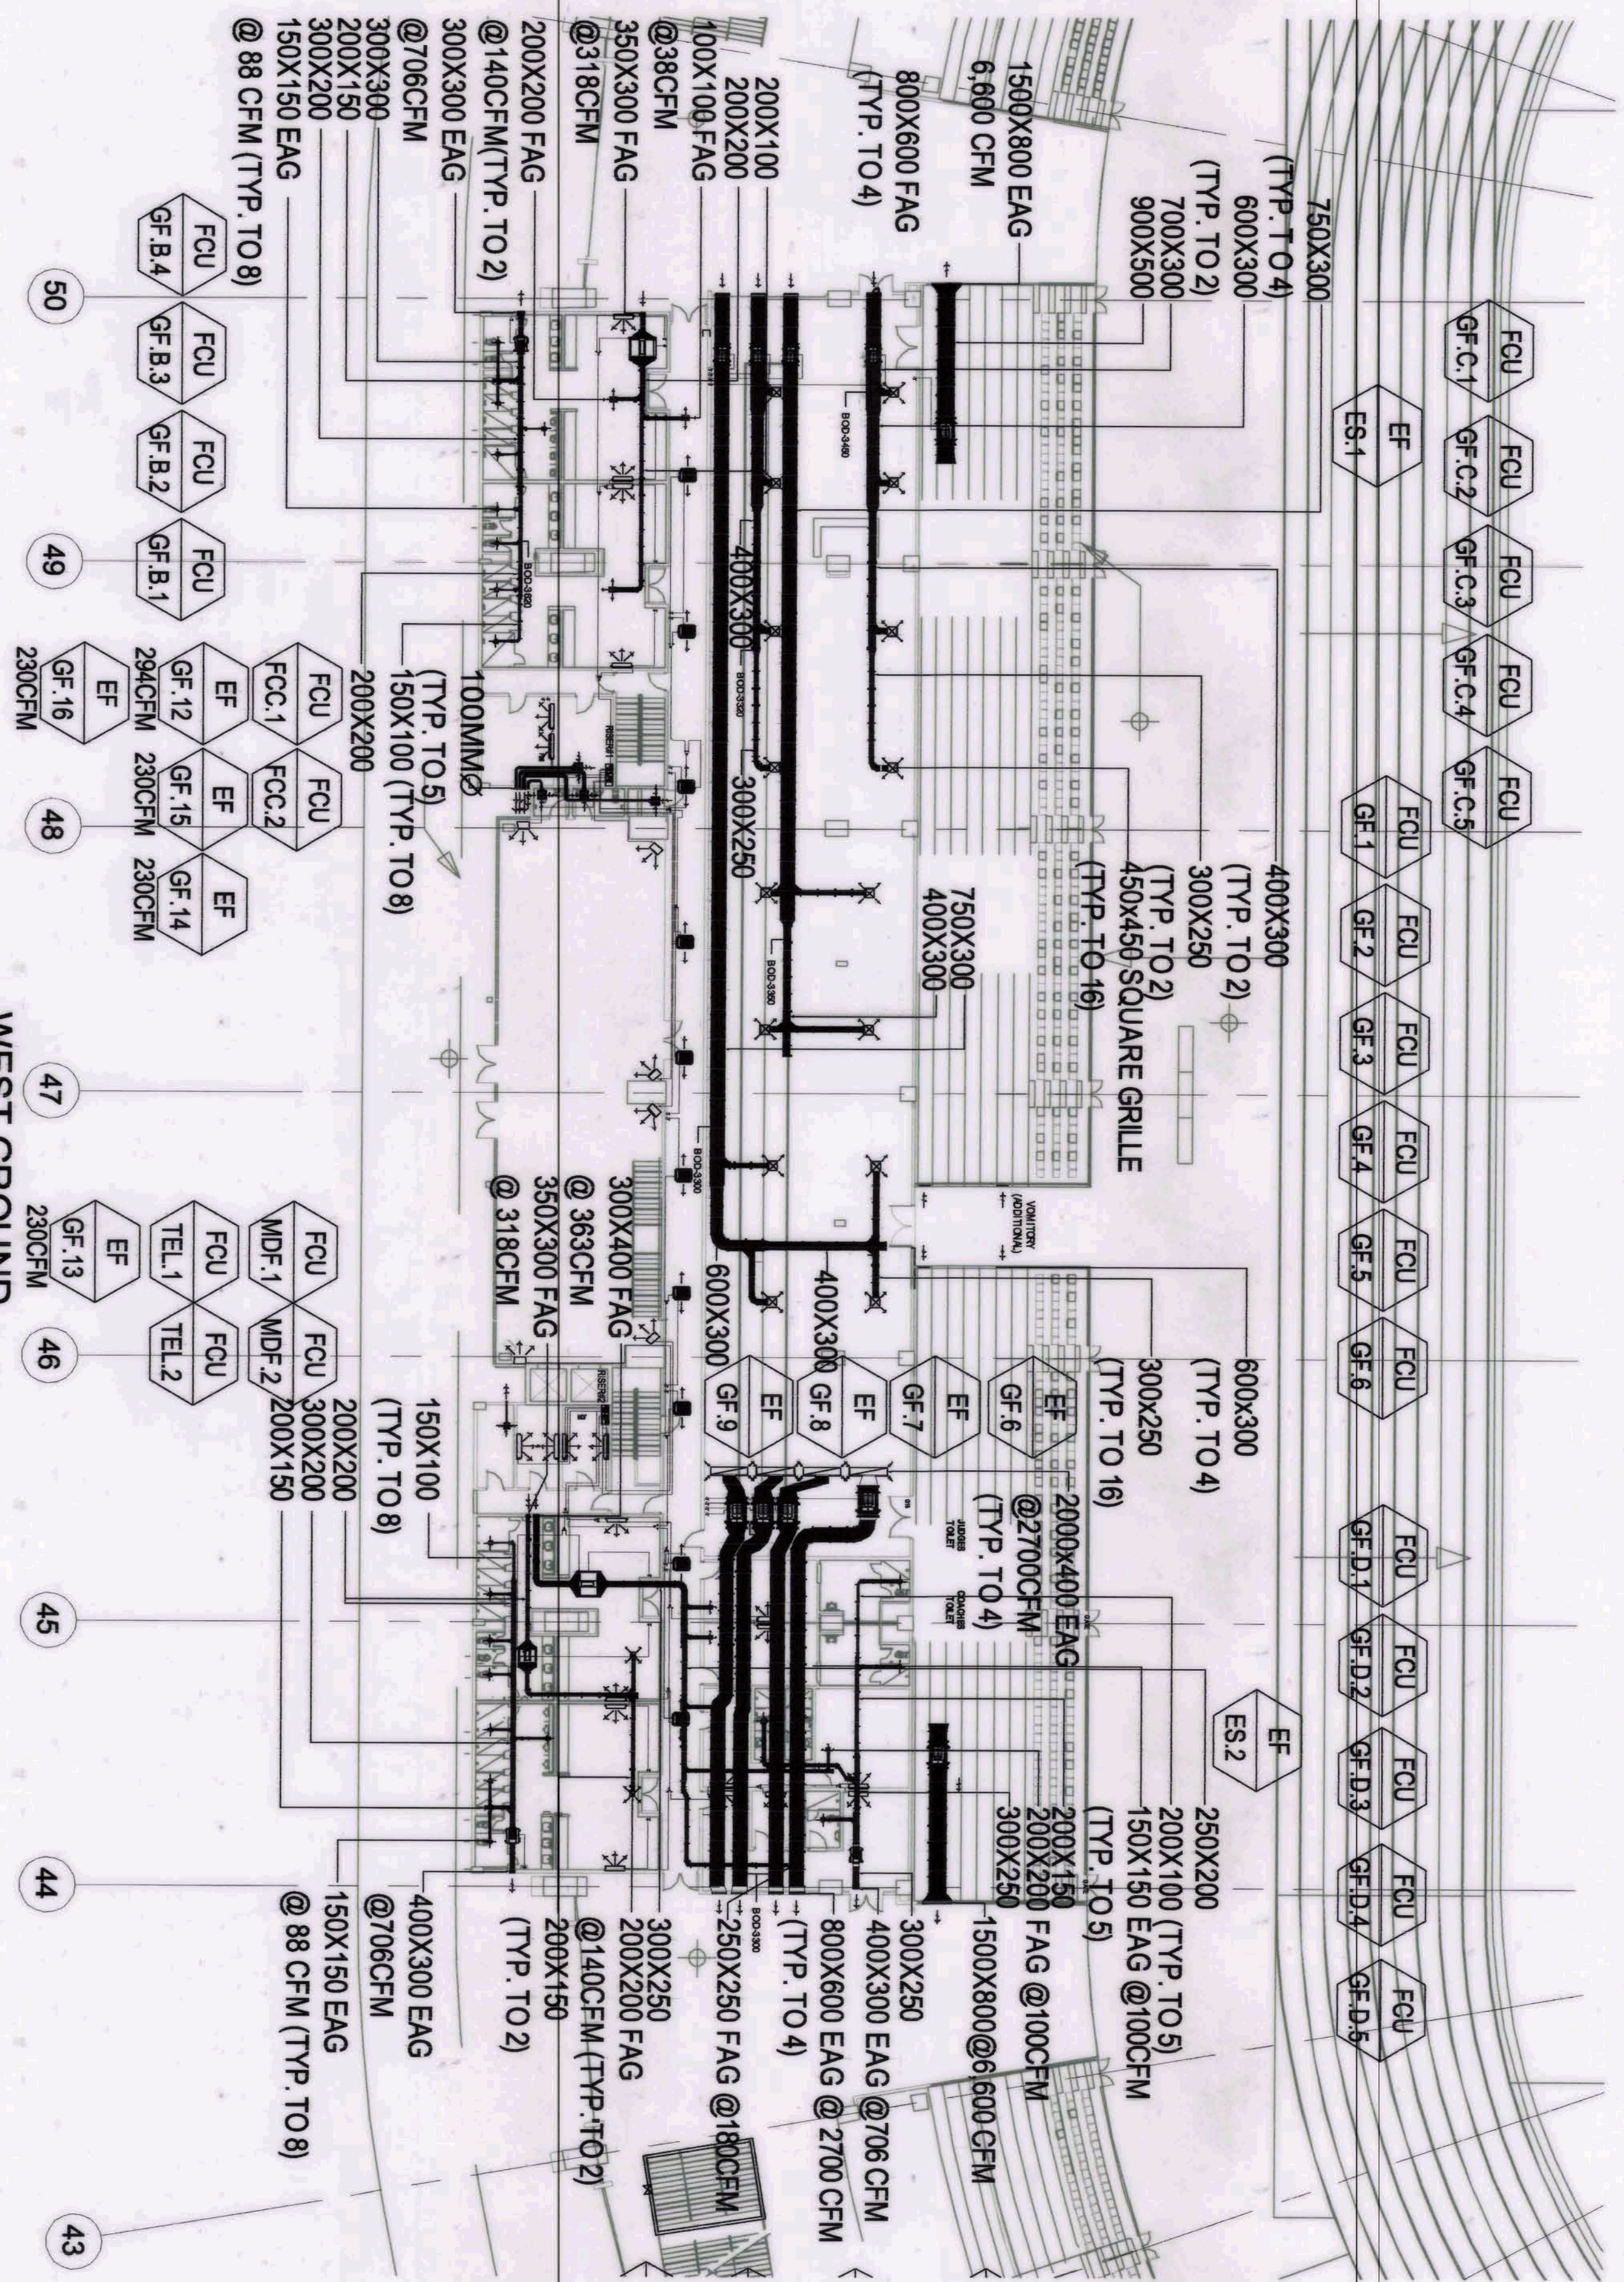


WEST GROUND  
FLOOR ACVENT LAYOUT


SCALE 1:250

OWNER: NGAC PHASE 1A COMPANY	PREPARED BY:	REVIEWED AND VALIDATED BY:	SUBMITTED BY:	CERTIFIED BY: INDEPENDENT CONSULTANT	PROJECT TITLE:	SHEET CONTENTS:	SHEET NO.
 <b>BCDA</b> BUREAU OF CONSTRUCTION DEVELOPMENT AND ADMINISTRATION OFFICE OF THE DIRECTOR 1001 N. LINCOLN BLVD., SUITE 100 ANAHEIM, CA 92801 TEL: 714.947.8000 FAX: 714.947.8001 WWW.BCDA.CA.GOV	 <b>HILMAR C'S</b> CONSTRUCTION CORPORATION 1001 N. LINCOLN BLVD., SUITE 100 ANAHEIM, CA 92801 TEL: 714.947.8000 FAX: 714.947.8001 WWW.HILMARCS.COM	 <b>FILIPINAS DRAVO CORPORATION</b> Architectural & Engineering Consultants 1001 N. LINCOLN BLVD., SUITE 100 ANAHEIM, CA 92801 TEL: 714.947.8000 FAX: 714.947.8001 WWW.FILIPINASDRAVO.COM	 <b>BANDAR HEBAT BUILDERS, INC.</b> 1001 N. LINCOLN BLVD., SUITE 100 ANAHEIM, CA 92801 TEL: 714.947.8000 FAX: 714.947.8001 WWW.BANDARHEBAT.COM	 <b>TCGI ENGINEERS</b> 1001 N. LINCOLN BLVD., SUITE 100 ANAHEIM, CA 92801 TEL: 714.947.8000 FAX: 714.947.8001 WWW.TCGIENGINEERS.COM	<b>AS-BUILT DRAWING</b> NGAC PHASE 1A ATHLETIC STADIUM (MECHANICAL) NEW CLARK CITY, CAPAS TARLAC	GROUND FLOOR AC & VENT LAY OUT	M2-01E




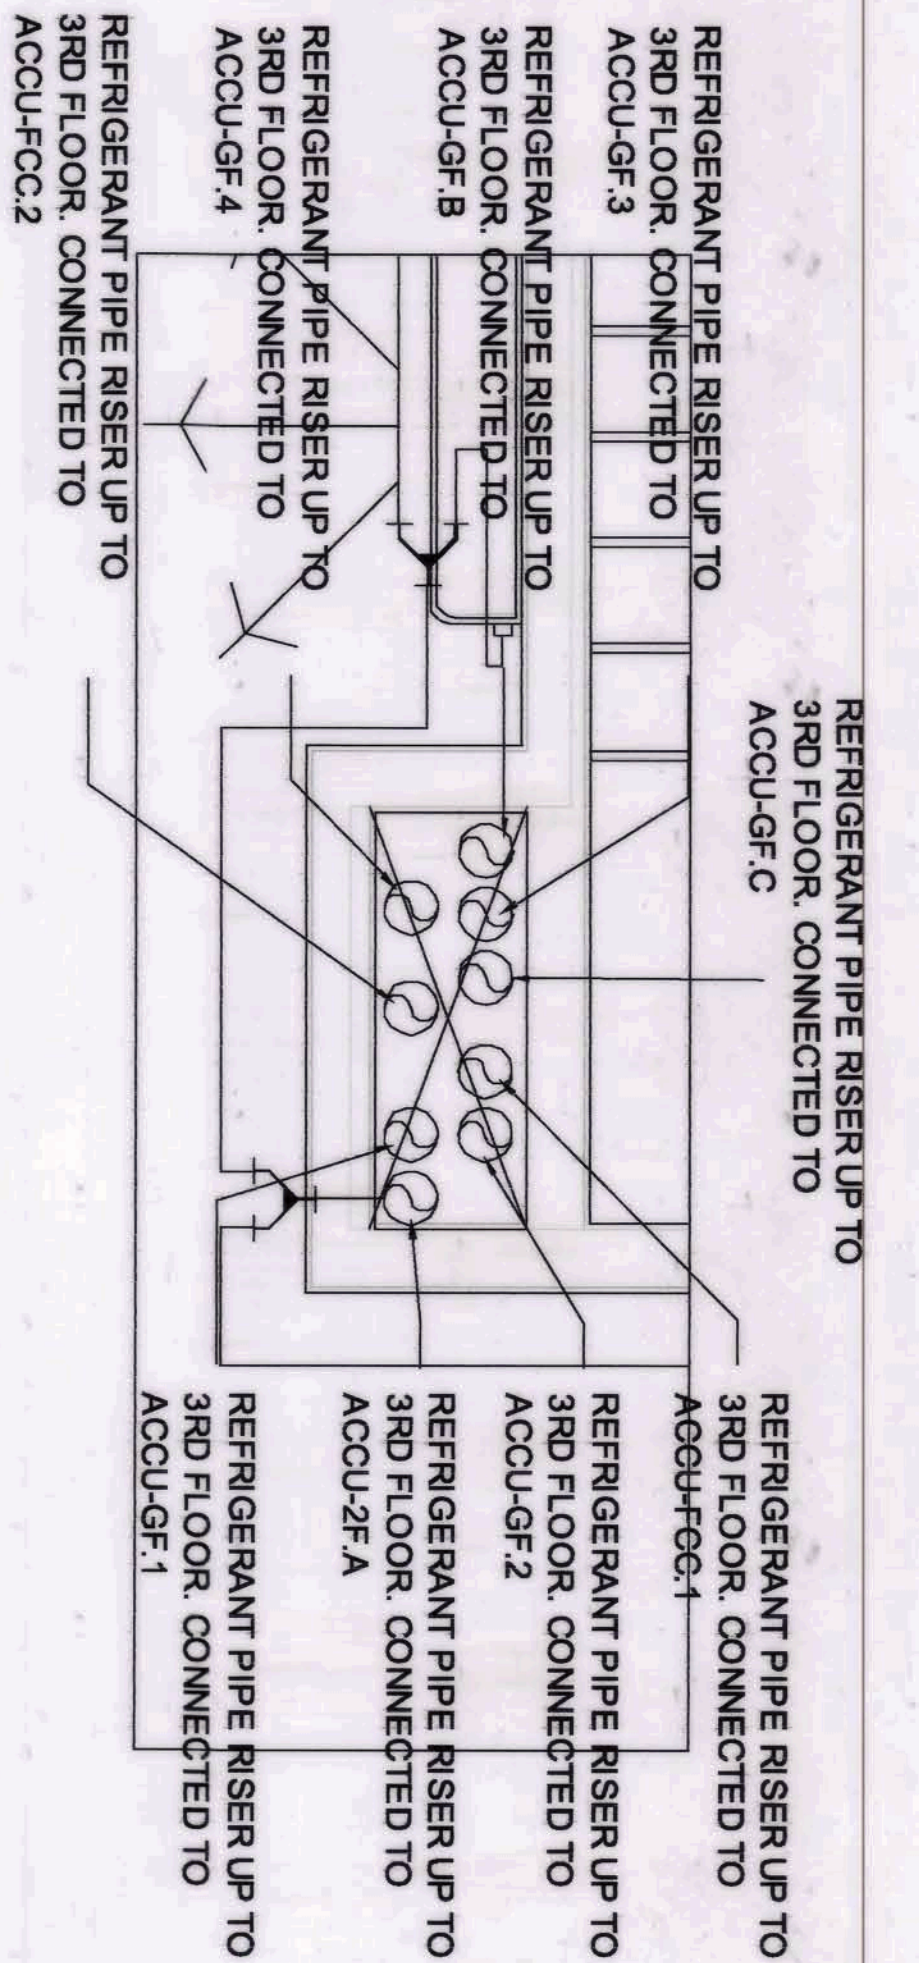



RISER #1 (BLOW-UP PLAN)

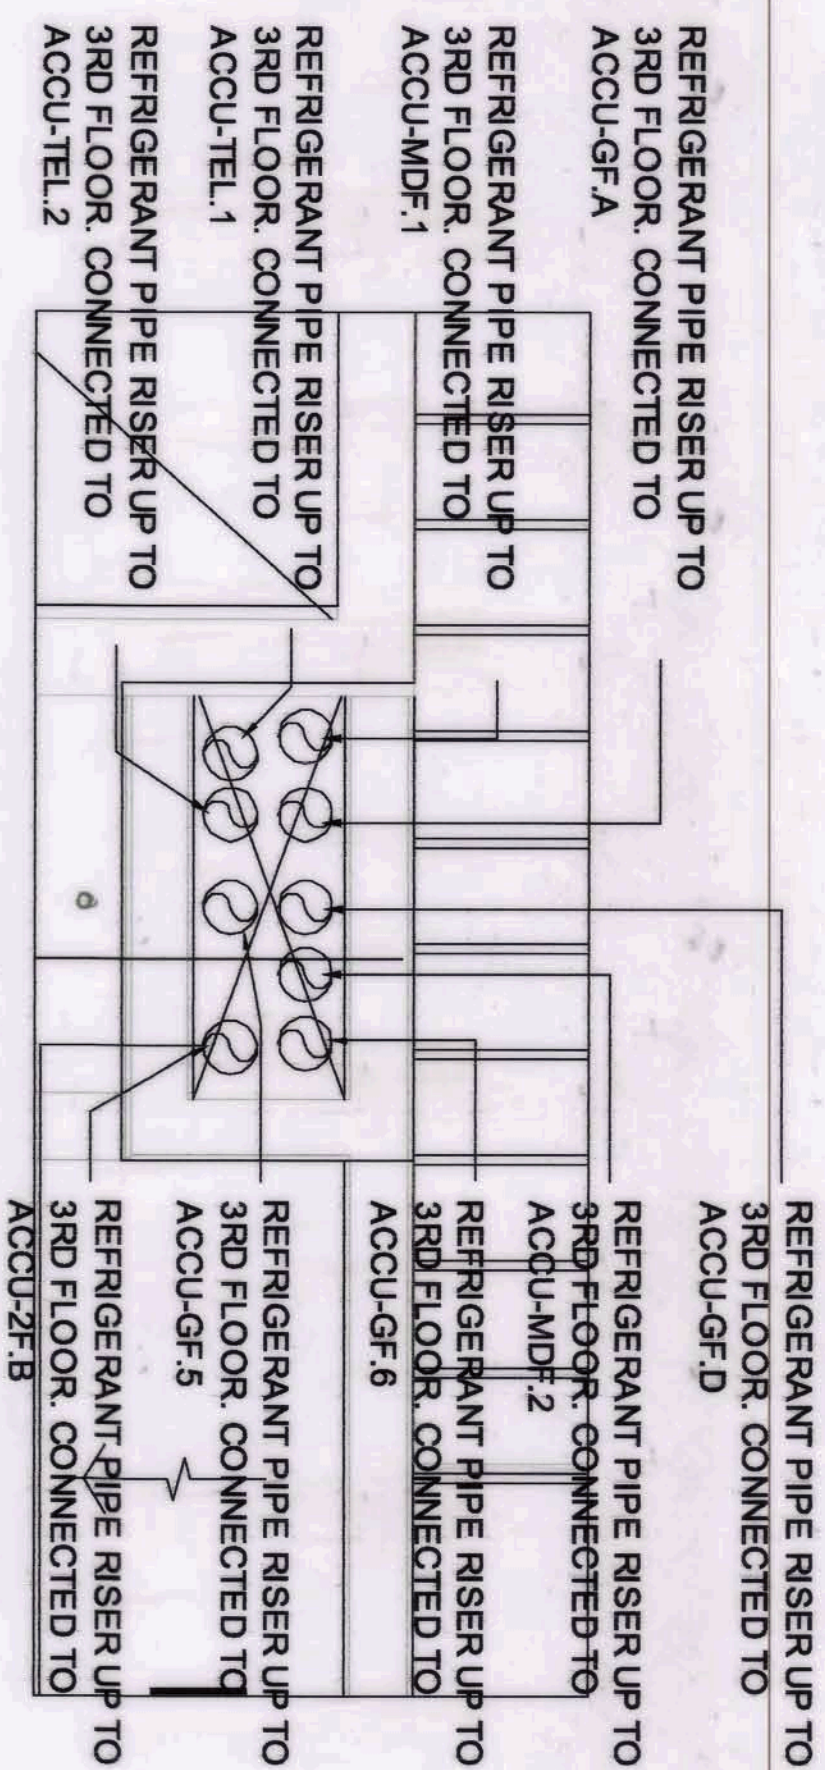

RISER #2 (BLOW-UP PLAN)

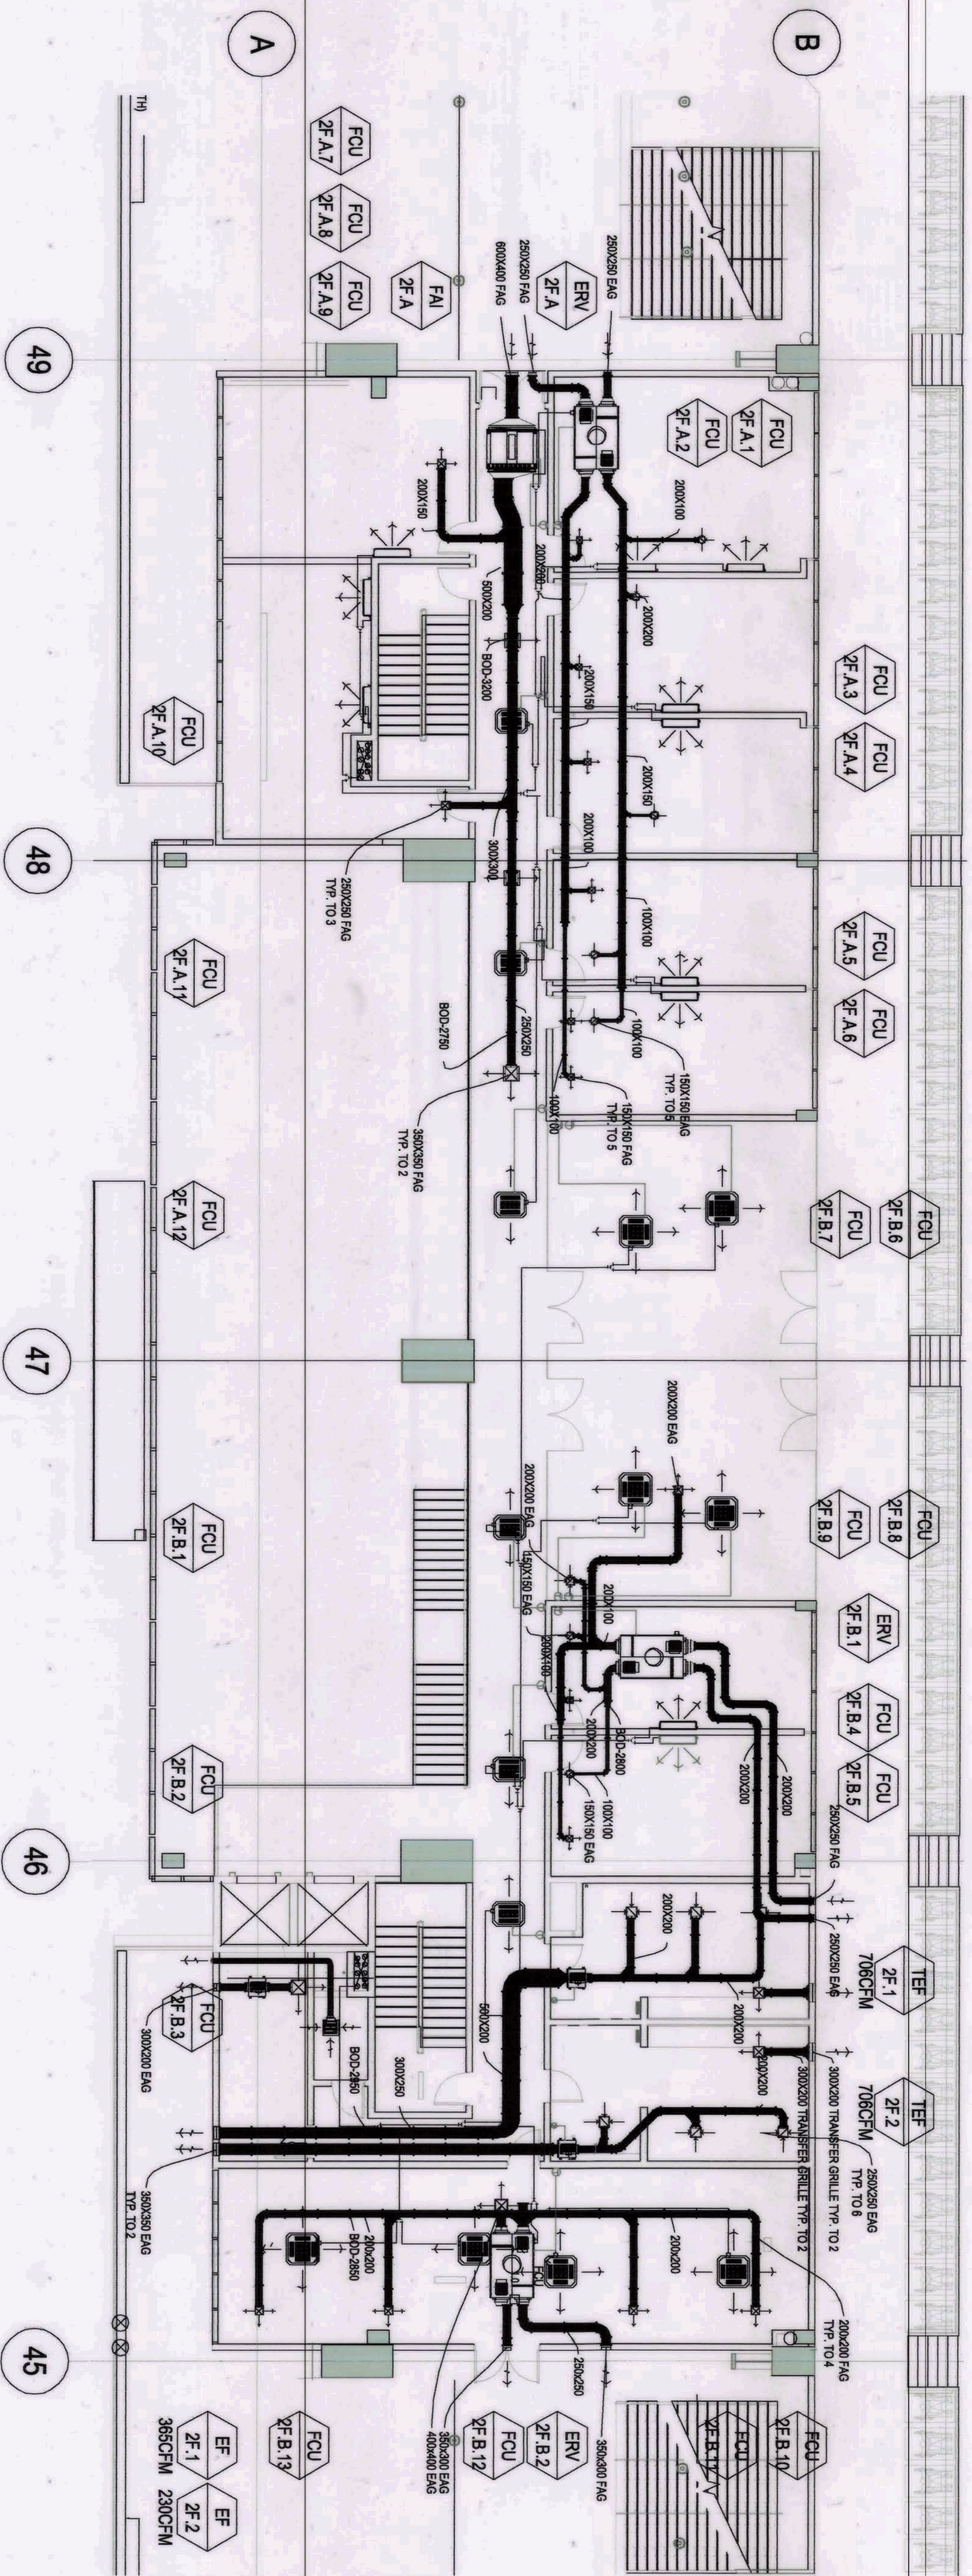



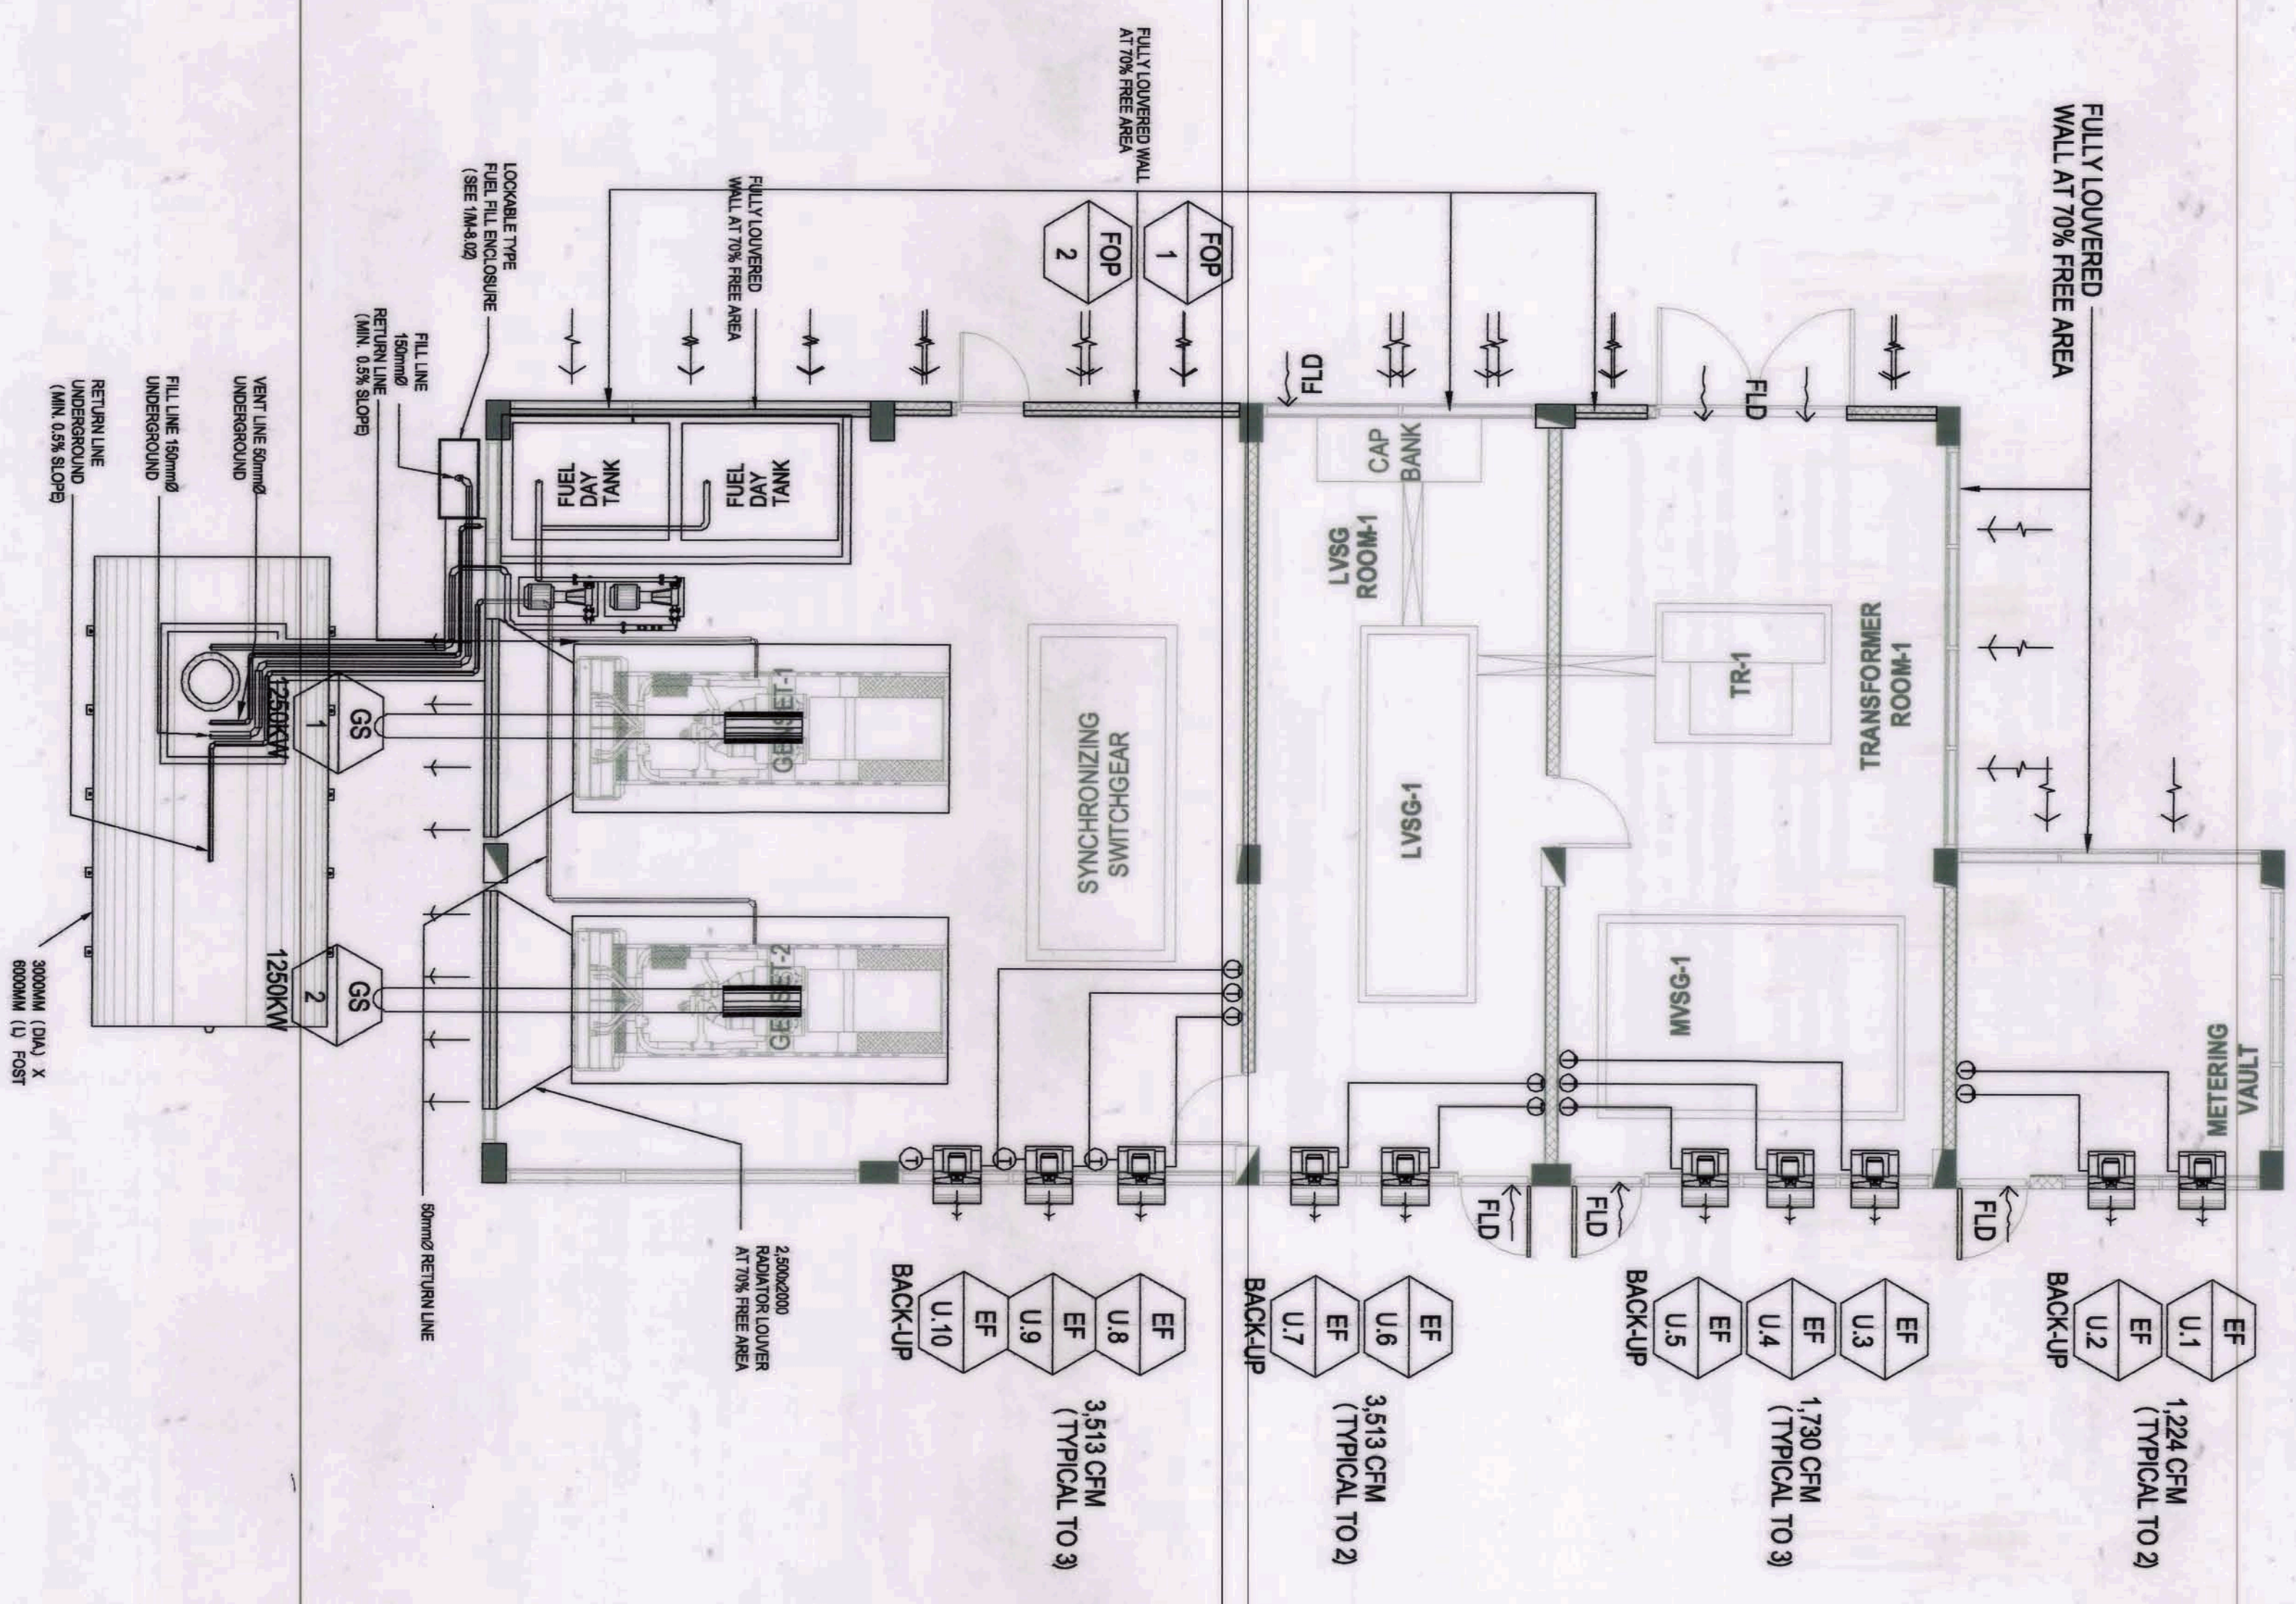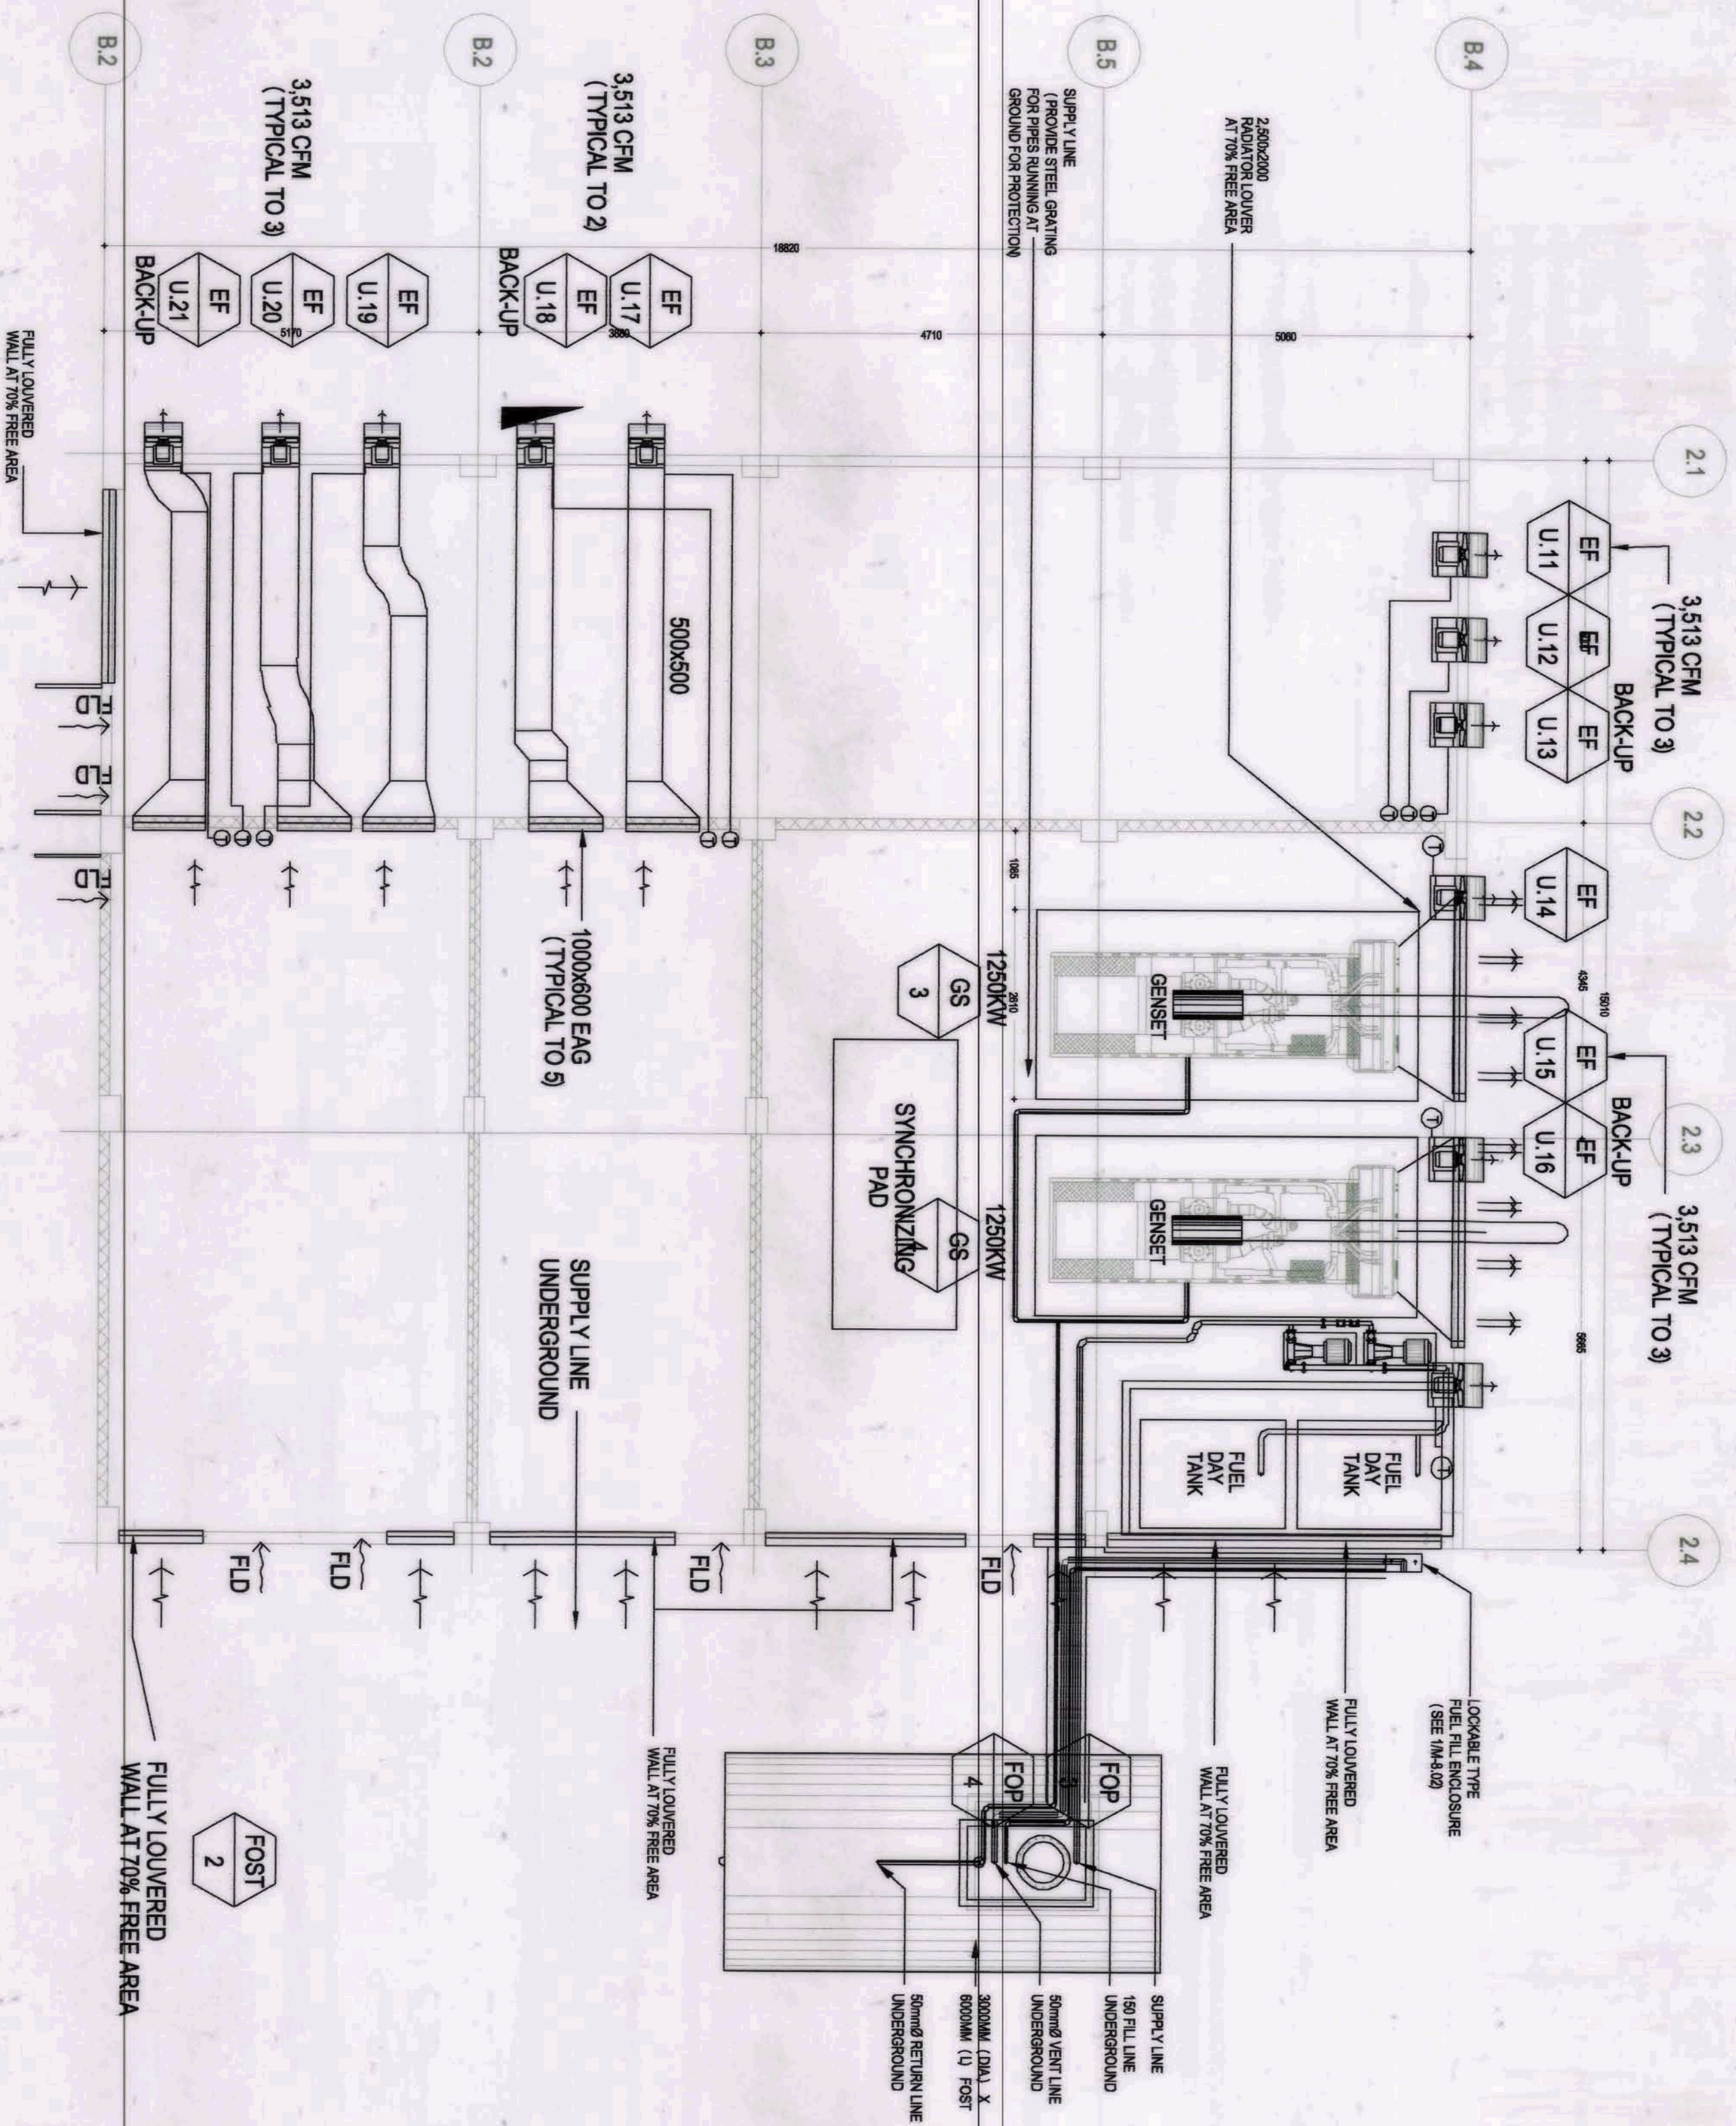

UTILITIES BUILDING VENTILATION &  
FUEL OIL PIPING LAYOUT (NORTH EAST)  
SCALE: 1:70

UTILITIES BUILDING VENTILATION &  
FUEL OIL PIPING LAYOUT (SOUTH WEST)  
SCALE: 1:70

OWNER: NGAC PHASE 1 JV COMPANY	PREPARED BY: HIL MARG'S CONSTRUCTION CORPORATION 188 E. MONTECITO AVENUE, CAGAYAN CITY TEL: 809-888-1111 FAX: 809-888-1112 WWW.HILMARG.COM	REVIEWED AND VALIDATED BY: FILIPINAS DRAYO CORPORATION ALFREDO R. REVILLA PROJECT MANAGER	SUBMITTED BY: BANDAR HEBAT BUILDERS, INC. ISAAC S. DAVID PROJECT MANAGER	CERTIFIED BY: INDEPENDENT CONSULTANT: TCGI ENGINEERS VIRGILIO A. MADRADO PROJECT MANAGER	PROJECT TITLE: AS-BUILT DRAWING NGAC PHASE 1A ATHLETICS STADIUM (MECHANICAL)	SHEET CONTENTS: UTILITIES BUILDING VENTILATION & FUEL OIL PIPING LAYOUT/SECTION (NORTH EAST/SOUTH WEST)	SHEET NO. M3-01
AND MDO CLARK, INC. PATRICK NICHOLAS P. DAVID PROJECT MANAGER	ANGELITO T. OLLERES PROJECT MANAGER	ALFREDO R. REVILLA PROJECT MANAGER	ISAAC S. DAVID PROJECT MANAGER	VIRGILIO A. MADRADO PROJECT MANAGER			



DATA FOR FUEL OIL SYSTEM:  
GENSET CAPACITY: 2 UNITS OF 1250KVA

FUEL CONSUMPTION PER GENSET: 271.6  $\frac{L}{hr}$

FUEL OIL TANK RESERVED: 70 HOURS

FUEL OIL STORAGE TANK SIZING:

$V = 271.6 \times 2 \times \frac{L}{hr} \times \frac{hr}{24} = 38,024.0 L$   
 $V = 38,024.0 L$  (TOTAL FUEL CONSUMPTION)  
 $V = 38,024.0 L \times 1.1$  (10% AIR GAP)  
 $V = 41,826.4 L \approx 42.0 M^3$



CONSIDERING 3.0M TANK DIAMETER FOR 1 TANK  
 $V = \frac{\pi}{4} \times D^2 \times L \approx 42.0 M^3 = \frac{\pi}{4} \times (3)^2 \times L$

SIZE OF TANK  
1 UNIT OF 3.0M $\phi$  (DIAMETER) X 8.0M (LENGTH)

PUMP SELECTION:  
REQUIRED VOLUME IN DAY TANK  
 $V = 271.6 \times 2 \times \frac{L}{hr} \times \frac{hr}{24} = 4,346.6 L$

CONSIDERING 20 MINS. FILLING TIME  
 $\frac{4,346.6 L}{20 \text{ MINUTES}} \times \frac{1 \text{ GAL}}{3.78 L} = 57.48 \text{ GAL/MIN}$

SAY: 1 UNIT OF 58 GAL/MIN (OPERATION) &  
1 UNIT OF 58 GAL/MIN (STAND-BY)

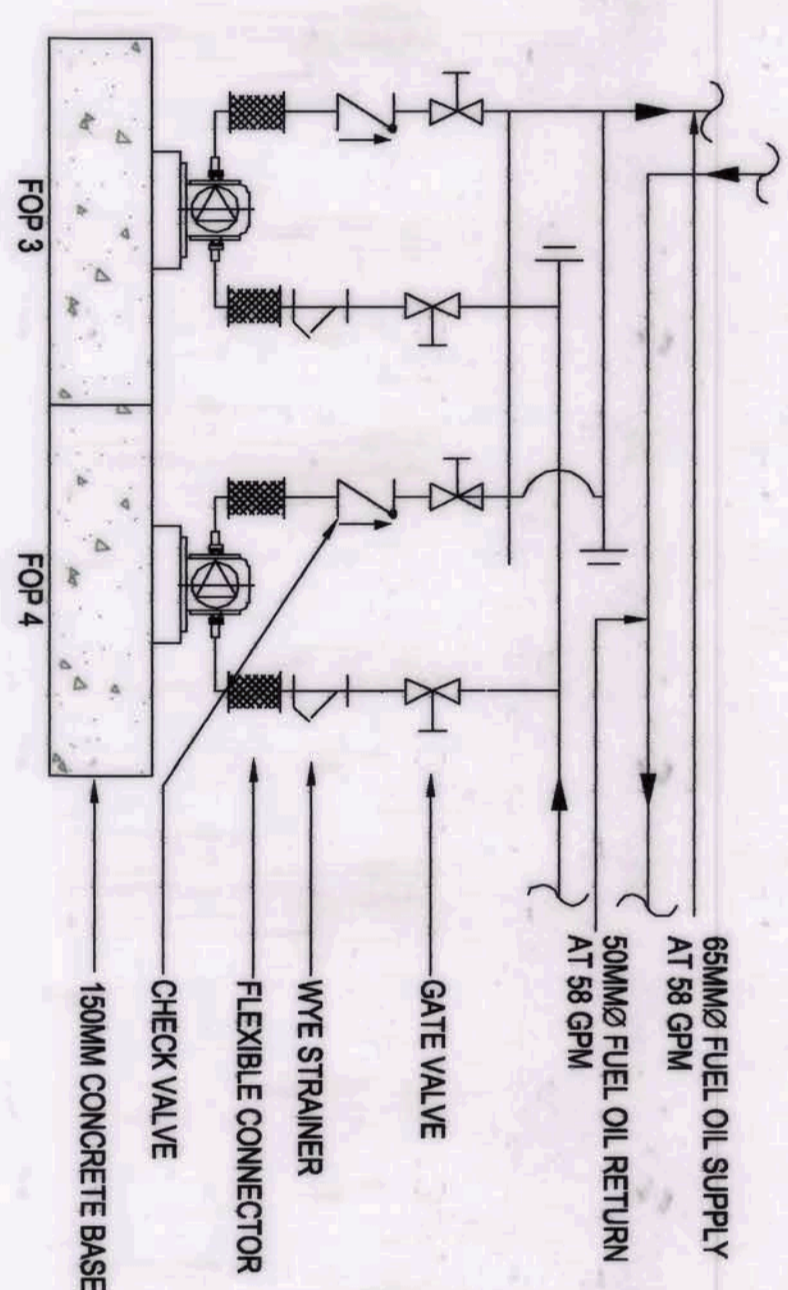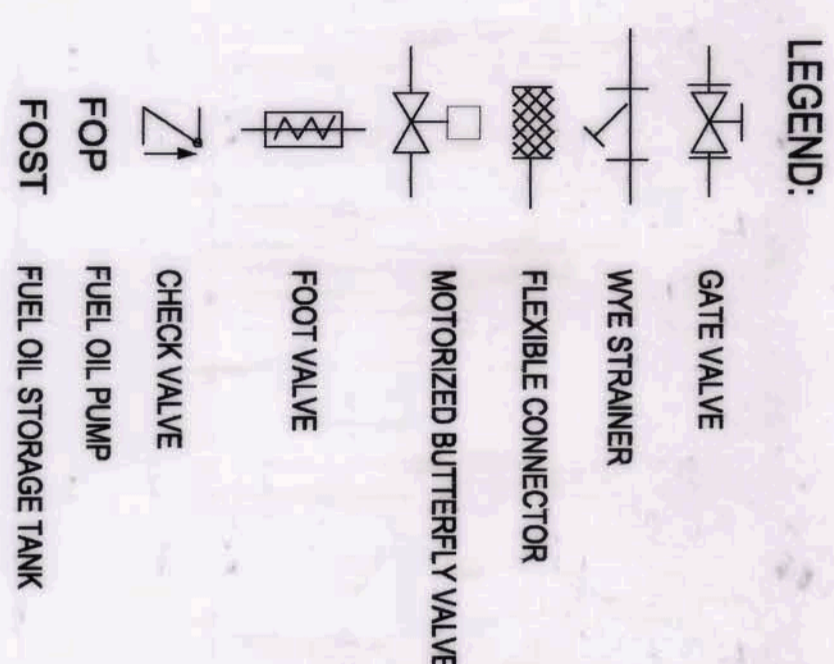

AUTOMATIC / MANUAL SEQUENCE FOR FUEL OIL FILLING AND PUMP OPERATION:

- A. MANUAL MODE  
1.) IN THE MANUAL MODE EACH PUMP CAN BE STARTED OR STOPPED MANUALLY VIA "HOA" CONTROLLER/SELECTOR SWITCH.
- H - HANDMANUAL  
O - OFF  
A - AUTOMATIC

- SEQUENCE: 1.) SET SELECTOR SWITCH TO "F" POSITION FOR MANUAL MODE.  
1.2) SELECT EITHER FOP-1 OR FOP-2.  
1.3) PRESS THE START/STOP BUTTON TO RUN/STOP THE PUMP.

- B. AUTOMATIC MODE  
1.) IN THE AUTOMATIC MODE EACH PUMP SHALL START ALTERNATELY BASED ON FUEL LEVEL AT BOTH FUEL OIL DAY TANKS AND BULK FUEL STORAGE TANKS.


- H - HANDMANUAL  
O - OFF  
A - AUTOMATIC
- HOA
- SEQUENCE: 1.) SET SELECTOR SWITCH TO "A" POSITION FOR AUTOMATIC MODE.  
1.2) ONCE THE FUEL DAY TANKS REACHES THE PRESET MINIMUM FUEL LEVEL, FOP-1 & 2 WILL RUN DEPENDING ON THE LEAD/LAG SETTING. ONCE THE FUEL DAY TANK REACHES THE PRESET MAXIMUM FUEL LEVEL, THE PUMP WILL STOP OPERATION.  
1.4) PUMPS WILL RUN/STOP ALTERNATELY AS THE FUEL LEVEL IN THE FUEL DAY TANK REACHES THE MINIMUM AND MAXIMUM LEVELS.

NOTES:

- IF THE FUEL LEVEL SENSORS AT THE FUEL OIL STORAGE TANKS SENSES THE FUEL LEVEL THAT IS AT "LOW LEVEL", FUEL OIL PUMPS WILL NOT RUN EVEN IF THE DAY TANKS ARE ALSO AT A LOW FUEL LEVEL. ALARM, THIS IS TO PROTECT THE FUEL OIL PUMP FROM RUNNING WITHOUT ANY FUEL AT THE FUEL OIL STORAGE TANKS.
- FOP-1 AND FOP-2 SHALL BE OPERATE ALTERNATELY.
- THE FLOAT SWITCH HAS A ELECTRONIC SWITCH ACTIVATED BY FUEL OIL LEVEL. DURING FILLING, WHEN THE DAY TANKS REACHES THE MAXIMUM SETTING OF FUEL OIL LEVEL, THE ELECTRONIC SWITCH ACTIVATE THE VALVE TO CLOSE AUTOMATICALLY. ONCE THE FUEL OIL DROPS TO MINIMUM LEVEL, THE ELECTRONIC SWITCH WILL ACTIVATE THE VALVE TO OPEN.
- THE MOTORIZED BUTTERFLY VALVE WILL SERVE AS A BACK UP VALVE IN CASE FLOAT SWITCH FAILS. THE VALVE HAS A FUEL OIL LEVEL SENSORS WHICH WILL ACTIVATE THE VALVE TO CLOSE OR OPEN WHEN MAXIMUM OR MINIMUM FUEL OIL LEVEL SETTING HAVE REACH RESPECTIVELY.
- WHEN PRESSURE IN THE MAIN HEADER REACHES THE MAX SETTING, THE PUMP WILL AUTOMATICALLY SWITCH OFF. THE PUMP WILL SWITCH ON WHEN PRESSURE DROPS TO THE MINIMUM SETTING, BUT AFTER A TIME DELAY TO PROTECT THE MOTOR AND STARTER.
- THE MOTORIZED BUTTERFLY VALVE AND TELL TALE METER IS ACTIVATED BY HIGH AND LOW SENSORS IN THE FUEL OIL STORAGE TANK. DURING FILLING, WHEN IT REACHES THE MAXIMUM OR MINIMUM LEVEL, THE MOTORIZED BUTTERFLY VALVE CLOSES OR OPEN RESPECTIVELY. WHILE THE TALE TELL METER WILL INFORM THE PERSON FILLING THE TANK THE LEVEL OF FUEL WHEN ITS FULL OR LOW.


FUEL OIL STORAGE TANK (FOP)							
UNIT DESIGNATION	QUANTITY	TANK SIZE (LITERS)	DIAMETER (MM)	LENGTH (MM)	FILLING (MM)	RETURN PIPE SIZE (MM)	REMARKS
FOP - 2	1	42,000	3000	6000	150	50	MADE OF 6.5MM THICK B.1 STEEL PLATE

FUEL OIL PUMP (FOP)					
UNIT DESIGNATION	QUANTITY	CAPACITY (GPM)	PRESSURE (PSI)	POWER RATING (HP)	ELECTRICAL DATA
FOP - 3 & 4	2	58	100	5	400V/3P/60Hz
					241
					535
					POSITIVE DISPLACEMENT ROTARY GEAR PUMP

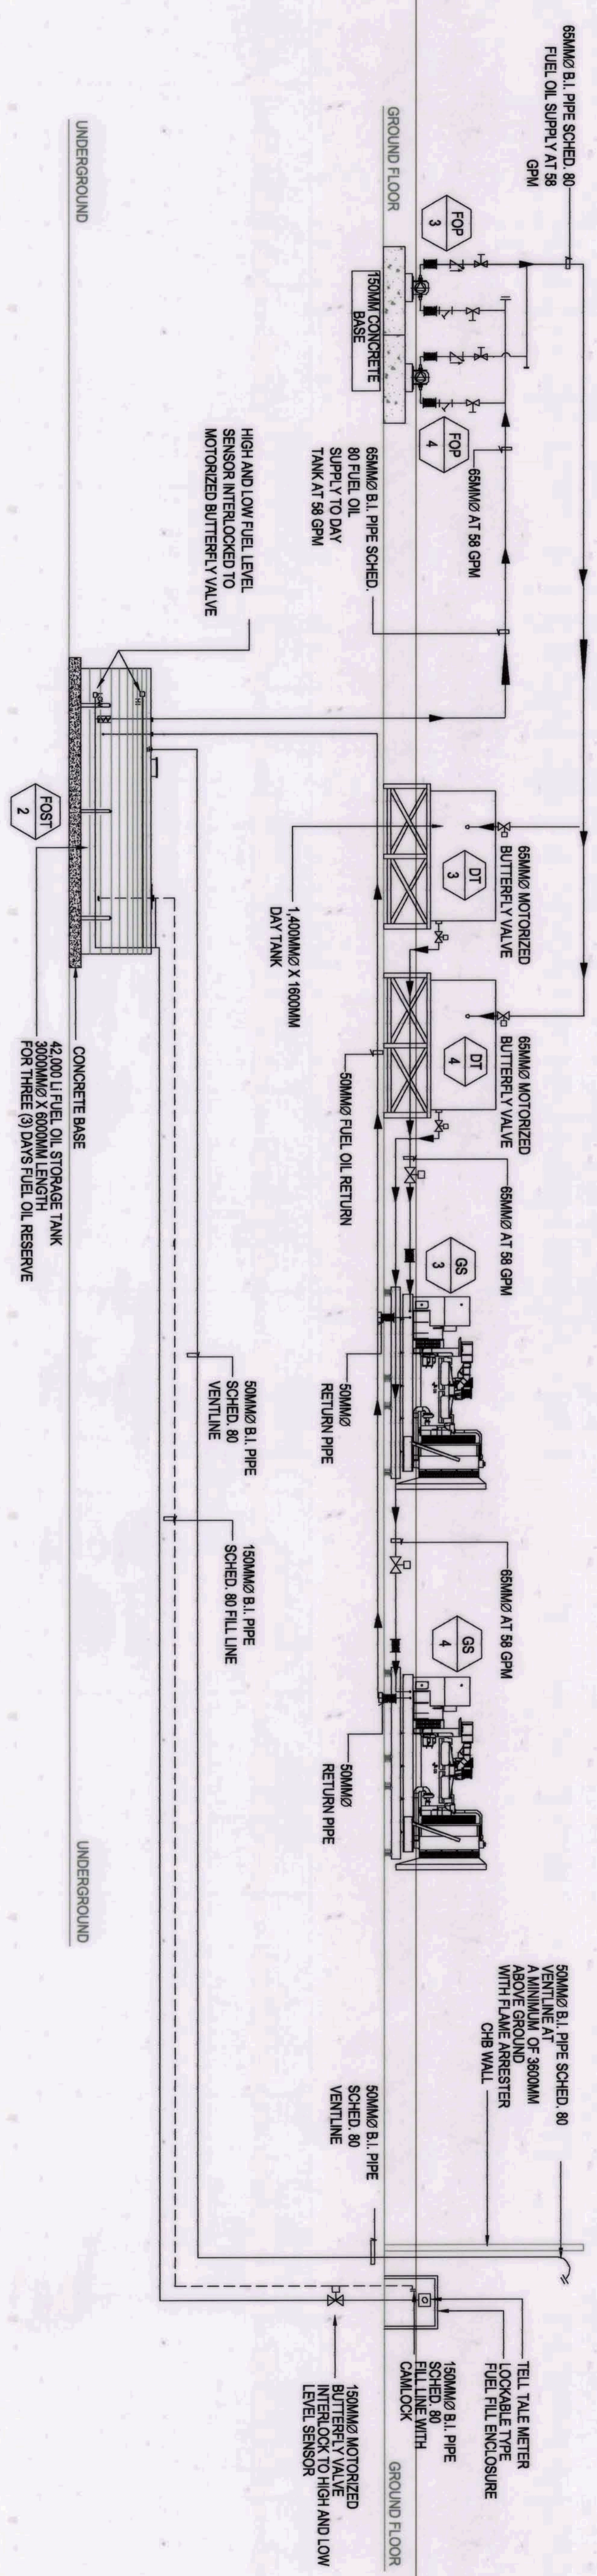


FUEL SYSTEM SCHEMATIC DIAGRAM (NORTH EAST)  
SCALE: 1" = 10'-0"

OWNER: NGAC PHASE 1 JV COMPANY	PREPARED BY: HILL M A R C ' S CONSTRUCTION CORPORATION	REVIEWED AND VALIDATED BY: FILIPINAS DRAVO CORPORATION	SUBMITTED BY: BANDAR HERBAT BUILDERS, INC.	CERTIFIED BY: INDEPENDENT CONSULTANT: TCGI ENGINEERS	PROJECT TITLE: AS-BUILT DRAWING	SHEET NO.:
AND: MTD GROUP INC. AND PATRICK NICHOLAS DAVID	ANGELITO L. OLLERES	ALFREDO R. REVILLA	ISAAC S. DAVID	VIRGILIO A. MADRADO	NGAC PHASE 1A ATHLETICS STADIUM (MECHANICAL)	FUEL SYSTEM SCHEMATIC DIAGRAM (NORTH EAST)
						M4-02

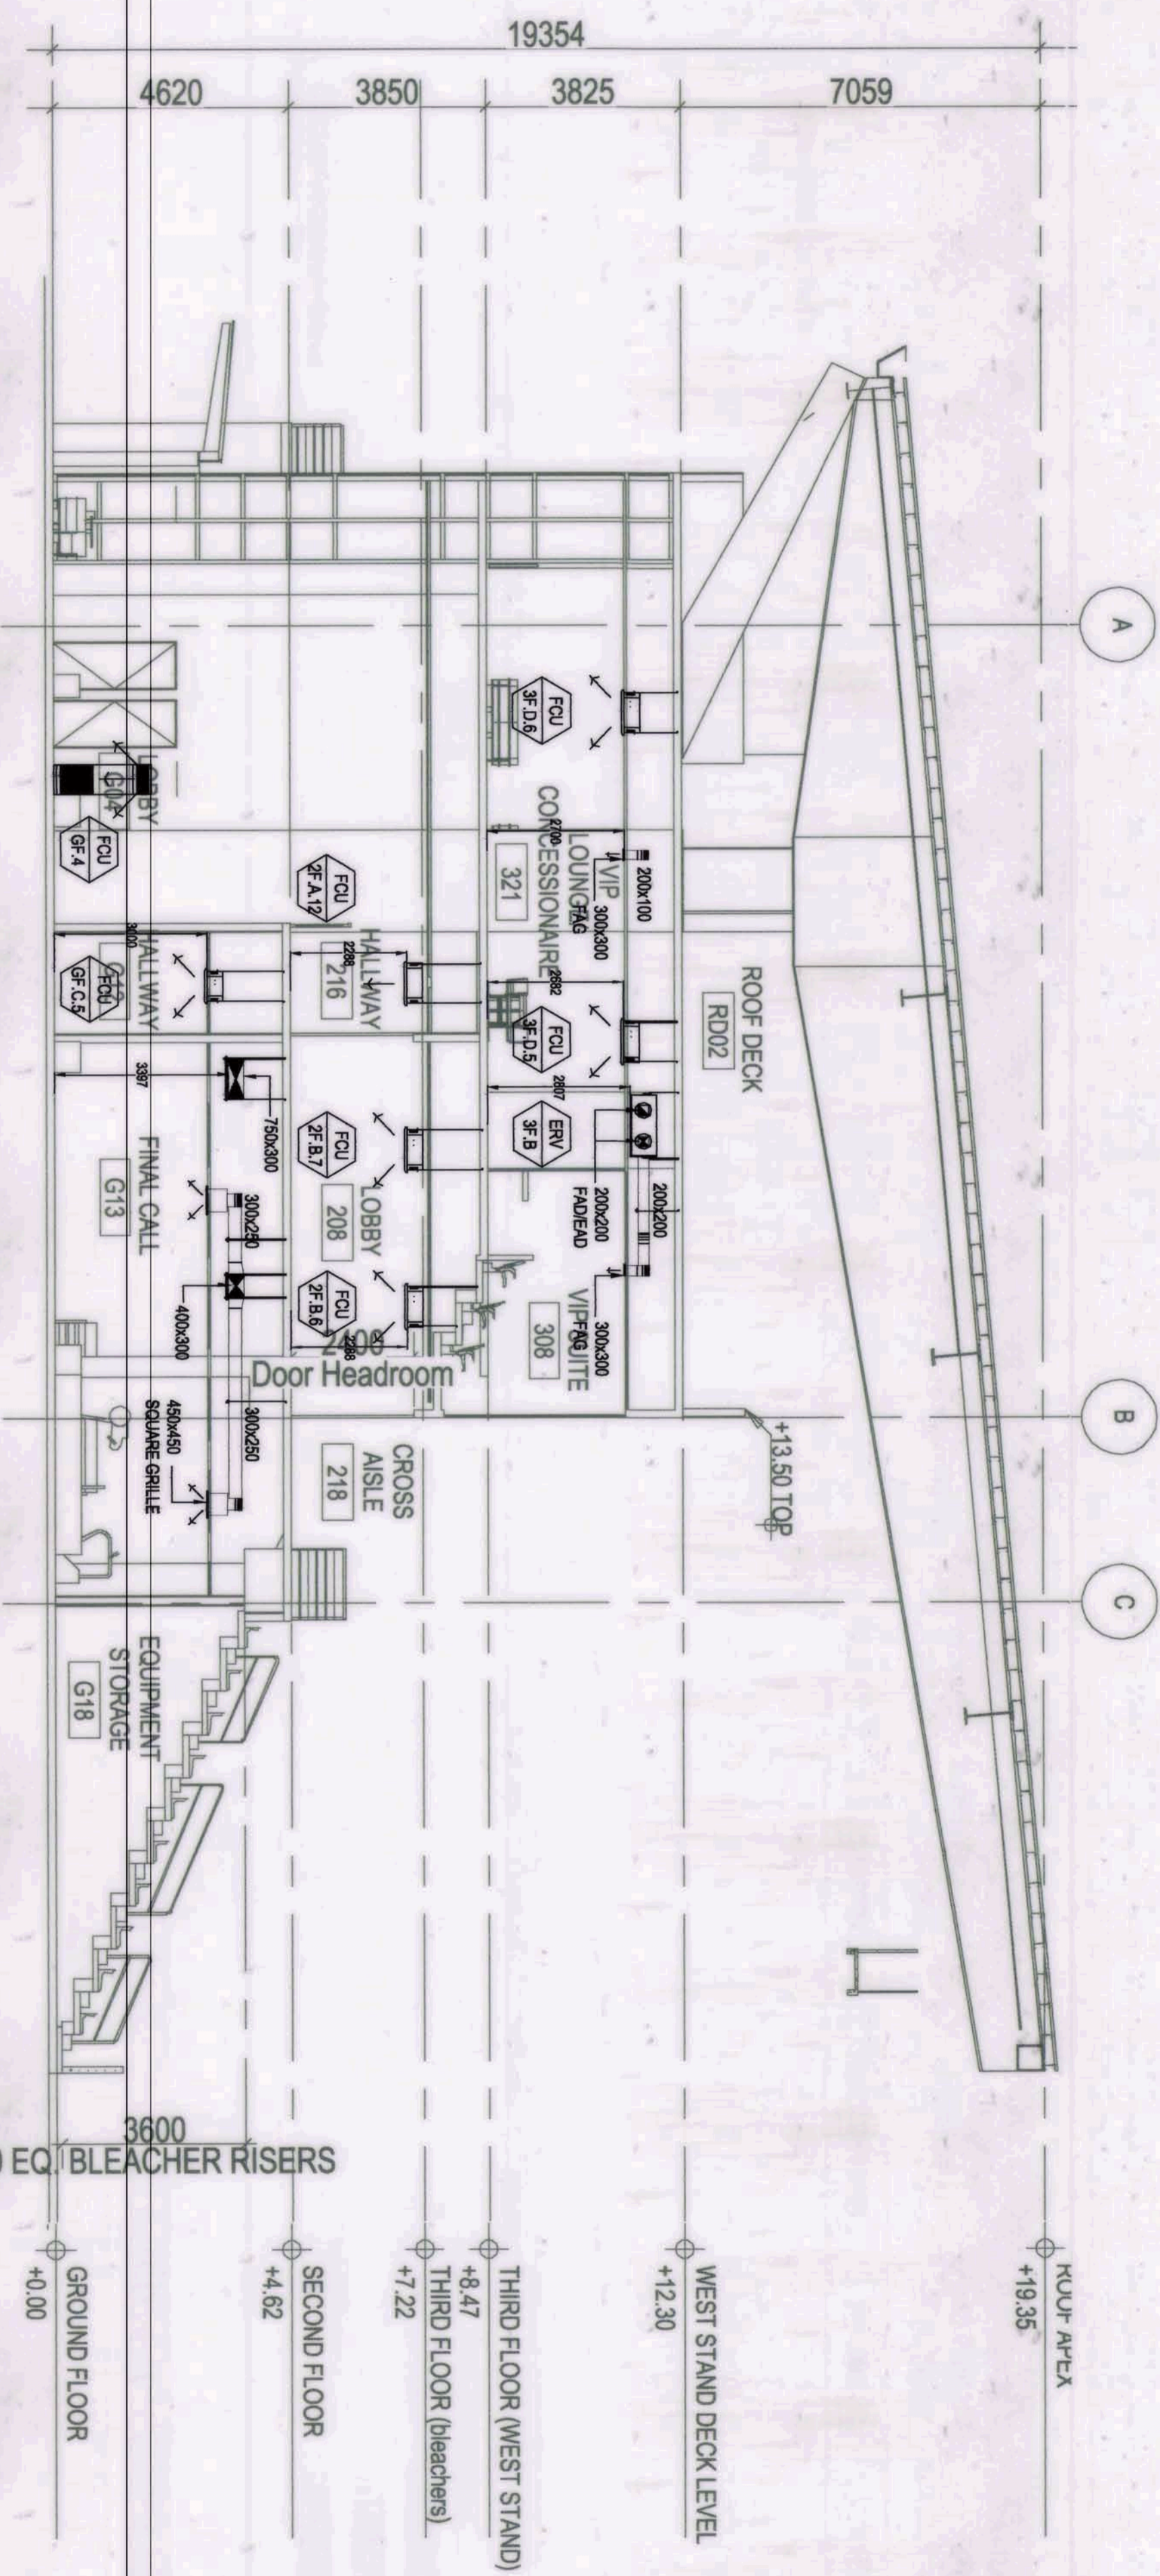

1 CROSS SECTION A  
SCALE 1:100

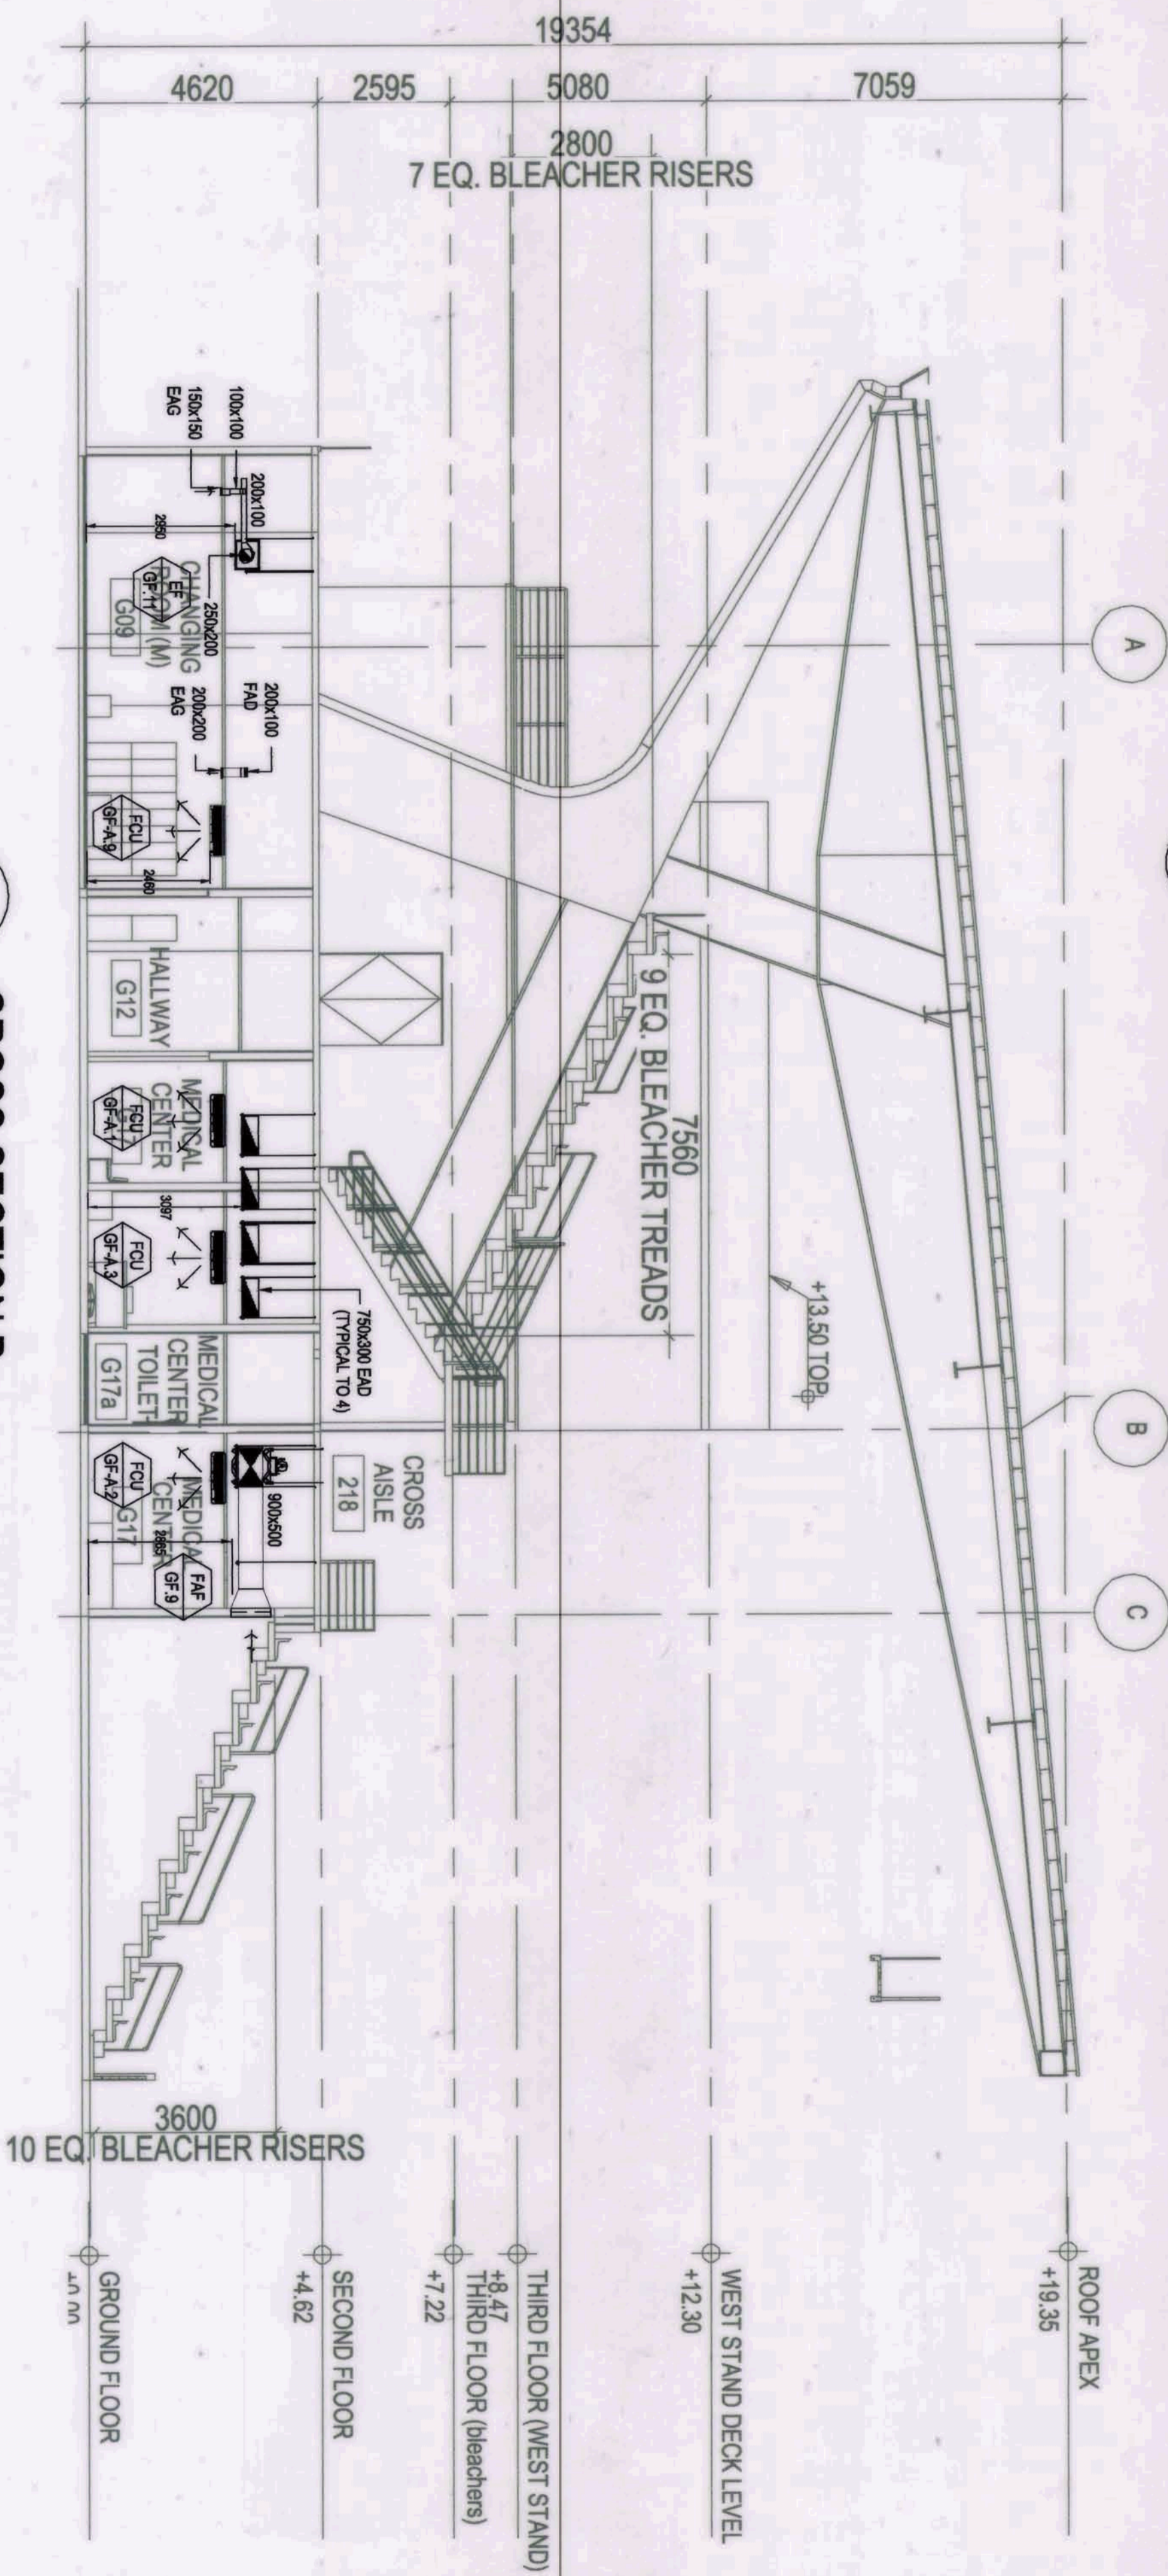


2 CROSS SECTION B  
SCALE 1:100

OWNER: NGAC PHASE 1 JV COMPANY	PREPARED BY:	REVIEWED AND VALIDATED BY:	SUBMITTED BY:	CERTIFIED BY INDEPENDENT CONSULTANT	PROJECT TITLE:	SHEET CONTENTS:	SHEET NO.
BCDA AND MTC PATRICK INQUIRAS L. DAVID	HIL M A R C ' S CONSTRUCTION CORPORATION ANGELITO L. OLIVERES	FILIPINAS DRAVO CORPORATION ALFREDO R. REVILLA	BANDAR HEBAT BUILDERS, INC. ISMAEL S. DAVID	TCGI ENGINEERS VIRGILIO A. MADRZO	AS-BUILT DRAWING NGAC PHASE 1A ATHLETICS STADIUM (MECHANICAL) NEW CLARK CITY, CARPAS TARLAC	CROSS SECTION	M5-01


ELEVATOR BRANDS TABULATION									
BRAND	RATED CAPACITY (KG)	MAX. NO. OF PERSONS	NO. OF STOPS	RATED SPEED (M/S)	DOOR OP WIDTH (MM)	CAR INTERNAL SIZE (MM)	HOISTWAY (MM)	OVERHEAD HEIGHT (MM)	MINIMUM PIT DEPTH (MM)
IFE	800	10	3	1	800	1200X1400	1981X1926	4409	1350

ELEVATOR ELECTRICAL DATA		
MOTOR CAPACITY (KW)	SUPPLY VOLTAGE (V)	BREAKER CAPACITY (A)
5.3	400V/3PH	125

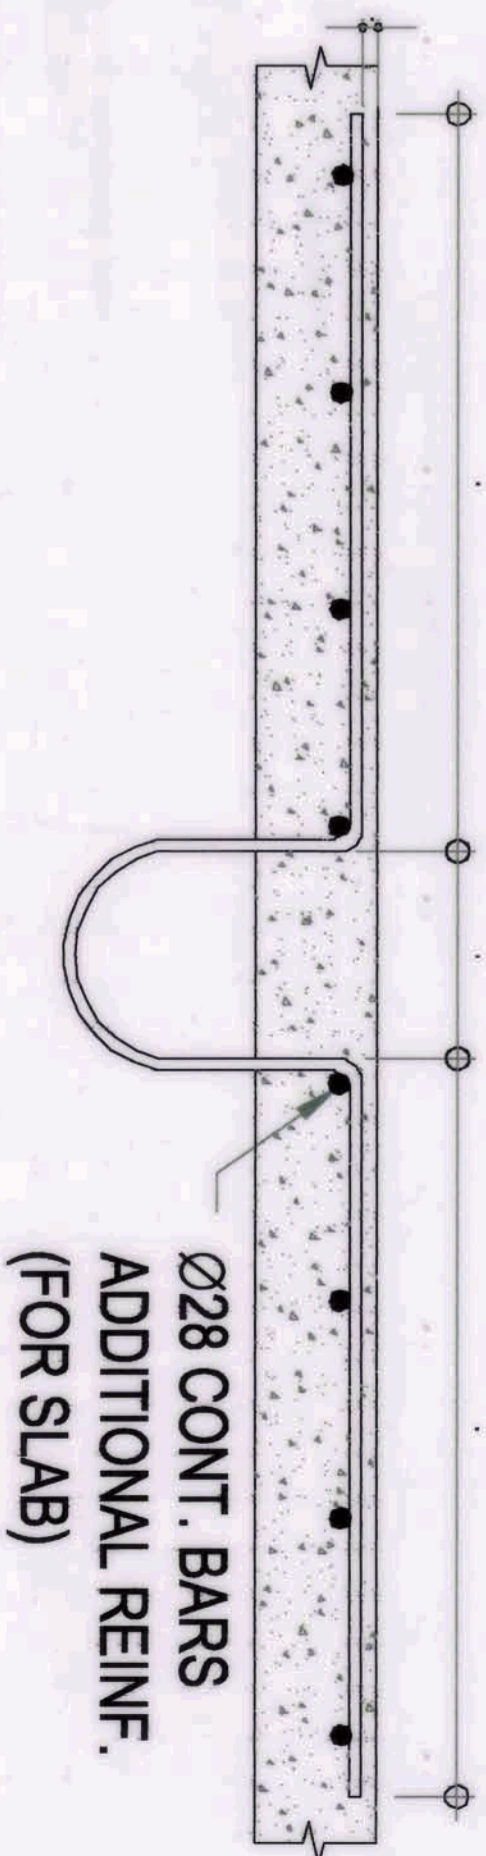


TYPICAL HOISTING HOOKS DETAIL

SCALE: 1:20

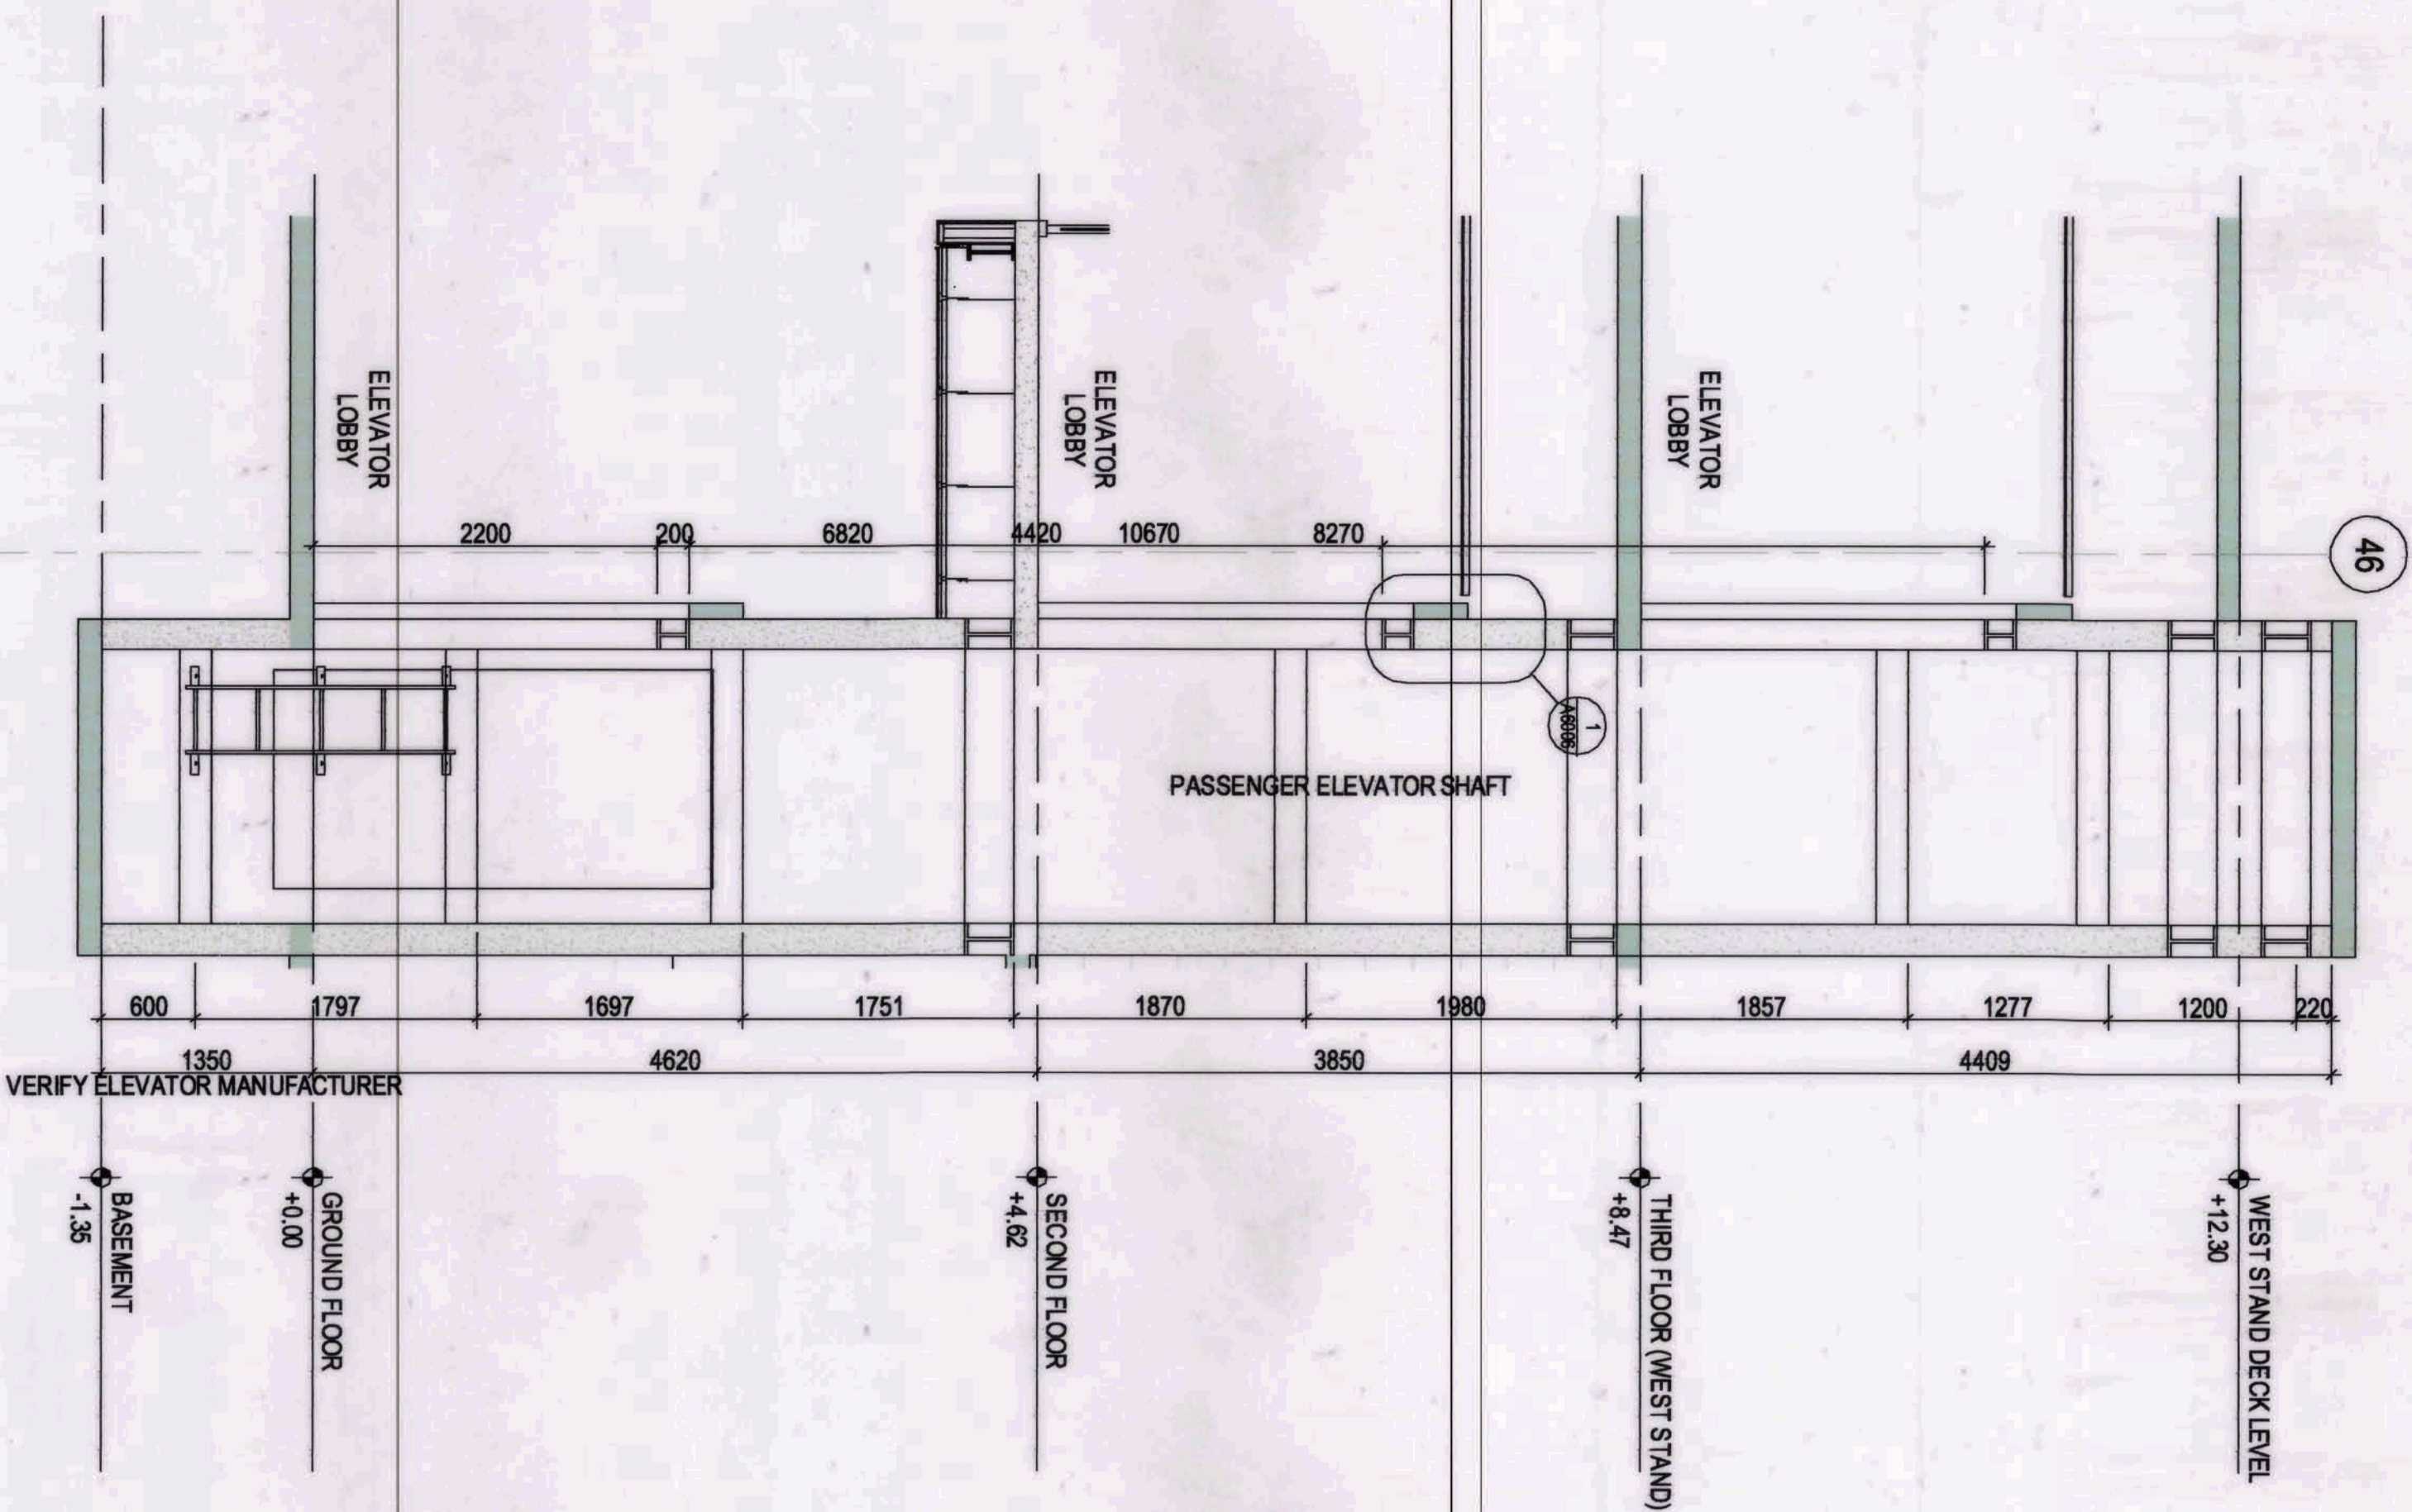

ELEVATOR SECTION

SCALE: 1:40


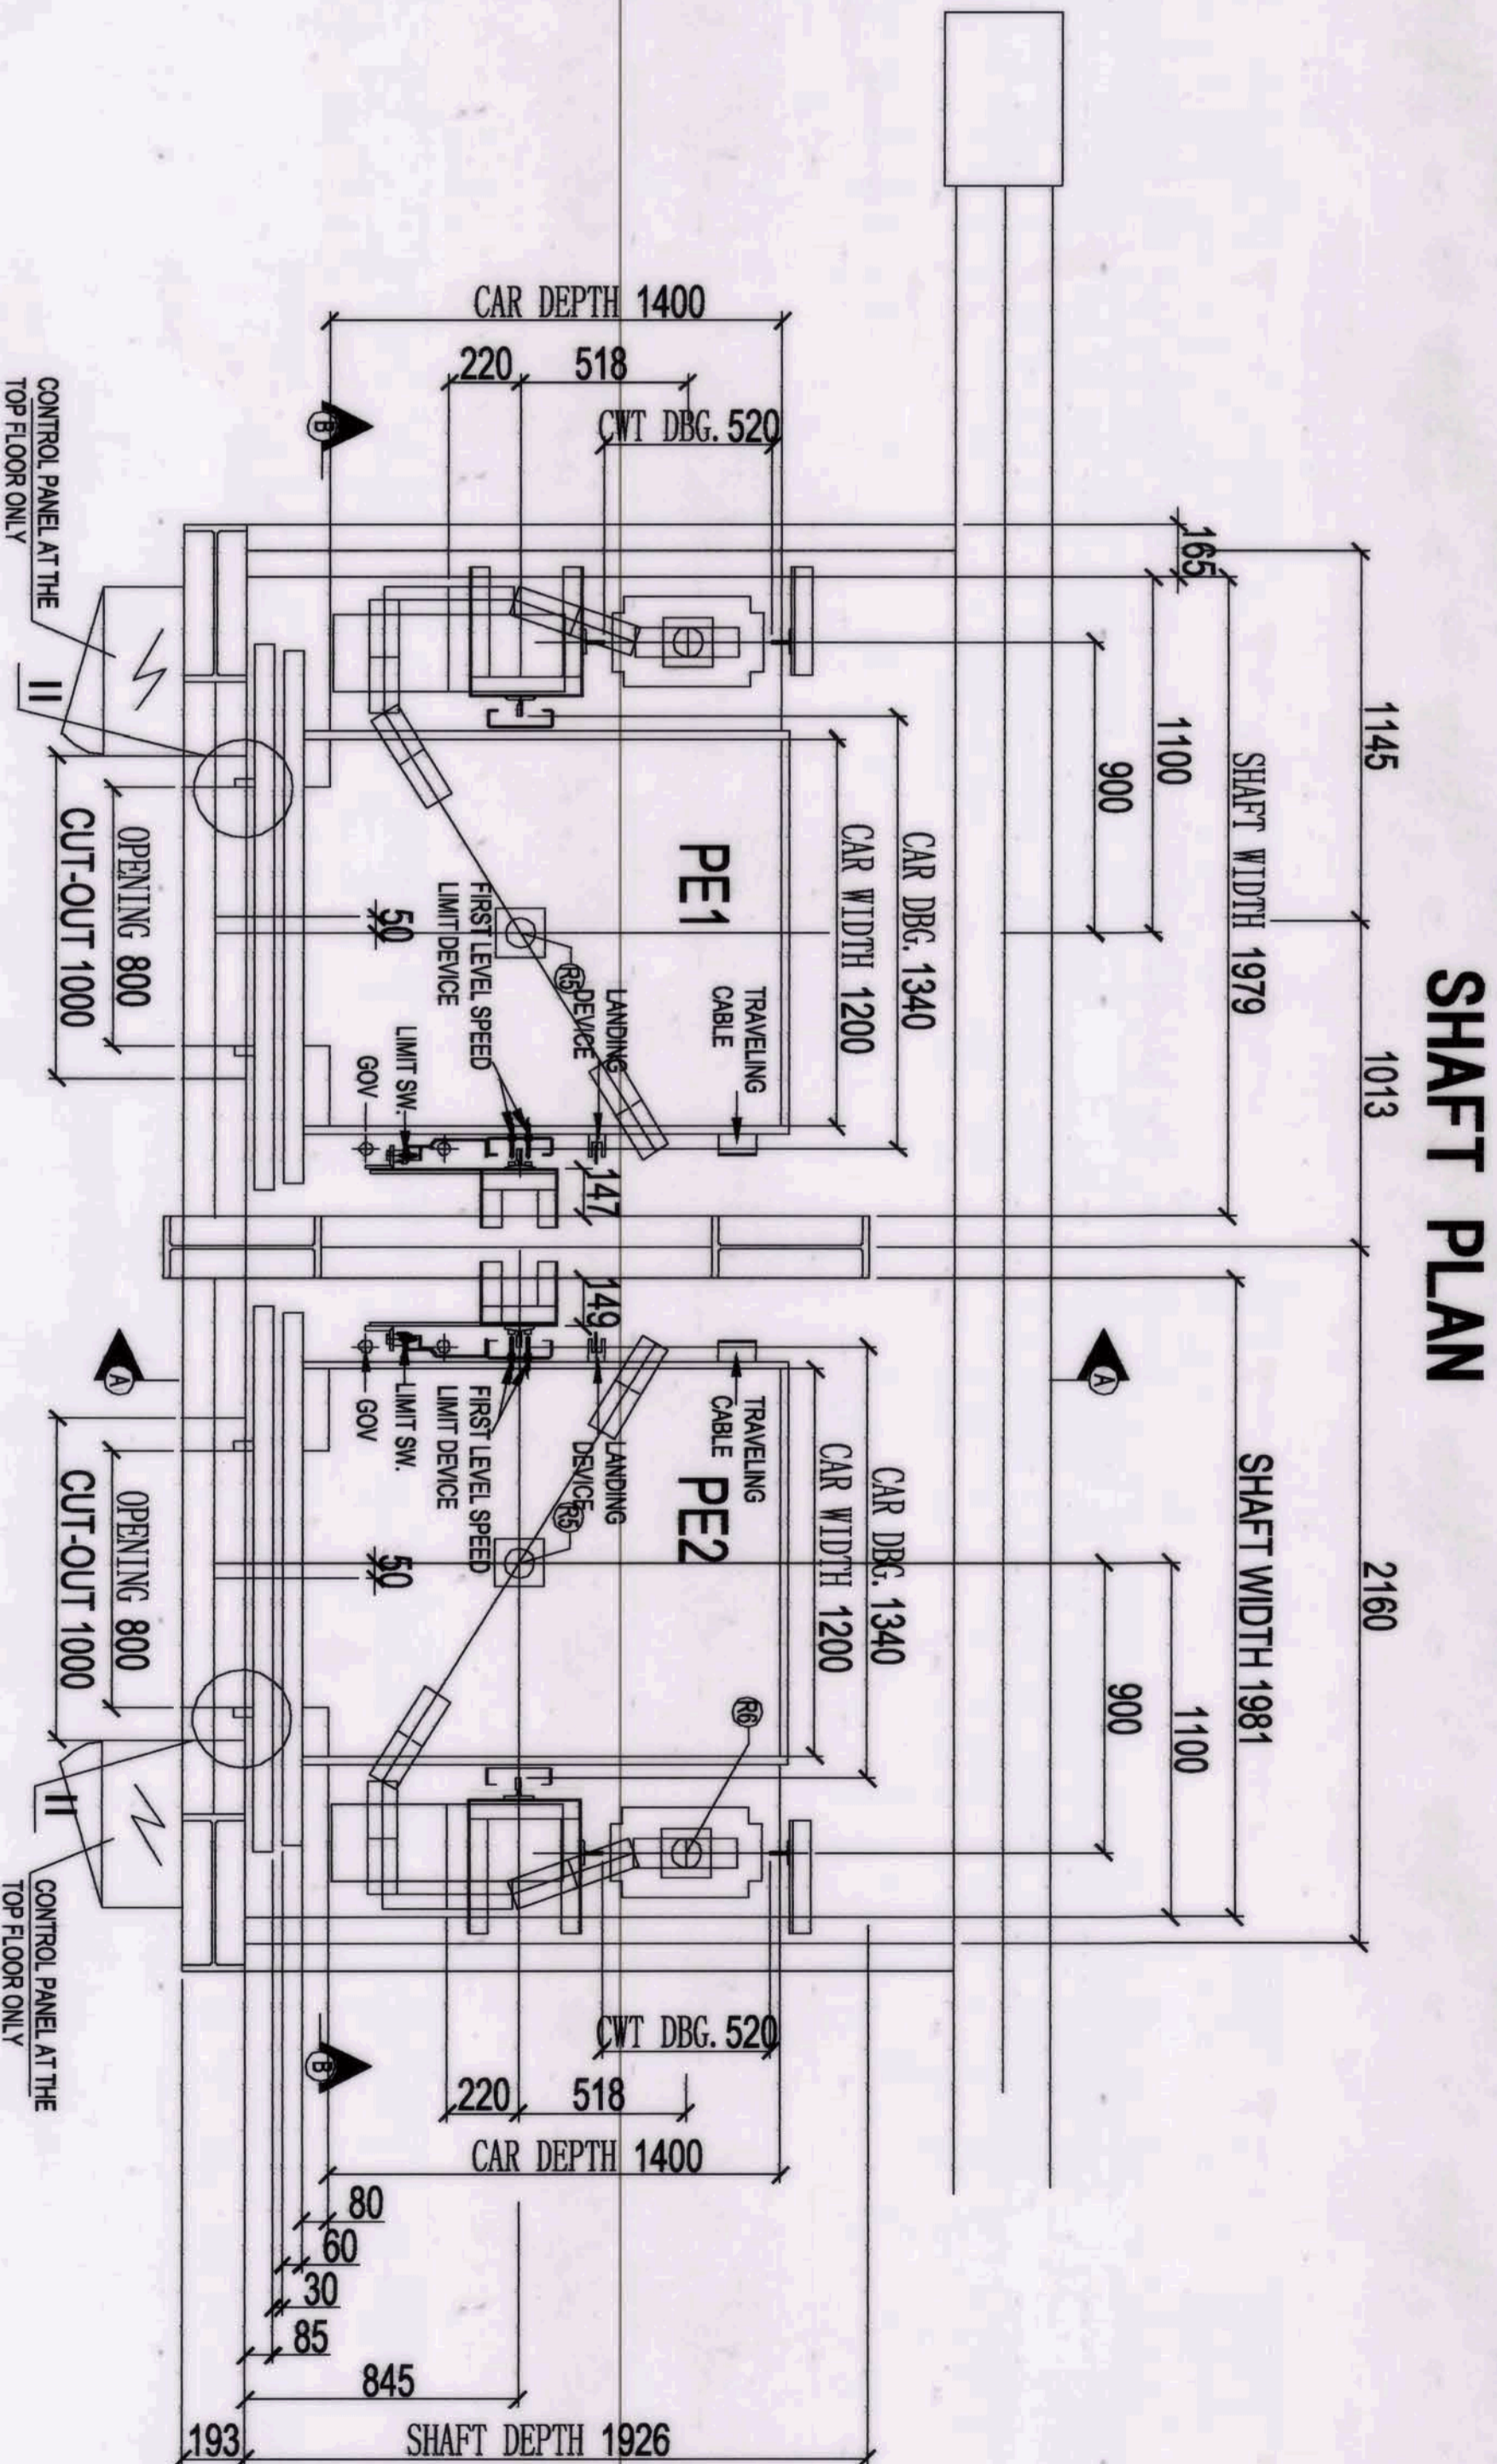


ELEVATOR LAY-OUT


SCALE: 1:20

OWNER: NGAC PHASE 1A COMPANY	PREPARED BY:	REVIEWED AND VALIDATED BY:	SUBMITTED BY:	CERTIFIED BY: INDEPENDENT CONSULTANT	PROJECT TITLE:	SHEET CONTENTS:	SHEET NO.:
BCDA AND JMD Clark, Inc. VIVENCIO B. DEON PATRICK NICHOLAS P. DAVID	HILMAR C'S CONSTRUCTION CORPORATION ANGELITO L. OLIVERES	FILIPINAS DRAVO CORPORATION Alfred R. Revilla	BANDAR HEBAT BUILDERS, INC. ISAACS DAVID	TCGI ENGINEERS VIRGILIO A. MADRADO	AS-BUILT DRAWING NGAC PHASE 1A ATHLETICS STADIUM (ARCHITECTURAL) NEW CLARK CITY, CAPAS TARLAC	ELEVATOR LAYOUT AND SECTION	M6-01



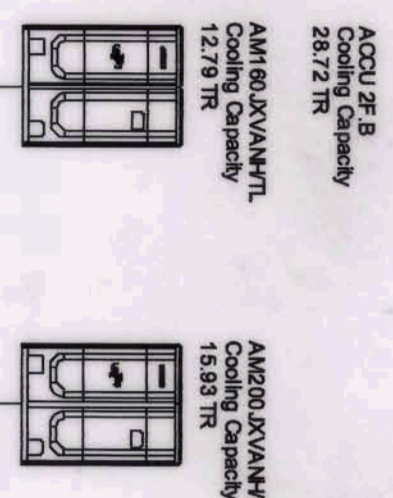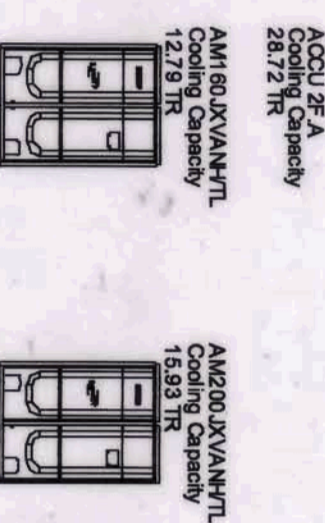


1  
M7-02

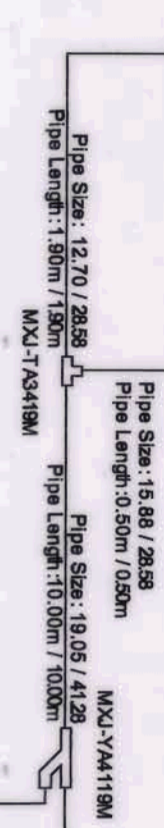

2  
M7-02

OWNER: NGAC PHASE 1 JV COMPANY	PREPARED BY:	REVIEWED AND VALIDATED BY:	SUBMITTED BY:	CERTIFIED BY: INDEPENDENT CONSULTANT	PROJECT TITLE:	SHEET CONTENTS:	SHEET NO.
 <b>BCDA</b> BOARD OF CONDOMINIUM DEVELOPERS ASSOCIATION AND  <b>HMD</b> HILMARC'S CONSTRUCTION CORPORATION 1102 KALIBRAHAN RD., ANTHEM CATALAN CANTON CITY 1102 KALIBRAHAN RD., ANTHEM CATALAN CANTON CITY TEL: (02) 8852-1100 FAX: (02) 8852-1101 E-MAIL: hmd@hmdcorp.com	 <b>HILMARC'S</b> CONSTRUCTION CORPORATION 1102 KALIBRAHAN RD., ANTHEM CATALAN CANTON CITY 1102 KALIBRAHAN RD., ANTHEM CATALAN CANTON CITY TEL: (02) 8852-1100 FAX: (02) 8852-1101 E-MAIL: hmd@hmdcorp.com	 <b>FILIPINAS DRAVO CORPORATION</b> Architectural & Engineering Consultants 1102 KALIBRAHAN RD., ANTHEM CATALAN CANTON CITY 1102 KALIBRAHAN RD., ANTHEM CATALAN CANTON CITY TEL: (02) 8852-1100 FAX: (02) 8852-1101 E-MAIL: hmd@hmdcorp.com	 <b>BANDAR HEBAT BUILDERS, INC.</b> 1102 KALIBRAHAN RD., ANTHEM CATALAN CANTON CITY 1102 KALIBRAHAN RD., ANTHEM CATALAN CANTON CITY TEL: (02) 8852-1100 FAX: (02) 8852-1101 E-MAIL: hmd@hmdcorp.com	 <b>TCGI ENGINEERS</b> 1102 KALIBRAHAN RD., ANTHEM CATALAN CANTON CITY 1102 KALIBRAHAN RD., ANTHEM CATALAN CANTON CITY TEL: (02) 8852-1100 FAX: (02) 8852-1101 E-MAIL: hmd@hmdcorp.com	<b>AS-BUILT DRAWING</b> NGAC PHASE 1A ATHLETICS STADIUM (MECHANICAL) NEW CLARK CITY, CAPAS TARIAC	SECOND FLOOR REFRIGERANT PIPING DIAGRAM (ACCU-2F-A/ACCU-2F-B) <b>M7-02</b>	

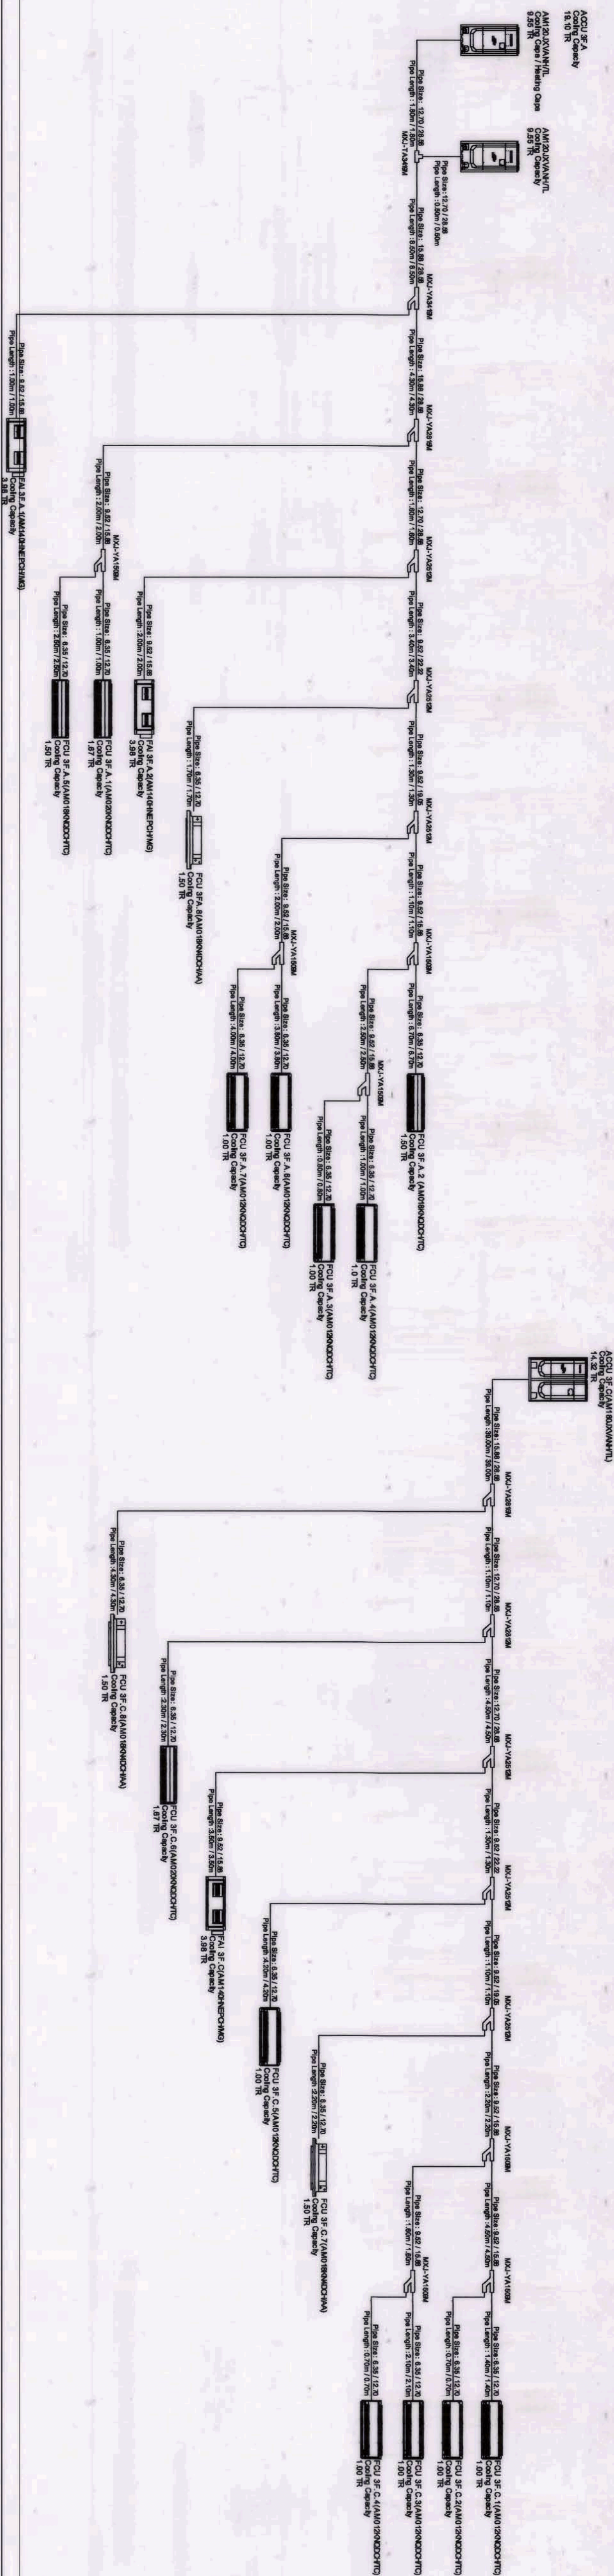

1 THIRD FLOOR REFRIGERANT PIPING DIAGRAM (ACCU-3F.A)  
M7-03 SCALE: NTS






3 THIRD FLOOR REFRIGERANT PIPING DIAGRAM (ACCU-3F.C)  
M7-03 SCALE: NTS



2 THIRD FLOOR REFRIGERANT PIPING DIAGRAM (ACCU-3F.B)  
M7-03 SCALE: NTS

4 THIRD FLOOR REFRIGERANT PIPING DIAGRAM (ACCU-3F.D)  
M7-03 SCALE: NTS

OWNER: NGAC PHASE 1 JV COMPANY	PREPARED BY:	REVIEWED AND VALIDATED BY:	SUBMITTED BY:	CERTIFIED BY: INDEPENDENT CONSULTANT	PROJECT TITLE:	SHEET CONTENTS:	SHEET NO.
AND VIVENCIO B. OJON PATRICK NICOLAS P. DAVID	HIL MARC'S CONSTRUCTION CORPORATION THE EPOCH BUILDERS ANGELITO L. OLLERES	FLIPINAS DRAVO CORPORATION Architectural & Engineering Consultants ALFREDO R. REVILLA	BANDAR HEBAT BUILDERS, INC. ISAACS. DAVID	TCGI ENGINEERS VIRGILIO A. MABRZO	AS-BUILT DRAWING NGAC PHASE 1A ATHLETICS STADIUM (MECHANICAL) NEW CLARK CITY, CAPAS TARLAC	GROUND FLOOR REFRIGERANT PIPING DIAGRAM (ACCU-3F.A/ACCU-3F.B/ ACCU-3F.C & ACCU-3F.D)	M7-03

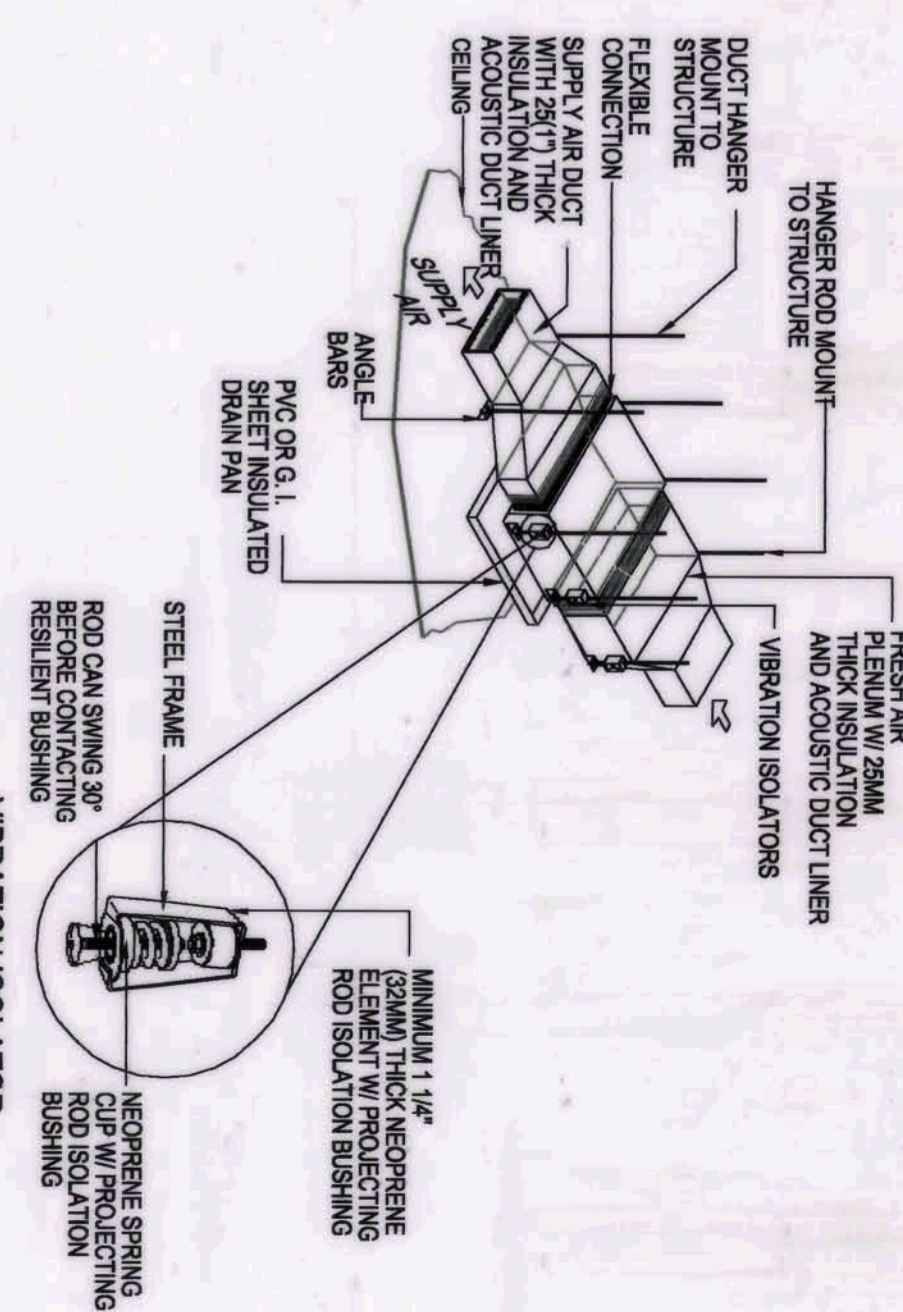
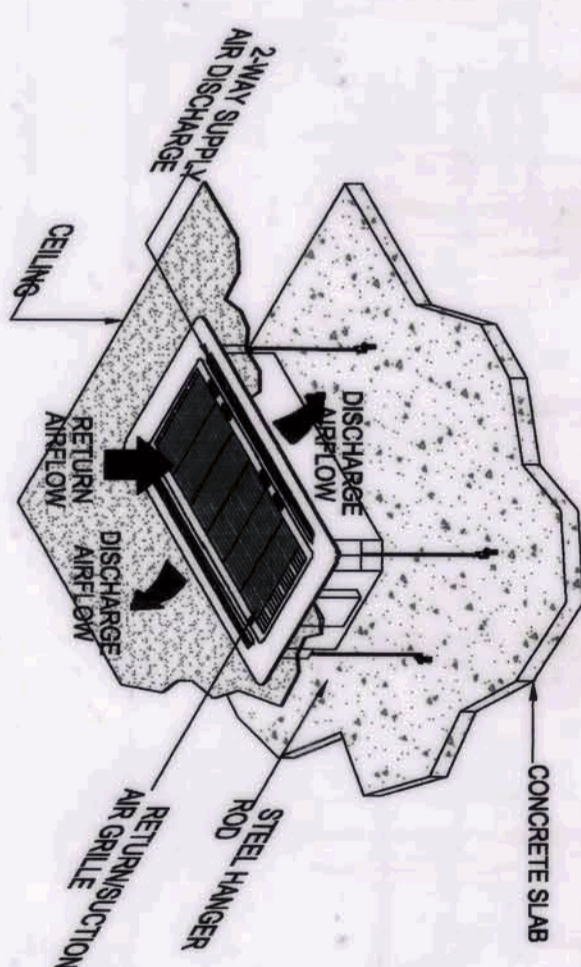
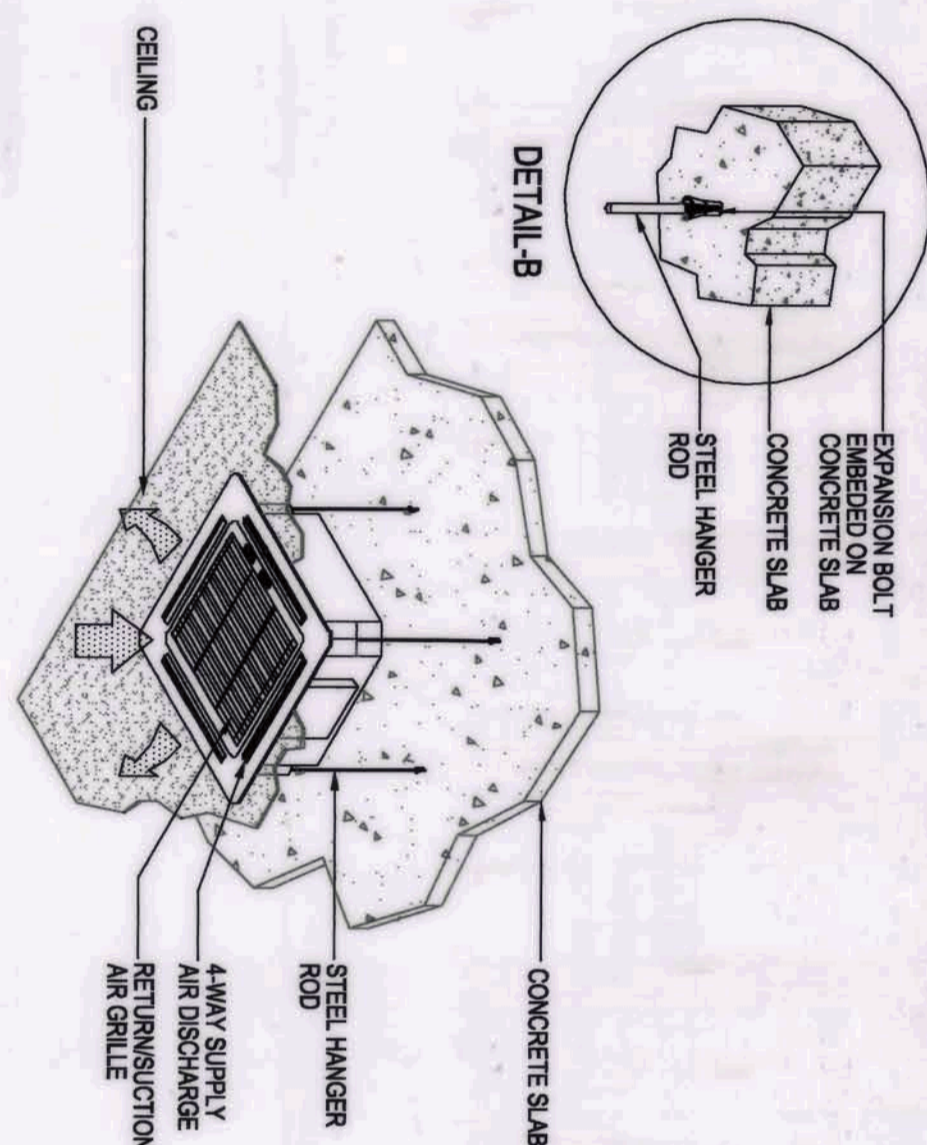
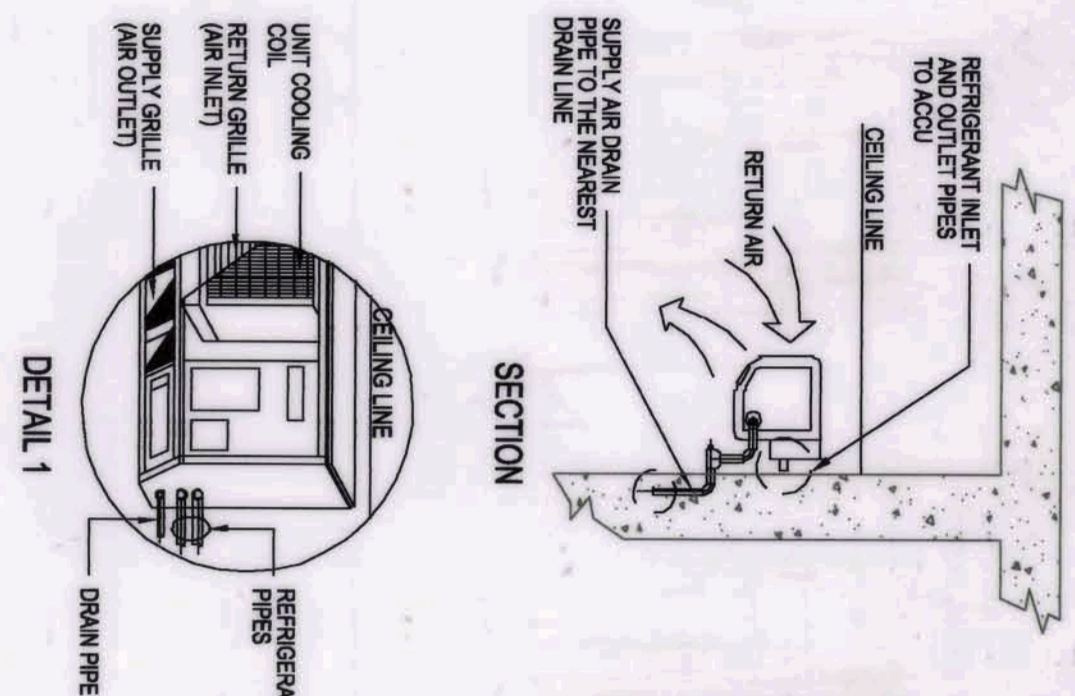
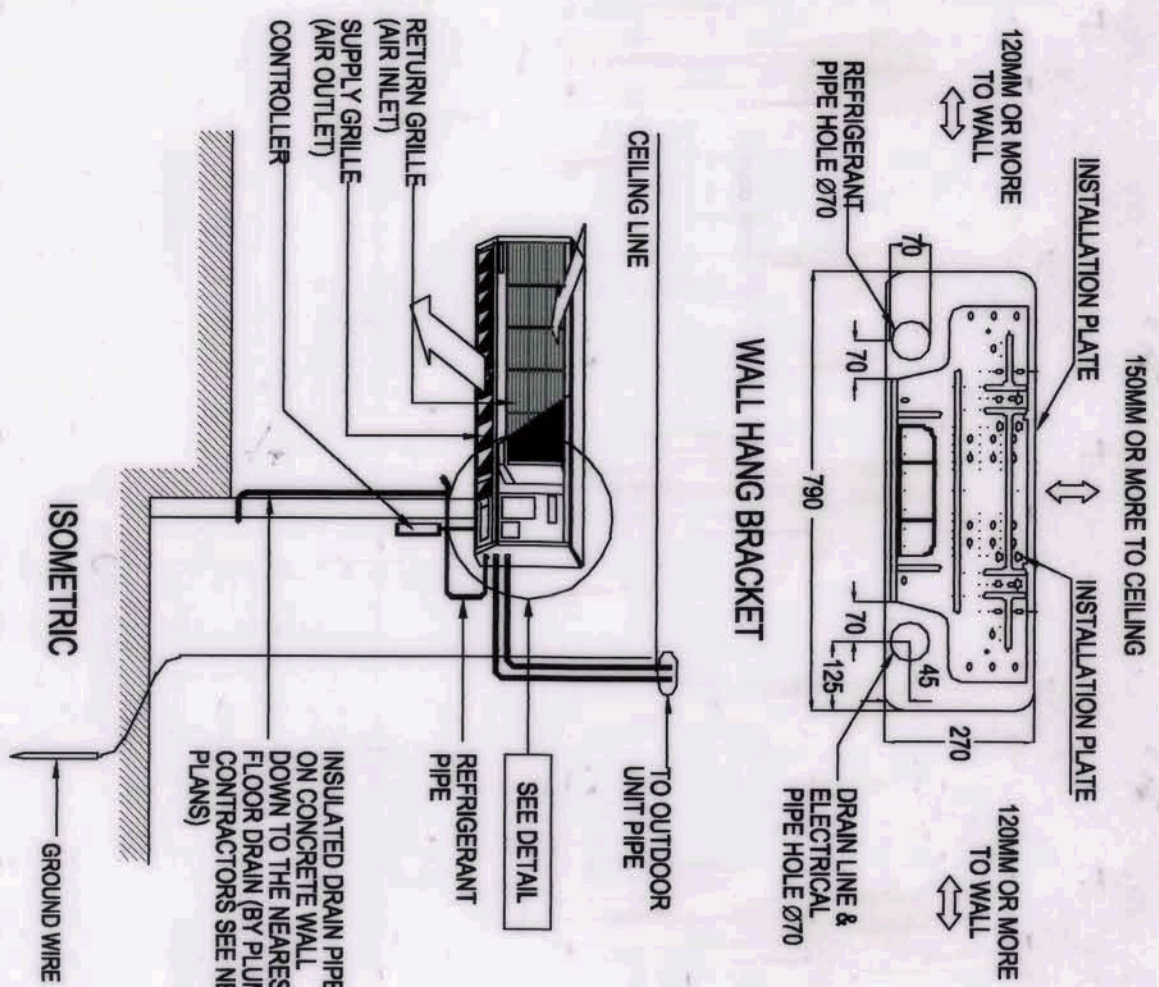


1 TYPICAL FCU WALL MOUNTED INSTALLATION  
SCALE: MB-01 NOT TO SCALE

2 TYPICAL CEILING CASSETTE (4-WAY) FCU MOUNTING  
SCALE: MB-01 NOT TO SCALE

3 TYPICAL CEILING CASSETTE (DOUBLE FLOW) FCU MOUNTING  
SCALE: MB-01 NOT TO SCALE

4 FRESH AIR INTAKE MOUNTING  
SCALE: MB-01 NOT TO SCALE

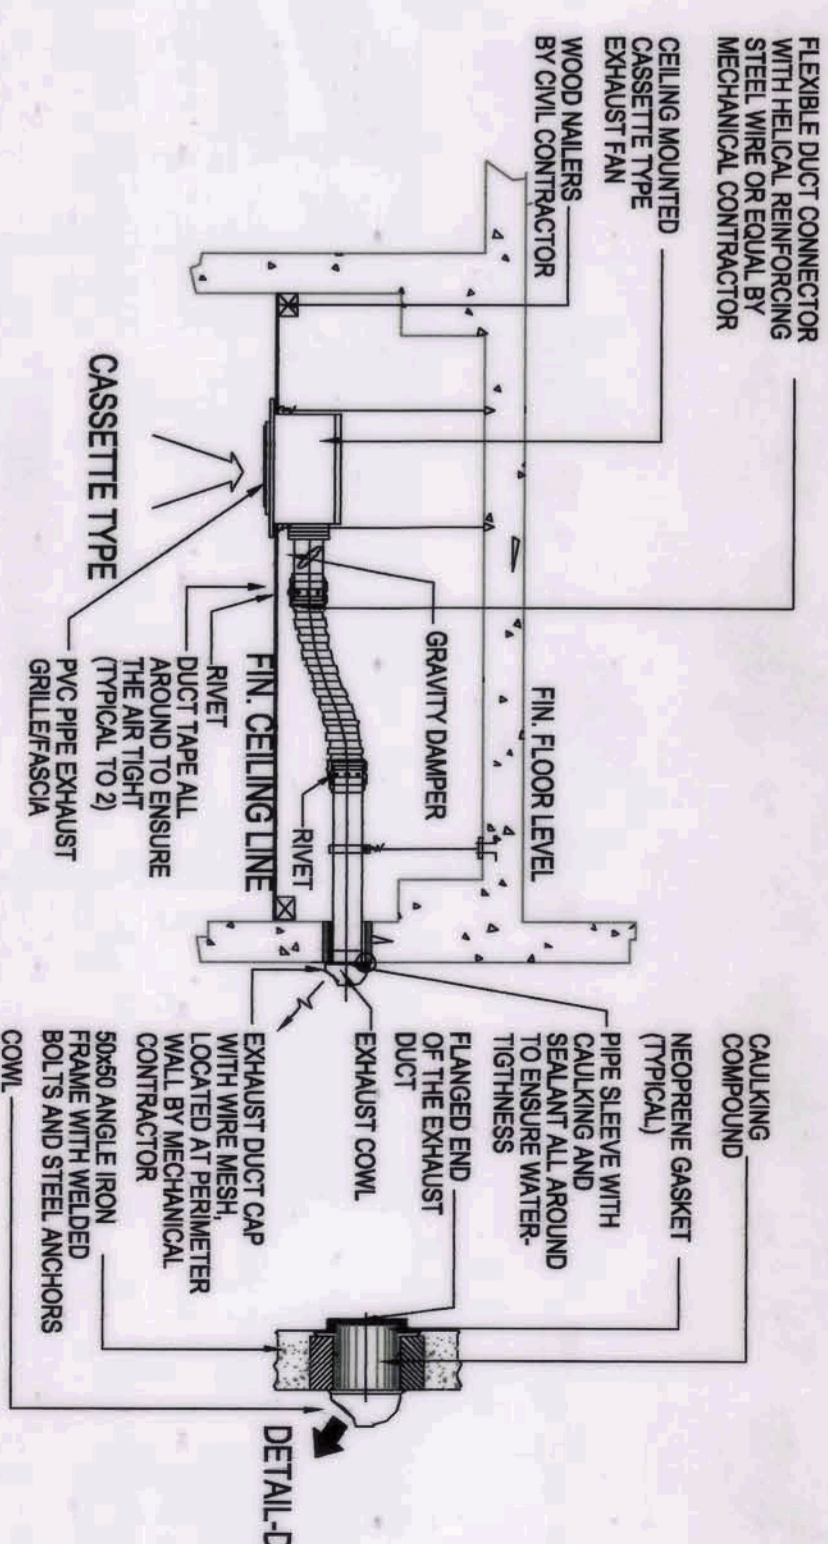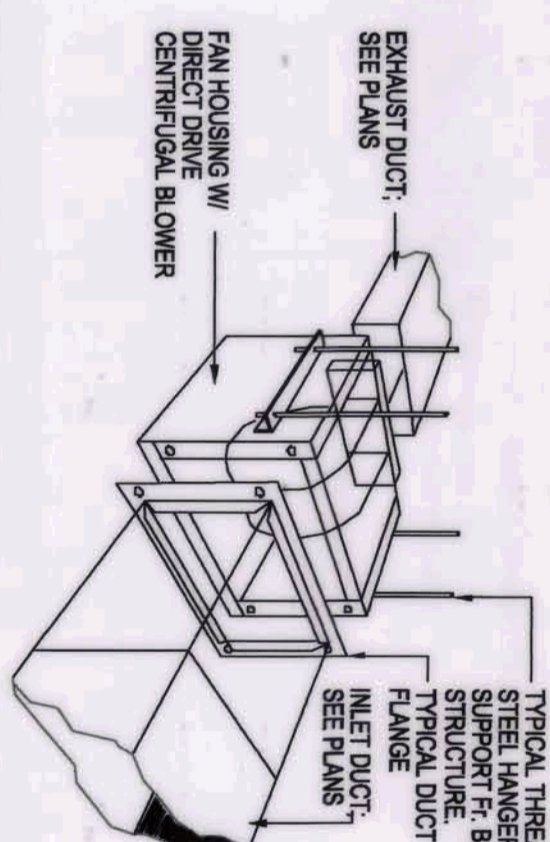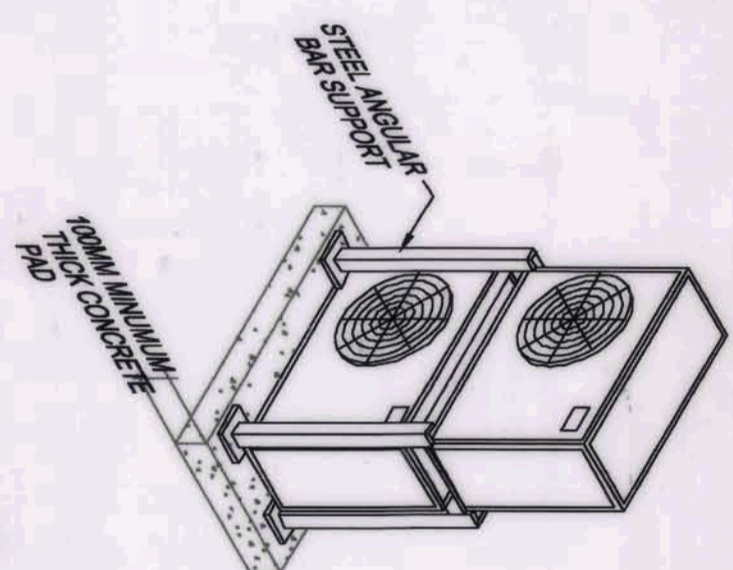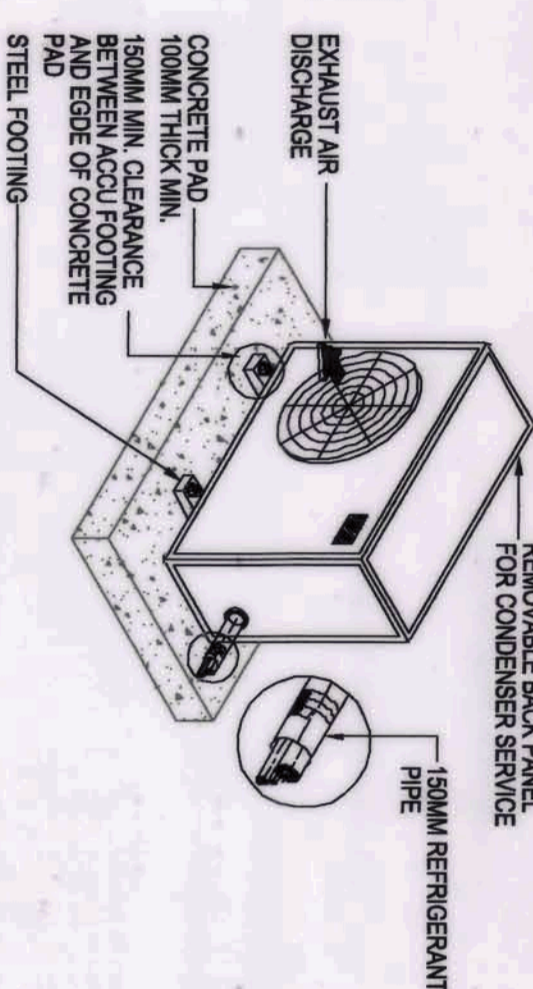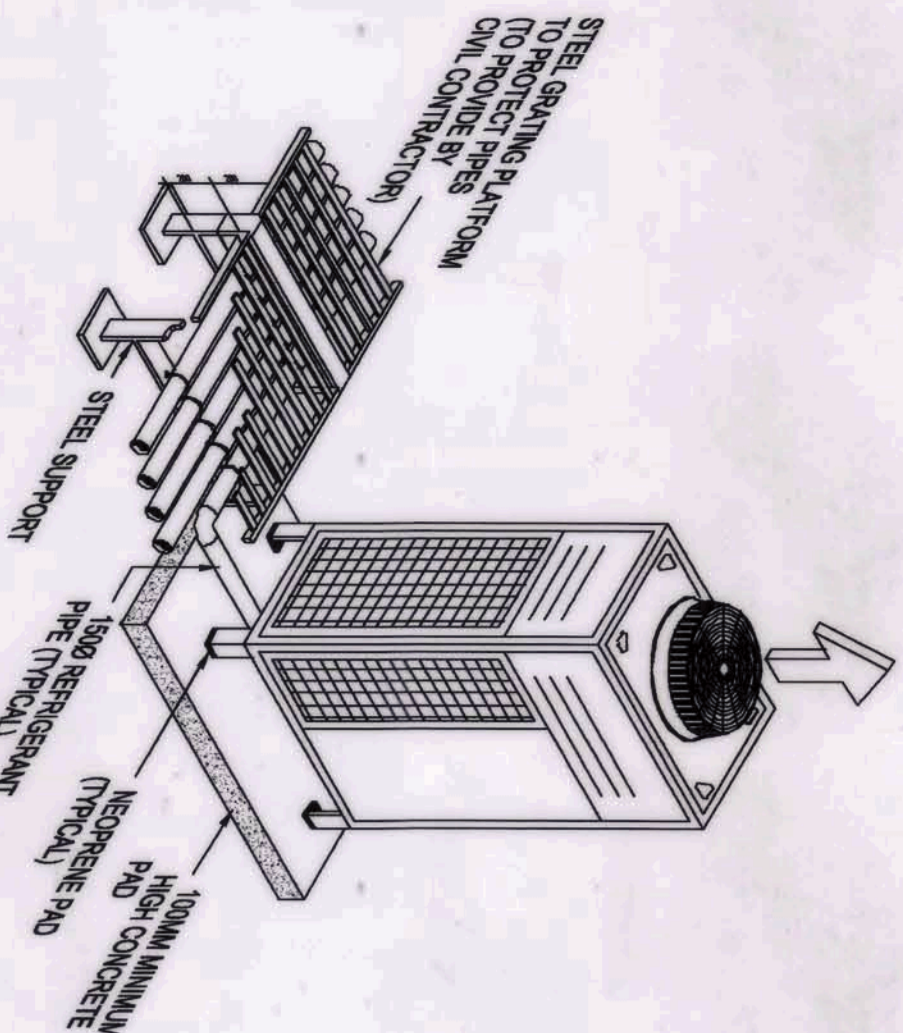


5 ACCU & REFRIGERANT PIPING STEEL GRATING MOUNTING  
SCALE: MB-01 NOT TO SCALE

6 TYPICAL ACCU MOUNTING DETAIL  
SCALE: MB-01 NOT TO SCALE

7 ACCU MOUNTING  
SCALE: MB-01 NOT TO SCALE

8 CABINET IN-LINE FAN  
SCALE: MB-01 NOT TO SCALE

9 CASSETTE TYPE EXHAUST FAN DETAIL  
SCALE: MB-01 NOT TO SCALE

















































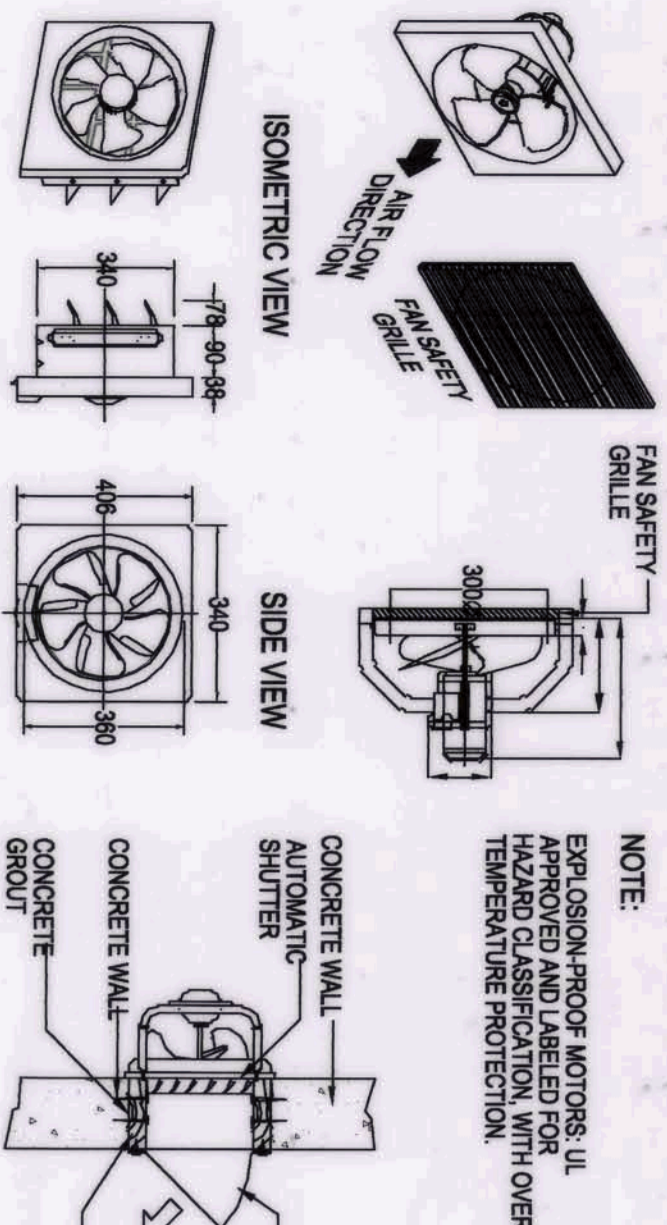


10 WALL MOUNTED EXHAUST FAN DETAIL  
SCALE: MB-01 NOT TO SCALE



11 HORIZONTAL CEILING HUNG VANE AXIAL FAN  
SCALE: MB-01 NOT TO SCALE

12 EXHAUST AIR GRILLE INSTALLATION  
SCALE: MB-01 NOT TO SCALE


13 TYPICAL LOWERED DOOR  
SCALE: MB-01 NOT TO SCALE

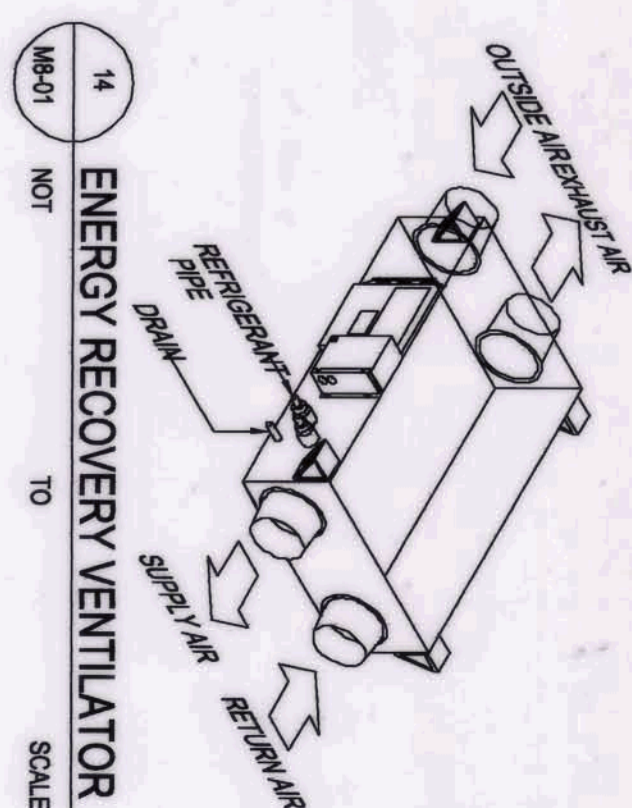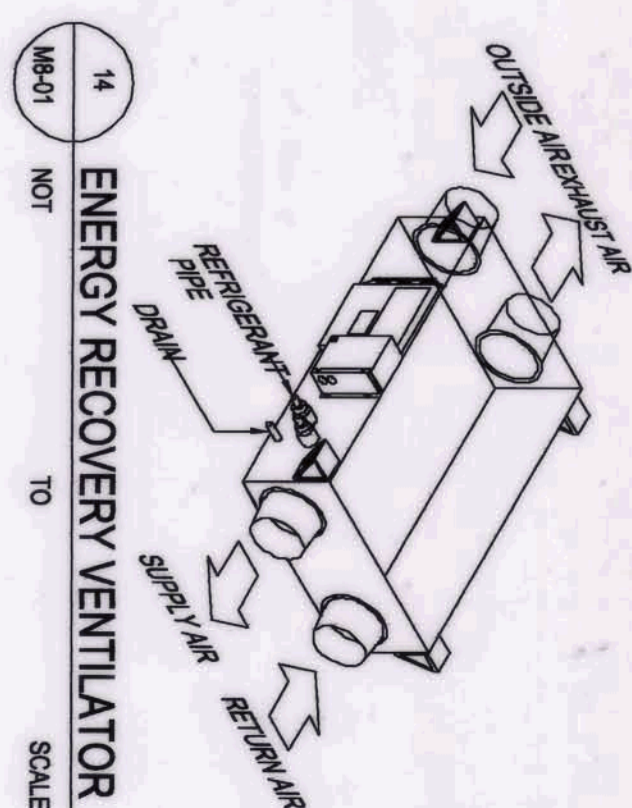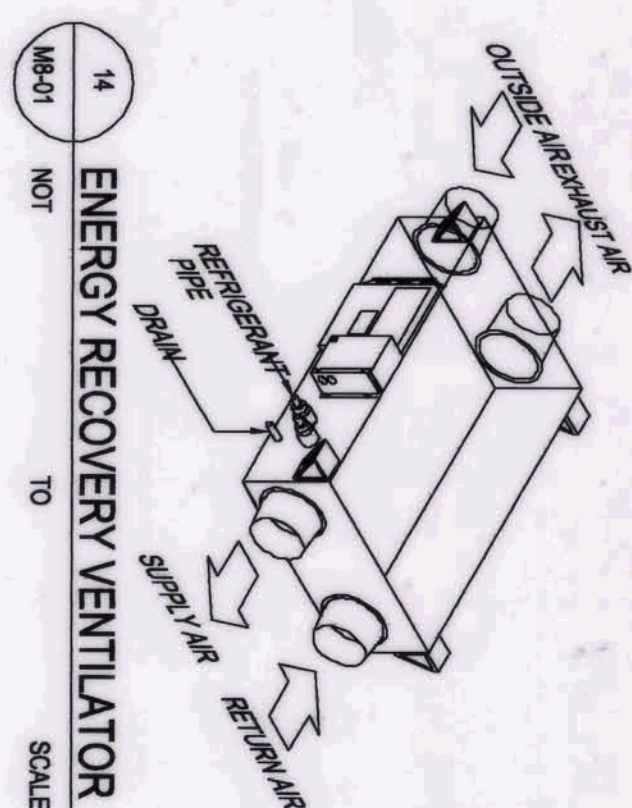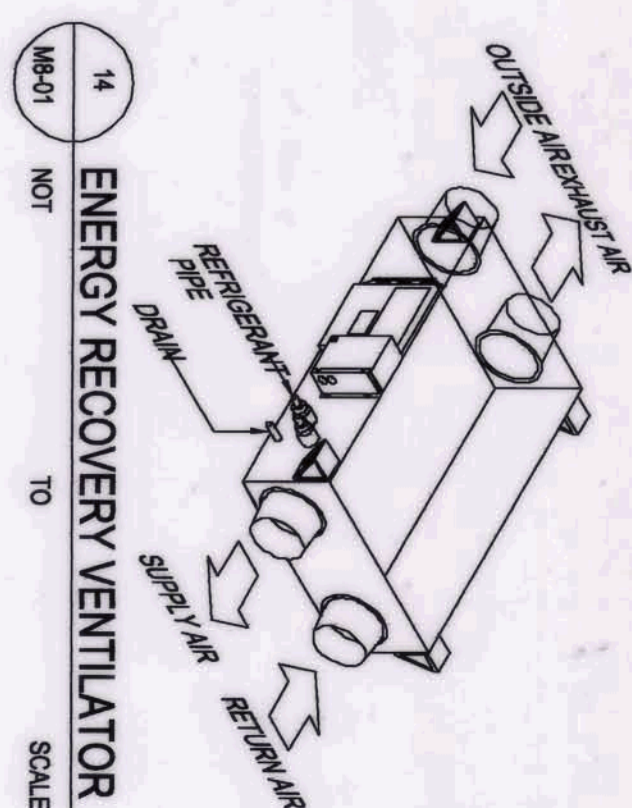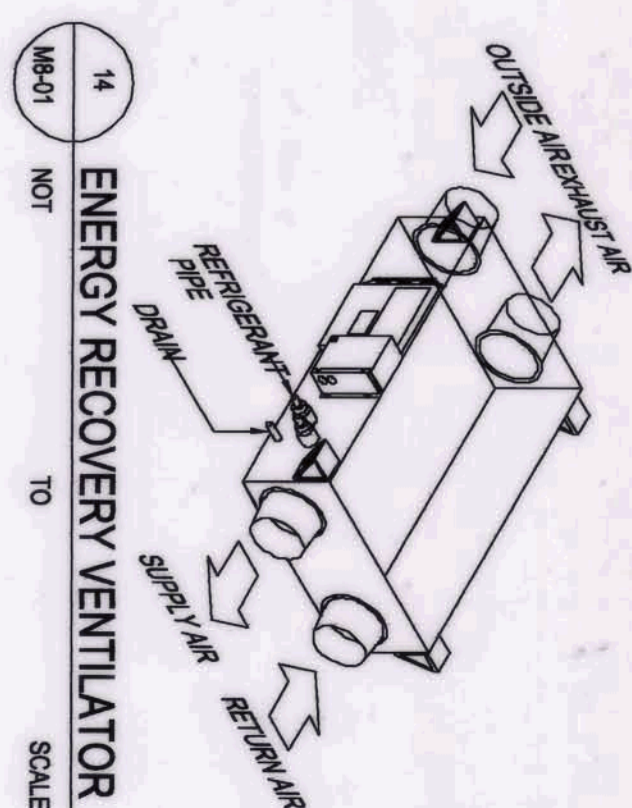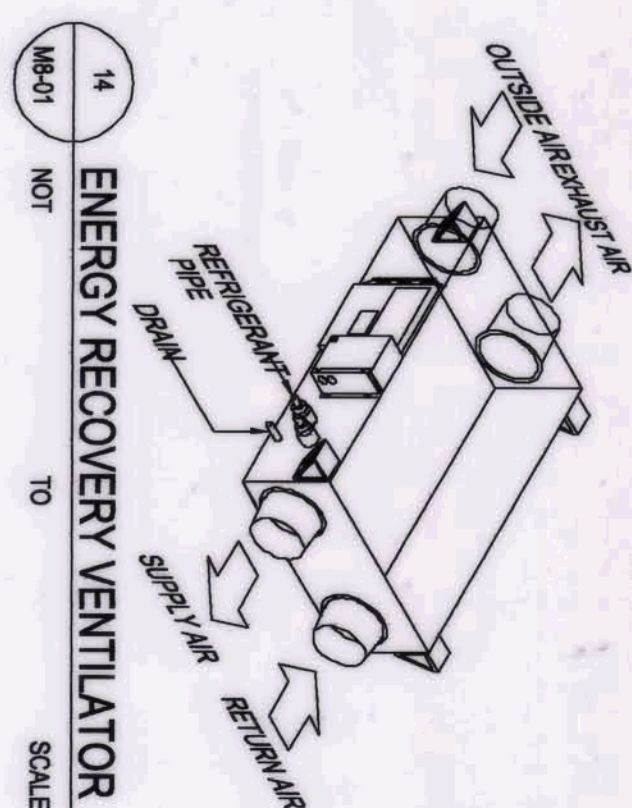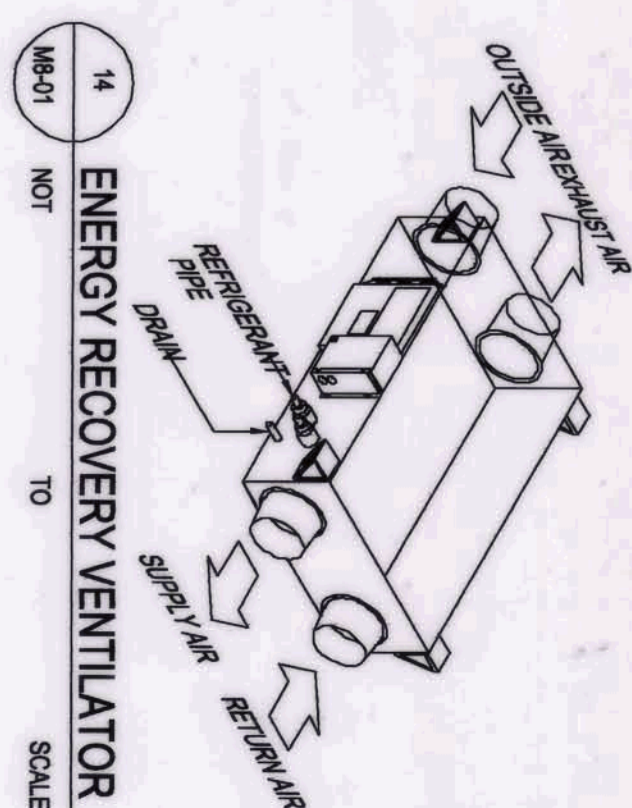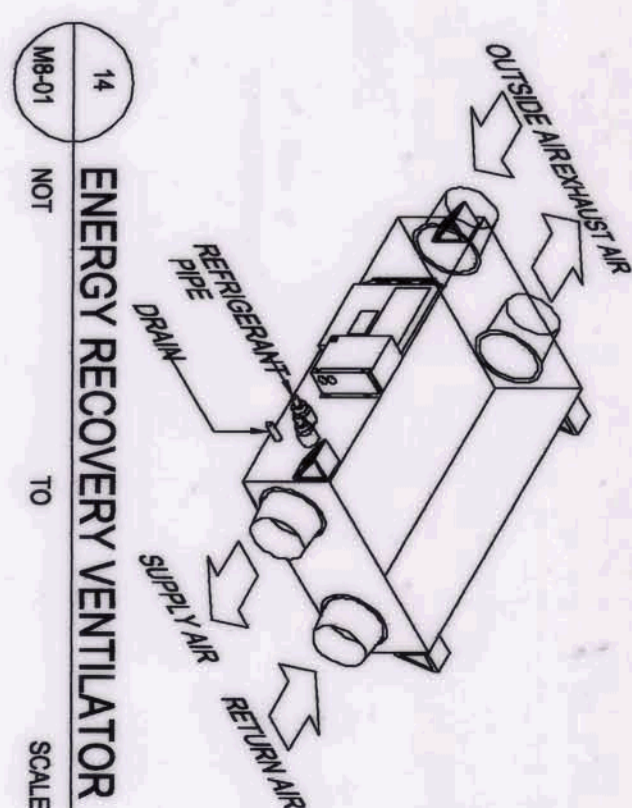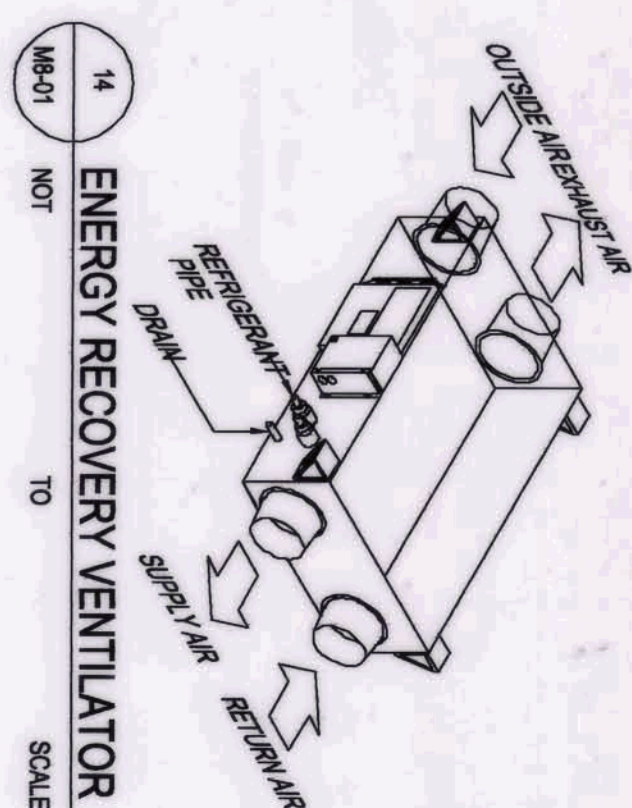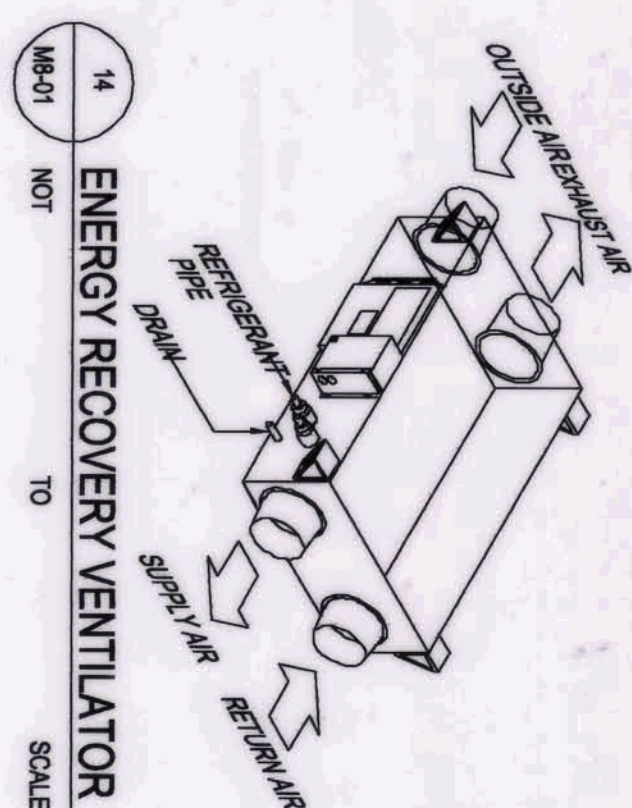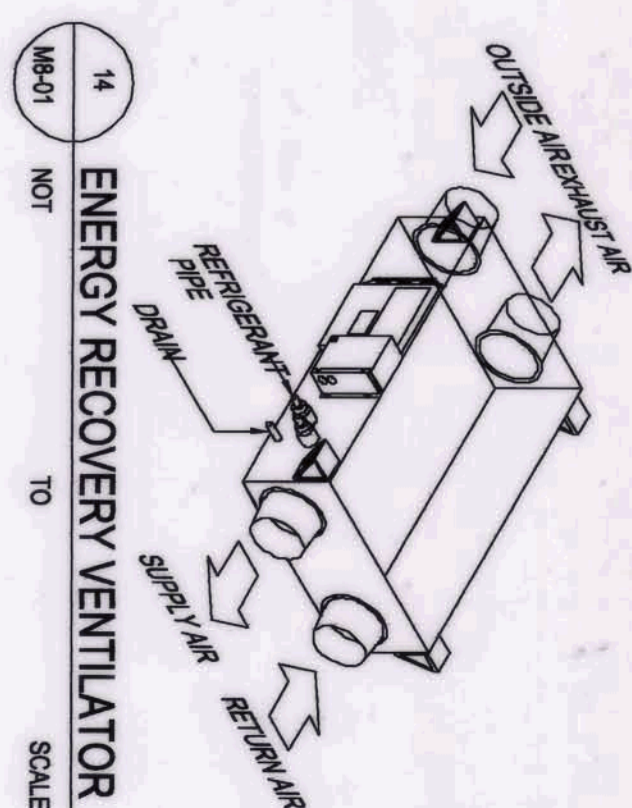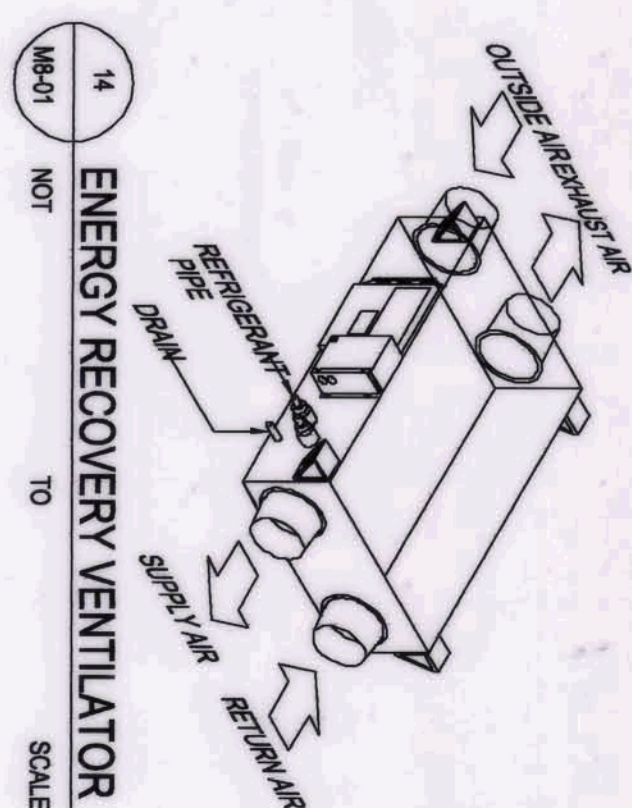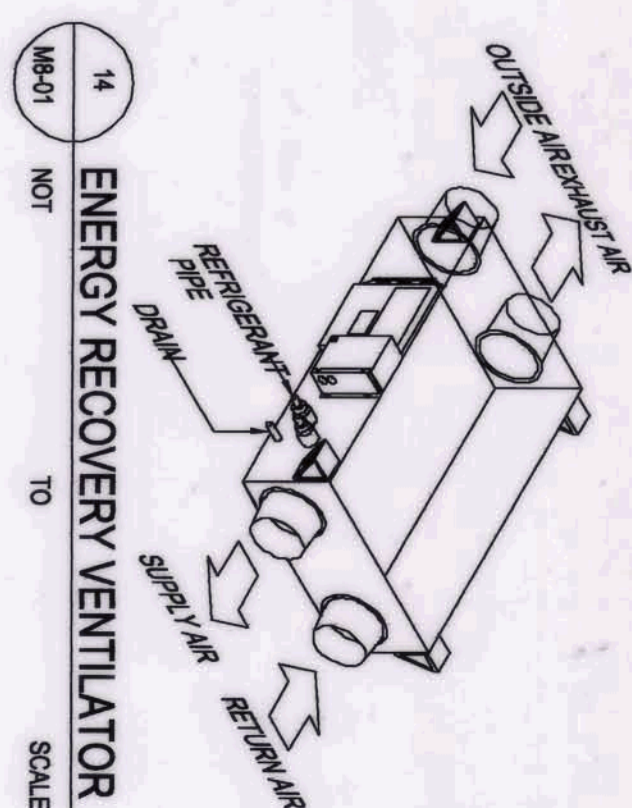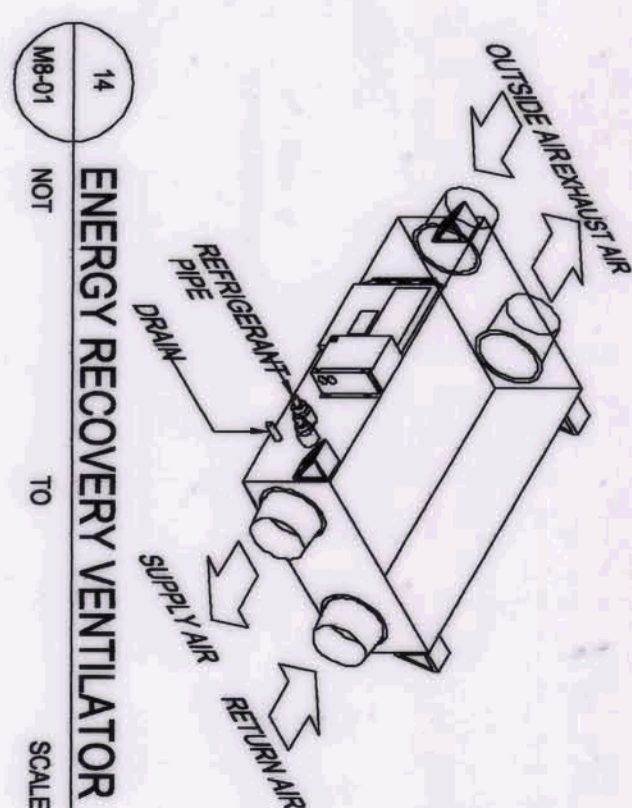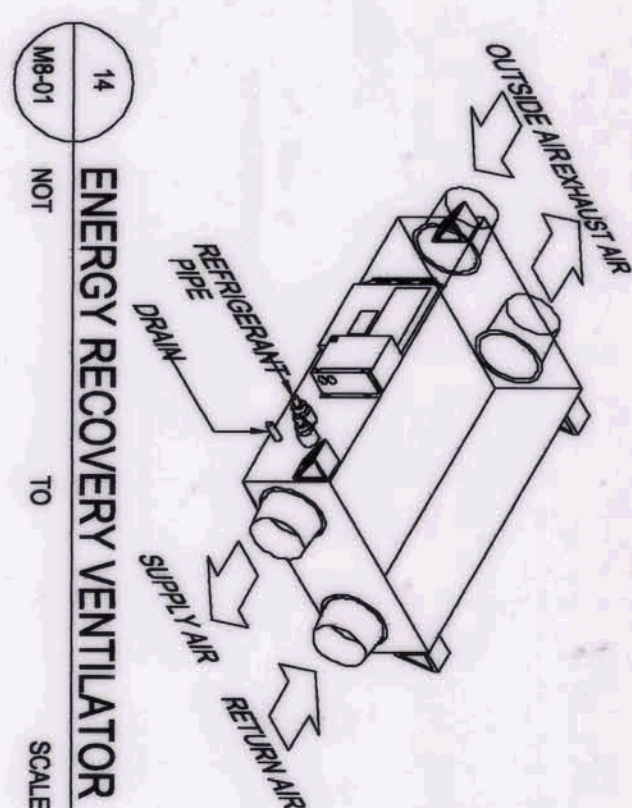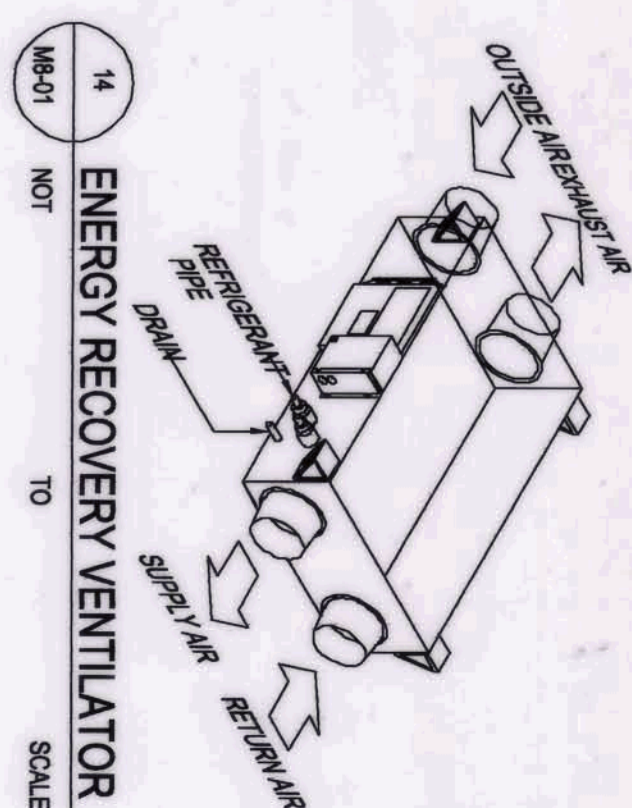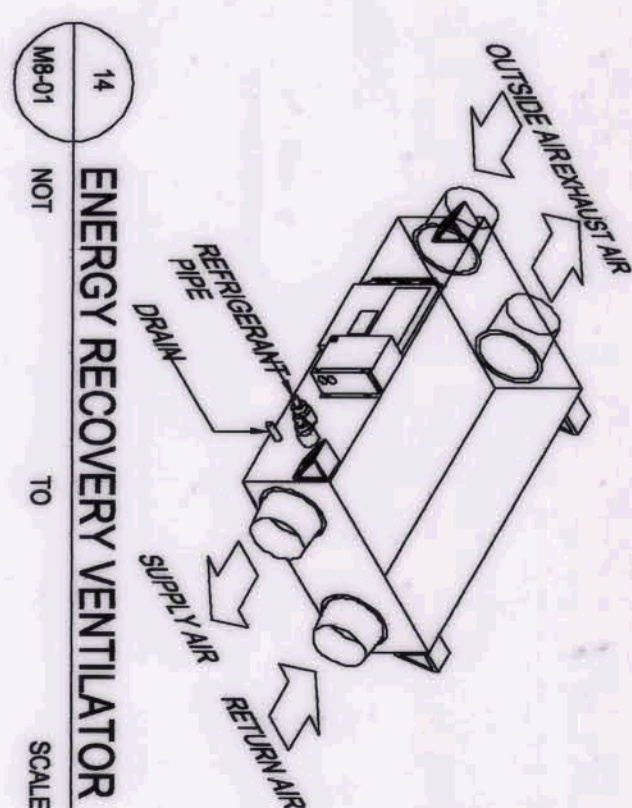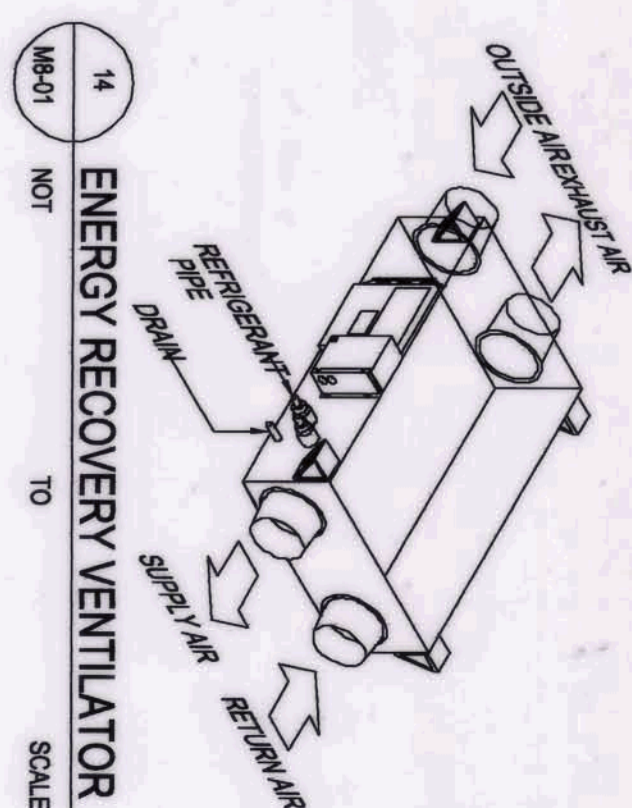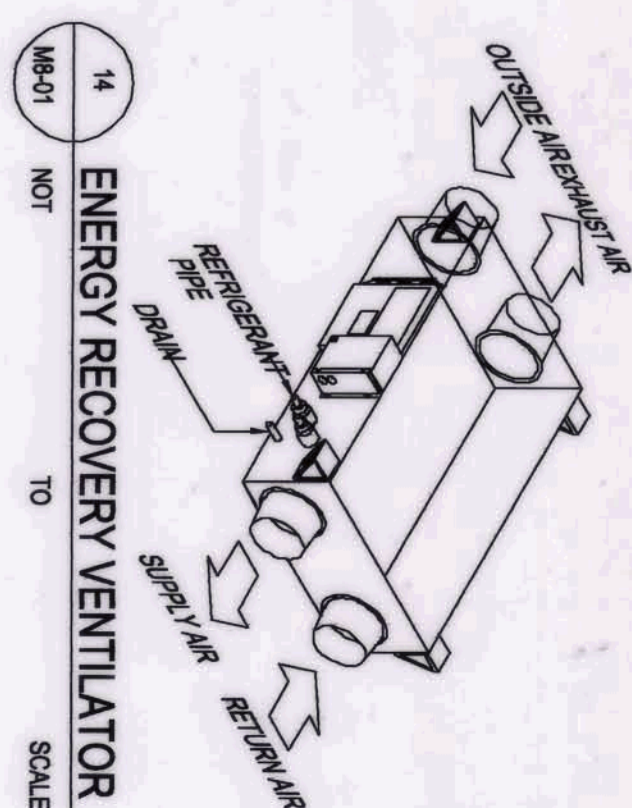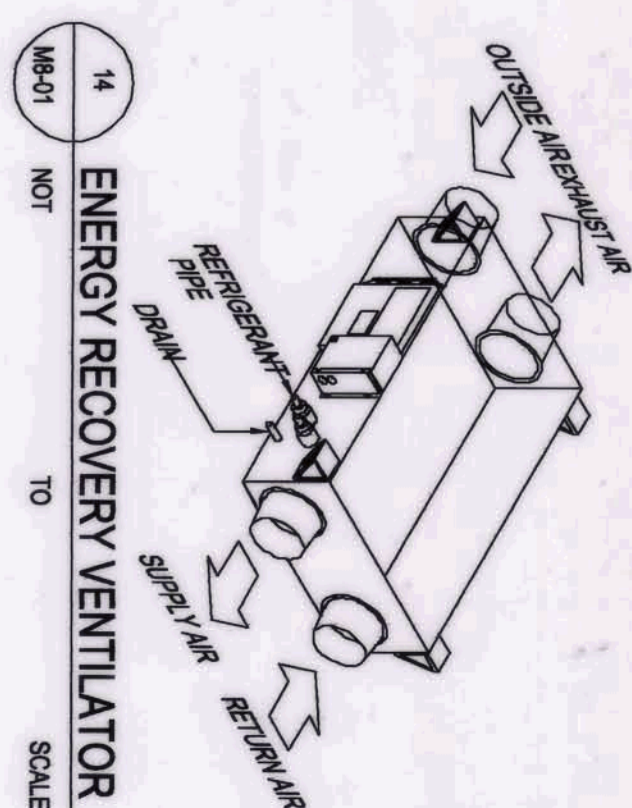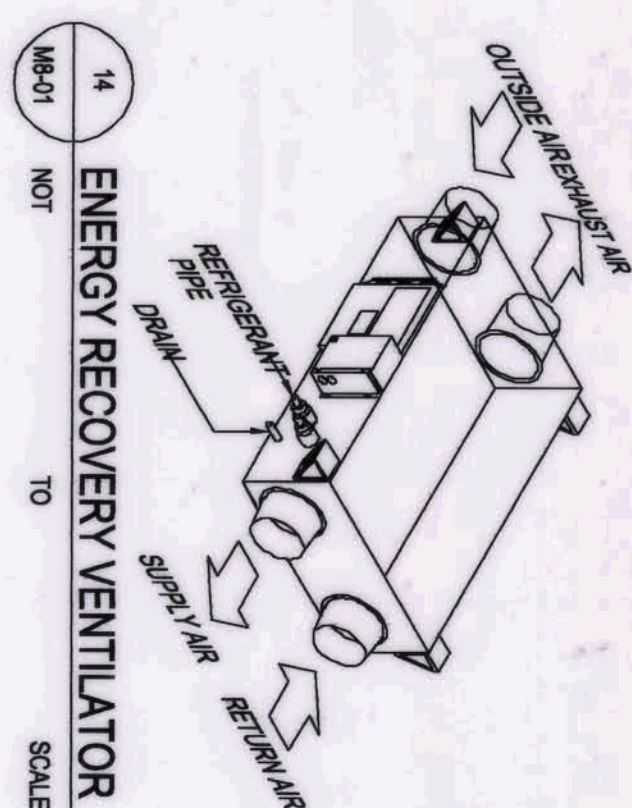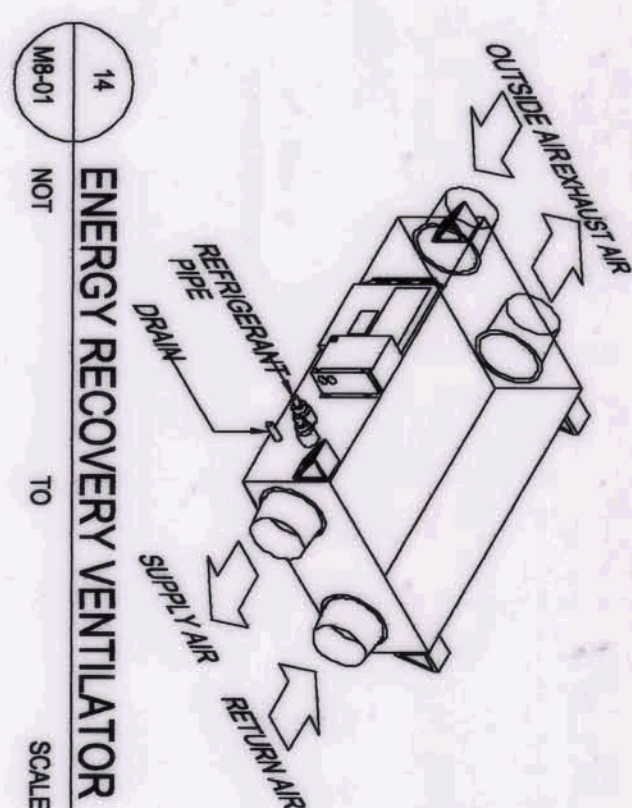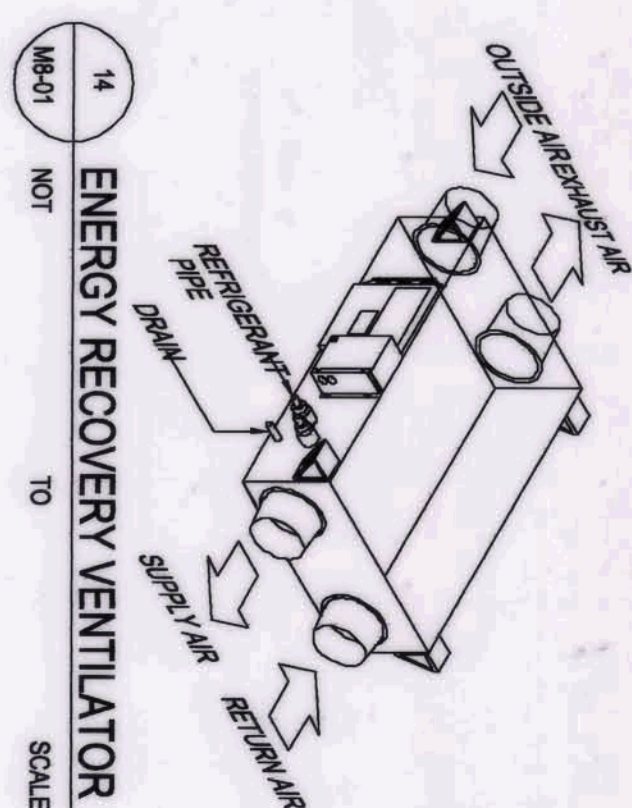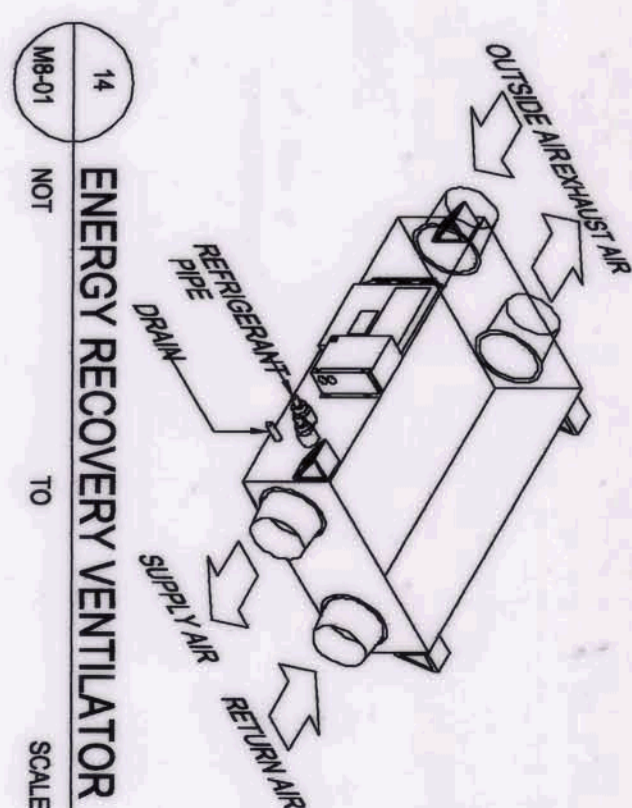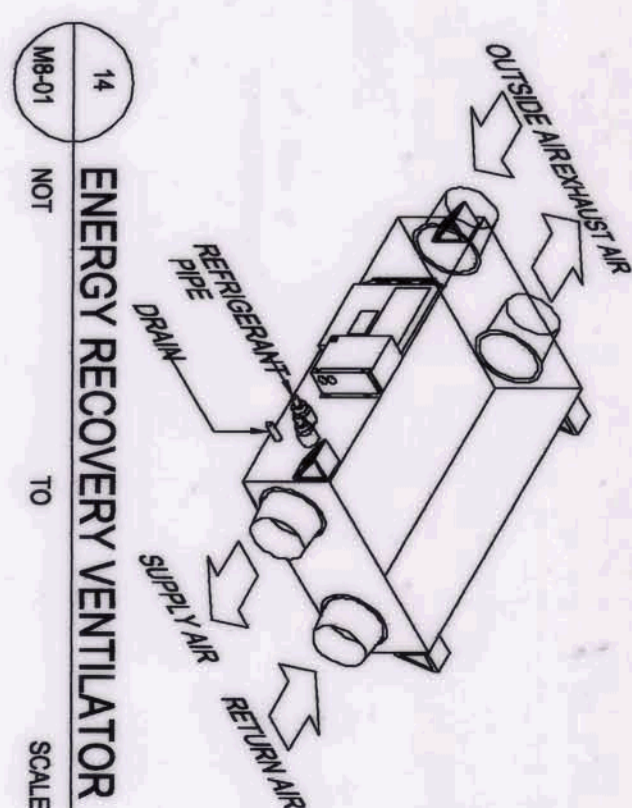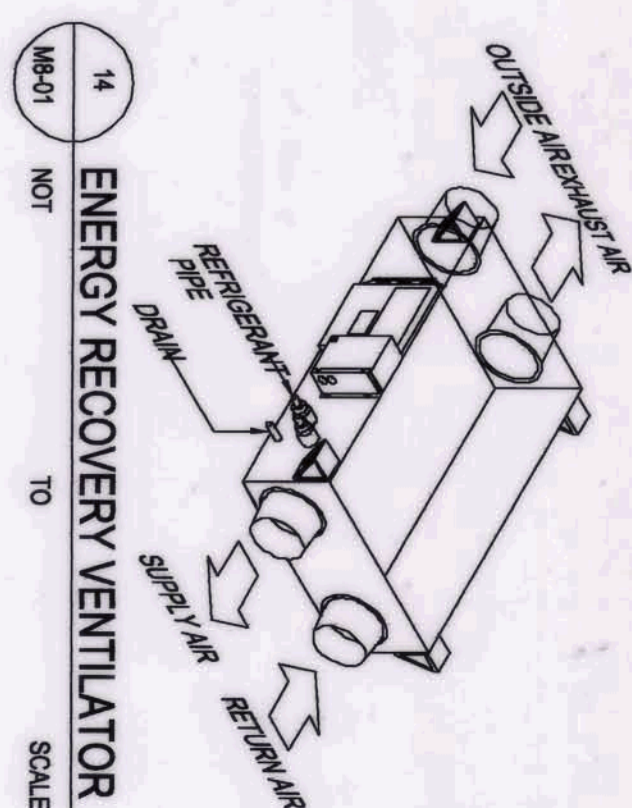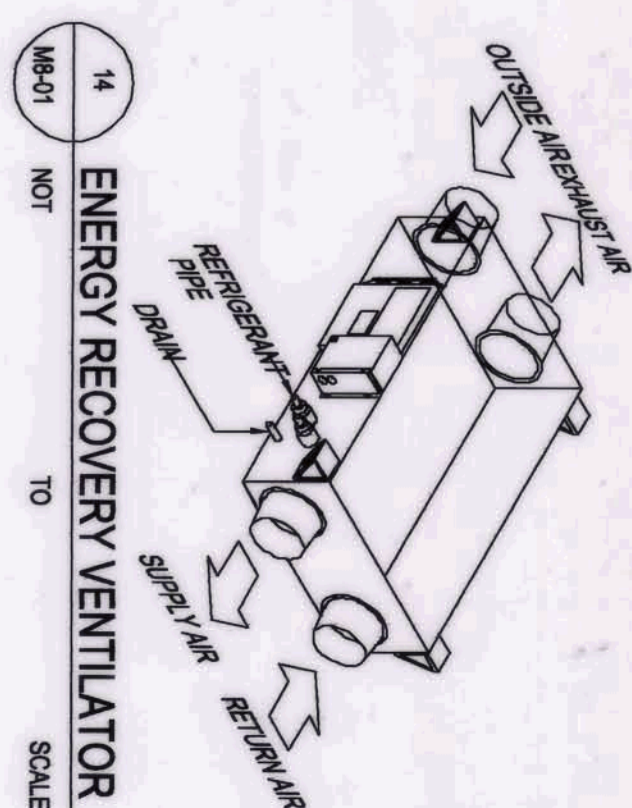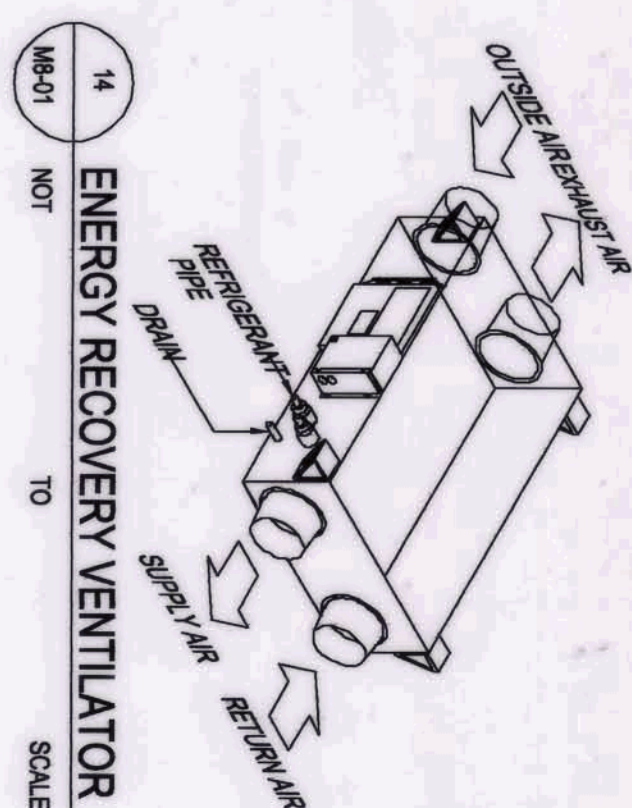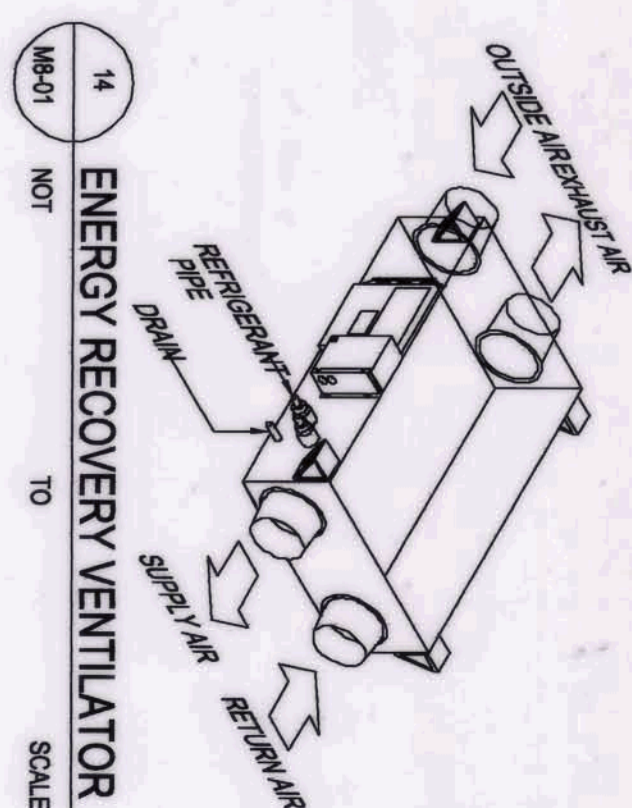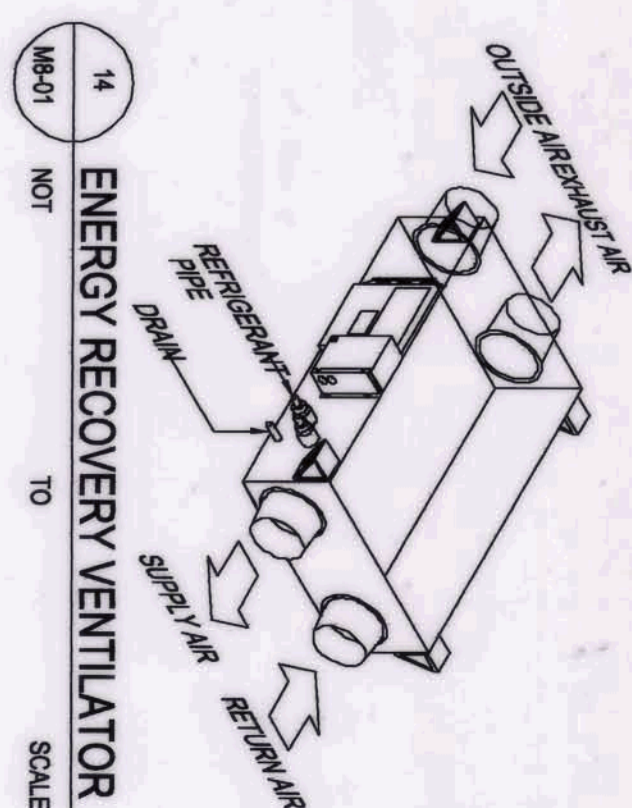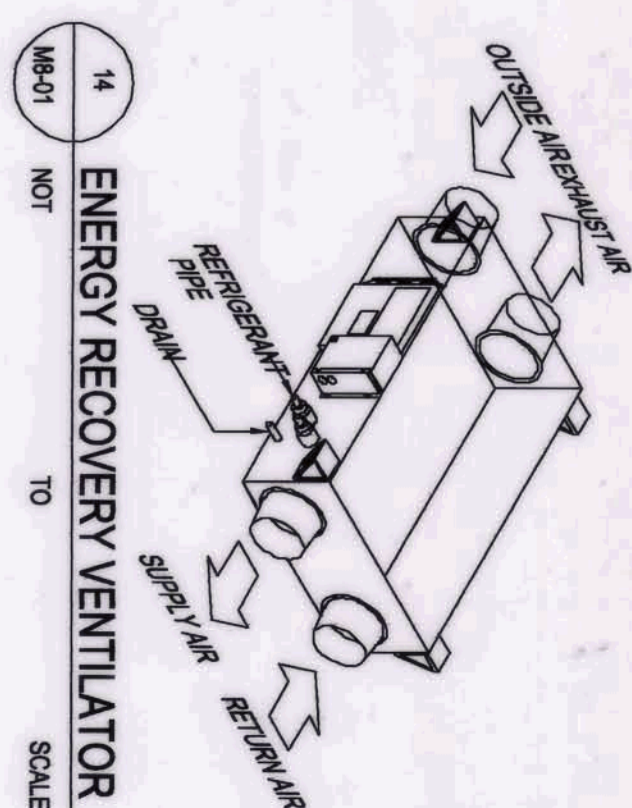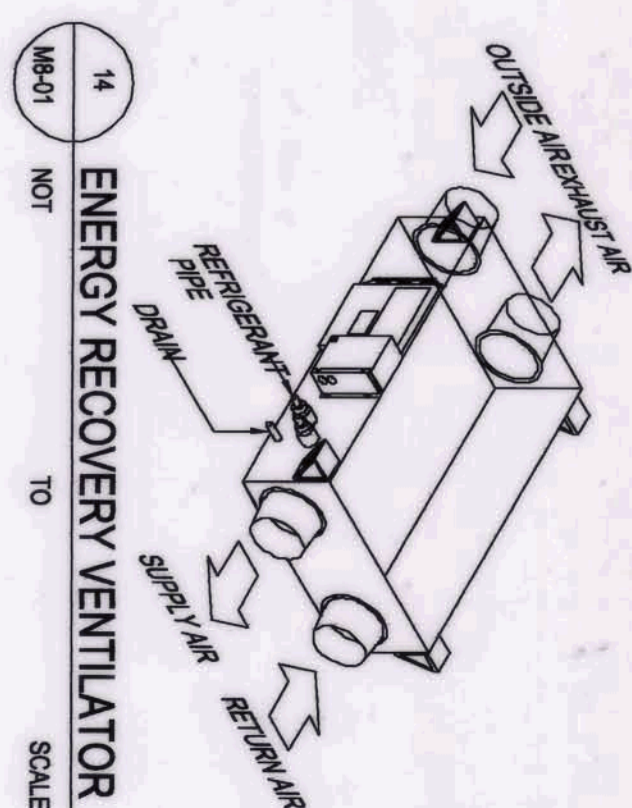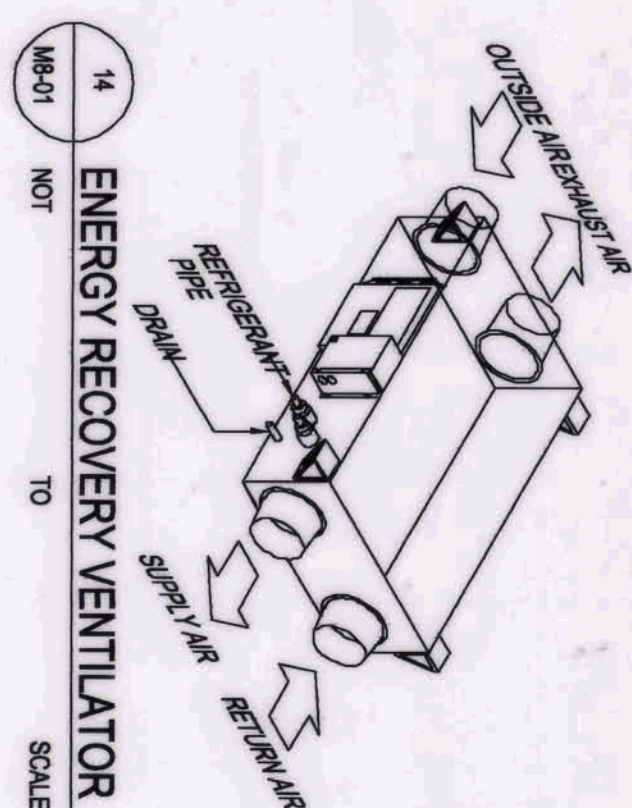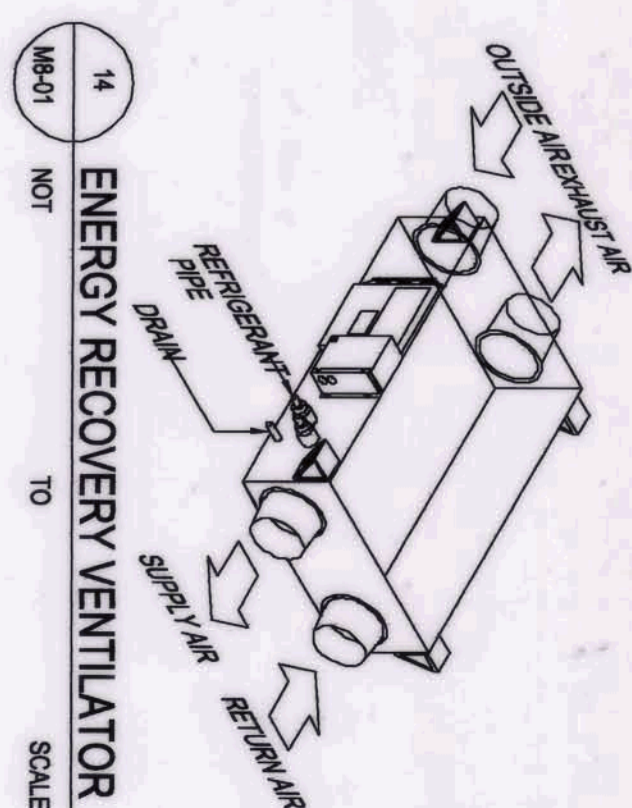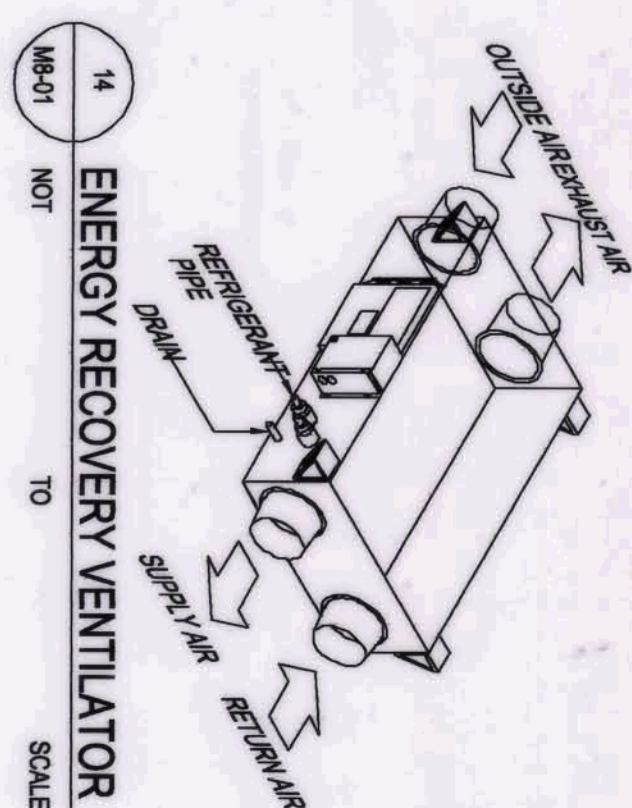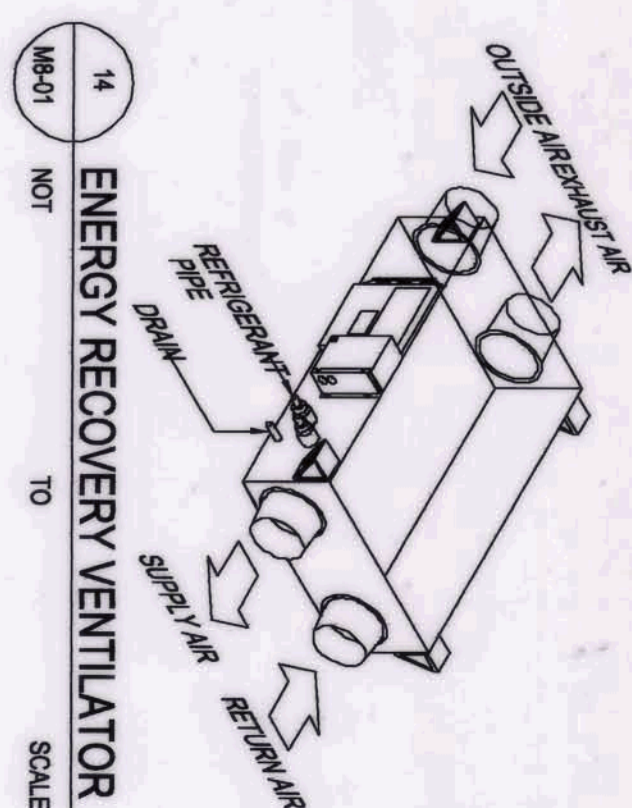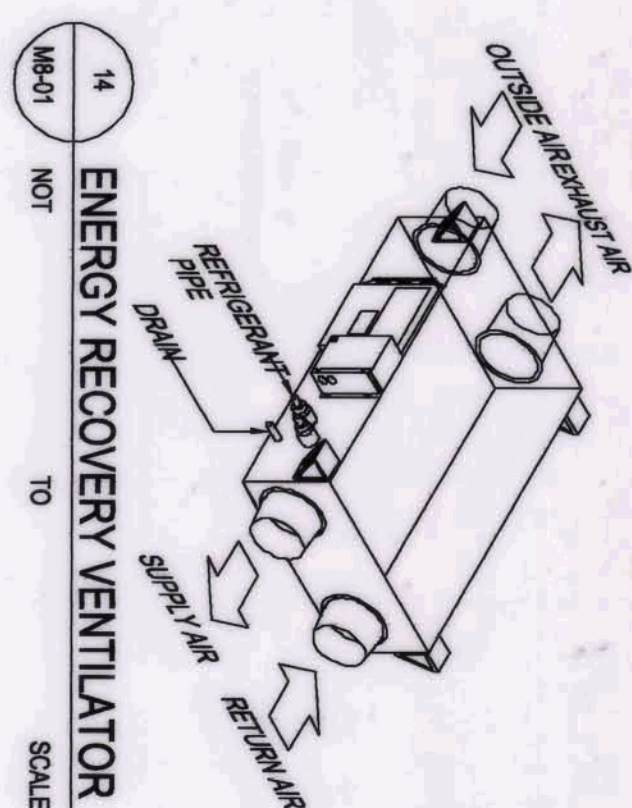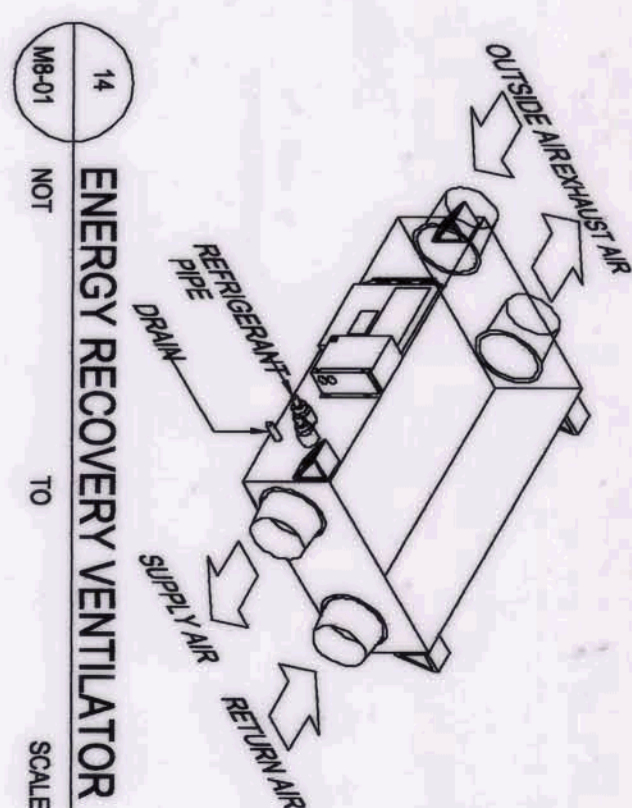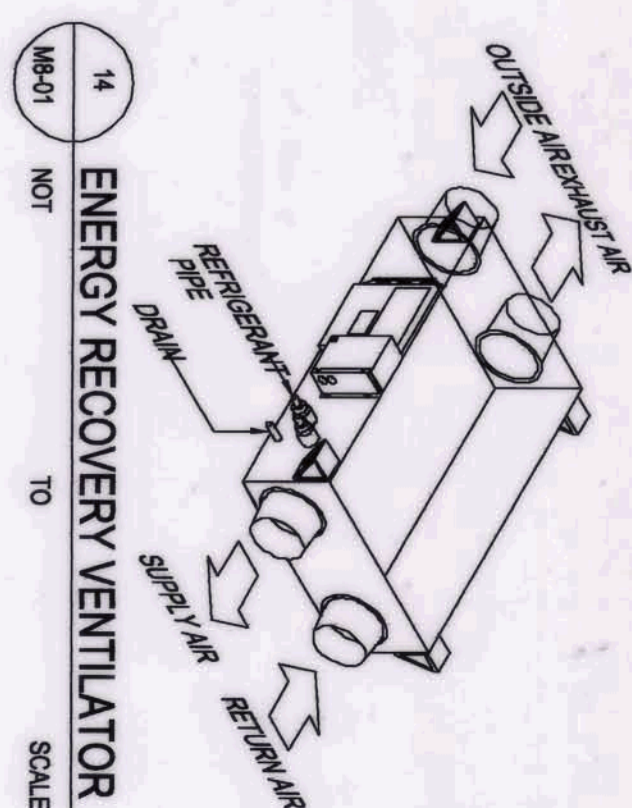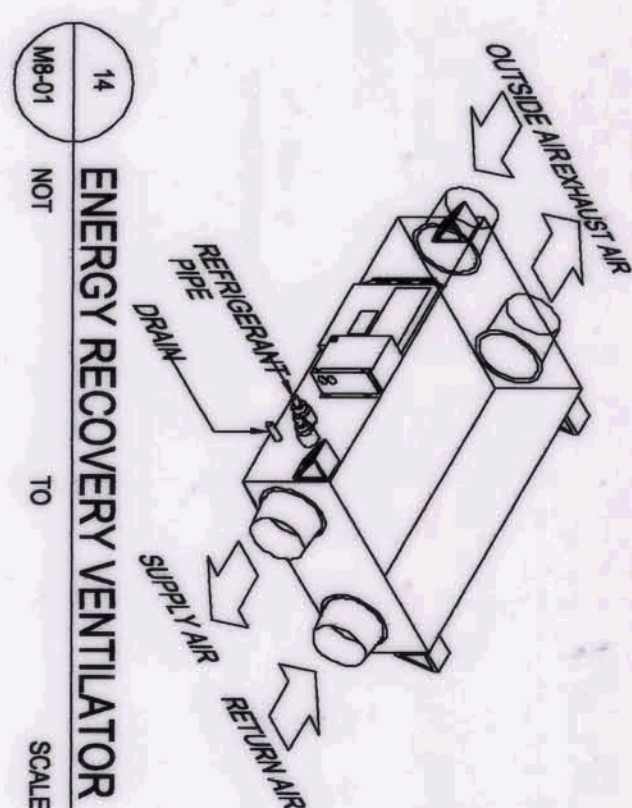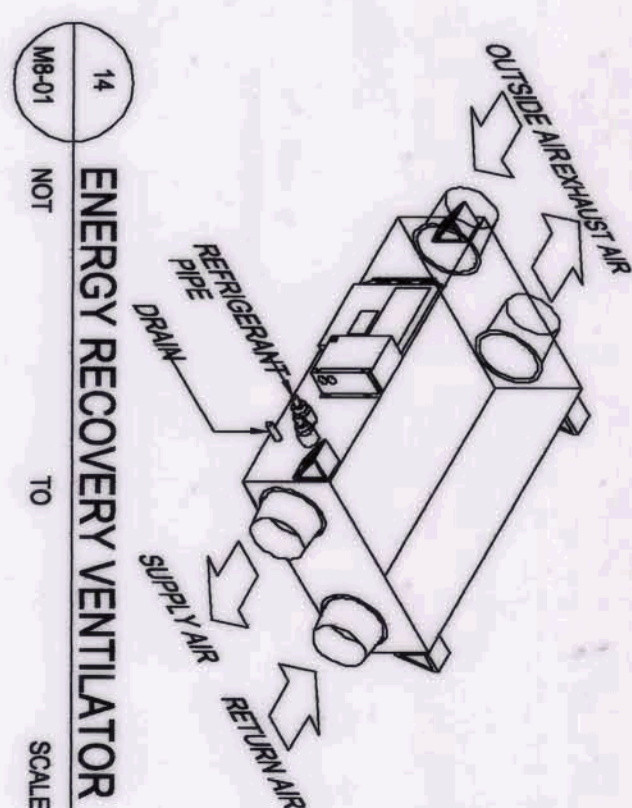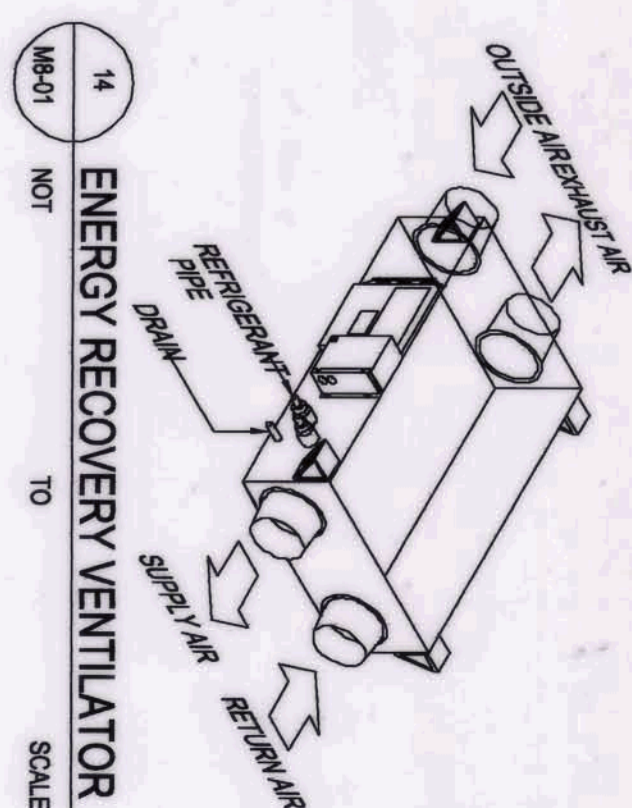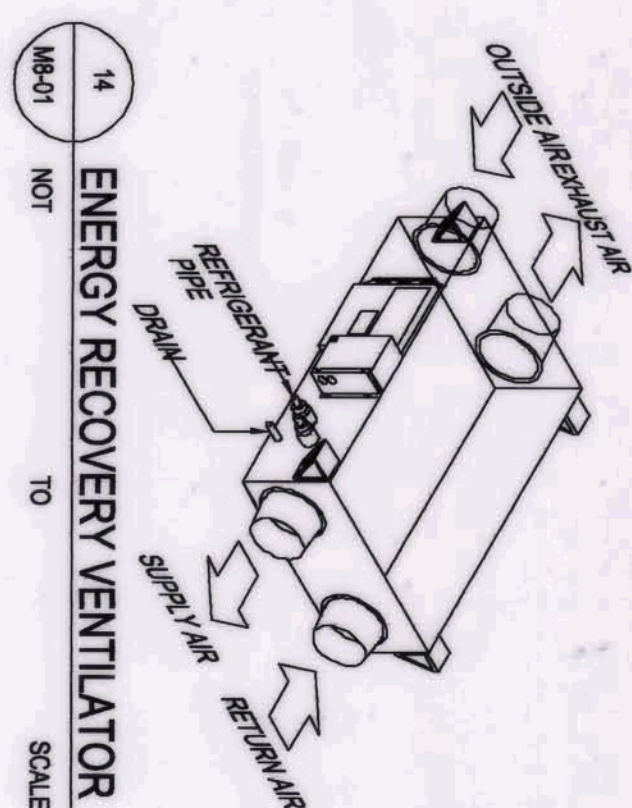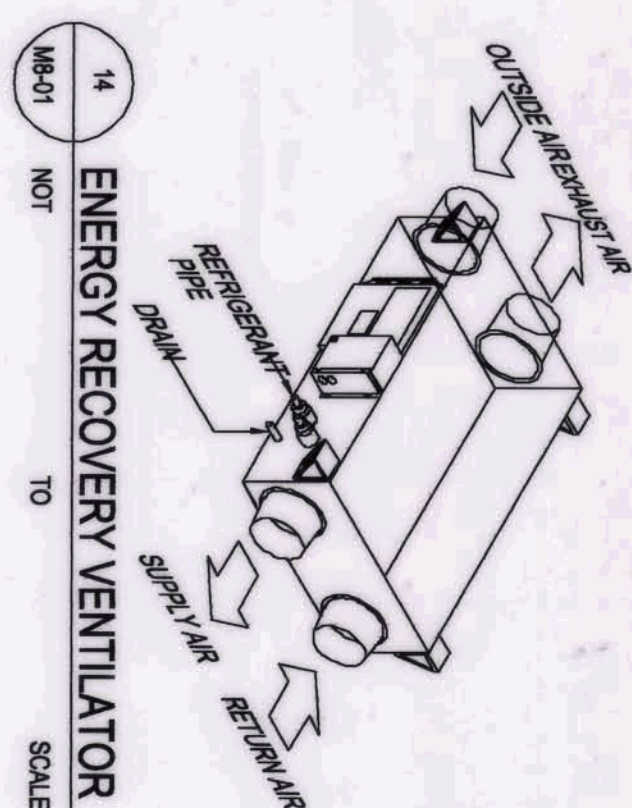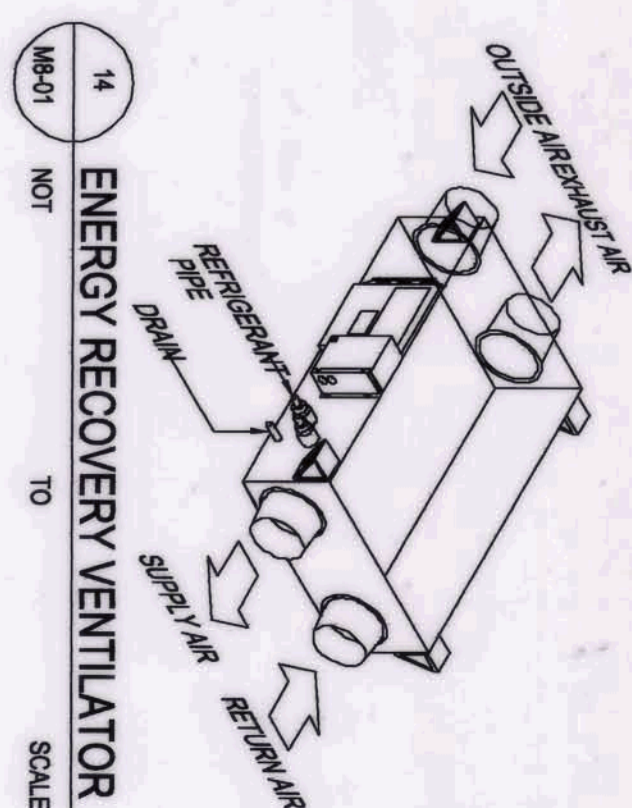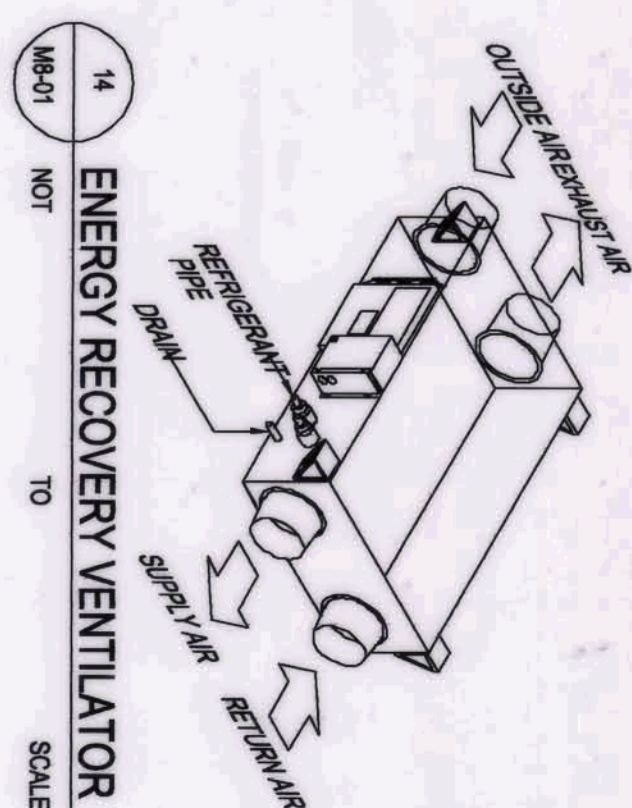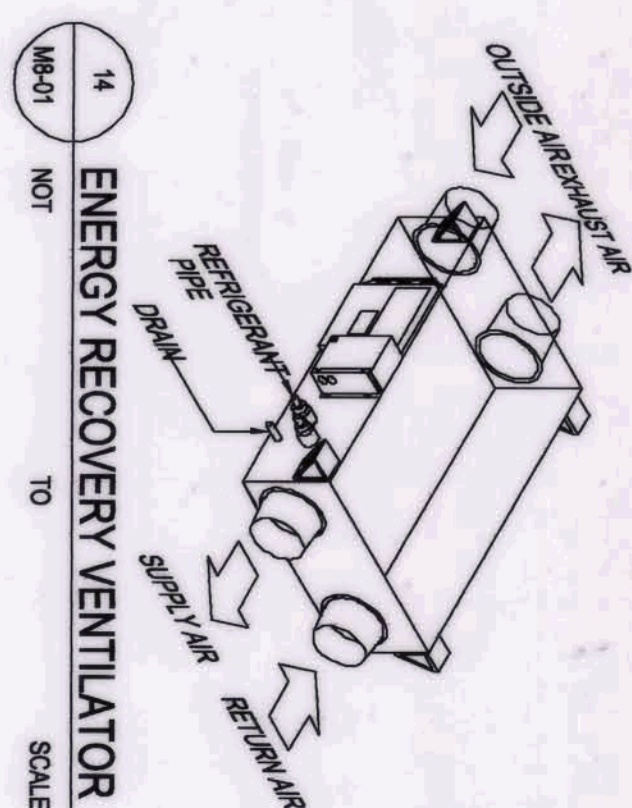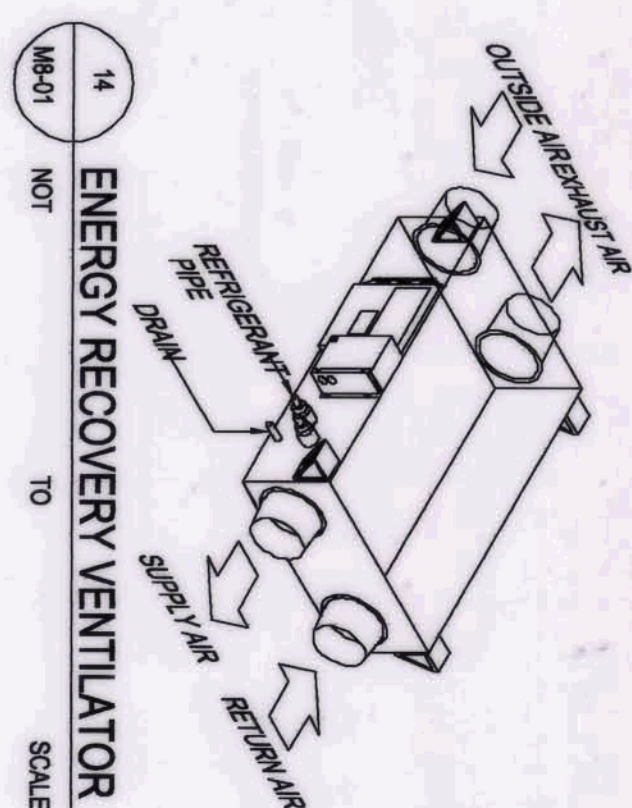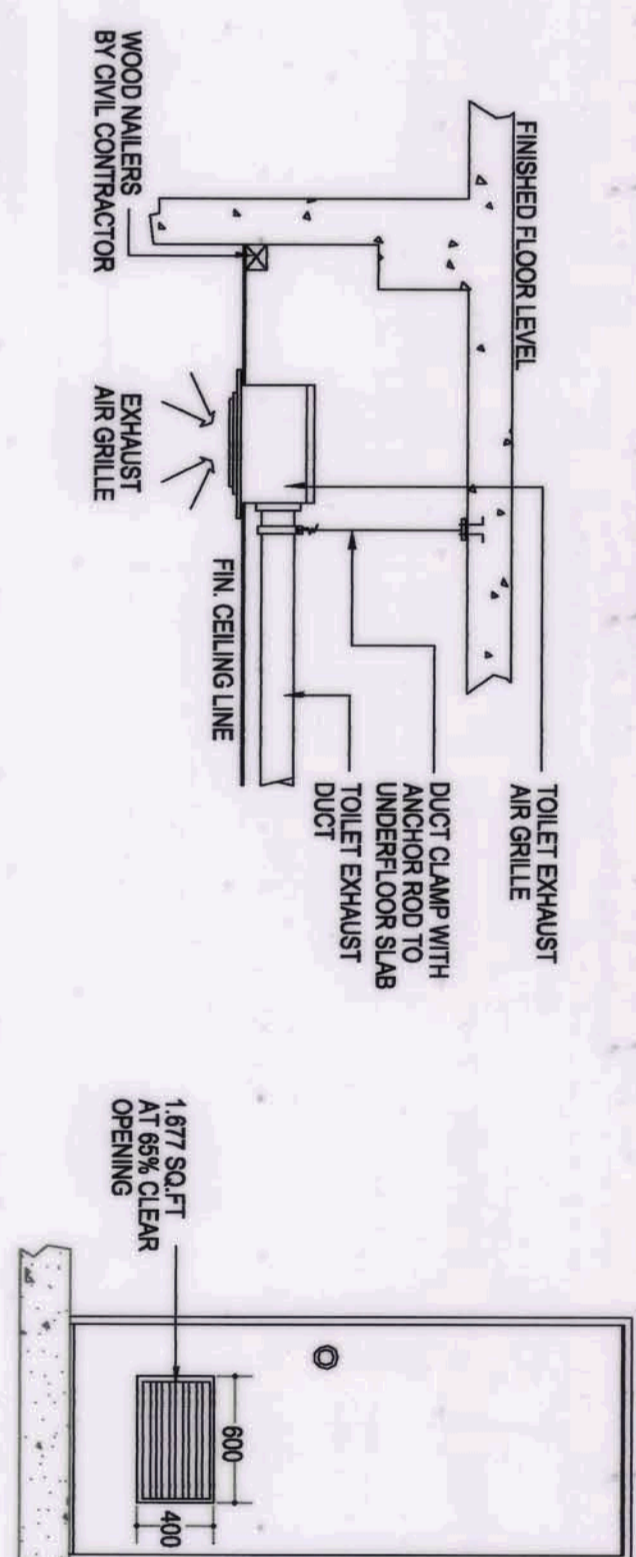


VERROLEC FLANGE AND CORNER SCHEDULE				
FLANGE SIZE	CORNER SIZE	DUCT SIZE	HANGER ROD	BOLT & NUT
SYSTEM 20	SYSTEM 20	100 - 900	3/8"x(10mm)	5/16"x(6mm)
SYSTEM 30	SYSTEM 30	850 - 2000	3/8"x(10mm)	3/8"x(10mm)
SYSTEM 40	SYSTEM 40	2050 - UP	1/2"x(12mm)	1/2"x(12mm)

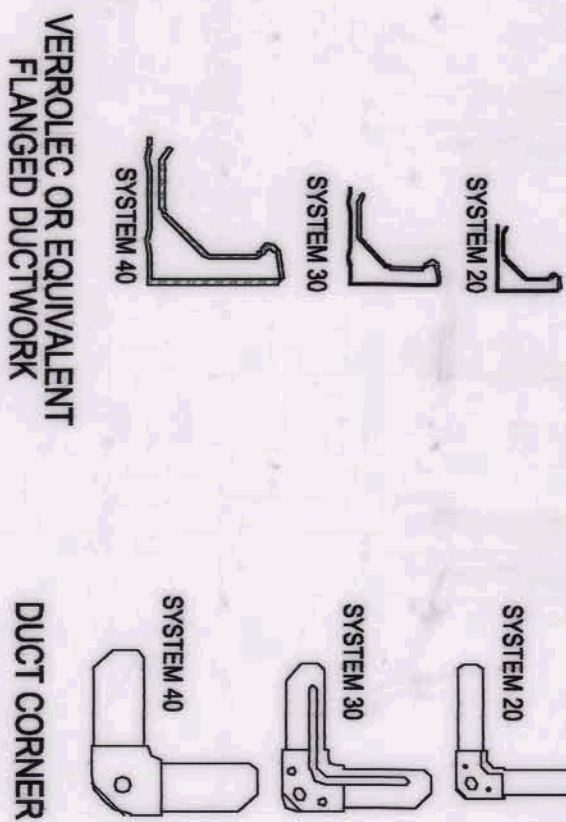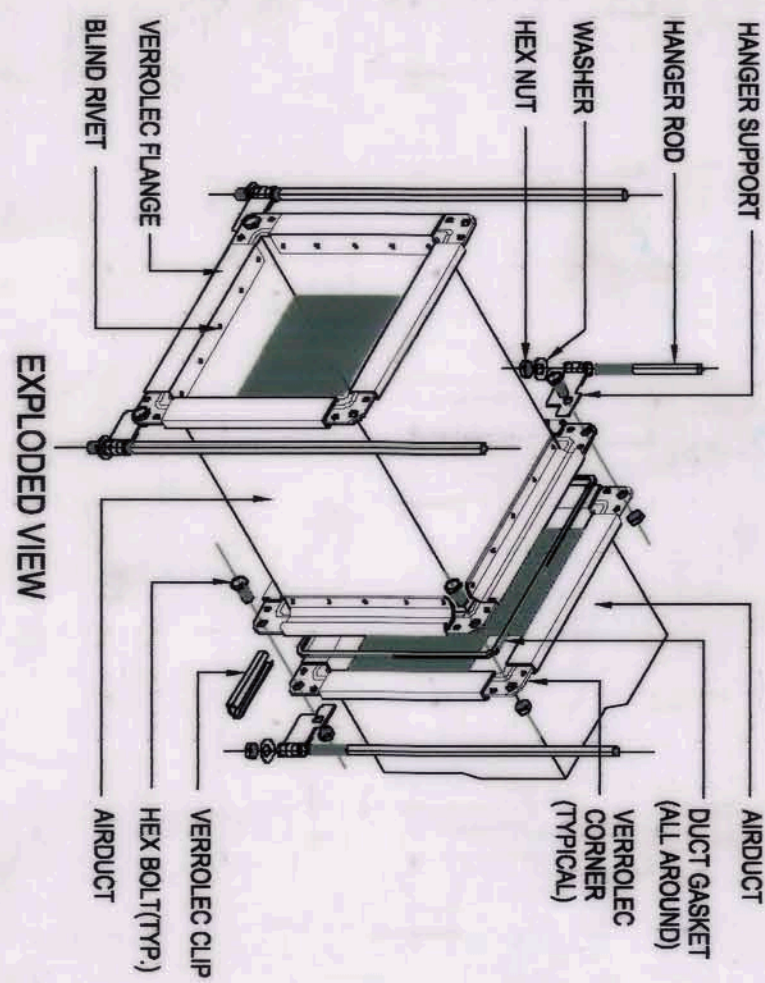


1 AIR DUCT ASSEMBLY DETAIL  
MB-02 NOT TO SCALE

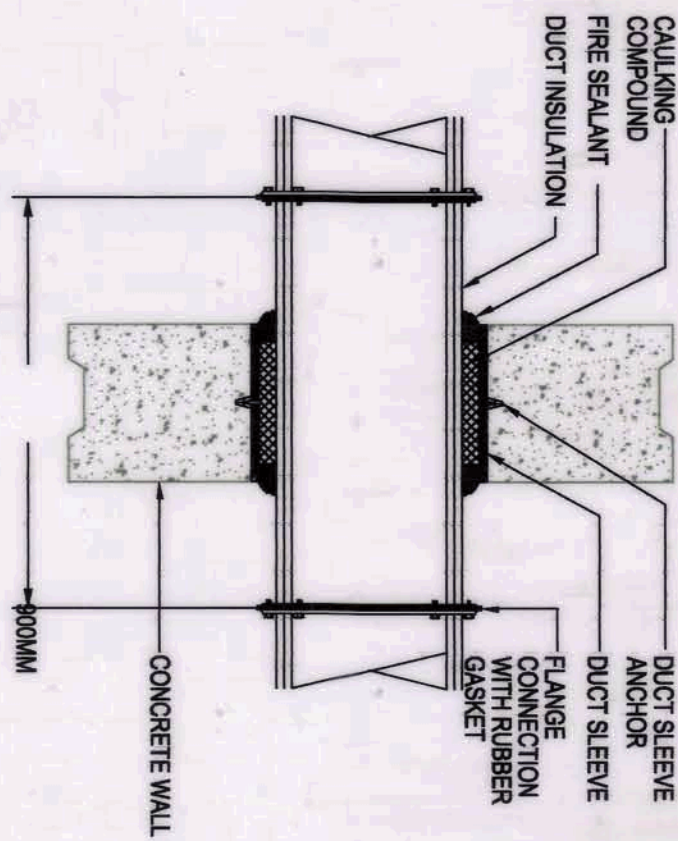


2 DUCT THRU WALL  
MB-02 NOT TO SCALE

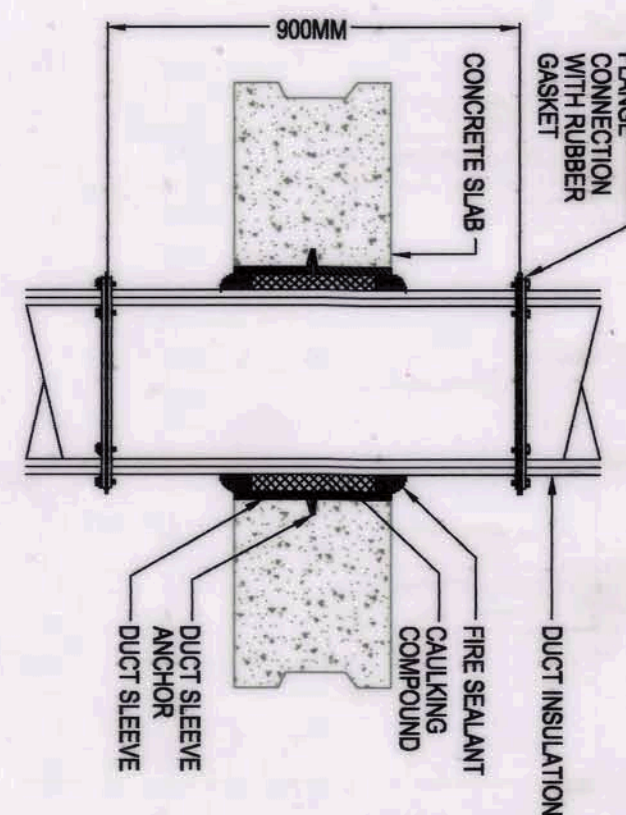


3 DUCT THRU FLOOR  
MB-02 NOT TO SCALE

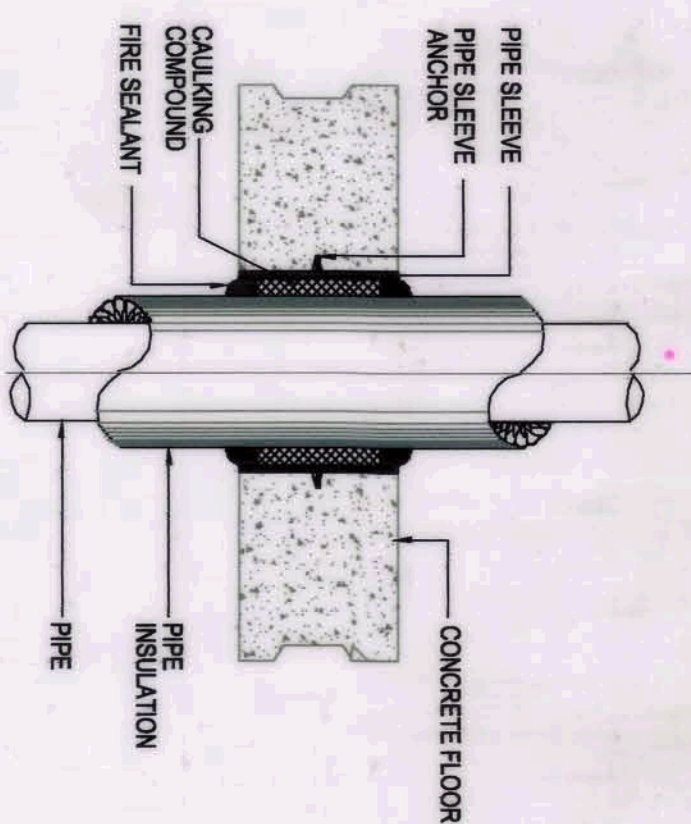


1 PIPE THRU ROOF  
MB-02 NOT TO SCALE

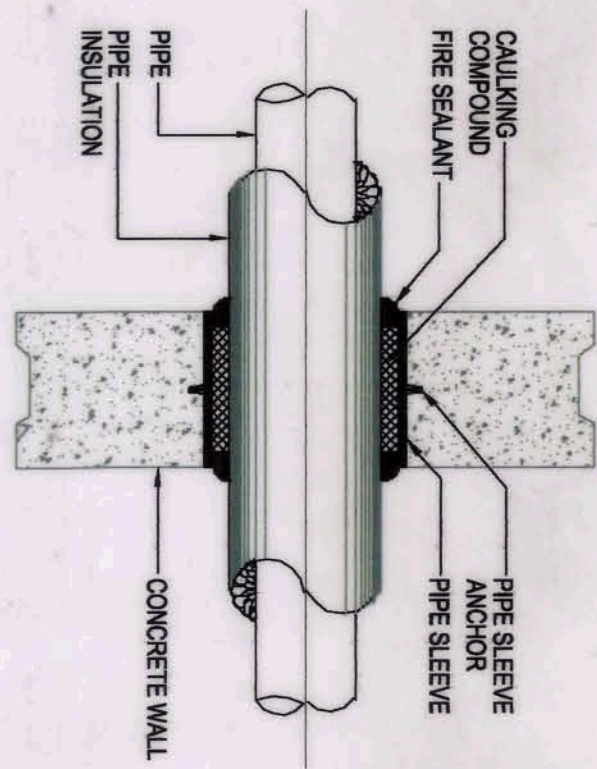


5 PIPE THRU WALL  
MB-02 NOT TO SCALE

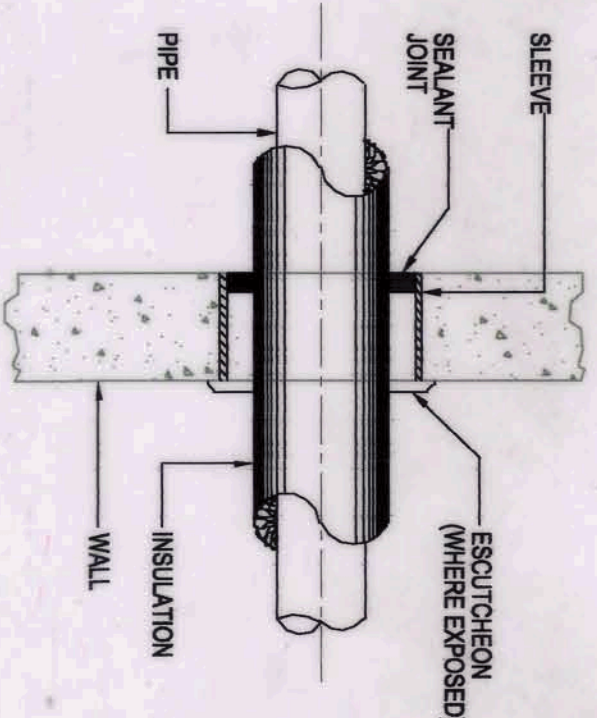


6 PIPE SLEEVE  
MB-02 NOT TO SCALE

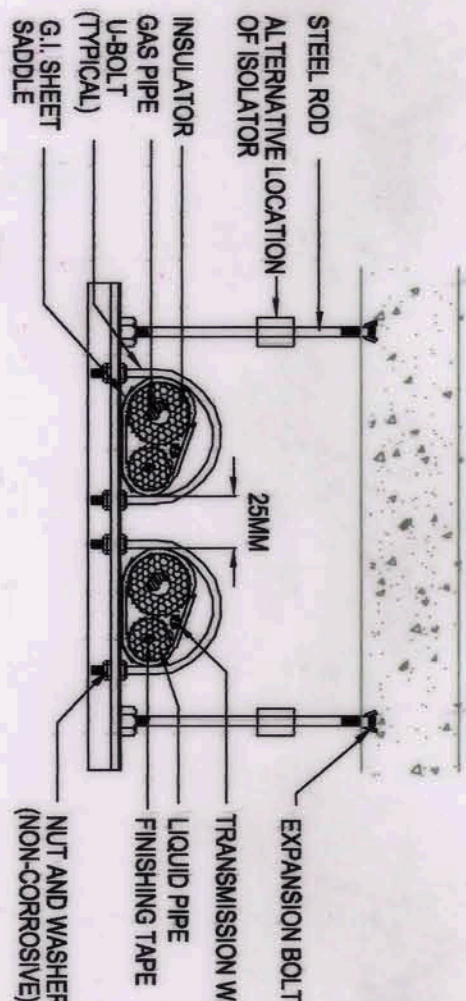



7 REFRIGERANT PIPE HANGER  
MB-02 NOT TO SCALE

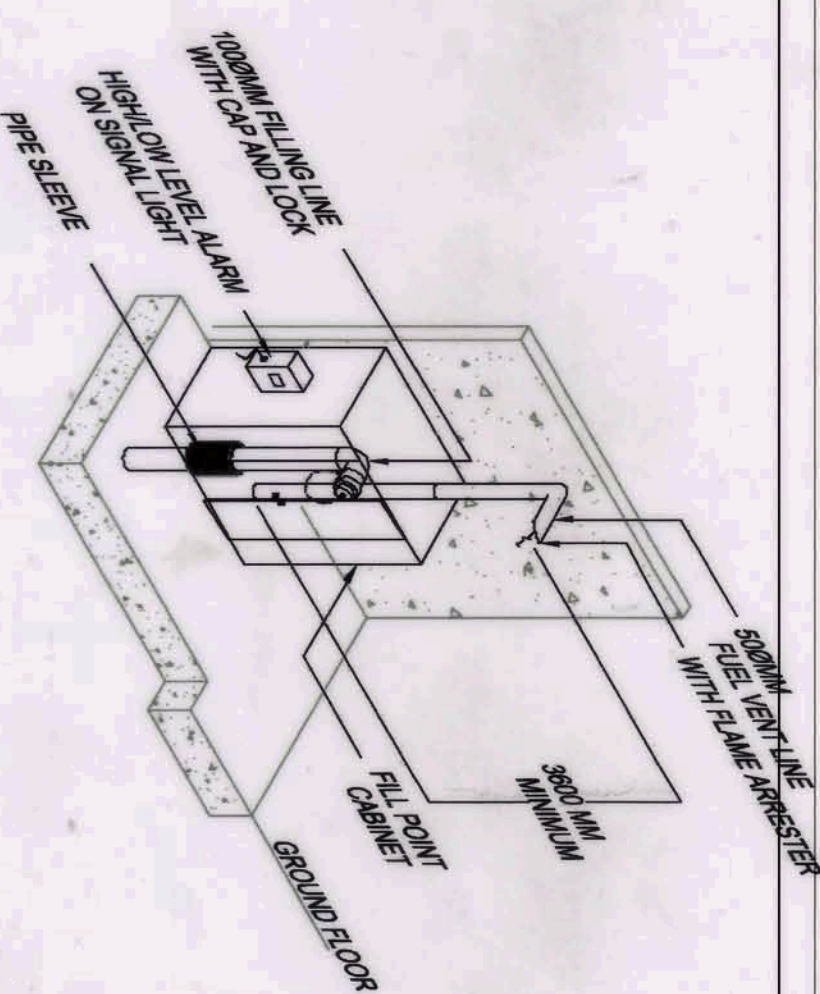

8 FUEL FILL LINE  
MB-02 NOT TO SCALE

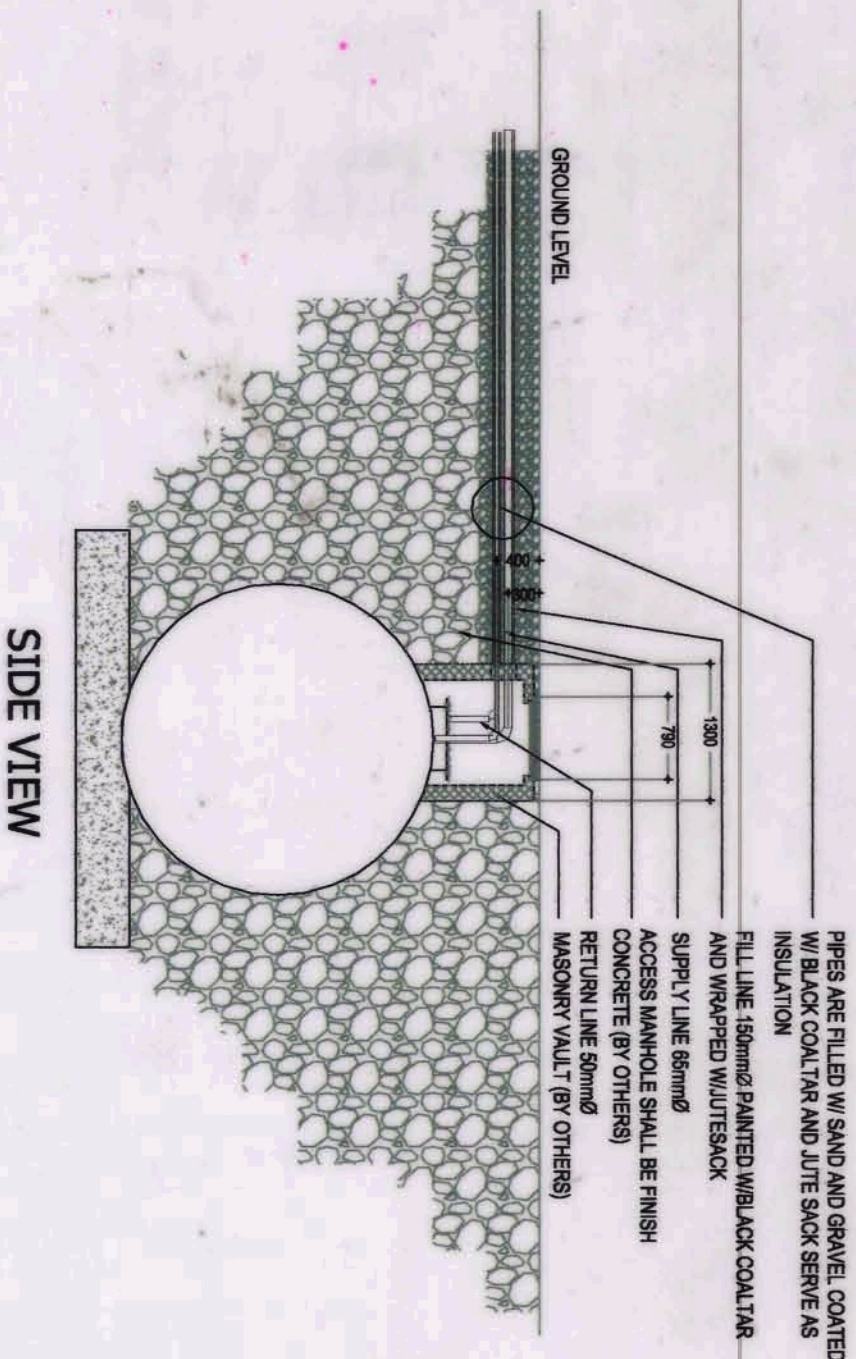

9 FUEL OIL STORAGE MOUNTING  
MB-02 NOT TO SCALE

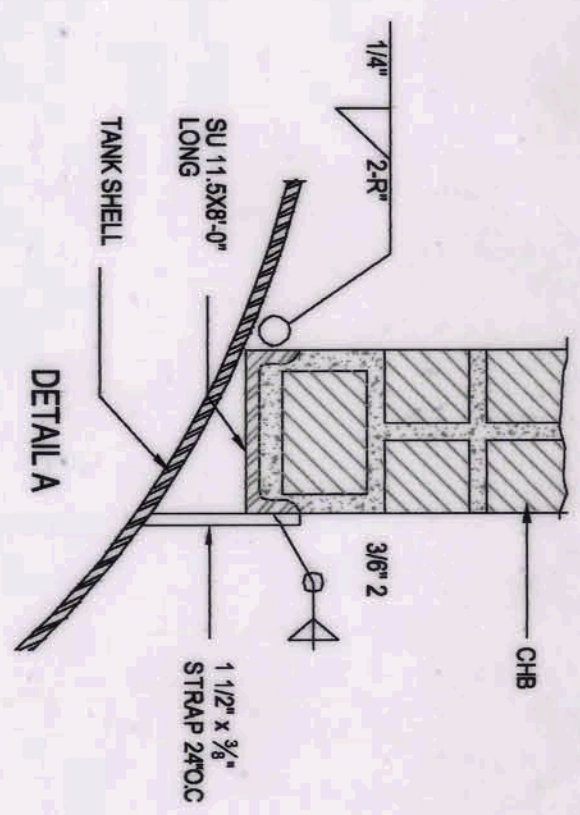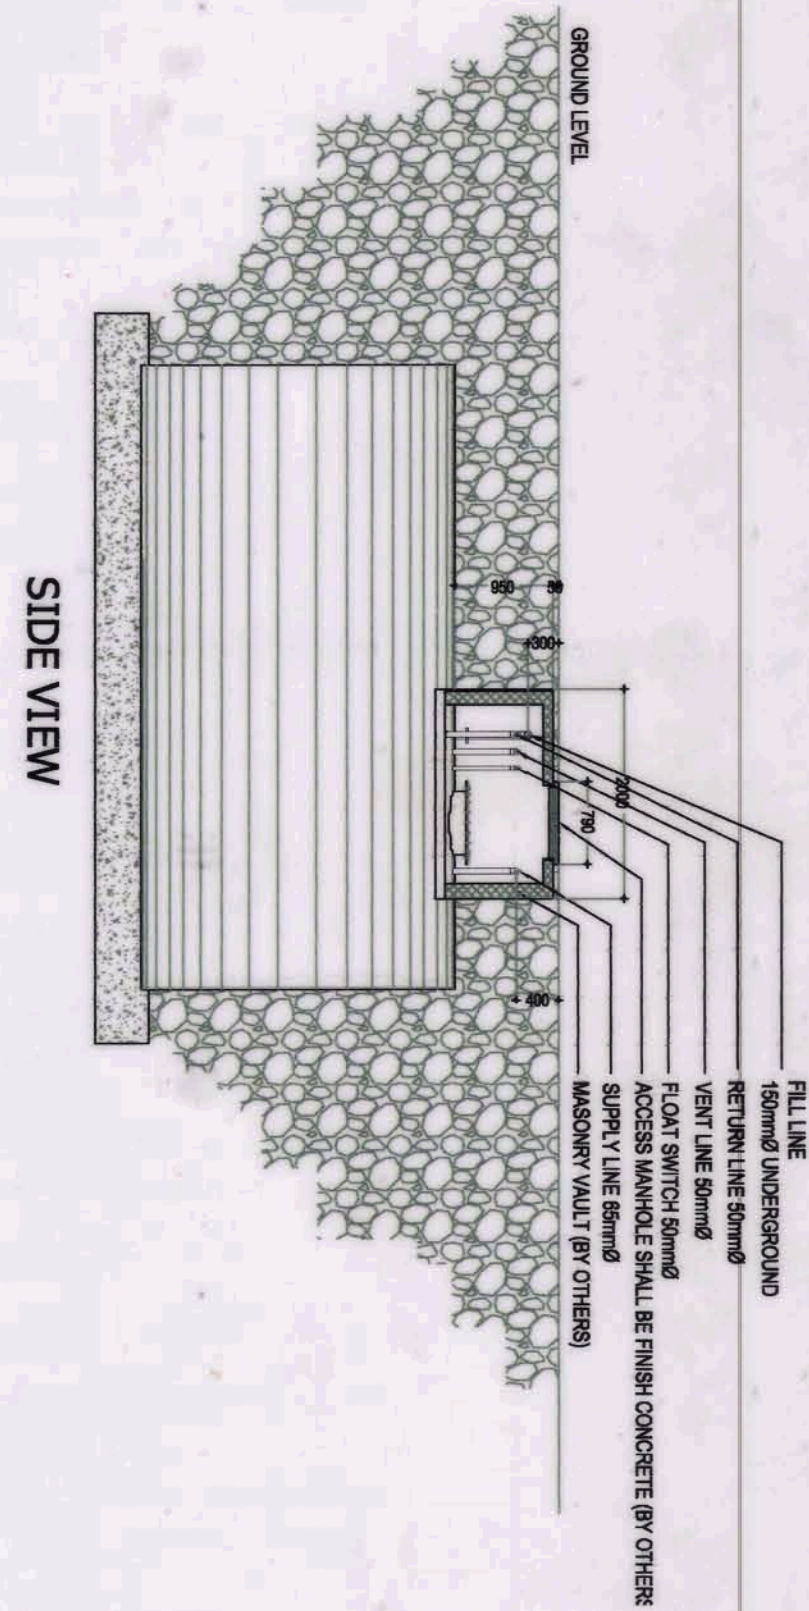

OWNER: NGAC PHASE 1A COMPANY

PREPARED BY:

REVIEWED AND VALIDATED BY:

SUBMITTED BY:

CERTIFIED BY: INDEPENDENT CONSULTANT

PROJECT TITLE:

SHEET CONTENTS:

SHEET NO.

BCDA  
AND  
VIVENCIO B. BIRON  
PATRICK NICHOLAS P. DAVID

HIL MARC'S  
CONSTRUCTION CORPORATION  
ANGEL P. QUERES

FILIPINAS DRAGO CORPORATION  
Architectural & Engineering Consultants  
ALFREDO E. BELLIA

BANDAR HERBAT BUILDERS, INC.  
ISMAEL DAVID

TCGI ENGINEERS  
VIRGILIO A. MADRIZO

AS-BUILT DRAWING  
ATHLETICS STADIUM  
NEW CLARK CITY, CAPAS TARLAC

MISCELLANEOUS DETAIL  
M8-02

# **AQUATICS CENTER**

**AS-BUILT  
MECHANICAL PLANS**



EQUIPMENT SCHEDULE 1

VRV SYSTEM-LGA (LOWER GROUND)

FAN COIL UNIT (FLOOR STANDING)				FAN COIL UNIT (CEILING CASSETTE)				FRESH AIR INTAKE (CONCEALED)			
UNIT DESIGNATION		QUANTITY		UNIT DESIGNATION		QUANTITY		UNIT DESIGNATION		QUANTITY	
FCL-LGA.1 TO FCL-LGA.5		5		FCL-LGA.6		1		FA-L-GA		1	
POWER SUPPLY		230V / 1PH / 60HZ		POWER SUPPLY		230V / 1PH / 60HZ		POWER SUPPLY		380V / 3PH / 60 HZ	
TR		4.0		TR		4.0		TR		31.53	
COOLING CAPACITY		KCAL/H 12,000 BTU/H 47,800		COOLING CAPACITY		KCAL/H 12,000 BTU/H 47,800		COOLING CAPACITY		KCAL/H 96,306 BTU/H 361,920	
POWER CONSUMPTION		KW 14.0		POWER CONSUMPTION		KW 14.0		POWER CONSUMPTION		KW 29.55	
AIRFLOW RATE (H/L)		M <sup>3</sup> /MIN 32.0/30.5/27.5		AIRFLOW RATE (H/L)		M <sup>3</sup> /MIN 29.0/27.0/24.0		AIRFLOW RATE (H/L)		M <sup>3</sup> /MIN 18	
SOUND LEVEL (H/L)		CFM 1,129/1,076/970		SOUND LEVEL (H/L)		CFM 1,023/952/846		SOUND LEVEL (H/L)		CFM 635	
DIMENSION (HxWxD)		MM 54/47		DIMENSION (HxWxD)		MM 44/42/39		DIMENSION (HxWxD)		MM 290+290	
MACHINE WEIGHT		KG 48		MACHINE WEIGHT		KG 840 x 288x 840		MACHINE WEIGHT		KG 307+307	
PIPING CONNECTIONS		LIQUID Ø9.52 GAS Ø15.88 DRAIN ID 18 HOSE		PIPING CONNECTIONS		LIQUID Ø9.52 GAS Ø15.88 DRAIN ID 18 HOSE		PIPING CONNECTIONS		LIQUID Ø9.52 GAS Ø15.88 DRAIN ID 18 HOSE	
REMARKS		UNIT IS SAMSUNG BRAND		REMARKS		UNIT IS SAMSUNG BRAND		REMARKS		UNIT IS SAMSUNG BRAND	

VRV SYSTEM-LGB2 (LOWER GROUND)

FAN COIL UNIT (CEILING CASSETTE)				FRESH AIR INTAKE (CONCEALED)				AIR COOLED CONDENSING UNIT (ACCU)			
UNIT DESIGNATION		QUANTITY		UNIT DESIGNATION		QUANTITY		UNIT DESIGNATION		QUANTITY	
FCL-LGB.1 TO FCL-LGB.6		6		FA-L-GA		1		ACCU-LGA		1	
POWER SUPPLY		230V / 1PH / 60HZ		POWER SUPPLY		230V / 1PH / 60HZ		POWER SUPPLY		380V / 3PH / 60 HZ	
TR		4.0		TR		4.0		TR		31.53	
COOLING CAPACITY		KCAL/H 12,000 BTU/H 47,800		COOLING CAPACITY		KCAL/H 12,000 BTU/H 47,800		COOLING CAPACITY		KCAL/H 96,306 BTU/H 361,920	
POWER CONSUMPTION		KW 14.0		POWER CONSUMPTION		KW 14.0		POWER CONSUMPTION		KW 29.55	
AIRFLOW RATE (H/L)		M <sup>3</sup> /MIN 32.0/30.5/27.5		AIRFLOW RATE (H/L)		M <sup>3</sup> /MIN 29.0/27.0/24.0		AIRFLOW RATE (H/L)		M <sup>3</sup> /MIN 18	
SOUND LEVEL (H/L)		CFM 1,129/1,076/970		SOUND LEVEL (H/L)		CFM 1,023/952/846		SOUND LEVEL (H/L)		CFM 635	
DIMENSION (HxWxD)		MM 54/47		DIMENSION (HxWxD)		MM 44/42/39		DIMENSION (HxWxD)		MM 290+290	
MACHINE WEIGHT		KG 48		MACHINE WEIGHT		KG 840 x 288x 840		MACHINE WEIGHT		KG 307+307	
PIPING CONNECTIONS		LIQUID Ø9.52 GAS Ø15.88 DRAIN ID 18 HOSE		PIPING CONNECTIONS		LIQUID Ø9.52 GAS Ø15.88 DRAIN ID 18 HOSE		PIPING CONNECTIONS		LIQUID Ø9.52 GAS Ø15.88 DRAIN ID 18 HOSE	
REMARKS		UNIT IS SAMSUNG BRAND		REMARKS		UNIT IS SAMSUNG BRAND		REMARKS		UNIT IS SAMSUNG BRAND	

VRV SYSTEM-LGC (LOWER GROUND)

FAN COIL UNIT (CEILING CASSETTE)				FAN COIL UNIT (CEILING CASSETTE)			
UNIT DESIGNATION		QUANTITY		UNIT DESIGNATION		QUANTITY	
FCL-LGC.6		1		FCL-LGC.1 TO FCL-LGC.5		5	
POWER SUPPLY		230V / 1PH / 60HZ		POWER SUPPLY		230V / 1PH / 60HZ	
TR		4.0		TR		4.0	
COOLING CAPACITY		KCAL/H 12,100 BTU/H 48,000		COOLING CAPACITY		KCAL/H 12,100 BTU/H 48,000	
POWER CONSUMPTION		KW 14.07		POWER CONSUMPTION		KW 14.07	
AIRFLOW RATE (H/L)		M <sup>3</sup> /MIN 29.0/27.0/24.0		AIRFLOW RATE (H/L)		M <sup>3</sup> /MIN 29.0/27.0/24.0	
SOUND LEVEL (H/L)		CFM 1,023/952/846		SOUND LEVEL (H/L)		CFM 1,023/952/846	
DIMENSION (HxWxD)		MM 44/42/39		DIMENSION (HxWxD)		MM 44/42/39	
MACHINE WEIGHT		KG 840 x 288 x 840		MACHINE WEIGHT		KG 840 x 288 x 840	
PIPING CONNECTIONS		LIQUID Ø9.52 GAS Ø15.88 DRAIN ID 18 HOSE		PIPING CONNECTIONS		LIQUID Ø9.52 GAS Ø15.88 DRAIN ID 18 HOSE	
REMARKS		UNIT IS SAMSUNG BRAND		REMARKS		UNIT IS SAMSUNG BRAND	

VRV SYSTEM-LGD (LOWER GROUND)

FAN COIL UNIT (CEILING CASSETTE)				FAN COIL UNIT (CEILING CASSETTE)			
UNIT DESIGNATION		QUANTITY		UNIT DESIGNATION		QUANTITY	
FCL-LGD.4		1		FCL-LGD.2, FCL-LGD.3, FCL-LGD.5, FCL-LGD.8		4	
POWER SUPPLY		230V / 1PH / 60HZ		POWER SUPPLY		230V / 1PH / 60HZ	
TR		2.0		TR		4.0	
COOLING CAPACITY		KCAL/H 6,051		COOLING CAPACITY		KCAL/H 12,100	
POWER CONSUMPTION		KW 7.555		POWER CONSUMPTION		KW 14.07	
AIRFLOW RATE (H/L)		M <sup>3</sup> /MIN 17.50/16.0/14.0		AIRFLOW RATE (H/L)		M <sup>3</sup> /MIN 29.0/27.0/24.0	
SOUND LEVEL (H/L)		CFM 618/565/494		SOUND LEVEL (H/L)		CFM 1,023/952/846	
DIMENSION (HxWxD)		MM 39/34/30		DIMENSION (HxWxD)		MM 44/42/39	
MACHINE WEIGHT		KG 15		MACHINE WEIGHT		KG 840 x 288 x 840	
PIPING CONNECTIONS		LIQUID Ø6.35 GAS Ø12.7 DRAIN ID 18 HOSE		PIPING CONNECTIONS		LIQUID Ø9.52 GAS Ø15.88 DRAIN ID 18 HOSE	
REMARKS		UNIT IS SAMSUNG BRAND		REMARKS		UNIT IS SAMSUNG BRAND	

VRV SYSTEM-LGE (LOWER GROUND)

FAN COIL UNIT (CEILING CASSETTE)				FAN COIL UNIT (CEILING CASSETTE)			
UNIT DESIGNATION		QUANTITY		UNIT DESIGNATION		QUANTITY	
FCL-LGE.3, FCL-LGE.4, FCL-LGE.7		2		FCL-LGE.3, FCL-LGE.4, FCL-LGE.7		5	
POWER SUPPLY		230V / 1PH / 60HZ		POWER SUPPLY		230V / 1PH / 60HZ	
TR		2.5		TR		4.0	
COOLING CAPACITY		KCAL/H 7,565		COOLING CAPACITY		KCAL/H 12,100	
POWER CONSUMPTION		KW 8.79		POWER CONSUMPTION		KW 14.07	
AIRFLOW RATE (H/L)		M <sup>3</sup> /MIN 22/19.5/17.0		AIRFLOW RATE (H/L)		M <sup>3</sup> /MIN 29.0/27.0/24.0	
SOUND LEVEL (H/L)		CFM 776/688/600		SOUND LEVEL (H/L)		CFM 1,023/952/846	
DIMENSION (HxWxD)		MM 39/34/30		DIMENSION (HxWxD)		MM 44/42/39	
MACHINE WEIGHT		KG 288 x 840 x 840		MACHINE WEIGHT		KG 840 x 288 x 840	
PIPING CONNECTIONS		LIQUID Ø9.52 GAS Ø15.88 DRAIN ID 18 HOSE		PIPING CONNECTIONS		LIQUID Ø9.52 GAS Ø15.88 DRAIN ID 18 HOSE	
REMARKS		UNIT IS SAMSUNG BRAND		REMARKS		UNIT IS SAMSUNG BRAND	

FRESH AIR INTAKE (CONCEALED)

UNIT DESIGNATION		QUANTITY		UNIT DESIGNATION		QUANTITY	
FA-L-GA		1		ACCU-LGC		1	
POWER SUPPLY		230V / 1PH / 60HZ		POWER SUPPLY		380V / 3PH / 60 HZ	
TR		30.28		TR		91.663	
COOLING CAPACITY		KCAL/H 11,953		COOLING CAPACITY		KCAL/H 363,506	
POWER CONSUMPTION		KW 106.6		POWER CONSUMPTION		KW 28.55	
AIRFLOW RATE (H/L)		M <sup>3</sup> /MIN 14.0		AIRFLOW RATE (H/L)		M <sup>3</sup> /MIN 4-100	
SOUND LEVEL (H/L)		CFM 635		SOUND LEVEL (H/L)		CFM 290+290	
DIMENSION (HxWxD)		MM 390 x 1,110 x 650		DIMENSION (HxWxD)		MM (1,295 x 1,695 x 765)+	
MACHINE WEIGHT		KG 51		MACHINE WEIGHT		KG 307+307	
PIPING CONNECTIONS		LIQUID Ø9.52 GAS Ø15.88 DRAIN ID 18 HOSE		PIPING CONNECTIONS		LIQUID Ø9.52 GAS Ø15.88 DRAIN ID 18 HOSE	
REMARKS		UNIT IS SAMSUNG BRAND		REMARKS		UNIT IS SAMSUNG BRAND	

FRESH AIR INTAKE (CONCEALED)

FRESH AIR INTAKE (CONCEALED)					AIR COOLED CONDENSING UNIT (ACCU)				
UNIT DESIGNATION		FA-L-GO.1 & FA-LG2.2			UNIT DESIGNATION		ACCU-LGD		
QUANTITY		2			QUANTITY		1		
POWER SUPPLY		230V / 1PH / 60HZ			POWER SUPPLY		380V / 3PH / 60 HZ		
TR		4.0			TR		35		
COOLING CAPACITY		KCAL/H 11,953			COOLING CAPACITY		KCAL/H 105,538		
BTU/H		47,400			BTU/H		420,112		
KW		14.0			KW		123.2		
POWER CONSUMPTION		KW 0.220			POWER CONSUMPTION		KW 34.7		
AIRFLOW RATE (H/L)		M <sup>3</sup> /MIN 18			POWER CONTROL		% 4-100		
ESP		PA 245			TYPE		SSC SCROLL x 2		
SOUND LEVEL (H/L)		dB(A) 42			MOTOR OUTPUT		KW 6.39 x 2		
DIMENSION (HxWxD)		MM 380 x 1,110 x 650			AIRFLOW RATE		M <sup>3</sup> /MIN 290		
MACHINE WEIGHT		KG 51			DIMENSION (HxWxD)		(1,295 x 1,695 x 795)		
LIQUID		ø9.52			MACHINE WEIGHT		KG 307		
GAS		ø15.88			SOUND LEVEL		dB(A) 66		
DRAIN		WP-25(INTERNAL DIA. 32/INTERNAL DIA. 25)			OPERATION RANGE		°CDB -5 TO 48		
REMARKS		UNIT IS SAMSUNG BRAND			REFRIGERANT		R-410A		
					TYPE		B-4		
					CHARGE		ø15.88 (BR42NG)		
					LIQUID		MM 4		
					GAS		ø28.38 (BR42NG)		

EQUIPMENT SCHEDULE 2

VRV SYSTEM-LGF (LOWER GROUND)

FAN COIL UNIT (CEILING CASSETTE)		FRESH AIR INTAKE (CONCEALED)		AIR COOLED CONDENSING UNIT (ACCU)	
UNIT DESIGNATION	QUANTITY	UNIT DESIGNATION	QUANTITY	UNIT DESIGNATION	QUANTITY
FOU-LGF-1 TO FOU-LGF-4	4	FAU-LGF-1FAU-LGF-2	2	ACCU-LGF	1
POWER SUPPLY	230V / 1PH / 60HZ	POWER SUPPLY	230V / 1PH / 60HZ	POWER SUPPLY	380V / 3PH / 60 HZ
TR	4.0	TR	4.0	TR	27.04
COOLING CAPACITY	KCAL/H 12,000	COOLING CAPACITY	KCAL/H 11,953	COOLING CAPACITY	KCAL/H 81,861
BTU/H	48,000	BTU/H	47,400	BTU/H	324,632
POWER CONSUMPTION	KW 14.07	POWER CONSUMPTION	KW 14.0	POWER CONSUMPTION	KW 26.15
W/MIN	0.95	W/MIN	0.220	W/MIN	1.63
AIRFLOW RATE (H/L) CFM	29.0/27.0/24.0	AIRFLOW RATE (H/L) CFM	18	SSC SPOOL X 2	(6.39 x 2)+(6.39 x 2)
1,023/952/846		1,023/952/846			
SOUND LEVEL (H/L) dB(A)	44/42/39	ESP	PA 245	COMPRESSOR OUTPUT	W/MIN 280+290
44/42/39		44/42/39			
DIMENSION (HxWxD) MM	840 x 288x 840	DIMENSION (HxWxD) MM	390 x 1,110 x 650	DIMENSION (HxWxD) MM	(1,295 x 1,685 x 785)+(1,295 x 1,685 x 785)
840 x 288x 840		840 x 288x 840			
MACHINE WEIGHT KG	18.5	MACHINE WEIGHT KG	51	MACHINE WEIGHT KG	307+307
18.5		18.5			
PIPING CONNECTIONS	LIQUID #9.52	LIQUID #9.52		PIPING CONNECTIONS	LIQUID #9.52
LIQUID #9.52		LIQUID #9.52		LIQUID #9.52	
GAS #15.88		GAS #15.88		GAS #15.88	
#15.88		#15.88		#15.88	
REMARKS	UNIT IS SAMSUNG BRAND	REMARKS	UNIT IS SAMSUNG BRAND	REMARKS	UNIT IS SAMSUNG BRAND

VRV SYSTEM-LGG (LOWER GROUND)

FAN COIL UNIT (CEILING CASSETTE)		FAN COIL UNIT (WALL MOUNTED)		AIR COOLED CONDENSING UNIT (ACCU)	
UNIT DESIGNATION	QUANTITY	UNIT DESIGNATION	QUANTITY	UNIT DESIGNATION	QUANTITY
FOU-LGG-1 TO FOU-LGG-9	9	FOU-LGG-6, FOU-LGG-7 & FOU-LGG-10	3	ACCU-LGG	1
POWER SUPPLY	230V / 1PH / 60HZ	POWER SUPPLY	230V / 1PH / 60HZ	POWER SUPPLY	380V / 3PH / 60 HZ
TR	4.0	TR	0.8	TR	19.1
COOLING CAPACITY	KCAL/H 6,051	COOLING CAPACITY	KCAL/H 2,386	COOLING CAPACITY	KCAL/H 57,821
BTU/H	24,000	BTU/H	8,78	BTU/H	223,300
POWER CONSUMPTION	KW 7.03	POWER CONSUMPTION	KW 0.95	POWER CONSUMPTION	KW 6.72
W/MIN	0.40	W/MIN	0.039	W/MIN	1.71
AIRFLOW RATE (H/L) CFM	17.50/16.0/14.0	AIRFLOW RATE (H/L) CFM	7.0/6.2/5.5	SSC SPOOL X 2	26.39 x 2
1,023/952/846		1,023/952/846			
SOUND LEVEL (H/L) dB(A)	44/42/39	SOUND LEVEL (H/L) dB(A)	14.7/13.0/11.0	COMPRESSOR OUTPUT	W/MIN 340
44/42/39		44/42/39			
DIMENSION (HxWxD) MM	288 x 840 x 840	DIMENSION (HxWxD) MM	820 x 285 x 227	DIMENSION (HxWxD) MM	1,295 x 1,795 765
288 x 840 x 840		820 x 285 x 227			
MACHINE WEIGHT KG	18.5	MACHINE WEIGHT KG	18.5	MACHINE WEIGHT KG	331
18.5		18.5			
PIPING CONNECTIONS	LIQUID #9.52	LIQUID #9.52		PIPING CONNECTIONS	LIQUID #9.52
LIQUID #9.52		LIQUID #9.52		LIQUID #9.52	
GAS #15.88		GAS #15.88		GAS #15.88	
#15.88		#15.88		#15.88	
REMARKS	UNIT IS SAMSUNG BRAND	REMARKS	UNIT IS SAMSUNG BRAND	REMARKS	UNIT IS SAMSUNG BRAND

VRV SYSTEM-UH (UPPER GROUND)

FRESH AIR INTAKE (CONCEALED)		AIR COOLED CONDENSING UNIT (ACCU)	
UNIT DESIGNATION	QUANTITY	UNIT DESIGNATION	QUANTITY
FAU-UH	1	ACCU-UH	1
POWER SUPPLY	230V / 1PH / 60HZ	POWER SUPPLY	230V / 1PH / 60 HZ
TR	4.0	TR	4.0
COOLING CAPACITY	KCAL/H 11,953	COOLING CAPACITY	KCAL/H 12,482
BTU/H	47,400	BTU/H	49,500
POWER CONSUMPTION	KW 14.0	POWER CONSUMPTION	KW 14.5
W/MIN	0.220	W/MIN	0.39
AIRFLOW RATE (H/L) CFM	18	COMPRESSOR OUTPUT	TWIN BLDC ROTARY x 1
18		COMPRESSOR OUTPUT	4.12
ESP	PA 635	AIRFLOW RATE (H/L) CFM	60
PA 245		ESP	PA 245
SOUND LEVEL (H/L) dB(A)	42	SOUND LEVEL (H/L) dB(A)	940 x 988 x 330
42		42	
DIMENSION (HxWxD) MM	390 x 1,110 x 650	DIMENSION (HxWxD) MM	76
390 x 1,110 x 650		76	
MACHINE WEIGHT KG	51	MACHINE WEIGHT KG	51
51		51	
PIPING CONNECTIONS	LIQUID #9.52	LIQUID #9.52	
LIQUID #9.52		LIQUID #9.52	
GAS #15.88		GAS #15.88	
#15.88		#15.88	
REMARKS	UNIT IS SAMSUNG BRAND	REMARKS	UNIT IS SAMSUNG BRAND

VRV SYSTEM-UG1 (UPPER GROUND)

FRESH AIR INTAKE (CONCEALED)		AIR COOLED CONDENSING UNIT (ACCU)	
UNIT DESIGNATION	QUANTITY	UNIT DESIGNATION	QUANTITY
FAU-UG1	1	ACCU-UG1	1
POWER SUPPLY	230V / 1PH / 60HZ	POWER SUPPLY	230V / 1PH / 60 HZ
TR	4.0	TR	4.0
COOLING CAPACITY	KCAL/H 11,953	COOLING CAPACITY	KCAL/H 13,768
BTU/H	47,400	BTU/H	54,600
POWER CONSUMPTION	KW 14.0	POWER CONSUMPTION	KW 16
W/MIN	0.220	W/MIN	0.42
AIRFLOW RATE (H/L) CFM	18	COMPRESSOR OUTPUT	TWIN BLDC ROTARY x 1
18		COMPRESSOR OUTPUT	4.12
ESP	PA 635	AIRFLOW RATE (H/L) CFM	95
PA 245		ESP	PA 245
SOUND LEVEL (H/L) dB(A)	42	SOUND LEVEL (H/L) dB(A)	940 x 1,210 x 330
42		42	
DIMENSION (HxWxD) MM	390 x 1,110 x 650	DIMENSION (HxWxD) MM	95
390 x 1,110 x 650		95	
MACHINE WEIGHT KG	51	MACHINE WEIGHT KG	51
51		51	
PIPING CONNECTIONS	LIQUID #9.52	LIQUID #9.52	
LIQUID #9.52		LIQUID #9.52	
GAS #15.88		GAS #15.88	
#15.88		#15.88	
REMARKS	UNIT IS SAMSUNG BRAND	REMARKS	UNIT IS SAMSUNG BRAND

VRV SYSTEM-P (PRESIDENTIAL SUITE)

FAN COIL UNIT (CEILING CASSETTE)		FAN COIL UNIT (CEILING CASSETTE)		AIR COOLED CONDENSING UNIT (ACCU)	
UNIT DESIGNATION	QUANTITY	UNIT DESIGNATION	QUANTITY	UNIT DESIGNATION	QUANTITY
FOU-P-1 TO FOU-P-5	5	FOU-P-6 TO FOU-P-8	3	ACCU-P-1 TO P-6	6
POWER SUPPLY	230V / 1PH / 60HZ	POWER SUPPLY	230V / 1PH / 60HZ	POWER SUPPLY	230V / 1PH / 60 HZ
TR	4.0	TR	1.5	TR	4.5
COOLING CAPACITY	KCAL/H 12,000	COOLING CAPACITY	KCAL/H 4,534	COOLING CAPACITY	KCAL/H 12,482
BTU/H	48,000	BTU/H	18,000	BTU/H	49,500
POWER CONSUMPTION	KW 14.07	POWER CONSUMPTION	KW 5.28	POWER CONSUMPTION	KW 14.5
W/MIN	0.330	W/MIN	0.032	W/MIN	0.39
AIRFLOW RATE (H/L) CFM	39.0/35.5/28.0	AIRFLOW RATE (H/L) CFM	15.5/14.0/12.0	COMPRESSOR OUTPUT	TWIN BLDC ROTARY x 1
39.0/35.5/28.0		15.5/14.0/12.0		COMPRESSOR OUTPUT	4.12
SOUND LEVEL (H/L) dB(A)	44/42/40	SOUND LEVEL (H/L) dB(A)	54/49/42/4	AIRFLOW RATE (H/L) CFM	60
44/42/40		54/49/42/4		ESP	PA 245
DIMENSION (HxWxD) MM	1,200 x 360 x 650	DIMENSION (HxWxD) MM	950 x 45x 950	DIMENSION (HxWxD) MM	940 x 988 x 330
1,200 x 360 x 650		950 x 45x 950		940 x 988 x 330	
MACHINE WEIGHT KG	62	MACHINE WEIGHT KG	15	MACHINE WEIGHT KG	76
62		15		76	
PIPING CONNECTIONS	LIQUID #9.52	LIQUID #9.52		PIPING CONNECTIONS	LIQUID #9.52
LIQUID #9.52		LIQUID #9.52		LIQUID #9.52	
GAS #15.88		GAS #15.88		GAS #15.88	
#15.88		#15.88		#15.88	
REMARKS	UNIT IS SAMSUNG BRAND	REMARKS	UNIT IS SAMSUNG BRAND	REMARKS	UNIT IS SAMSUNG BRAND

VRV SYSTEM-U (UTILITY BUILDING)

FAN COIL UNIT (CEILING CASSETTE)		FRESH AIR INTAKE (CONCEALED)		AIR COOLED CONDENSING UNIT (ACCU)	
UNIT DESIGNATION	QUANTITY	UNIT DESIGNATION	QUANTITY	UNIT DESIGNATION	QUANTITY
FOU-U-1 TO FOU-U-4	4	FAU-U	1	ACCU-U	1
POWER SUPPLY	230V / 1PH / 60HZ	POWER SUPPLY	230V / 1PH / 60 HZ	POWER SUPPLY	380V / 3PH / 60 HZ
TR	4.0	TR	11,953	TR	27.04
COOLING CAPACITY	KCAL/H 12,000	COOLING CAPACITY	KCAL/H 47,400	COOLING CAPACITY	KCAL/H 324,632
BTU/H	48,000	BTU/H	47,400	BTU/H	95.2
POWER CONSUMPTION	KW 14.07	POWER CONSUMPTION	KW 14.0	POWER CONSUMPTION	KW 26.15
W/MIN	0.95	W/MIN	0.220	W/MIN	1.63
AIRFLOW RATE (H/L) CFM	29.0/27.0/24.0	AIRFLOW RATE (H/L) CFM	18	SSC SPOOL X 2	(6.39 x 2)+(6.39 x 2)
1,023/952/846		1,023/952/846			
SOUND LEVEL (H/L) dB(A)	44/42/39	ESP	PA 245	COMPRESSOR OUTPUT	W/MIN 280+290
44/42/39		44/42/39			
DIMENSION (HxWxD) MM	840 x 288x 840	DIMENSION (HxWxD) MM	390 x 1,110 x 650	DIMENSION (HxWxD) MM	(1,295 x 1,685 x 785)+(1,295 x 1,685 x 785)
840 x 288x 840		390 x 1,110 x 650			
MACHINE WEIGHT KG	18.5	MACHINE WEIGHT KG	51	MACHINE WEIGHT KG	307+307
18.5		51			
PIPING CONNECTIONS	LIQUID #9.52	LIQUID #9.52		PIPING CONNECTIONS	LIQUID #9.52
LIQUID #9.52		LIQUID #9.52		LIQUID #9.52	
GAS #15.88		GAS #15.88		GAS #15.88	
#15.88		#15.88		#15.88	
REMARKS	UNIT IS SAMSUNG BRAND	REMARKS	UNIT IS SAMSUNG BRAND	REMARKS	UNIT IS SAMSUNG BRAND

VRV SYSTEM-UG1.1 (UPPER GROUND)

FAN COIL UNIT (FLOOR STANDING)		AIR COOLED CONDENSING UNIT (ACCU)	
UNIT DESIGNATION	QUANTITY	UNIT DESIGNATION	QUANTITY
FOU-UG1.1 TO FOU-UG1.3	3	ACCU-UG1.1	1
POWER SUPPLY	230V / 1PH / 60HZ	POWER SUPPLY	380V / 3PH / 60 HZ
TR	4.0	TR	12.8
COOLING CAPACITY	KCAL/H 12,000	COOLING CAPACITY	KCAL/H 38,695
BTU/H	47,800	BTU/H	153,450
POWER CONSUMPTION	KW 14.0	POWER CONSUMPTION	KW 45
W/MIN	0.19	W/MIN	11.4
AIRFLOW RATE (H/L) CFM	32.0/30.5/27.5	COMPRESSOR OUTPUT	SSC SPOOL X 2
32.0/30.5/27.5		COMPRESSOR OUTPUT	4.39 x 2
SOUND LEVEL (H/L) dB(A)	54/47	AIRFLOW RATE (H/L) CFM	255
54/47		1,295 x 1,795 765	
DIMENSION (HxWxD) MM	610 x 1,850 x400	DIMENSION (HxWxD) MM	289
610 x 1,850 x400		289	
MACHINE WEIGHT KG	48	MACHINE WEIGHT KG	63
48		63	
PIPING CONNECTIONS	LIQUID #9.52	LIQUID #9.52	
LIQUID #9.52		LIQUID #9.52	
GAS #15.88		GAS #15.88	
#15.88		#15.88	
REMARKS	UNIT IS SAMSUNG BRAND	REMARKS	UNIT IS SAMSUNG BRAND

VRV SYSTEM-UG1.1 (UPPER GROUND)

FAN COIL UNIT (FLOOR STANDING)		AIR COOLED CONDENSING UNIT (ACCU)	
UNIT DESIGNATION	QUANTITY	UNIT DESIGNATION	QUANTITY
FOU-UG1.1 TO FOU-UG1.4	4	ACCU-UG1.1	1
POWER SUPPLY	230V / 1PH / 60HZ	POWER SUPPLY	380V / 3PH / 60 HZ
TR	4.0	TR	12.8
COOLING CAPACITY	KCAL/H 12,000	COOLING CAPACITY	KCAL/H 38,695
BTU/H	47,800	BTU/H	153,450
POWER CONSUMPTION	KW 14.0	POWER CONSUMPTION	KW 45
W/MIN	0.19	W/MIN	11.4
AIRFLOW RATE (H/L) CFM	32.0/30.5/27.5	COMPRESSOR OUTPUT	SSC SPOOL X 2
32.0/30.5/27.5		COMPRESSOR OUTPUT	4.39 x 2
SOUND LEVEL (H/L) dB(A)	54/47	AIRFLOW RATE (H/L) CFM	255
54/47		1,295 x 1,795 765	
DIMENSION (HxWxD) MM	610 x 1,850 x400	DIMENSION (HxWxD) MM	289
610 x 1,850 x400		289	
MACHINE WEIGHT KG	48	MACHINE WEIGHT KG	63
48		63	
PIPING CONNECTIONS	LIQUID #9.52	LIQUID #9.52	
LIQUID #9.52		LIQUID #9.52	
GAS #15.88		GAS #15.88	
#15.88		#15.88	
REMARKS	UNIT IS SAMSUNG BRAND	REMARKS	UNIT IS SAMSUNG BRAND

GRAPHIC SCALE:



OWNER: NGAC PHASE 1 JV COMPANY

PREPARED BY:

REVIEWED AND VALIDATED BY:

SUBMITTED BY:

CERTIFIED BY: INDEPENDENT CONSULTANT

PROJECT TITLE:

SHEET CONTENTS:

SHEET NO.



BCDA  
BAYAN LEPUS CONSTRUCTION DEVELOPMENT AUTHORITY



AND  
ANGLO-AMERICAN DEVELOPMENT



Hilmar's Construction Corporation  
1835 E. Rodriguez St., Avenue Cebu, Cebu City



Filipinas Dravo Corporation  
Architectural & Engineering Corporation  
1835 E. Rodriguez St., Avenue Cebu, Cebu City



BANDAR HEBAT BUILDERS, INC.  
ISMA S. DAVID



TCGI ENGINEERS  
VIRGILIO A. MADRADO

AS-BUILT DRAWING  
NGAC PHASE 1A  
AQUATIC CENTER

EQUIPMENT SCHEDULE 2  
M1-02

## EQUIPMENT SCHEDULES

**DIRECT EXPANSION SYSTEM - MDF, TELCO & FCC AREA**

FAN COIL UNIT (WALL MOUNTED)

FAN COIL UNIT (WALL MOUNTED)					
UNIT DESIGNATION			FCU-MDF.1, FCU-MDF.2, FCU-TEL.1 & FCU-TEL.2		
QUANTITY			4		
POWER SUPPLY			230V / 1PH / 60HZ		
COOLING CAPACITY			2		
			TR		
			1.0		
			KCAL/H		
BTU/H			3000		
KW			11,900		
INDOOR UNIT			3.5		
POWER CONSUMPTION			0.050		
AIRFLOW RATE (H)			0.060		
M <sup>3</sup> /MIN			10.10/9.97/7.9		
CFM			356/348/279		
SOUND LEVEL (H/A/BSL)			17.8/14.3/10.6		
dB(A)			628/504/374		
37/34/30/23			44/39/35/27		
DIMENSION (HxWxD)			44/39/35/27		
MM			285 x 820 x 215		
1065 x298 x 230			8.0		
MACHINE WEIGHT			11.5		
KG			8.0		
OUTDOOR UNIT					
COMPRESSOR			TWIN BLOC ROTARY		
TYPE			TWIN BLOC ROTARY		
MOTOR OUTPUT			W		
4.454			7.766		
REFRIGERANT			R410A		
R410A			1.3		
CHARGE			2.8		
KG			45		
H/SL			48		
DB (A)			790 x 548 x 285		
DIMENSIONS			880 x 798 x 310		
H X W X D			MM		
790 x 548 x 285			37.9		
MACHINE WEIGHT			65		
KG			-5 TO 46		
OPERATION RANGE			-5 TO 46		
COB			46.35 x 2		
LIQUID			46.35 x 2		
PIPING CONNECTIONS			49.52 x 2 + 12.7 x 1		
GAS			-		
MM			-		
DRAIN			30		
MAX. PIPING LENGTH			15		
M			15		
MAX. LEVEL DIFFERENCE			70		
M			15		
REMARKS			UNIT IS SAMSUNG BRAND		
UNIT IS SAMSUNG BRAND			UNIT IS SAMSUNG BRAND		

[illegible]

EXHAUST FAN (EF) - EE ROOM & UTILITY BUILDING : TOILET EXHAUST FAN (TEF) - PRESIDENTIAL SUITE

EXHAUST FAN (EF) – EE ROOM & UTILITY BUILDING : TOILET EXHAUST FAN (TEF) – RESIDENTIAL SUITE								
UNIT DESIGNATION	TEF-U	TEF-P-1 & TEF-P-2	EF-EE	EF-U-5 & EF-U-6	EF-U-3 & EF-U-4	EF-U-7 & EF-U-8	EF-U-9	EF-U-1 & EF-U-2
QUANTITY	1	2	2	2	2	2	1	2
LOCATION	DRY LAND TOILET AREA	TOILET AREA	EE ROOM	METERING VALVE	LIVING ROOM	GENSET ROOM	EQUIPMENT ROOM	TRANSFORMER ROOM
POWER SUPPLY	220V / 1PH / 60HZ	220V / 1PH / 60HZ	220V / 1PH / 60HZ	220V / 1PH / 60HZ	220V / 1PH / 60HZ	220V / 1PH / 60HZ	220V / 1PH / 60HZ	220V / 1PH / 60HZ
AIR VOLUME (CFM)	80	159	280	1,224	1,730	5,539	5,539	10,350
EXTERNAL STATIC PRESSURE (P0)	40	40	40	20	20	20	20	
TYPE	WALL MOUNTED	CEILING CASSETTE	CEILING CASSETTE	WALL MOUNTED	WALL MOUNTED	WALL MOUNTED	WALL MOUNTED	WALL MOUNTED
CONSUMPTION (KW)	0.033	0.033	0.061	0.080	0.127	0.361	0.361	0.912
FAN SPEED (R.P.M)	570	570	540	1,560	1,660	1,150	1,150	1150
NOISE dB(A)	34	34	33	42	48	54	54	54
WEIGHT (KG)	4.4	4.4	5.6	6.1	10.5	34	34	34
BASIS OF DESIGN		SIMILAR TO KOK OR APPROVED EQUAL						

SIMILAR TO KDK OR APPROVED EQUIVALENT

Notes

Pursuant to Section 9 of Annex "A" of the Revised Implementing Rules and Regulations of R.A. 9184, approval of detailed engineering survey and design undertaken by Design Consultants neither diminishes the responsibility of the client for the technical integrity of the surveys and designs nor transfer any part of that responsibility to the approving officials. The Design Consultant shall be held fully responsible for the failure of the facilities/structures due to faulty design except for the changes made without the conformity of the Design Consultants.

**GRAPHIC SCALE:**



OWNER: NGAC PHASE I JV COMPANY	PREPARED BY:	REVIEWED AND VALIDATED BY:	SUBMITTED BY:	CERTIFIED BY: INDEPENDENT CONSULTANT	PROJECT TITLE:	SHEET CONTENTS:	SHEET NO.
 <b>BCDA</b> BAY AREA COMMUNITY DEVELOPMENT AUTHORITY 1000 BAY STREET, SUITE 200 OAKLAND, CA 94612 (415) 774-2000 AND  <b>MWD</b> MARIN WATER DISTRICT 1000 MARIN AVENUE, SUITE 200 SAN ANTONIO, CA 94963 (415) 774-2000 AWEONIO B. OZON PRESIDENT PATRICK NICHOLAS P. DAVID PRESIDENT	 <b>Hilmarc's Construction Corporation</b> 1855 E. Rodriguez St., Hayward, Calif. 94541 JESUS V. HERBAS PROJECT MANAGER	 <b>FILIPINAS DRAVO CORPORATION</b> Architectural & Engineering Consultants 1000 BAY STREET, SUITE 200 OAKLAND, CA 94612 (415) 774-2000 ALFREDO R. REVILLA PROJECT MANAGER	 <b>BANDAR HEBAT BUILDERS, INC.</b> ISMAIC S. DAVID PRESIDENT	 <b>TCGI ENGINEERS</b> 1000 BAY STREET, SUITE 200 OAKLAND, CA 94612 (415) 774-2000 VIRGILIO A. MADRZO PRESIDENT	<b>AS-BUILT DRAWING</b> NGAC PHASE 1A <b>AQUATIC CENTER</b> NEW CLARK CITY, CAPAS, TAPALC	<b>EQUIPMENT SCHEDULE 3</b> <b>M1-03</b>	





**SCALE:**

1:100

**GRAPHIC SCALE:**



**Note:**


Pursuant to Section 4 of Annex 'A' of the Revised Implementing Rules and Regulations of R.A. 9184, approval of detailed engineering survey and design undertaken by Design Consultants neither diminishes the responsibility of the latter for the technical integrity of the surveys and designs nor transfer any part of that responsibility to the approving officials.

The Design Consultant shall be held fully responsible for the fairness of the facilities/structures to be fully design except for the changes made without the conformity of the Design Consultants.


OWNER: NGAC PHASE I JV COMPANY




PREPARED BY:

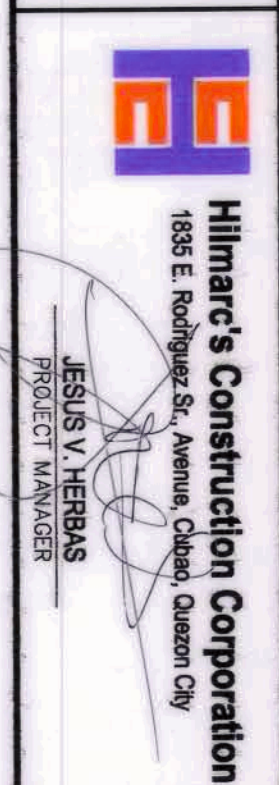


REVIEWED AND VALIDATED BY:

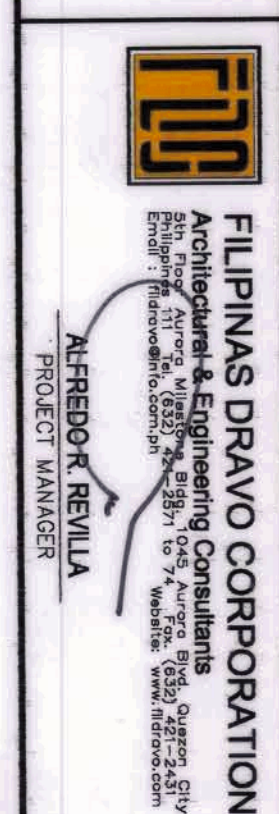

SUBMITTED BY:

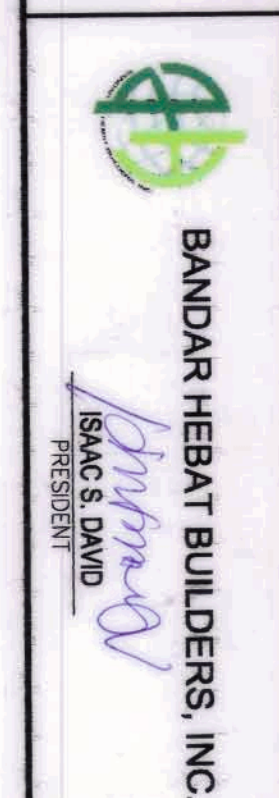

CERTIFIED BY: INDEPENDENT CONSULTANT

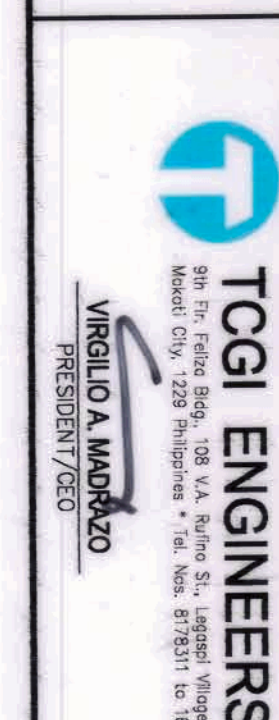

PROJECT TITLE:


**AS-BUILT DRAWING**

NGAC PHASE 1A


**AQUATIC CENTER**  
NEW CLARK CITY, CAPAS, TARLAC

SHEET CONTENTS:

SHEET NO.

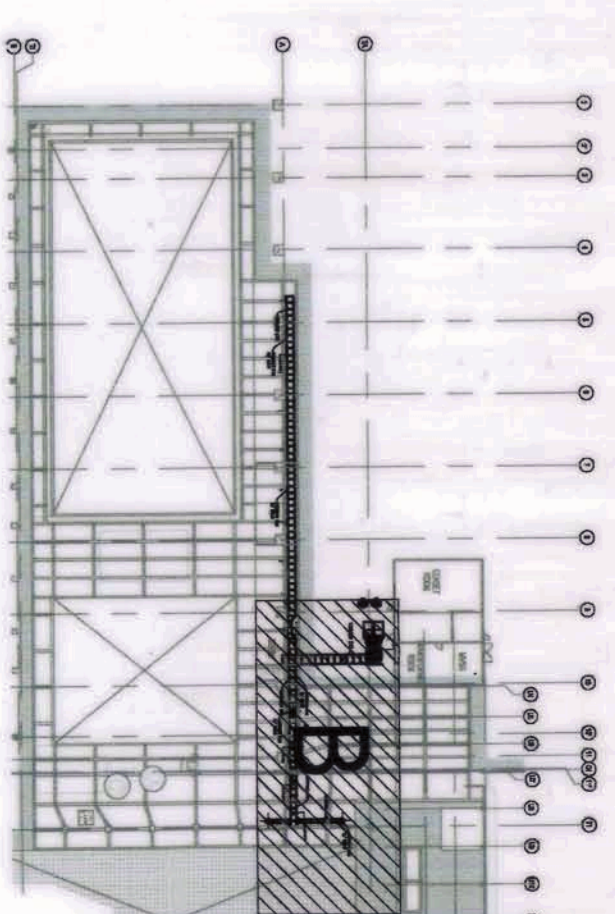

KEYPLAN

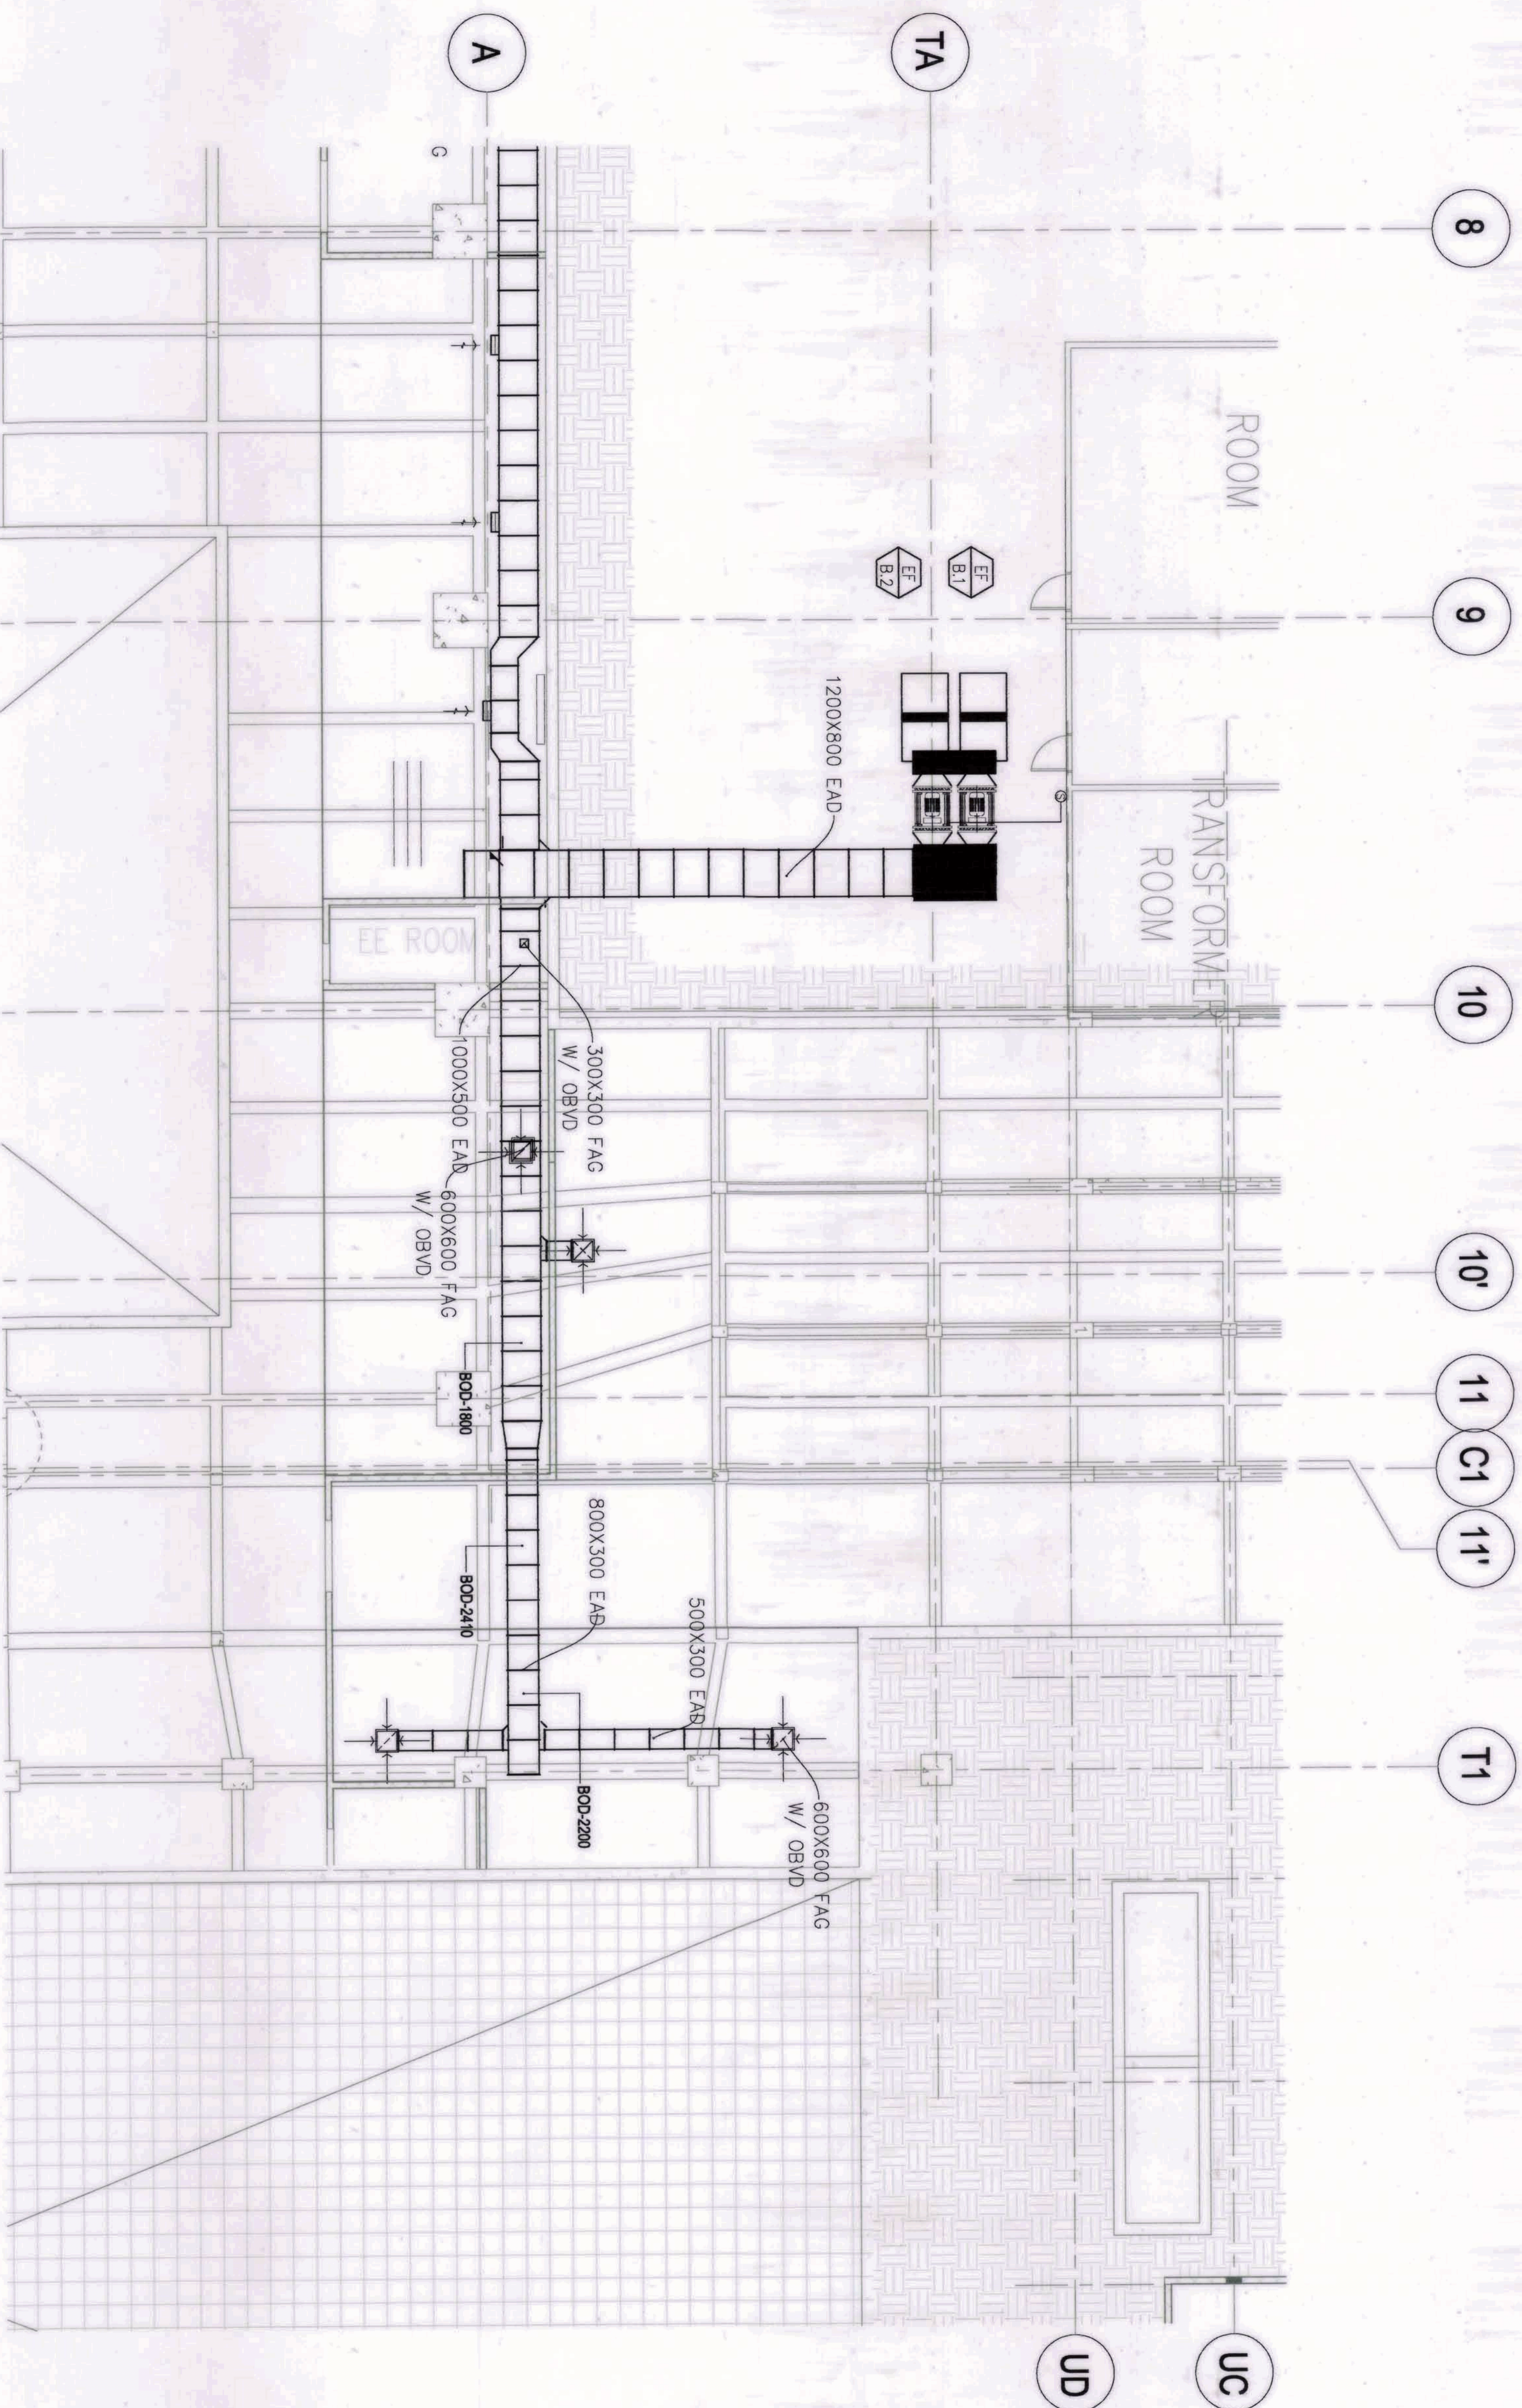

PARTIAL-B  
BASEMENT VENTILATION LAYOUT

1  
M2-01B

SCALE:

1:100

GRAPHIC SCALE:  
4000 2000 0 4000 10000  
SCALE 1:100



OWNER: NGAC PHASE 1 JV COMPANY

PREPARED BY:

REVIEWED AND VALIDATED BY:

SUBMITTED BY:

CERTIFIED BY: INDEPENDENT CONSULTANT

PROJECT TITLE:

SHEET NO.

BCDA  
PRESIDENT  
AND  
PRESIDENT

Hilmar's Construction Corporation  
1839 E. Rodriguez St., Avenue, Cebu, Quezon City  
PROJECT MANAGER


FILIPINAS DRAVO CORPORATION  
PROJECT MANAGER

BANDAR HERBAT BUILDERS, INC.  
PRESIDENT


TCGI ENGINEERS  
PRESIDENT

AS-BUILT DRAWING  
NGAC PHASE 1A  
AQUATIC CENTER  
NEW CLARK CITY CAPAS, TARLAC

PARTIAL-B BASEMENT  
VENTILATION LAYOUT  
M2-01B

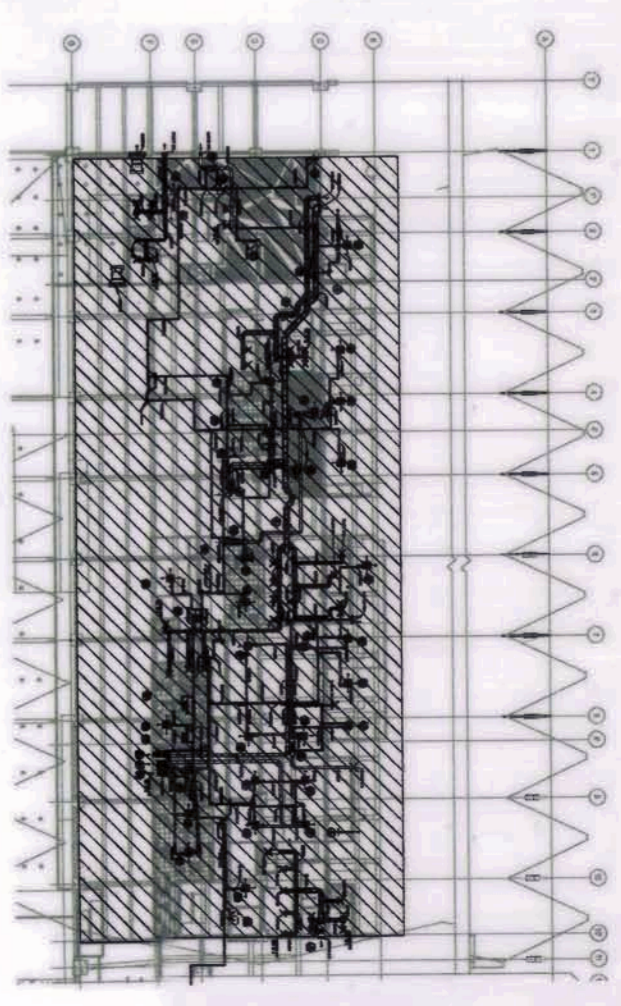

KEYPLAN

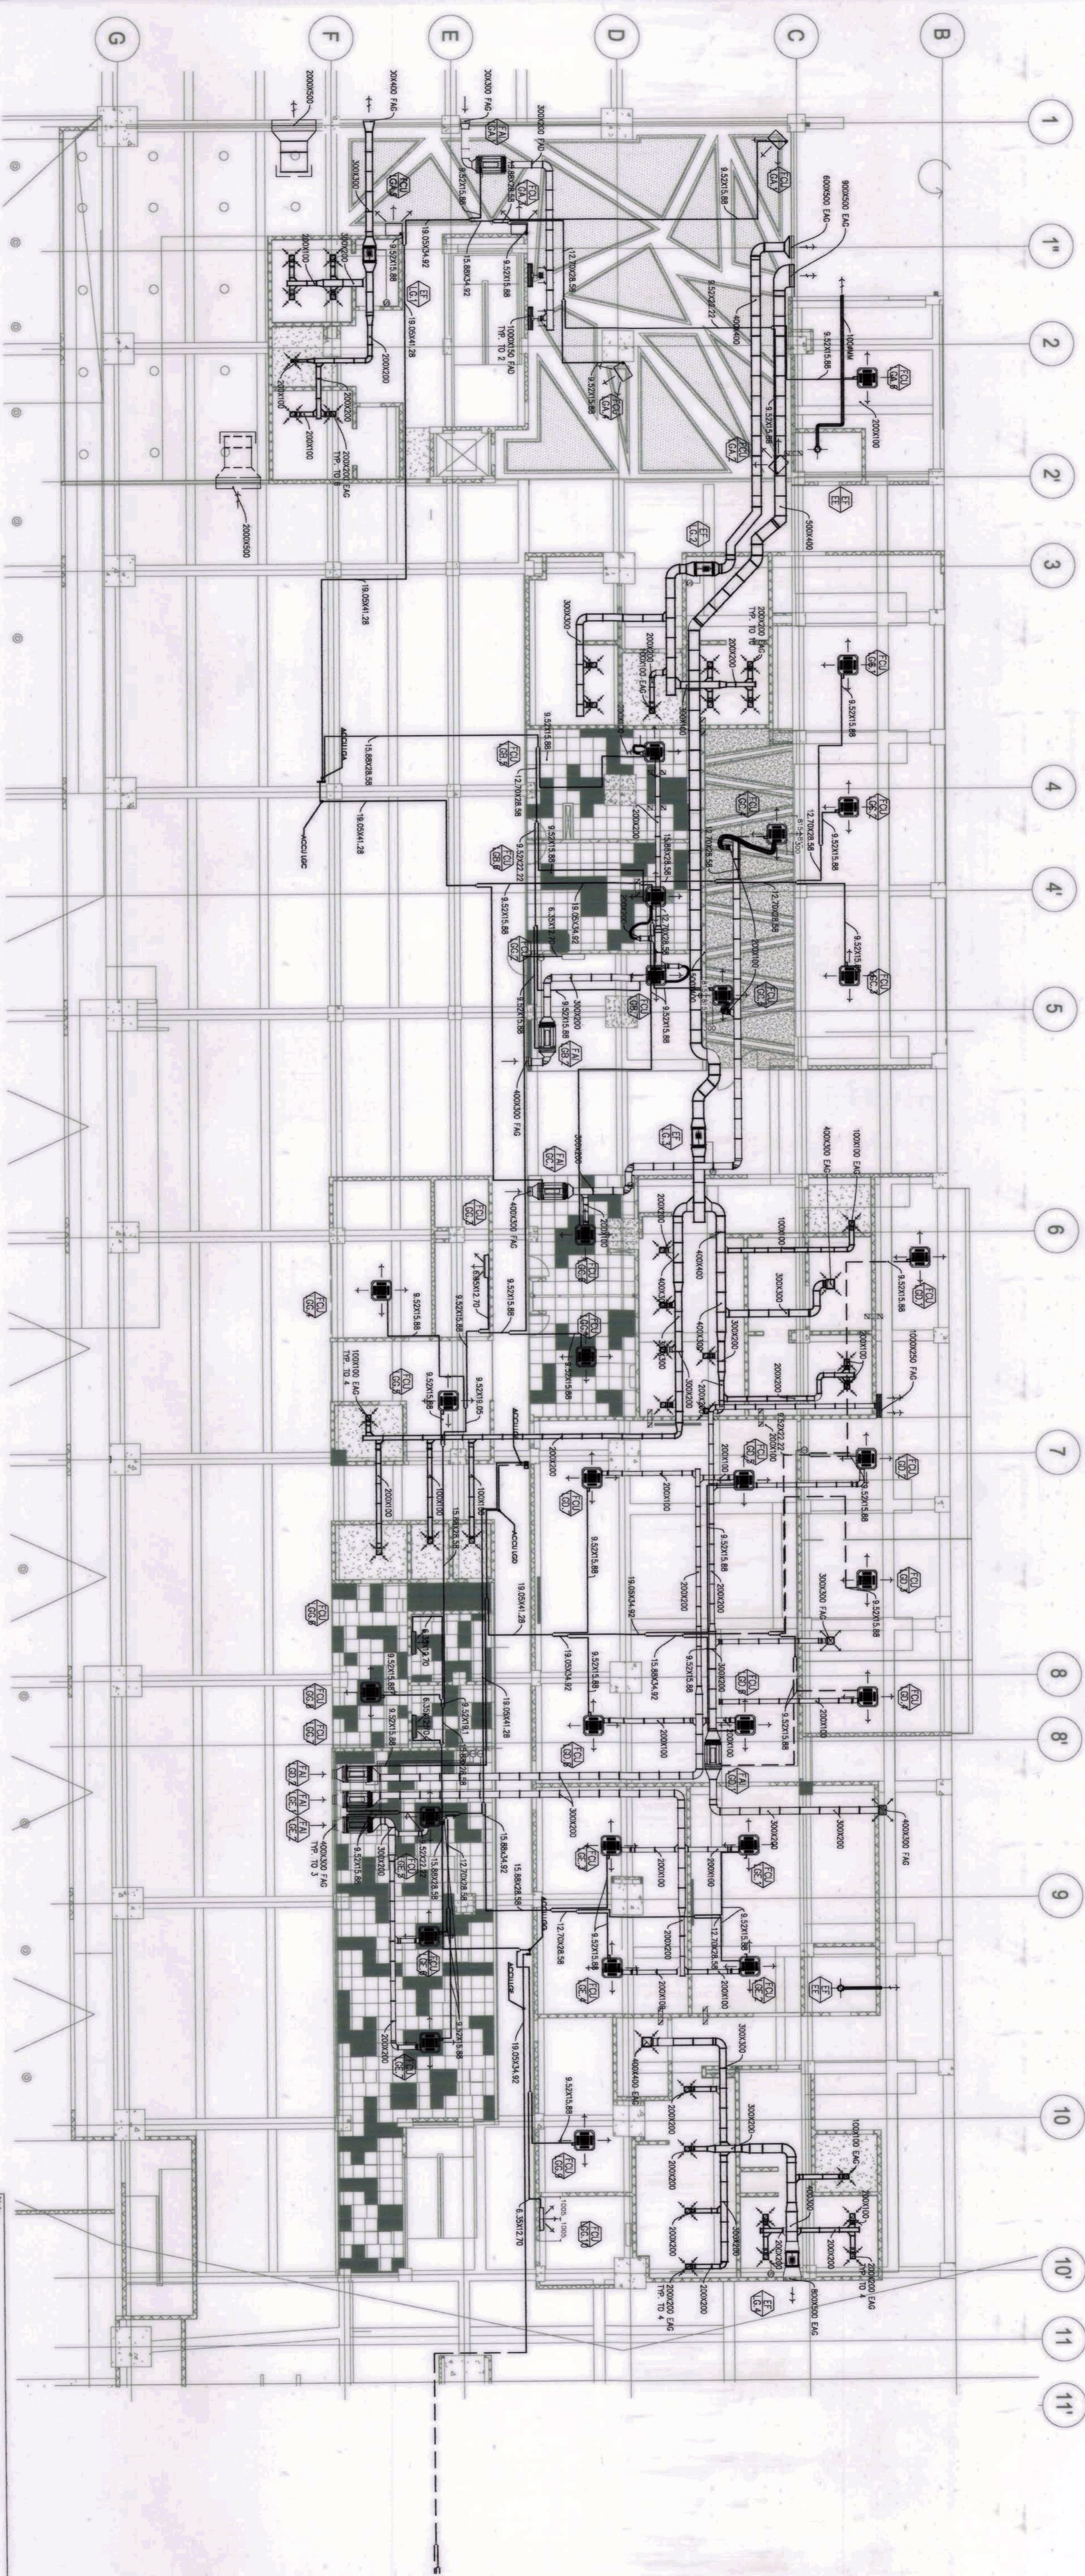

1  
LOWER GROUND FLOOR AC & VENTILATION LAYOUT  
SCALE: 1:150

GRAPHIC SCALE:



OWNER: NGAC PHASE 1 JV COMPANY

PREPARED BY:

REVIEWED AND VALIDATED BY:

SUBMITTED BY:

CERTIFIED BY: INDEPENDENT CONSULTANT



PROJECT TITLE:

SHEET CONTENTS:

SHEET NO.

 BICENTENNIAL COMMISSION AND VINCENZO P. DIZON PRESIDENT	 Hilmar's Construction Corporation 1635 E. Rodriguez St., Avenue, Cebu, Cebu City JESUS V. HERBAS PROJECT MANAGER	 FILIPINAS DRAVO CORPORATION Architectural & Engineering Consultants Rm. 101, 10th Floor, United Building, 1201, E. Rodriguez St., Cebu City ALFREDO R. BENTUA PROJECT MANAGER	 BANDAR HEBAT BUILDERS, INC. ISAAC S. DAVID PRESIDENT	 TCGI ENGINEERS Rm. 10, 10th Floor, 108 A, 10th St., Cebu City VIRILLO A. MADRZO PRESIDENT/CEO	AS-BUILT DRAWING NGAC PHASE 1A AQUATIC CENTER NEW CLARK CITY, CAPAS, TARLAC	LOWER GROUND FLOOR AC & VENTILATION LAYOUT M2-02
--	---	---	--	--	--	--



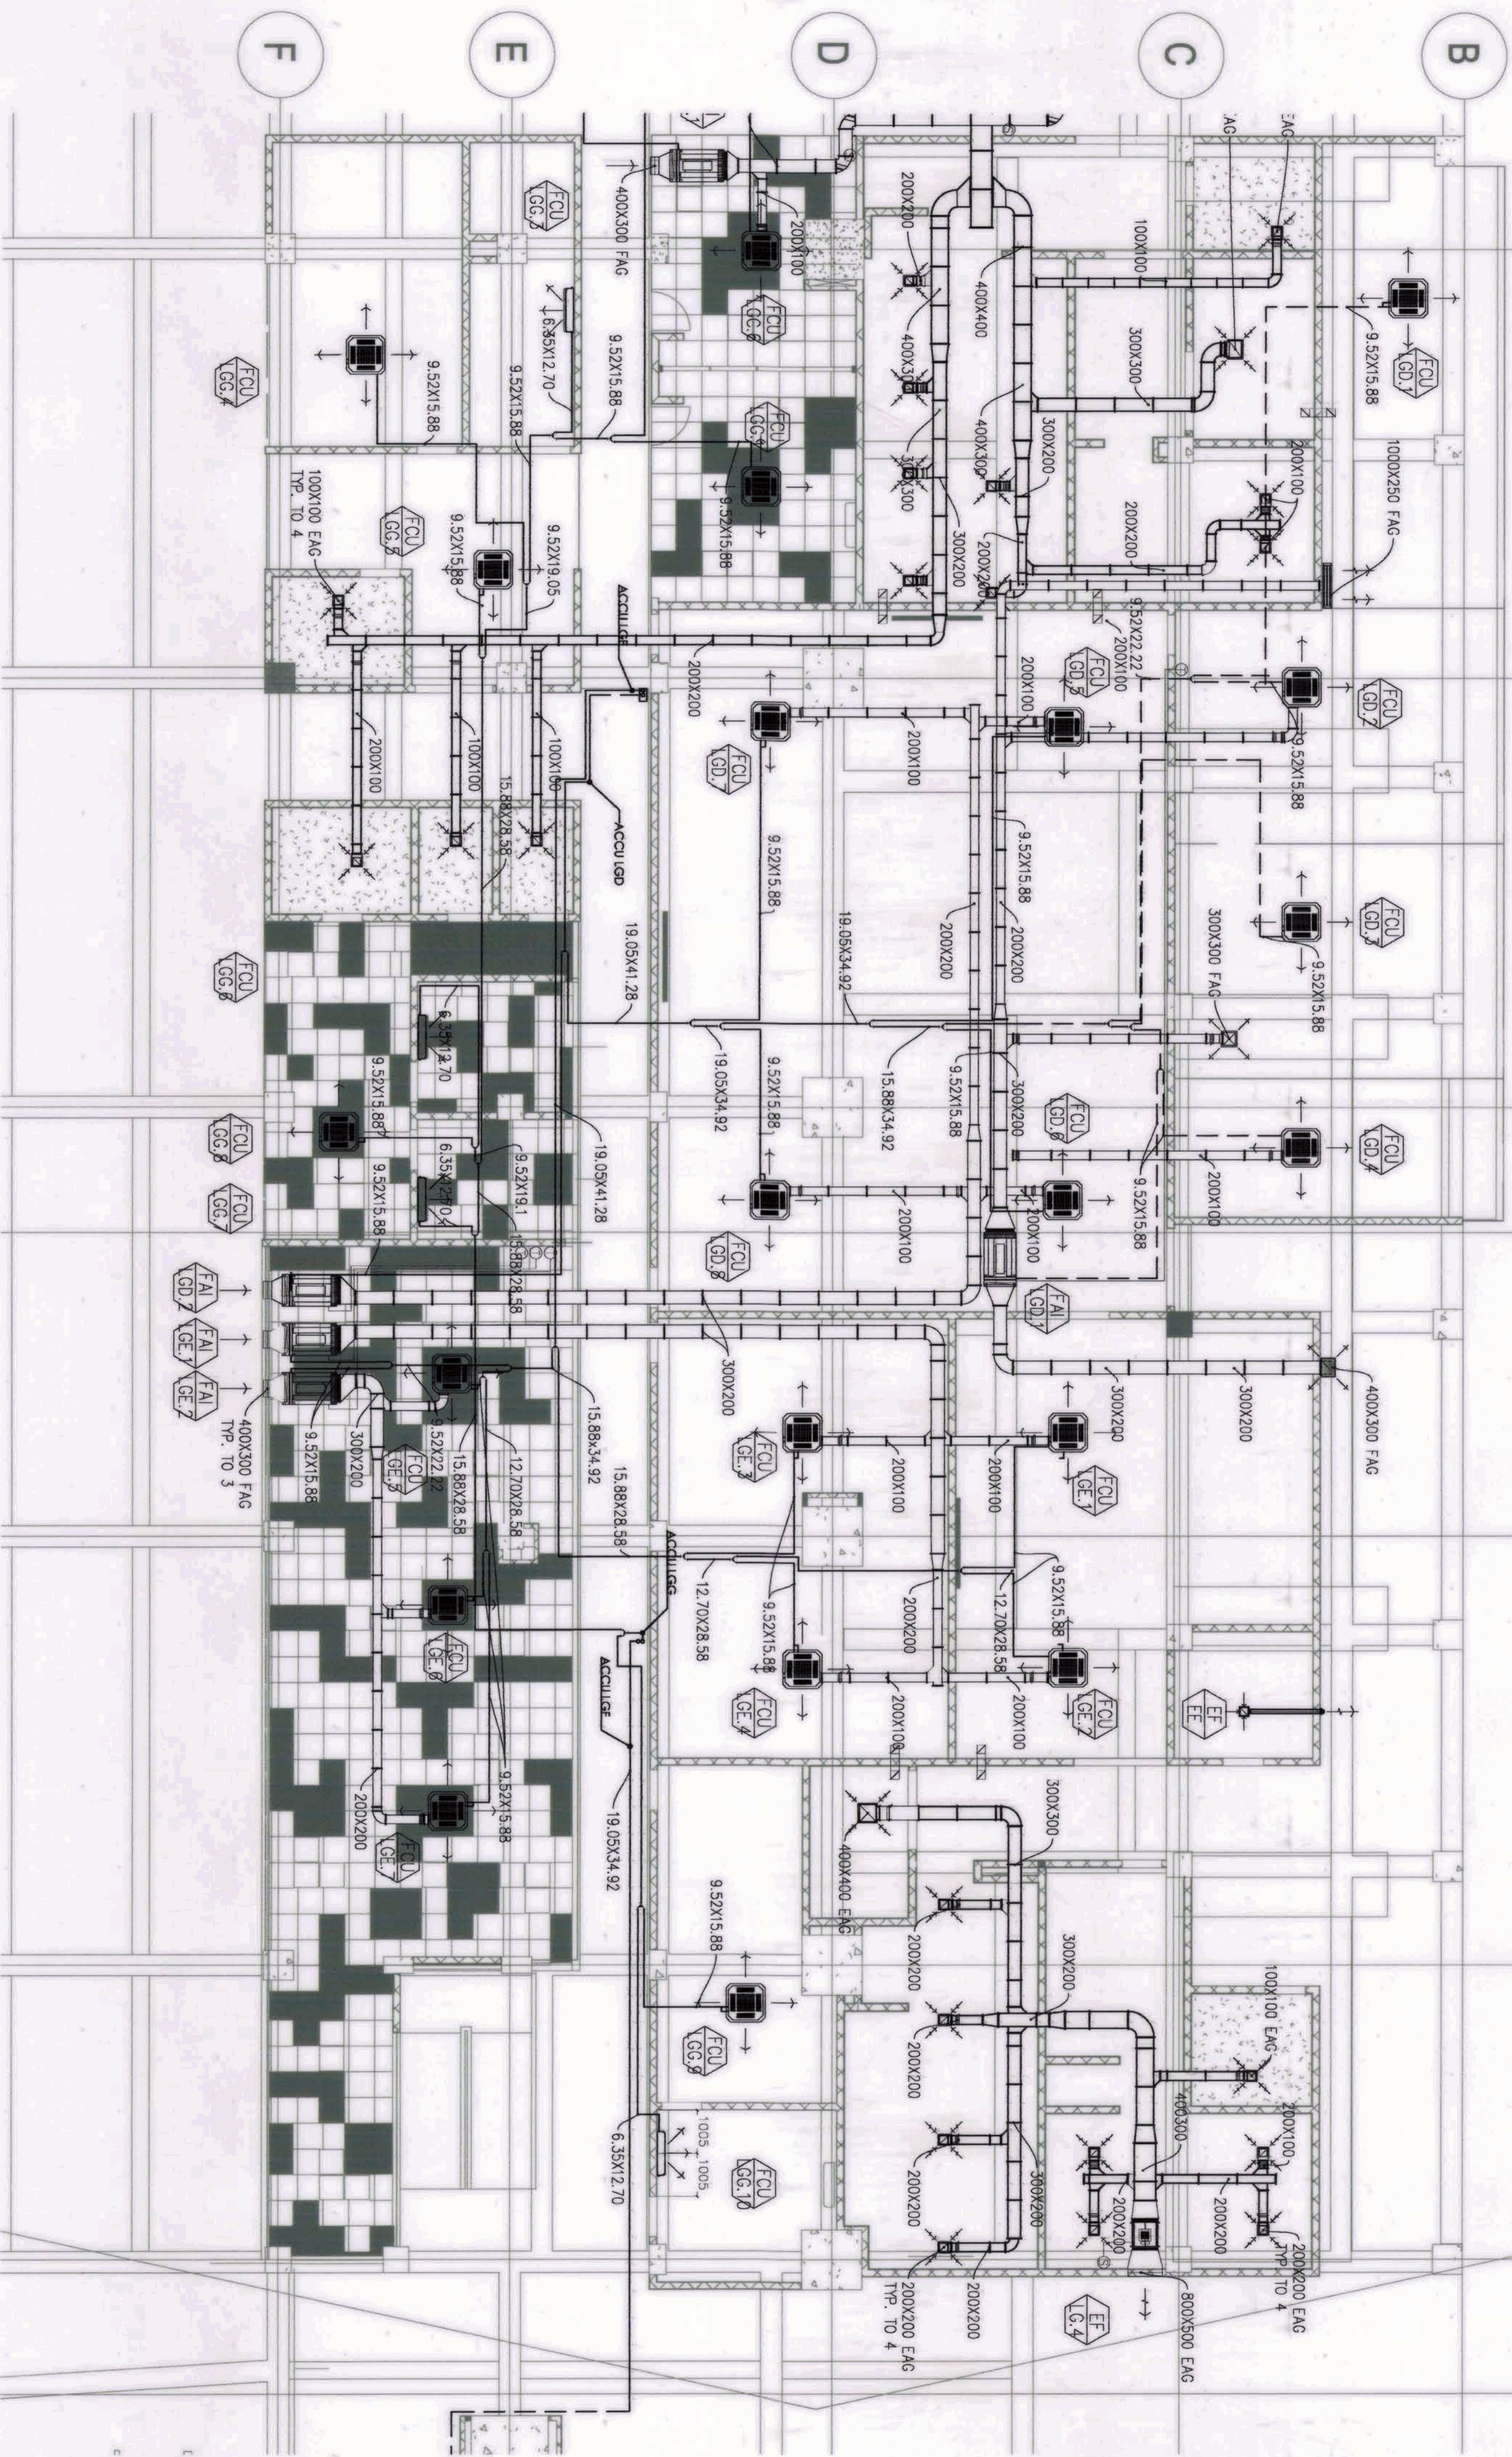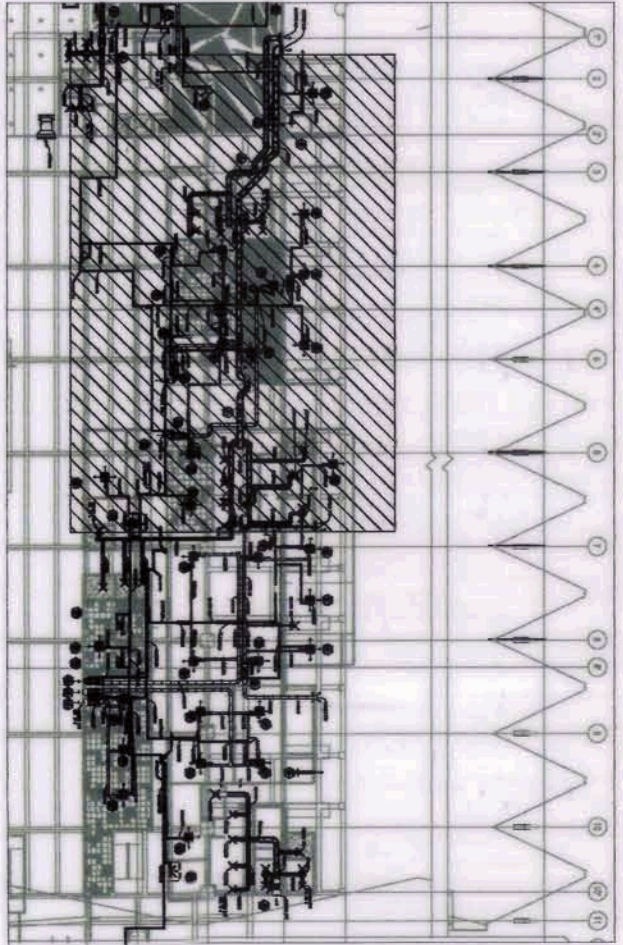


PARTIAL-B  
LOWER GROUND FLOOR AC & VENTILATION LAYOUT

1  
M2-02B  
SCALE:


1:100

GRAPHIC SCALE:

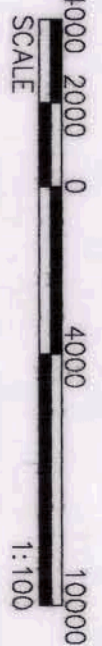

Note:  
Pursuant to Section 4 of Annex 'A' of the Revised Implementing Rules and Regulations of the National Building Code of the Philippines (PD 1096), the undersigned hereby certifies that the design and construction of the building shall conform to the provisions of the said Code and the Rules and Regulations thereunder. The undersigned also certifies that the design and construction of the building shall conform to the provisions of the said Code and the Rules and Regulations thereunder. The undersigned also certifies that the design and construction of the building shall conform to the provisions of the said Code and the Rules and Regulations thereunder.


OWNER: NGAC PHASE 1 JV COMPANY		PREPARED BY:		REVIEWED AND VALIDATED BY:		SUBMITTED BY:		CERTIFIED BY: INDEPENDENT CONSULTANT		PROJECT TITLE:		SHEET CONTENTS:		SHEET NO.	
 BUREAU OF CHIEF DEPARTMENT OF ANTI-CORRUPTION AND WENGENO B. PICON PRESIDENT		 Hilmarc's Construction Corporation 1835 E. Rodriguez St., Avenue Cebu, Cebu City JESUS V. HERBAS PROJECT MANAGER		 Architectural & Engineering Consultants Filipinas Dravo Corporation 1835 E. Rodriguez St., Avenue Cebu, Cebu City ALBERTO B. REYLLA PROJECT MANAGER		 BANDAR HEBAT BUILDERS, INC. ISAAC S. DAVIS PRESIDENT		 TCGI ENGINEERS 8th Fl. Plaza Bldg., 108 V.A. Rufino St., Legaspi Village, Metro City, 1229 Philippines • Tel. Nos. 8713311 to 15		AS-BUILT DRAWING NGAC PHASE 1A AQUATIC CENTER NEW CLARK CITY, CAPAS, TARLAC		PARTIAL-B LOWER GROUND FLOOR AC & VENTILATION LAYOUT		M2-02B	

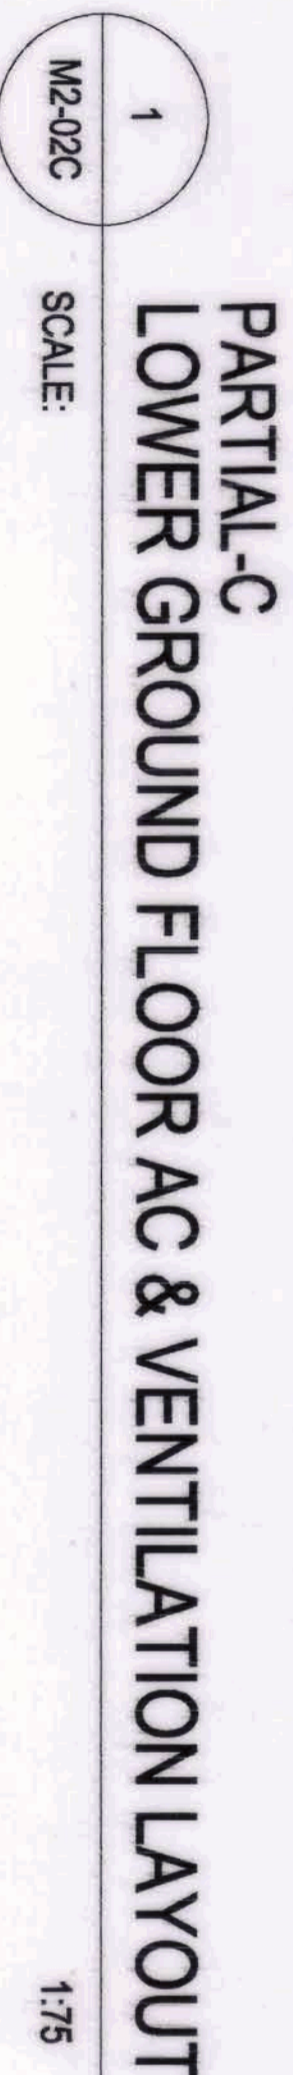

**Note:** Pursuant to Section 4 of Annex "A" of the Revised Implementing Rules and Regulations of R.A. 9164, approval of detailed engineering survey and design undertaken by Design Consultants neither diminishes the responsibility of the state for the technical integrity of the surveys and designs nor transfer any part of that responsibility to the appointing officials. The Design Consultant shall be held fully responsible for the failure of the facilities/structure due to faulty design except for the changes made without the conformity of the Design Consultants.

**GRAPHIC SCALE:**


OWNER: NGAC PHASE I JV COMPANY	PREPARED BY:	REVIEWED AND VALIDATED BY:	SUBMITTED BY:	CERTIFIED BY: INDEPENDENT CONSULTANT	PROJECT TITLE:	SHEET CONTENTS:	SHEET NO.
 <b>BCDA</b> BAYAN LEPONAT CANTONMENT DEVELOPMENT AUTHORITY 11000 BAYAN LEPONAT, CANTONMENT CAVITE PRESIDENT:  <b>WENCESLAO B. IBARRA</b> PRESIDENT	AND  <b>Hilmarc's Construction Corporation</b> 1488 E. Rodriguez St., Avenue Cebu, Davao City PRESIDENT:  <b>JESUS V. HERBAS</b> PRESIDENT PROJECT MANAGER:  <b>ALFREDO R. ARELLA</b>	 <b>FILIPINAS DRAVO CORPORATION</b> Architectural & Engineering Consultants 11000 BAYAN LEPONAT, CANTONMENT CAVITE PRESIDENT:  <b>ALFREDO R. ARELLA</b>	 <b>BANDAR HEBAT BUILDERS, INC.</b> PRESIDENT:  <b>ISAAC S. DAVID</b> PRESIDENT	 <b>TCGI ENGINEERS</b> 11000 BAYAN LEPONAT, CANTONMENT CAVITE PRESIDENT:  <b>VIROGLIO A. AMOROSO</b> PRESIDENT	<b>AS-BUILT DRAWING</b> NGAC PHASE 1A <b>AQUATIC CENTER</b> NEW CLARK CITY, CAPAS, TARLAC	PARTIAL - C LOWER GROUND FLOOR AC & VENTILATION LAYOUT	<b>M2-02C</b>

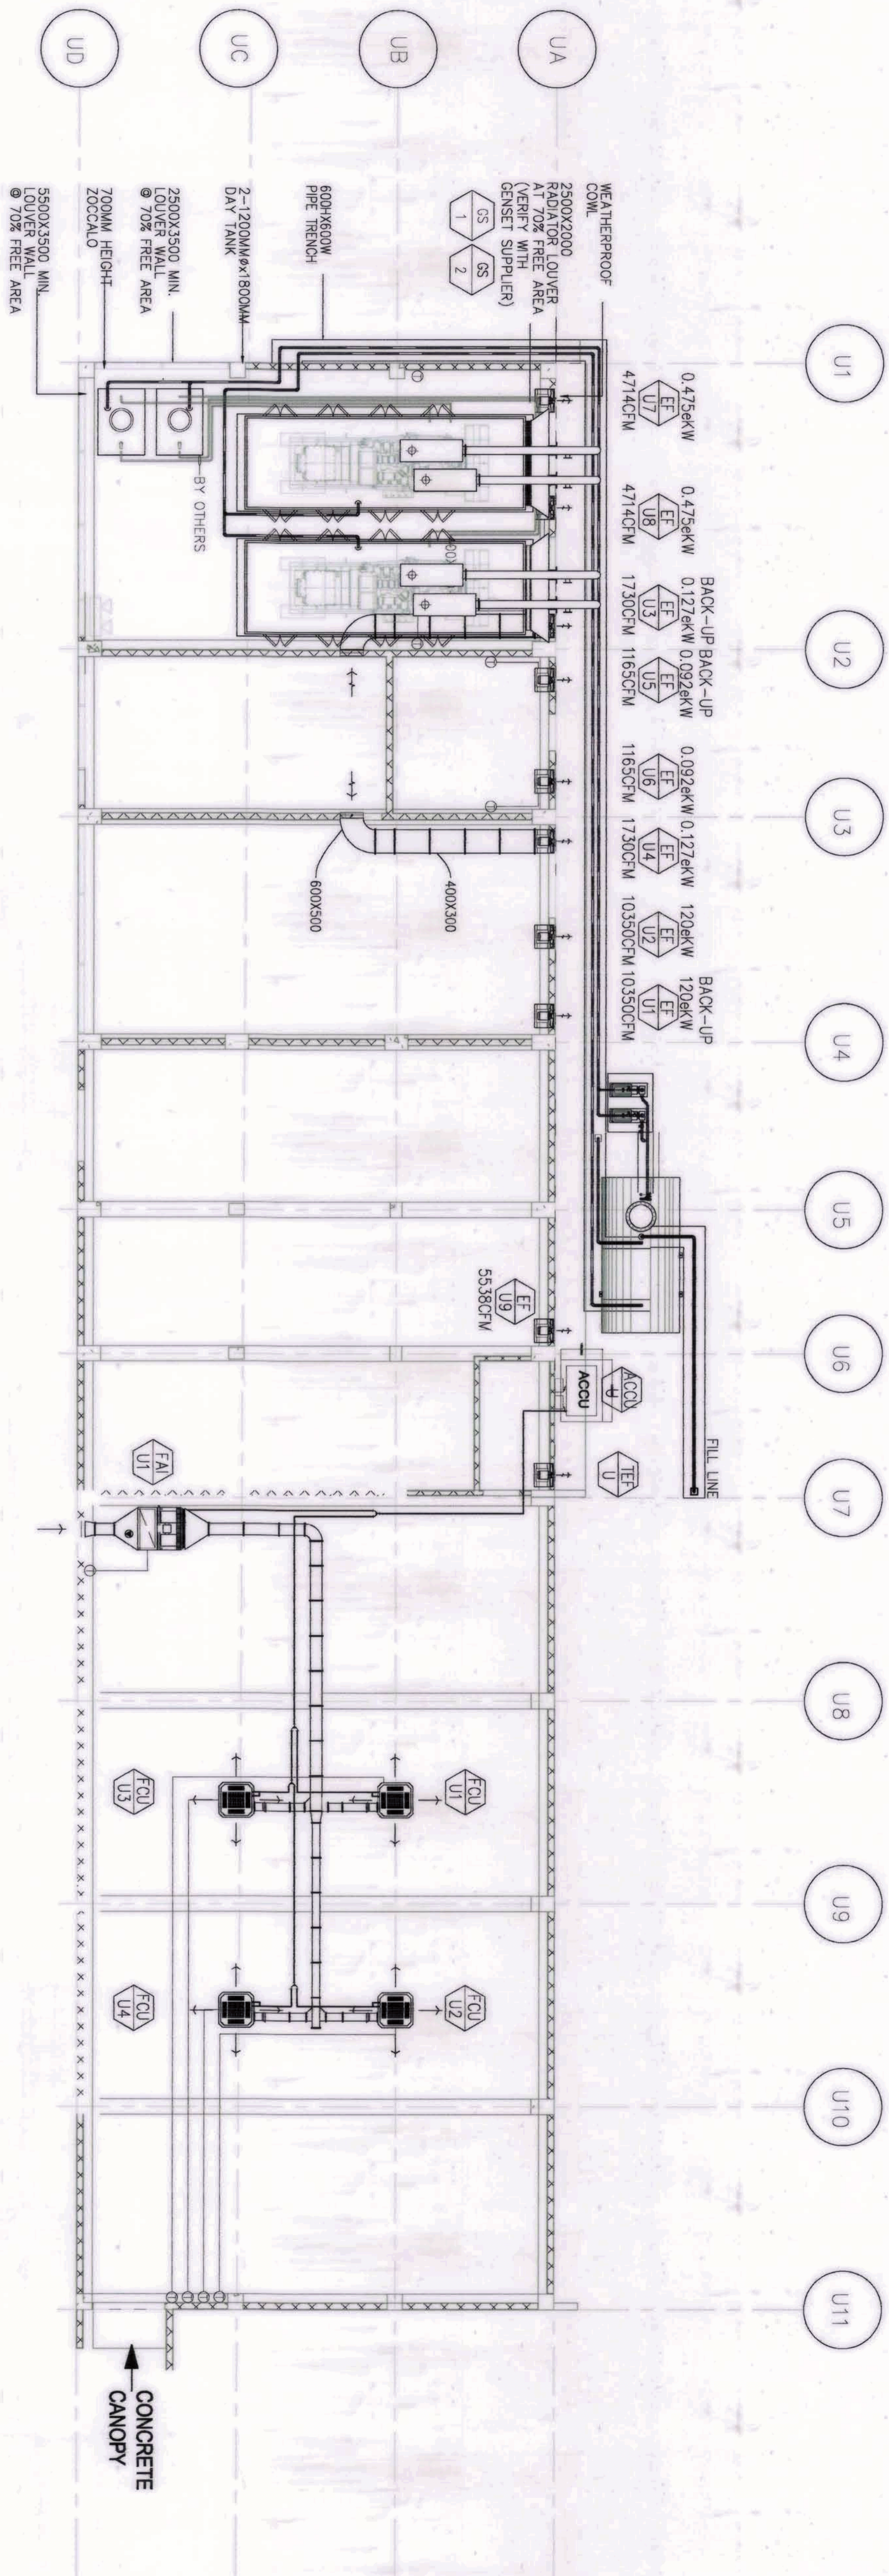

**PARTIAL D**  
**UTILITY BUILDING AC & VENTILATION LAYOUT**  
1  
M2-02D  
SCALE: 1:100


Note:  
Pursuant to Section 4 of Annex 'A' of the Revised Implementing Rules and Regulations of the Philippine Mechanical Engineering Law (RA 6262), the undersigned, being duly  
Qualified, approved, and licensed by the Board of Mechanical Engineering, hereby  
Certifies that the design and construction of the building and its mechanical system  
of the surveys and designs are true and correct and that the undersigned is not  
The Design Consultant shall be held fully responsible for the failure of the structures due  
to faulty design except for the changes made without the conformity of the Design Consultants.

GRAPHIC SCALE:

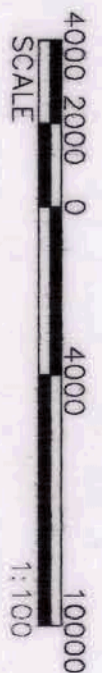


OWNER: NGAC PHASE 1 JV COMPANY		PREPARED BY:		REVIEWED AND VALIDATED BY:		SUBMITTED BY:		CERTIFIED BY: INDEPENDENT CONSULTANT		PROJECT TITLE:		SHEET CONTENTS:		SHEET NO.	
<div>BCDA BAYAN CEBU DEVELOPMENT AUTHORITY AND MTD Group, Inc. PRESIDENT PATRICK NICHOLAS T. DAVID</div>		<div>Hilmarc's Construction Corporation 1835 E. Rodriguez St., Avenue Cebu, Quezon City PROJECT MANAGER JESUS V. HERBAS</div>		<div>FILIPINAS DRAVO CORPORATION Architectural &amp; Engineering Consultants 1000 N. 10th St., Suite 100, Cebu City PROJECT MANAGER ALFREDO B. REYLLA</div>		<div>BANDAR HEBAT BUILDERS, INC. PRESIDENT ISAAC S. DAVID</div>		<div>TCGI ENGINEERS 1000 N. 10th St., Suite 100, Cebu City PRESIDENT/CEO VIRGILIO A. MADRADO</div>		AS-BUILT DRAWING NGAC PHASE 1A		PARTIAL D-UTILITY BUILDING AC & VENTILATION LAYOUT		M2-02D	
										AQUATIC CENTER NEW CLARK CITY, CAPAS, TARLAC					



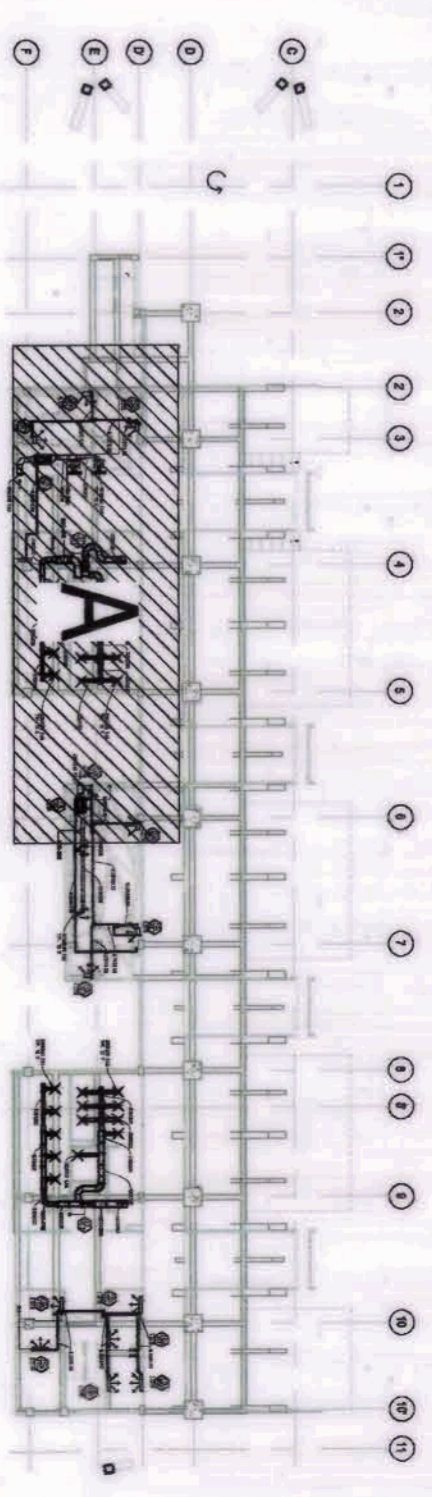

## KEY PLAN

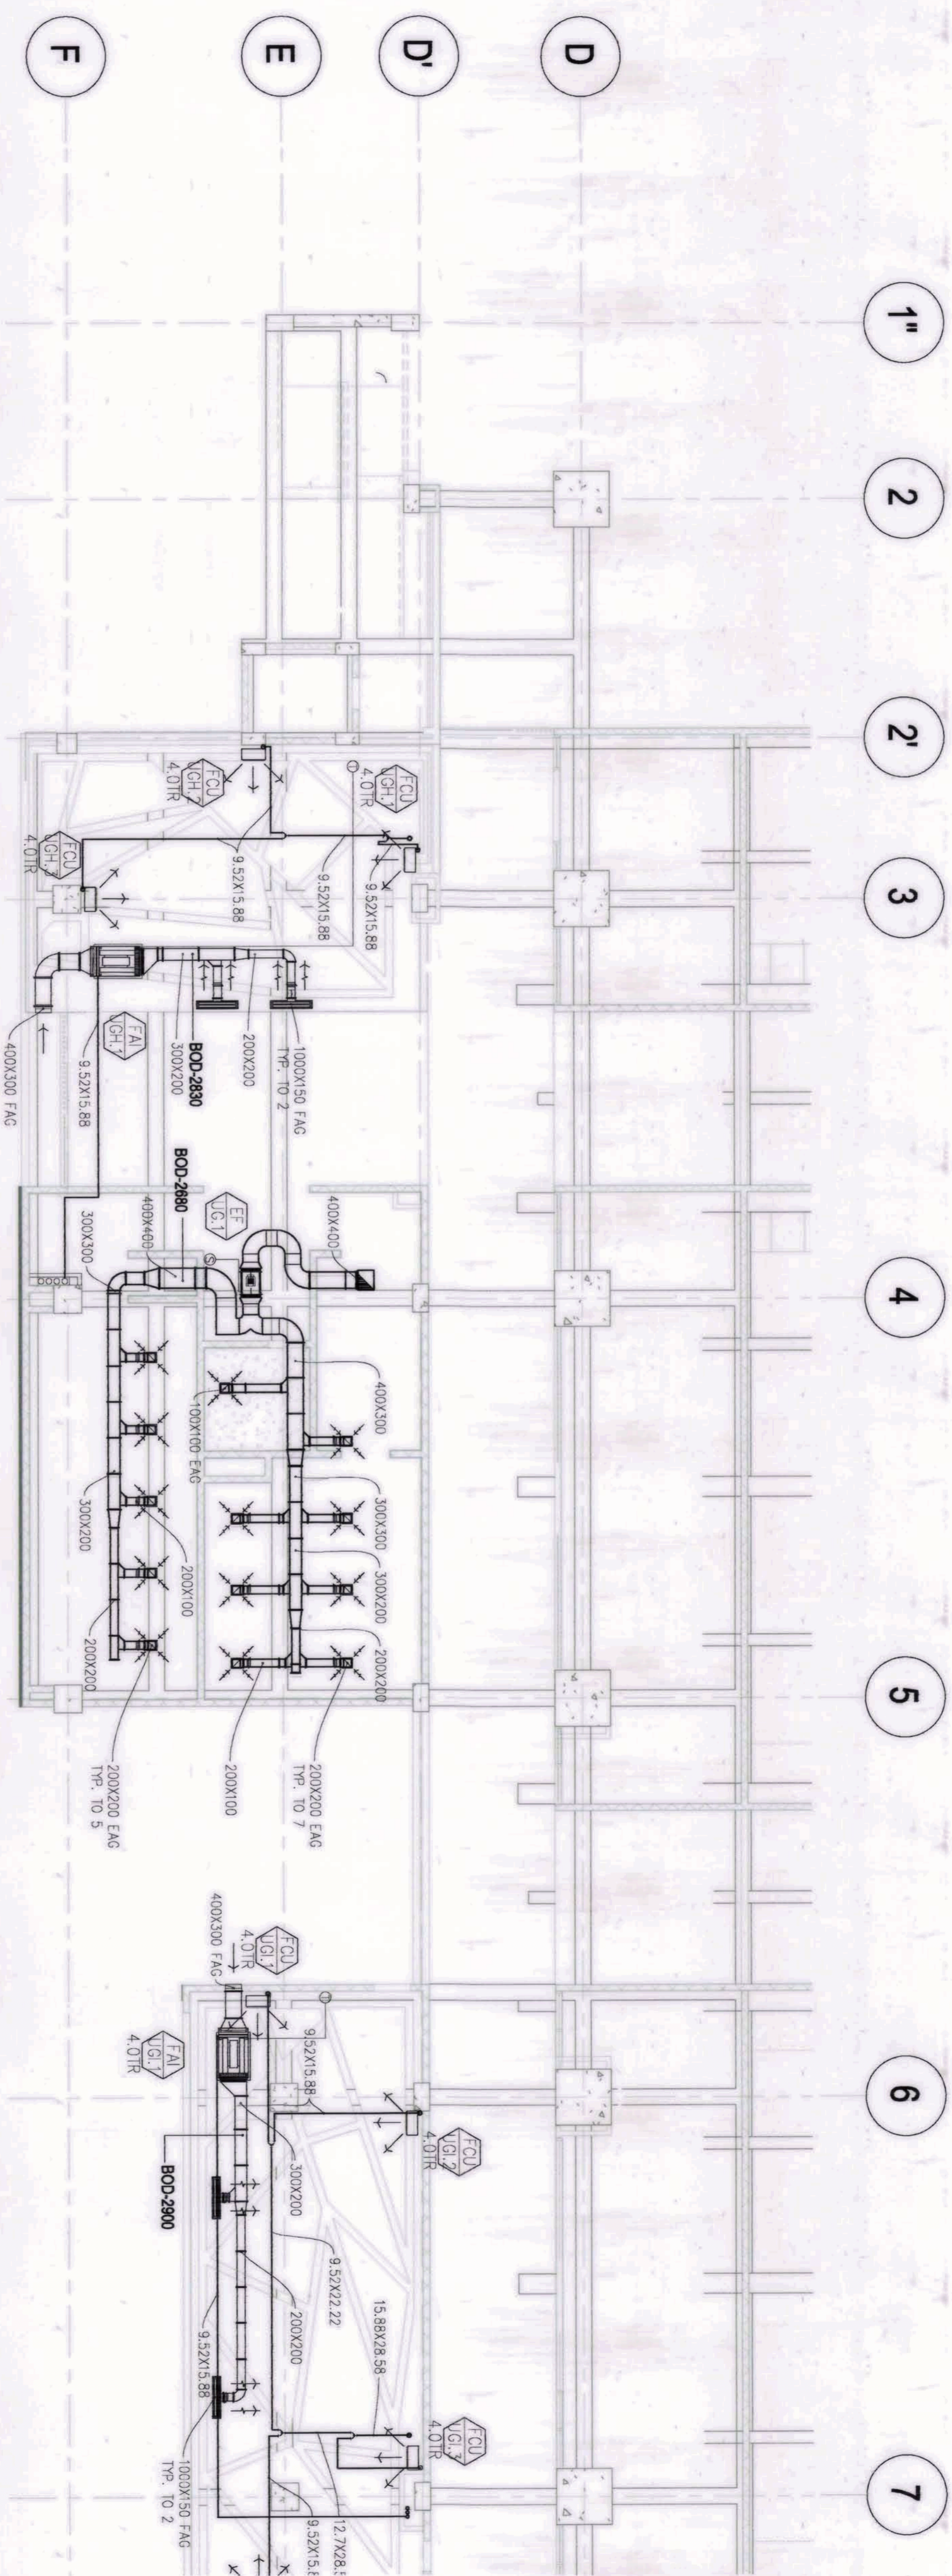


## PARTIAL-A UPPER GROUND FLOOR AC & VENTILATION LAYOUT

1  
M2-03A

1:100

**GRAPHIC SCALE:**

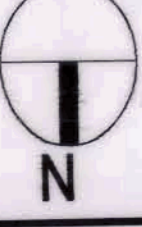


OWNER: NGAC PHASE I JV COMPANY	PREPARED BY:	REVIEWED AND VALIDATED BY:	SUBMITTED BY:	CERTIFIED BY: INDEPENDENT CONSULTANT	PROJECT TITLE:	SHEET CONTENTS:	SHEET NO.
 <b>BCDA</b> Bay City Development Authority 1000 E. Michigan Ave., Suite 1000 Detroit, MI 48202 (313) 224-1000 www.bcitydetroit.com	 <b>Hilmar's Construction Corporation</b> 1635 E. Michigan St., Avenue, Oakland, Oakland, CA (510) 438-1000 www.hilmars.com	 <b>FILIPINAS DRAVO CORPORATION</b> Architectural & Engineering Consultants 1700 E. Michigan St., Suite 1000, Detroit, MI 48202 (313) 224-1000 www.filipinasdravo.com	 <b>BANDAR HEBAT BUILDERS, INC.</b> 1000 E. Michigan St., Suite 1000, Detroit, MI 48202 (313) 224-1000 www.bandarhebat.com	 <b>TCGI ENGINEERS</b> 1000 E. Michigan St., Suite 1000, Detroit, MI 48202 (313) 224-1000 www.tcgiengineers.com	<b>AS-BUILT DRAWING</b> NGAC PHASE 1A <b>AQUATIC CENTER</b> NEW CLARK CITY, CAPAS, TARIAC	PARTIAL - A UPPER GROUND FLOOR AC & VENTILATION LAYOUT	<b>M2-03A</b>








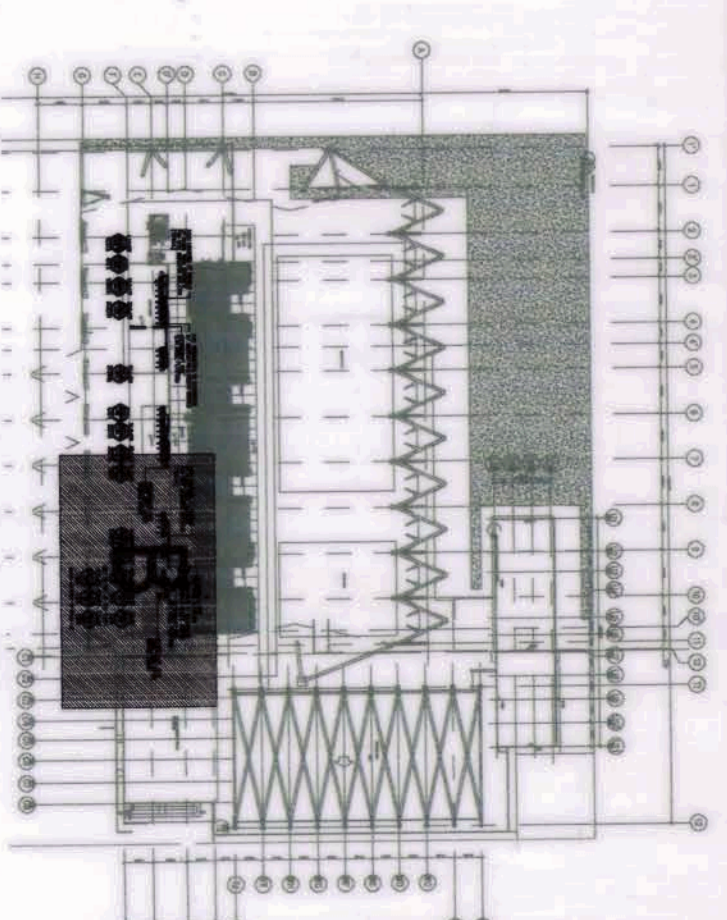


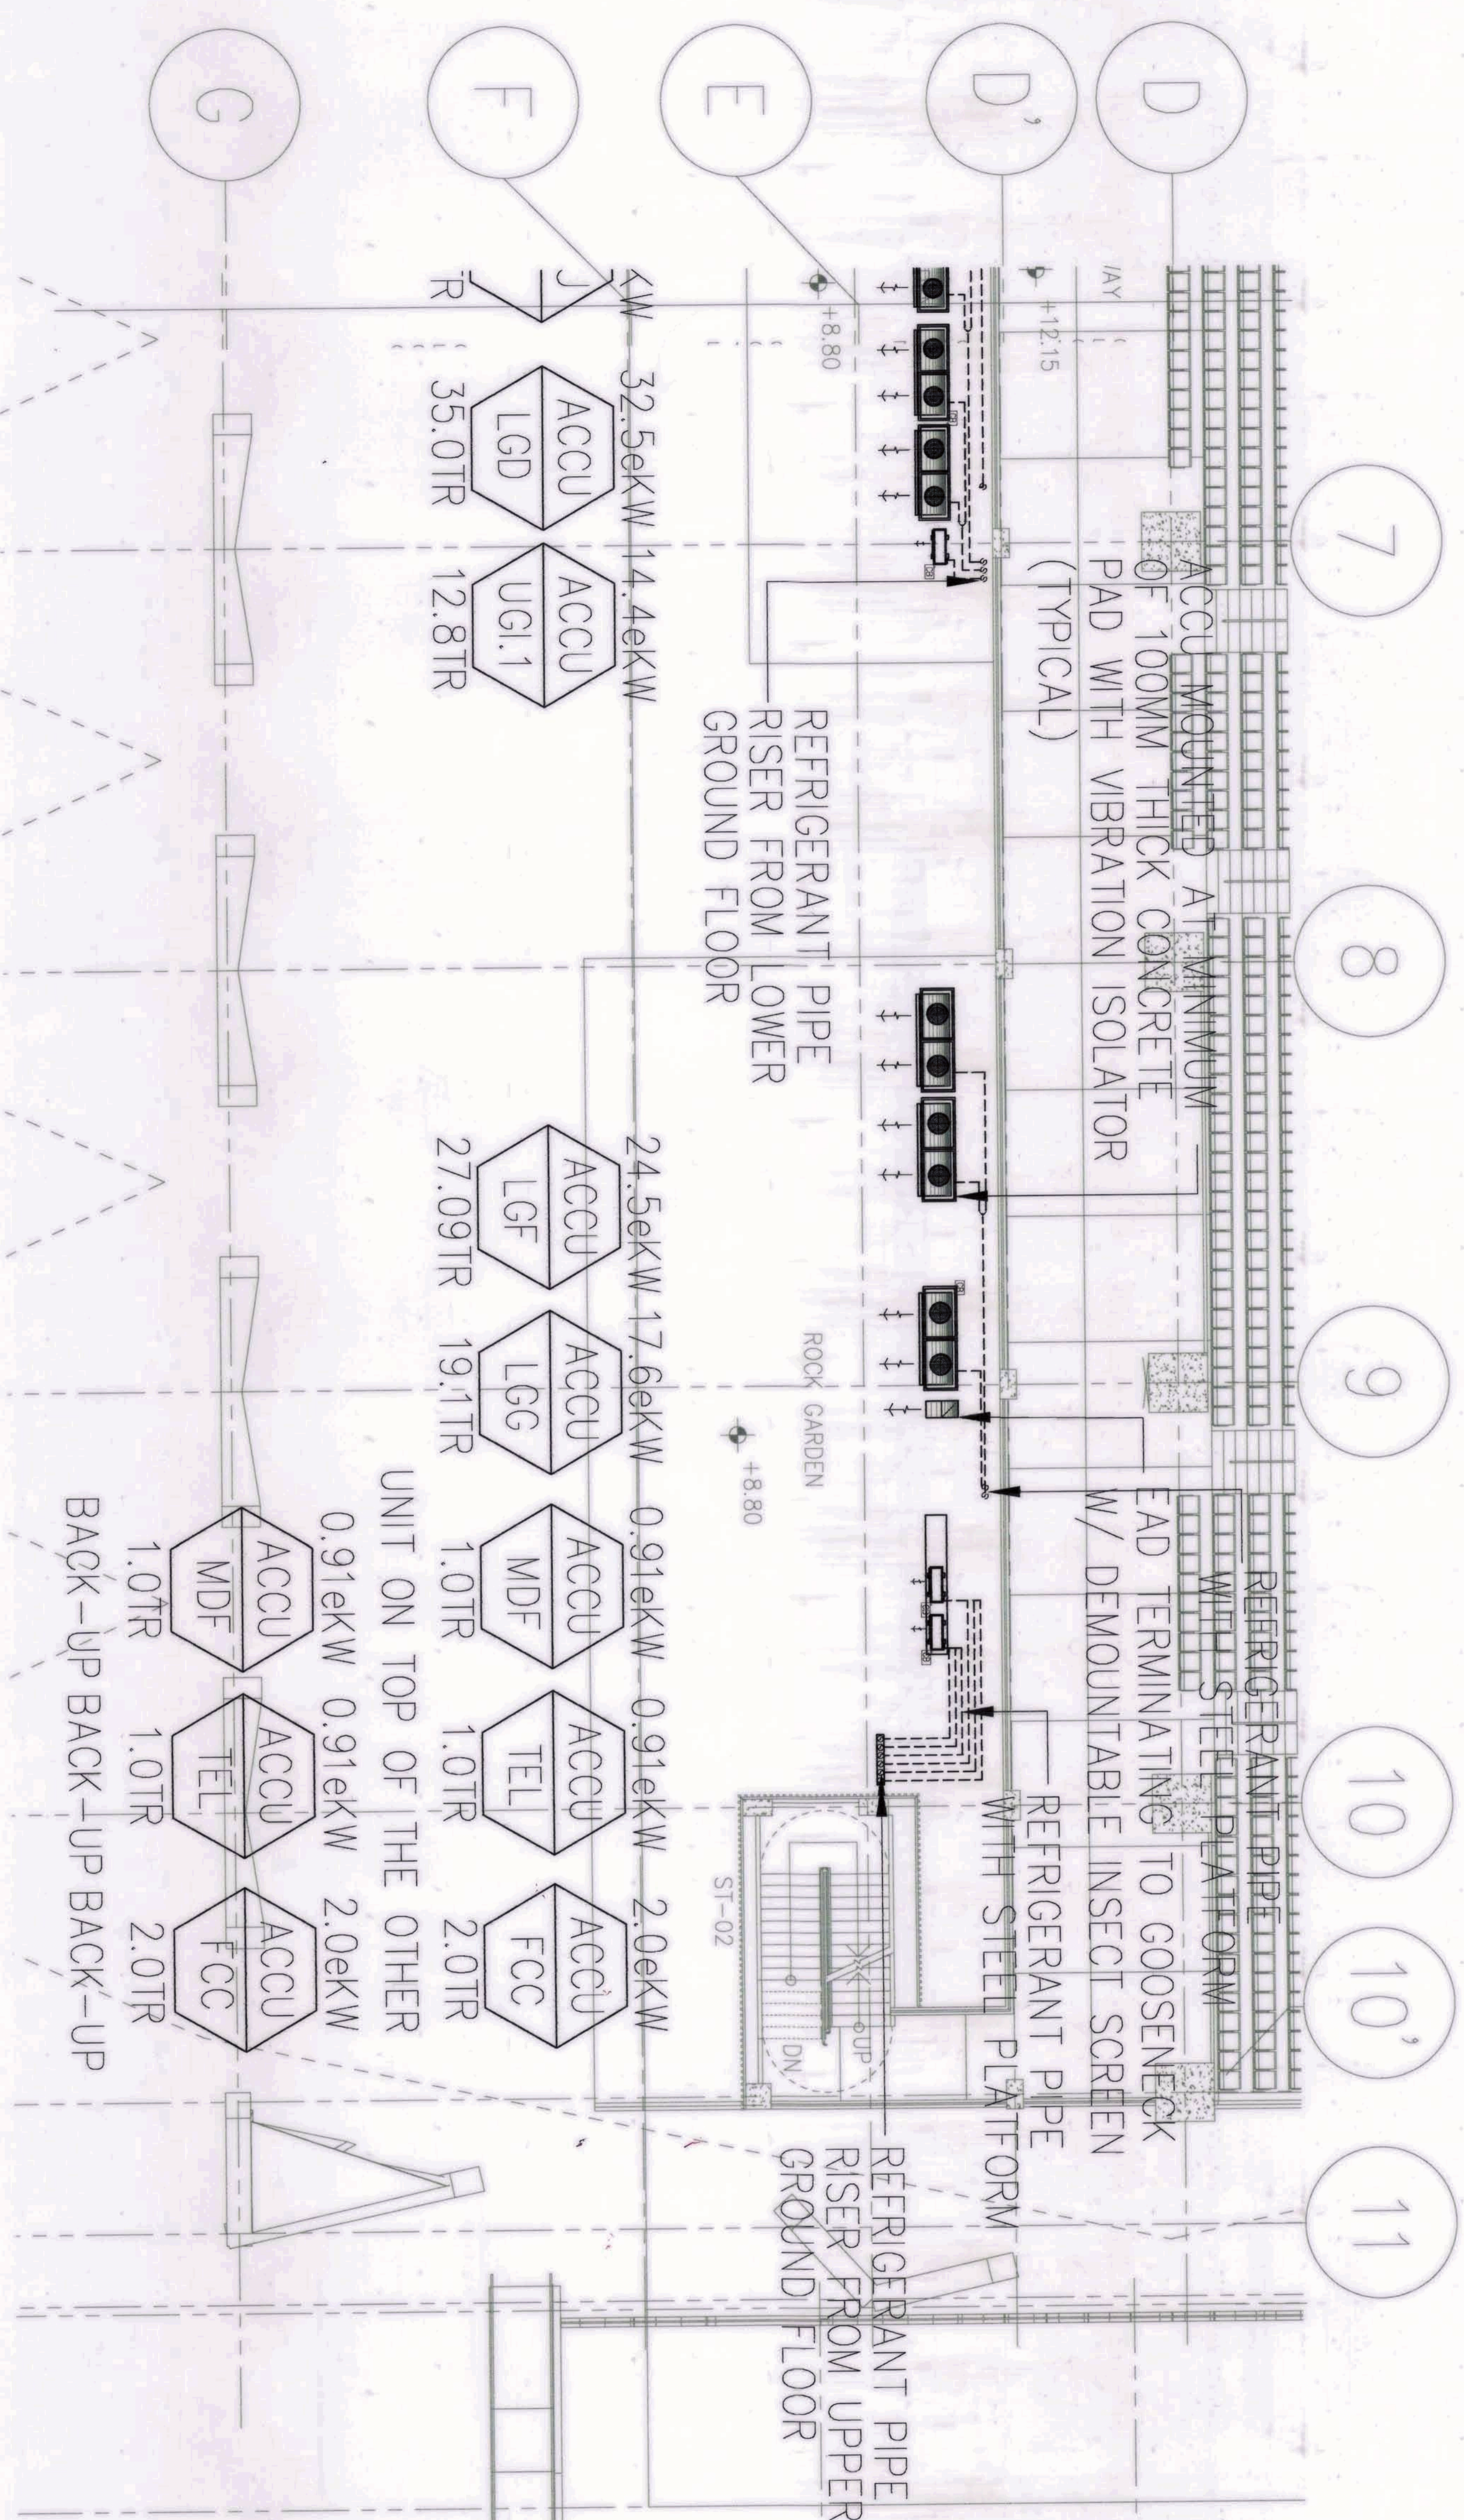



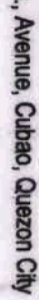




## KEY PLAN

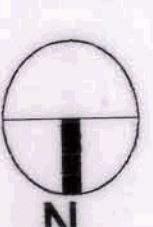

**Pursuant to Section 4 of Annex "A" of the Revised Implementing Rules and Regulations of RA 8196, approval of detailed engineering survey and design undertaken by Design Consultants neither distributes the responsibility of the latter for the technical integrity of the surveys and designs nor transfer any part of that responsibility to the approving officials. The Design Consultant shall be held fully responsible for the failure of the infrastructure due to faulty design except for the changes made without the conformity of the Design Consultants.**

**GRAPHIC SCALE:**

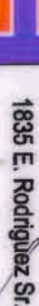

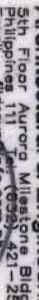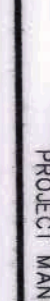OWNER: NGAC PHASE 1 JV COMPANY	PREPARED BY:	REVIEWED AND VALIDATED BY:	SUBMITTED BY:	CERTIFIED BY: INDEPENDENT CONSULTANT	PROJECT TITLE:	SHEET CONTENTS:	SHEET
<div> The Office of the President Bureau of Construction Development and Administration  <b>WENCESLAO B. BUJON</b> PRESIDENT</div> <div>AND   <b>PATRICK NICHOLAS P. DAVID</b> PRESIDENT</div>	<div> <b>Hilmar's Construction Corporation</b> 1635 E. Rodriguez St., Avenue, Cebu, Quezon City  <b>JESUS V. HERNANDEZ</b> PROJECT MANAGER</div>	<div> <b>FILIPINAS DRAVO CORPORATION</b> Architectural &amp; Engineering Consultants 11700 E. Rodriguez St., Avenue, Cebu, Quezon City Branch Office: 1635 E. Rodriguez St., Avenue, Cebu, Quezon City  <b>ALEXANDER R. PROFILA</b> PROJECT MANAGER</div>	<div> <b>BANDAR HEBAT BUILDERS, INC.</b>  <b>ISAAC S. DAVID</b> PRESIDENT</div>	<div> <b>TCGI ENGINEERS</b> 8th Flr. Katun Bldg., 106 V.A. Rufino St., Legaspi Branch Marikina City, 1702 Philippines • Tel. No. 078101 to 16  <b>VIRGILIO A. MADRID</b> PRESIDENT/CEO</div>	<div>AS-BUILT DRAWING NGAC PHASE 1A <b>AQUATIC CENTER</b> NEW CLARK CITY, CAGAYAN, TARLAC</div>	<div>PARTIAL B-UPPER BLEACHER AC &amp; VENTILATION LAYOUT <b>M2-041</b></div>	













LIFT SPECIFICATION & DATA	
STANDARD	JOHMORE-6
ELEVATOR TYPE	800kg (10 Persons)
RATED LOAD/PERSON	1.0 m/s
SPEED	2-1
NO. OF FLS/STOP/LANDING	5/4/4
NO. OF CAR ENTRANCE (S)	1
CAR INTERNAL WIDTH	1200
CAR INTERNAL DEPTH	1350
CAR INTERNAL HEIGHT	2420
LIFT ENTRANCE WIDTH	2100
DOOR OPERATION	2 PANELS CENTRAL OPENING
CONTROL SYSTEM	CTRL 70A
OPERATION	SHR/EX
DIAMETER OF MAIN SHEAVE	Φ400
D.A. OF DEFLECTOR SHEAVE	Φ400/Φ350/Φ320
MAIN ROPE	8 x 8 x 6
TYPE OF GOVERNOR	X52015-13
TYPE OF COUNTERWEIGHT RAIL	175X57B
TYPE OF CAR BUFFER	H7580B
TYPE OF C/W BUFFER	H7580B
BUFFER STROKE	80
CAR WEIGHT	920 KG
MAX WT ALLOWANCE (FINISHES)	200 KG
COUNTERWEIGHT WT.	1350 KG
COINTEGRATED SIZE	600 X 500 X 280
WT OF TRACTION MACHINE	350 KG
FINISHES, DECORATION & CONTROLS	
CABIN WALL FINISH	
CAR DOOR FINISH	
LANDING DOOR FINISH	
LANDING WALL FINISH	
FLOORING	
HOP	
COP	
ELECTRICAL REQUIREMENTS	
MAIN SUPPLY	3 PHASE 400V 60HZ
AUXILIARY SUPPLY	SINGLE PHASE 220V 60HZ
RATED CURRENT	12.0 A
STARTING CURRENT	18.0 A
MOTOR OUTPUT POWER	5.3 kW
MAXIMUM START HOUR	240
OPTIONAL DEVICES	
ARD	
REGENERATIVE SYSTEM	
ANNOUNCIATOR	
REACTIONS	
R1	HITCH BEAM SUPPORT FRONT SIDE
R2	HITCH BEAM SUPPORT REAR SIDE
R3	TRACTION MOTOR LOWER BRACKET
R4	CAR BUFFER PLINTH
R5	COUNTERWT BUFFER PLINTH
R6	
R7	
R8	
R9	
R10	

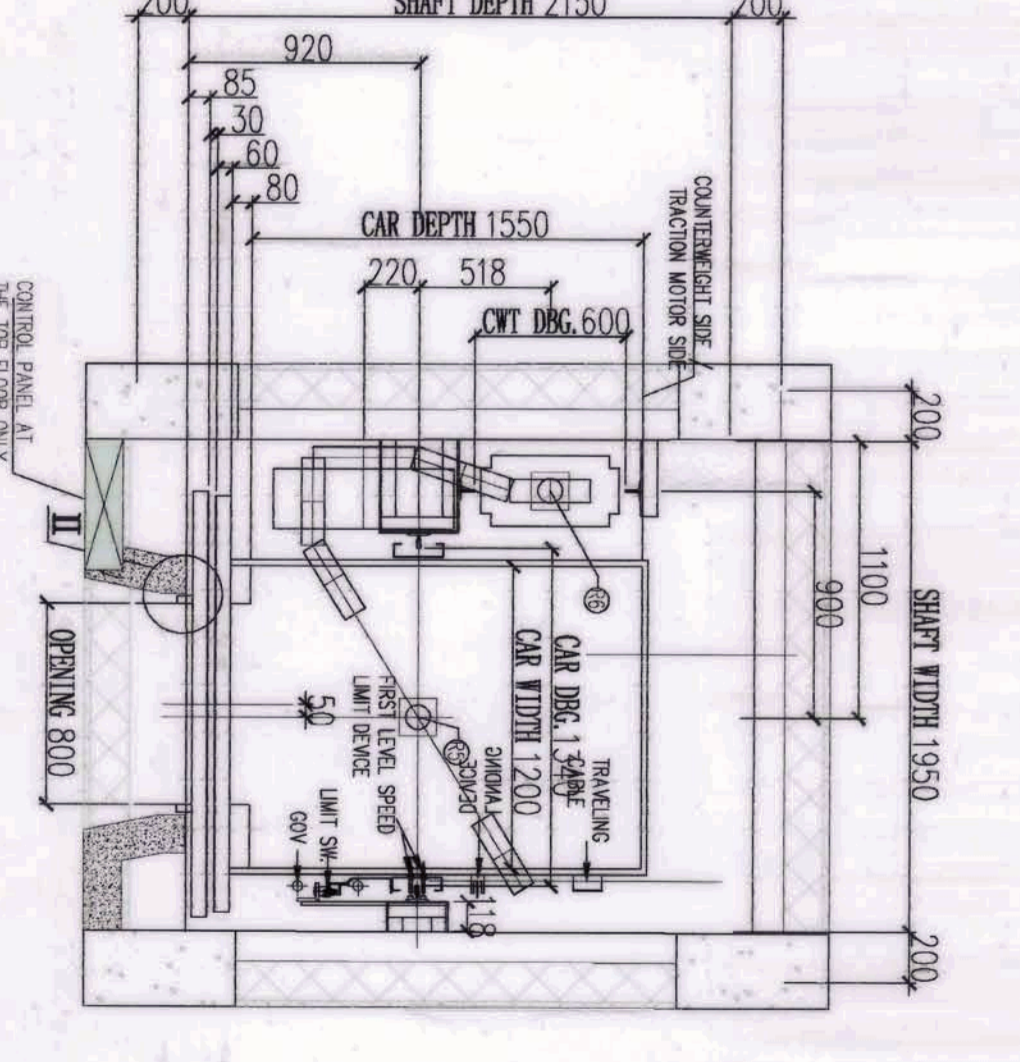
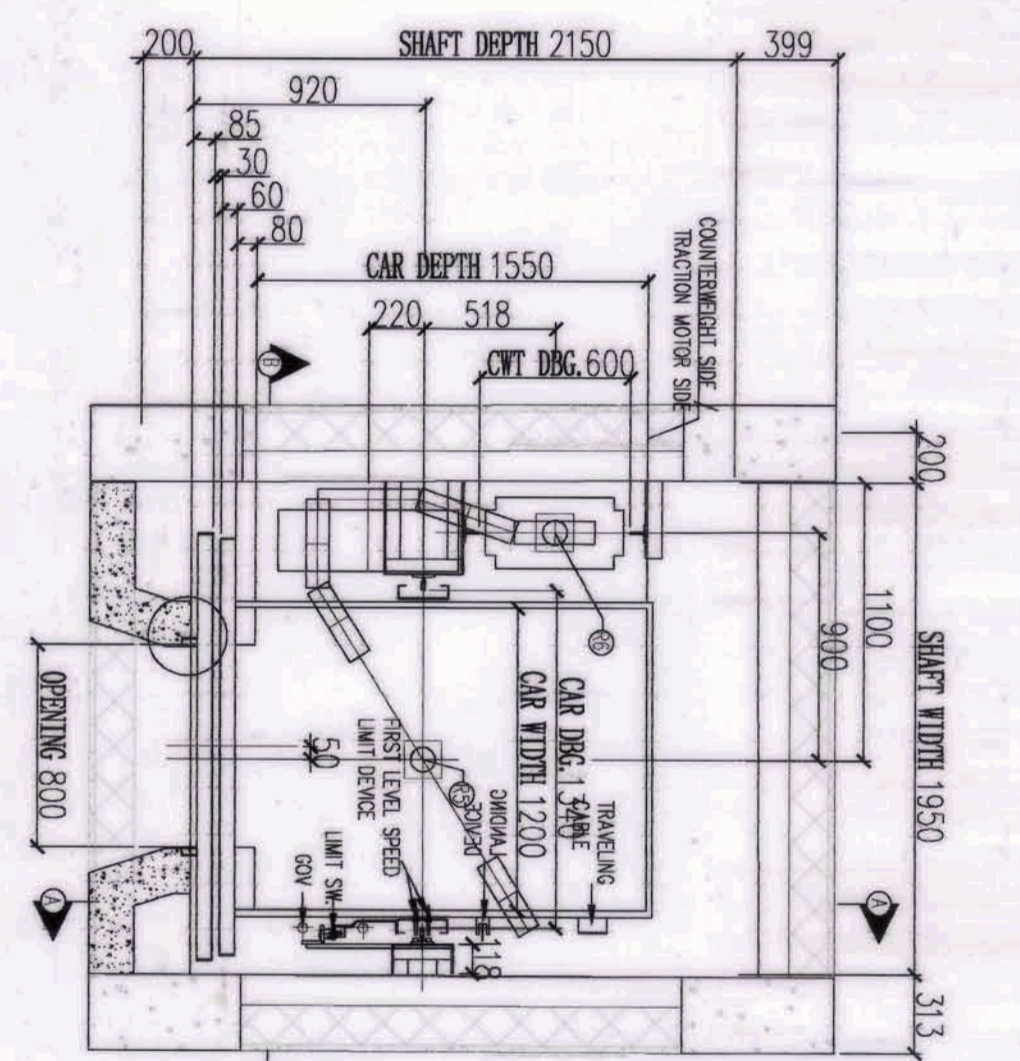
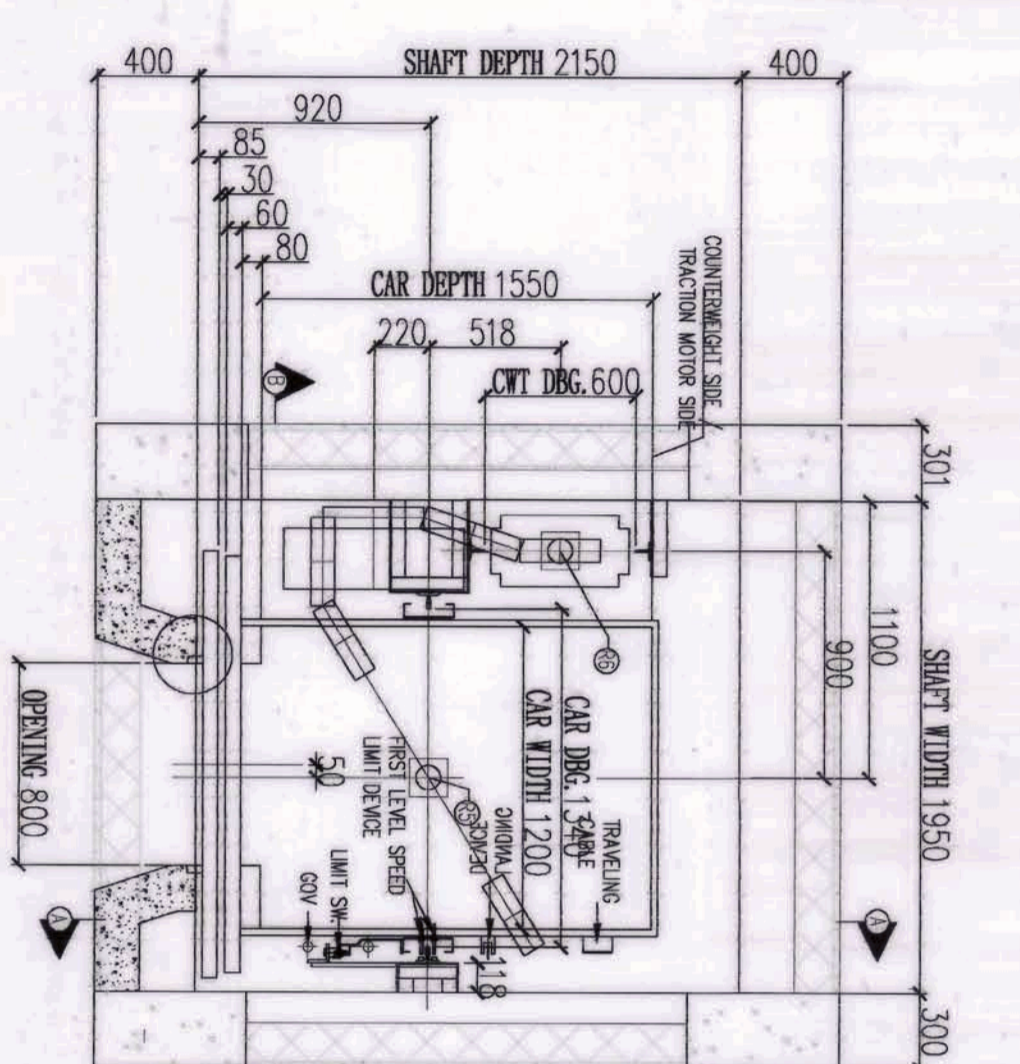
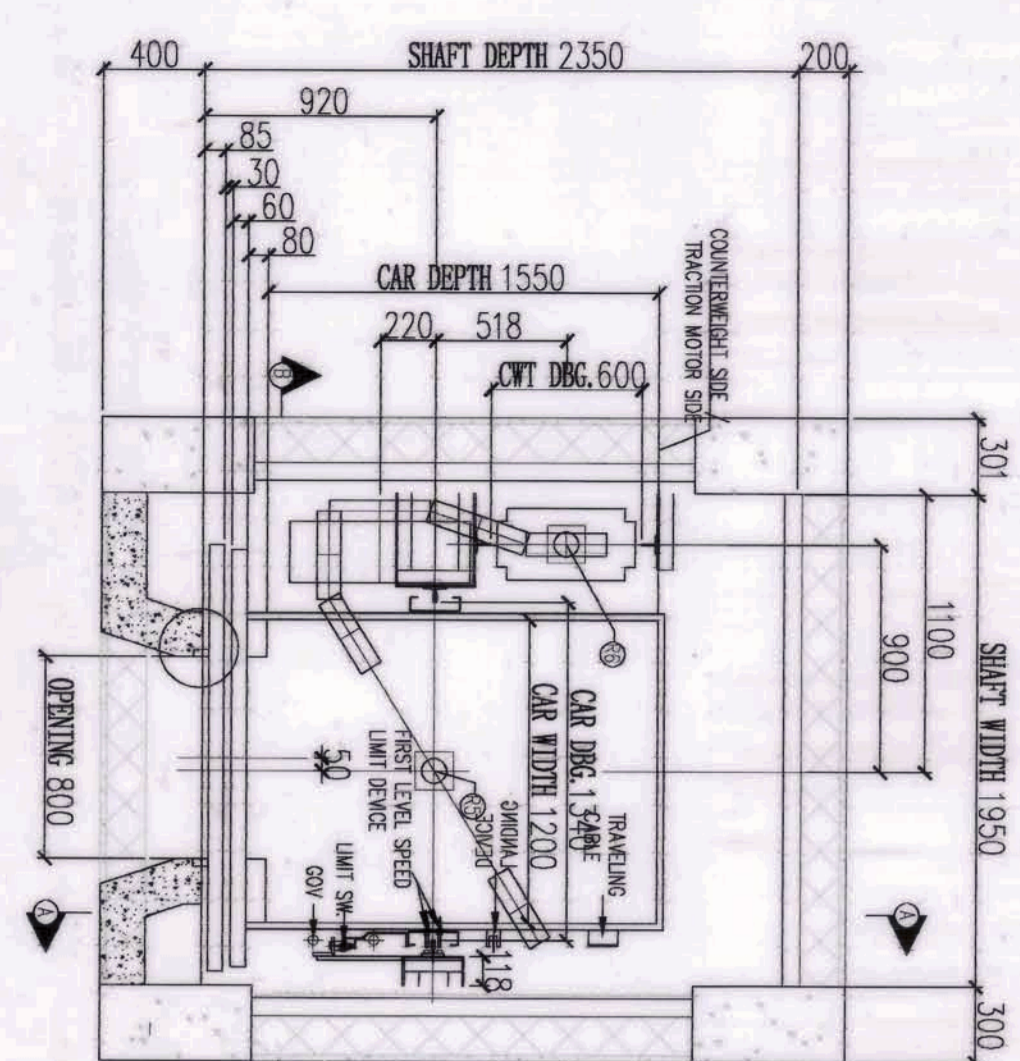


SHAFT PLAN  
A @ LOWER GROUND FLOOR  
MS-01 SCALE: 1:30M

SHAFT PLAN  
B @ UPPER GROUND FLOOR  
MS-01 SCALE: 1:30M

SHAFT PLAN  
C @ UPPER BLEACHER FLOOR  
MS-01 SCALE: 1:30M

SHAFT PLAN  
D @ PRESIDENTIAL SUITE FLOOR  
MS-01 SCALE: 1:30M

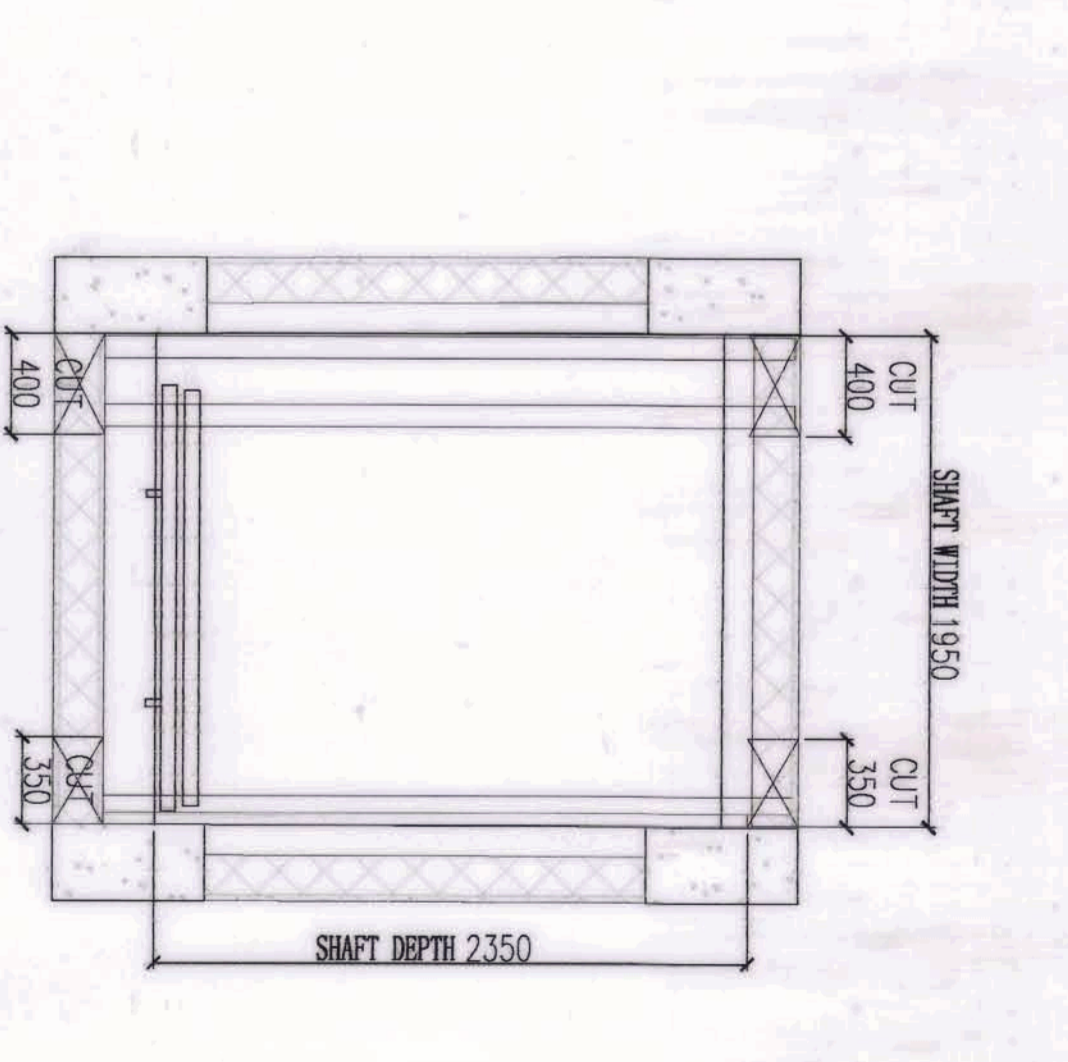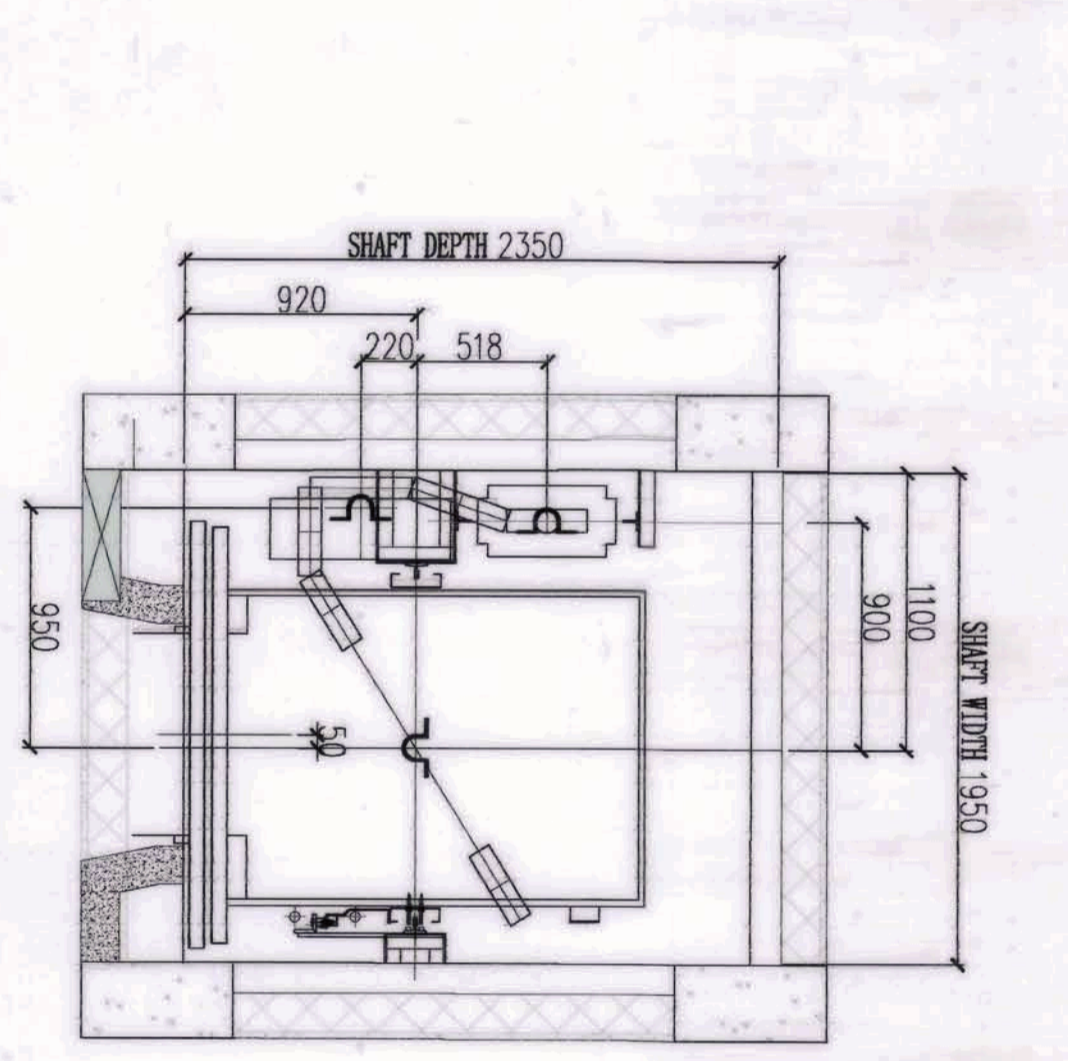
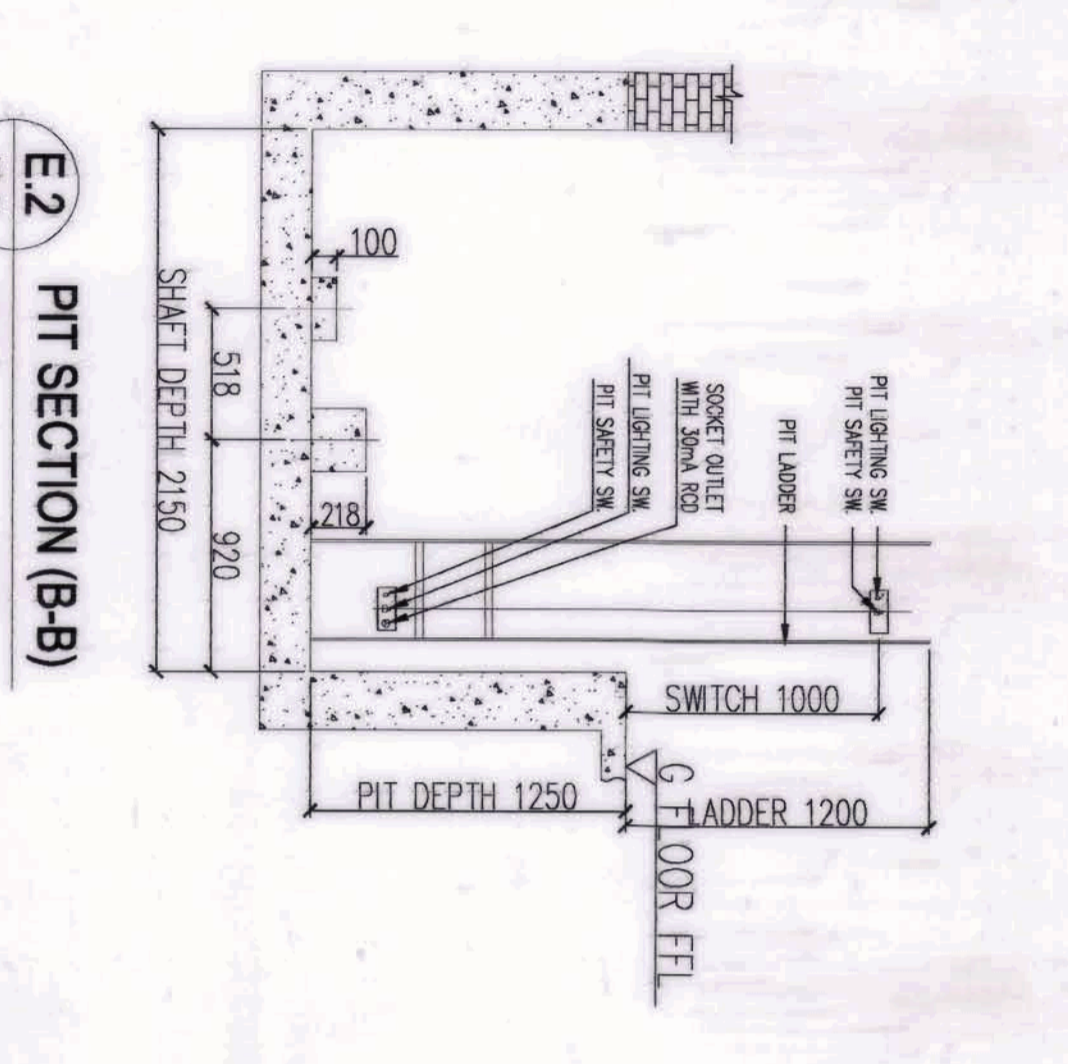
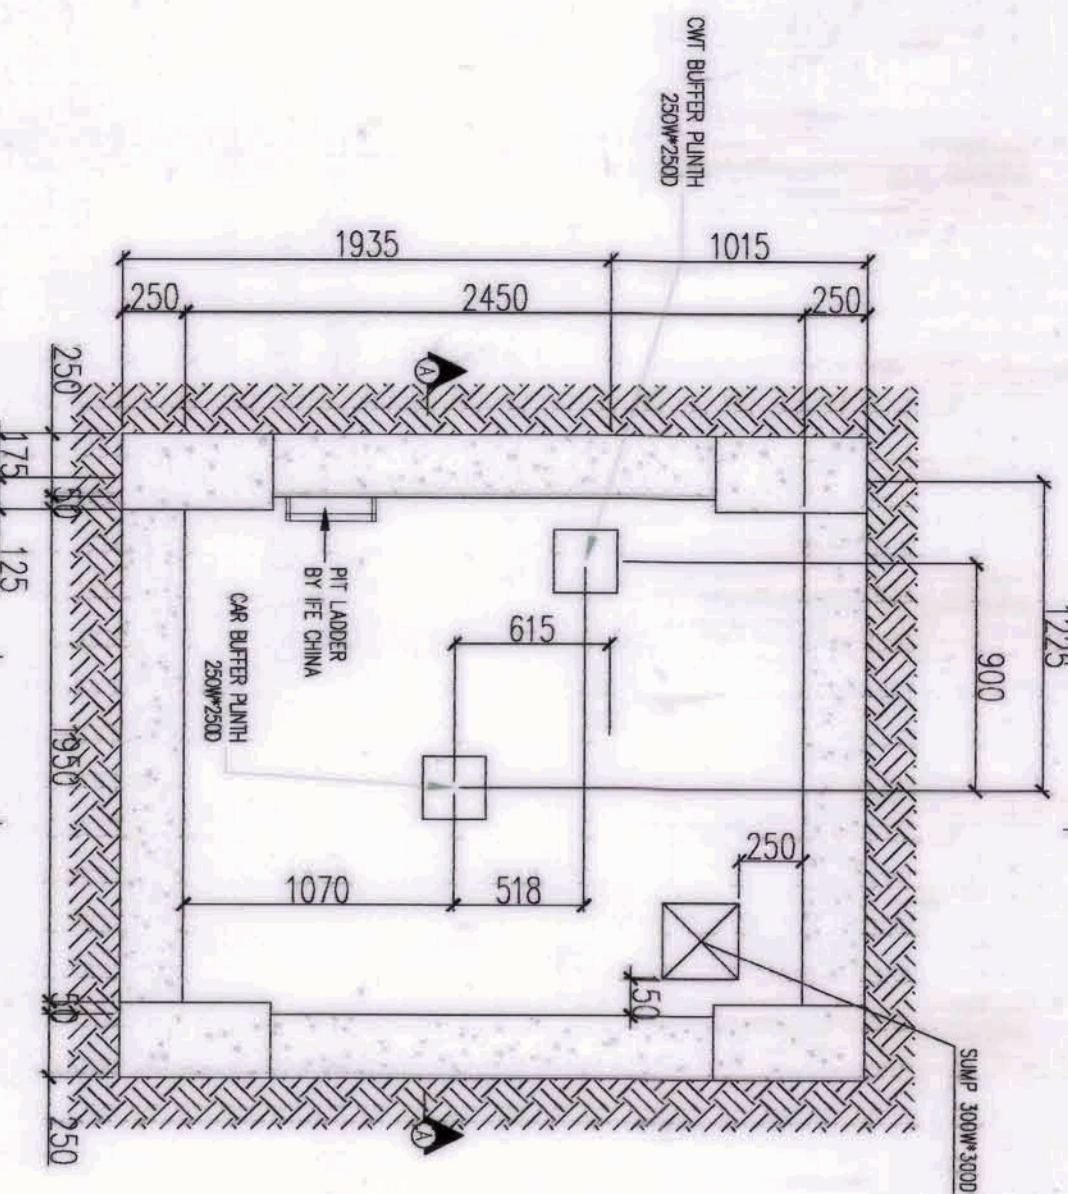


PIT PLAN  
E  
MS-01 SCALE: 1:30M

PIT SECTION (B-B)  
E.2  
MS-01 SCALE: 1:30M

HOOK PLAN  
F  
MS-01 SCALE: 1:30M

HITCH BEAM AT  
OVERHEAD  
G  
MS-01 SCALE: 1:30M

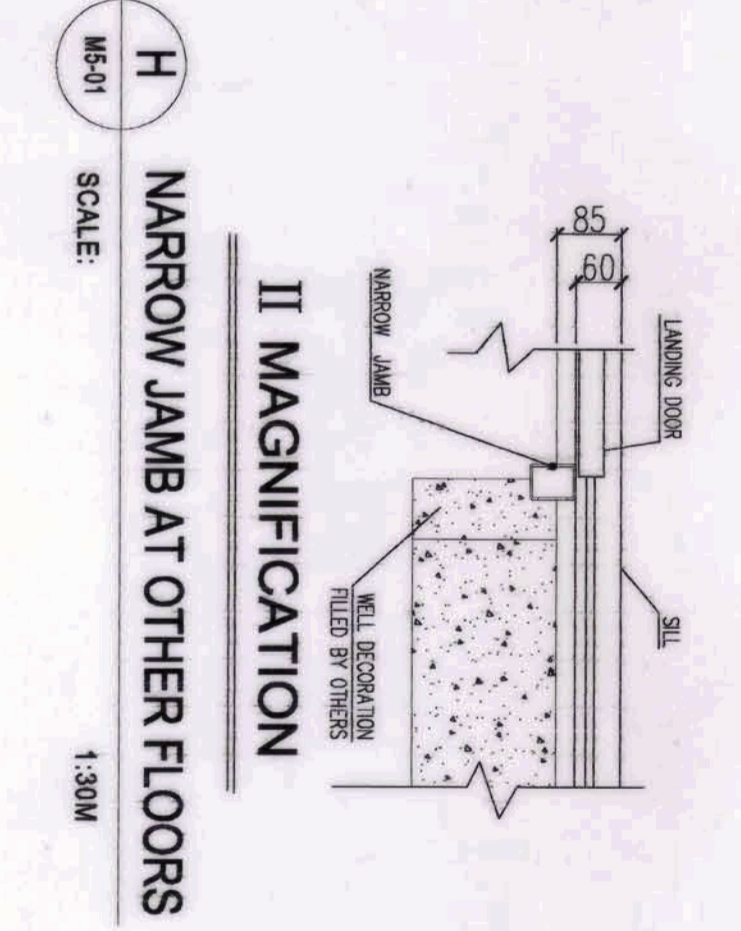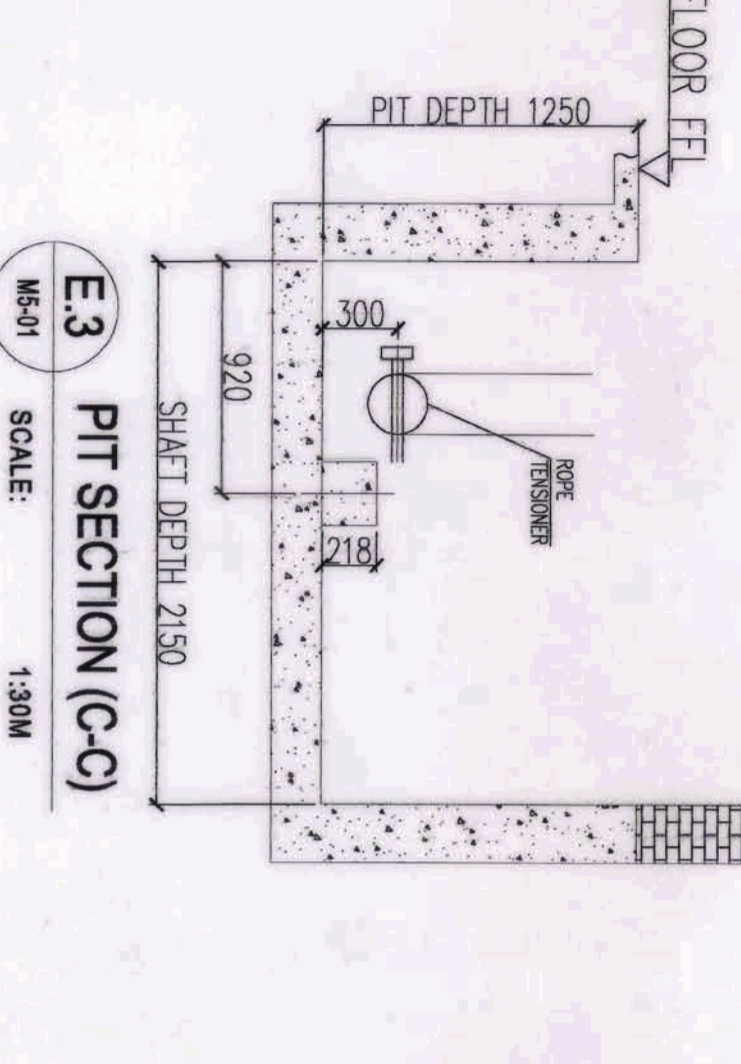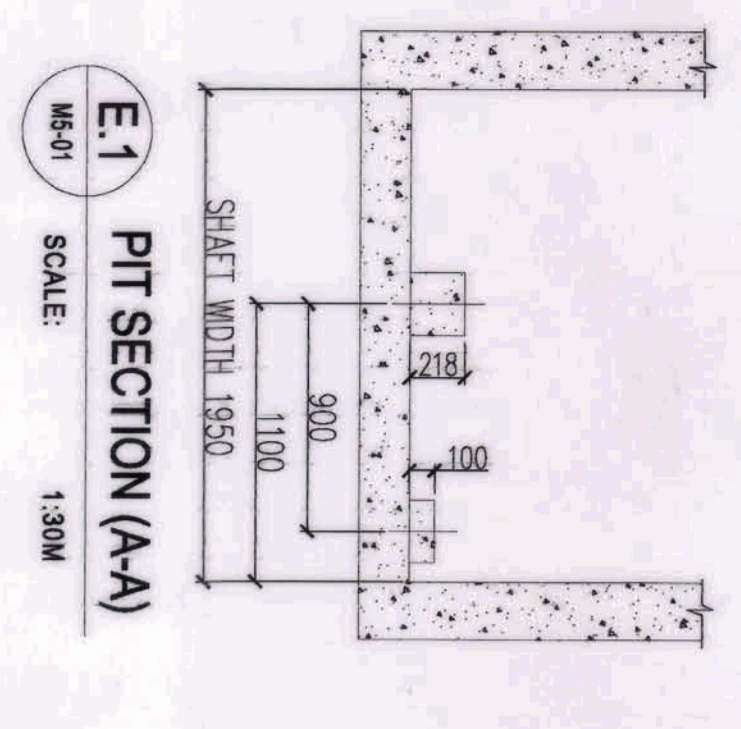

PIT SECTION (A-A)  
E.1  
MS-01 SCALE: 1:30M


PIT SECTION (C-C)  
E.3  
MS-01 SCALE: 1:30M

NARROW JAMB AT OTHER FLOORS  
H  
MS-01 SCALE: 1:30M

## ELEVATOR PLAN AND SECTION

1

SCALE: 1:30M

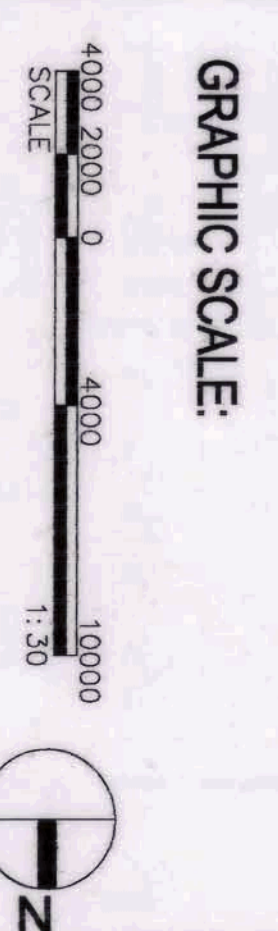

Note:  
Pursuant to Section 4 of Annex 'A' of the Revised Implementing Rules and Regulations of RA 9164, approval of detailed engineering survey and design undertaken by Design Consultants neither diminishes the responsibility of the latter for the technical integrity of the survey and designs nor transfer any part of that responsibility to the approving officials. The Design Consultant shall be held fully responsible for the safety of the facilities/structures due to faulty design except for the changes made without the conformity of the Design Consultants.

OWNER: NGAC PHASE I JV COMPANY

PREPARED BY:

SUBMITTED BY:

CERTIFIED BY: INDEPENDENT CONSULTANT

PROJECT TITLE:

SHEET NO.

BCDA  
Bureau of Construction, Design and Architecture  
Department of Public Works and Highways  
Malacañang Palace, Manila

Hilmar's Construction Corporation  
1835 E. Rodriguez St., Avenue, Cebu, Cebu City


Filipinas Dravo Corporation  
Architectural & Engineering Consultants  
1000 N. E. 10th Ave., Suite 100, Fort Lauderdale, FL 33304, USA  
Tel: (954) 571-1111, Fax: (954) 571-1112, Email: info@filipinasdravo.com

BANDAR HEBAT BUILDERS, INC.  
ISMA'S DAVID  
PRESIDENT


TCGI ENGINEERS  
VINGILO A. MORONZO  
PRESIDENT/CEO

AS-BUILT DRAWING  
NGAC PHASE I A  
AQUATIC CENTER  
NEW CLARK CITY, CAPAS, TARLAC

ELEVATOR PLAN AND SECTION  
MS-01

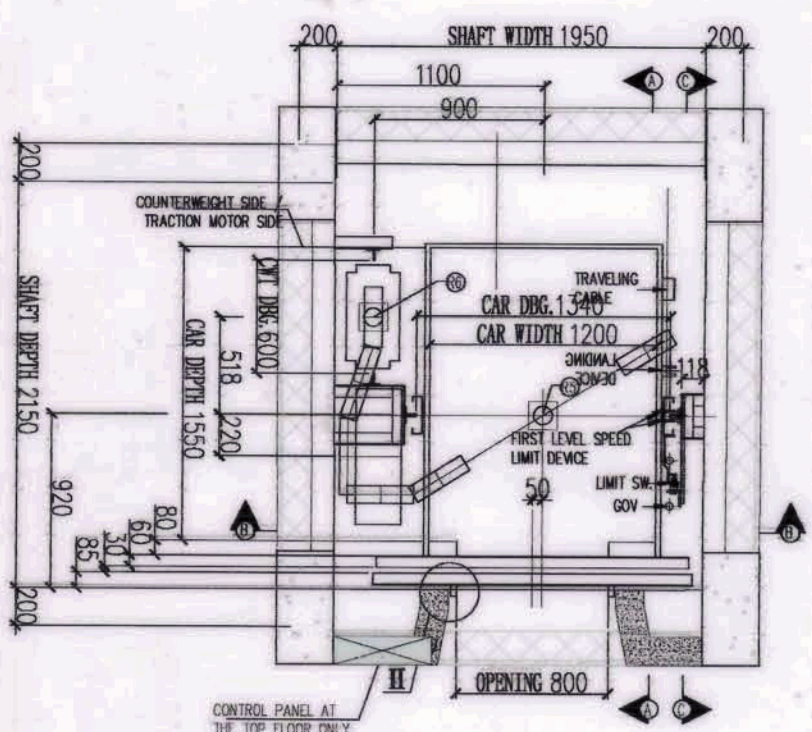


B SHAFT PLAN  
SCALE: 1:35M

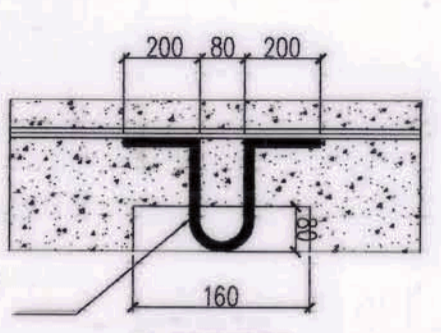


C I HOOK  
CAP. ≥ 20KN  
SCALE: 1:35M

WALL	CONCRETE
WALL THK	
PD(OH)	4750 MM
UB	5090 MM
UCD	3350 MM
UG	3800 MM
LG	5000 MM
PIT	1250 MM


NOT STOP

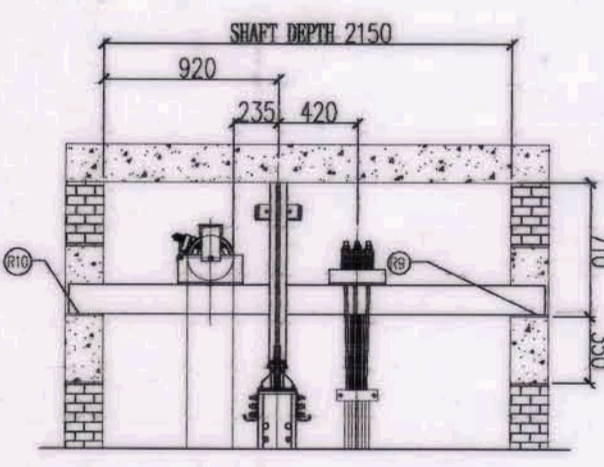

D C-C SECTION AT TOP FLOOR ONLY  
SCALE: 1:35M

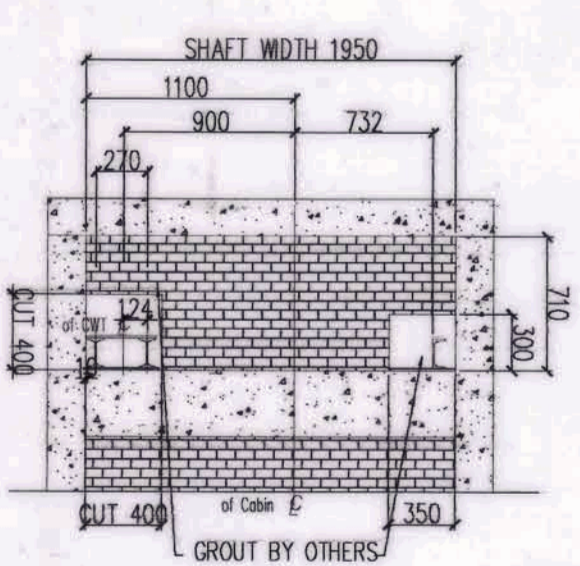

E B-B SECTION AT TOP FLOOR ONLY  
SCALE: 1:35M

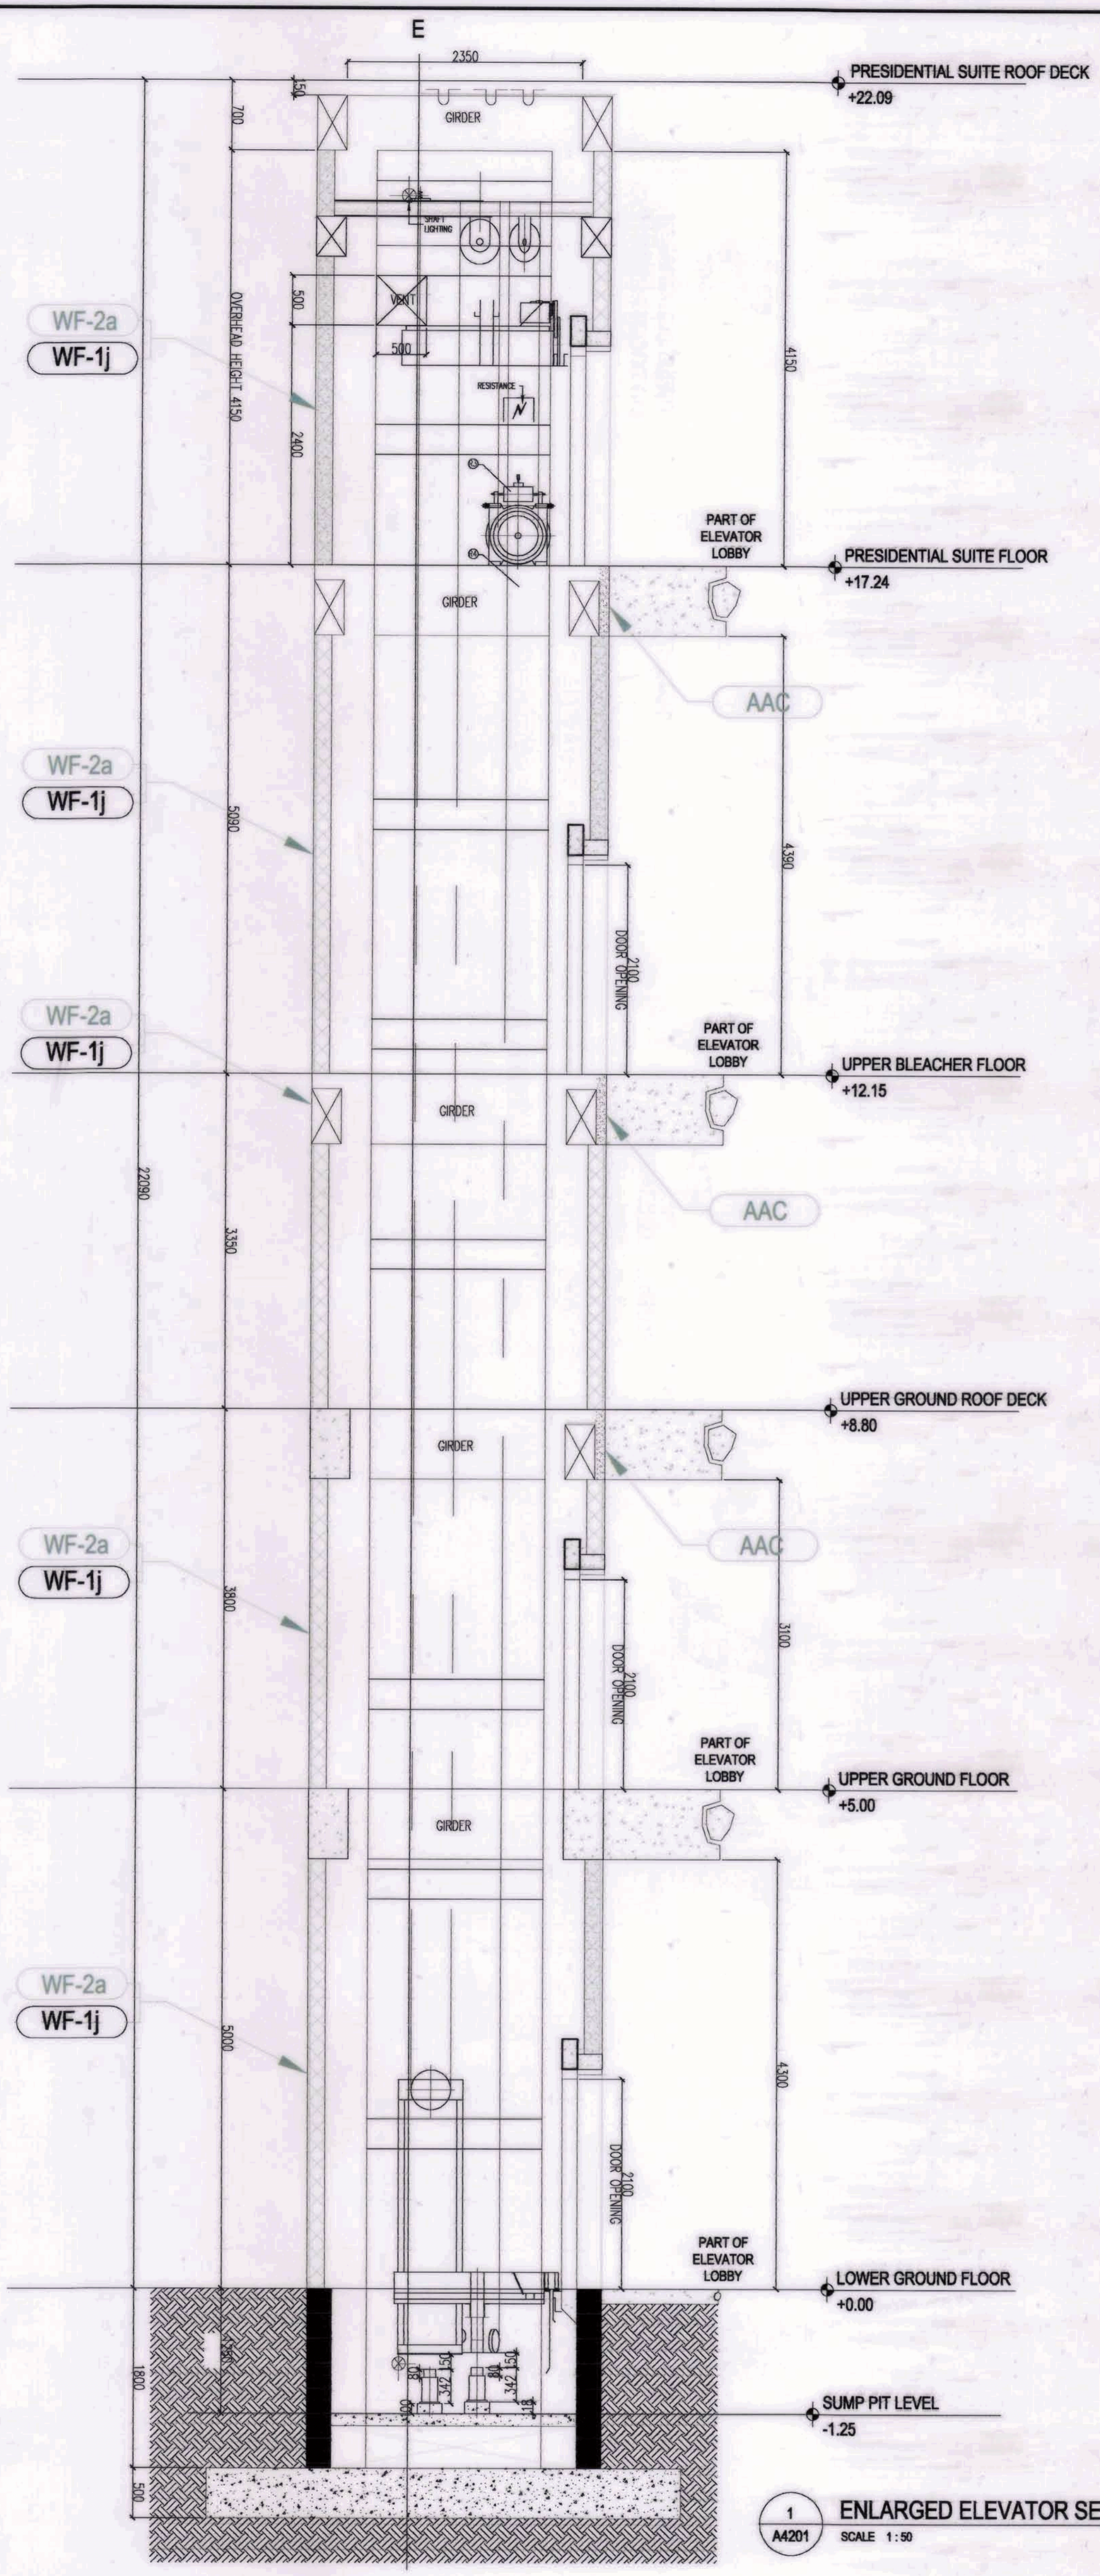

1 ENLARGED ELEVATOR SECTION  
SCALE: 1:50



A SHAFT SIDE SECTION C-C  
SCALE: 1:35M

LIFT SPECIFICATION & DATA	
STANDARD	JOHNSON-8
ELEVATOR TYPE	800kg (10 Persons)
RATED LOAD/PERSON	1.0 m/s
SPEED	2.1
ROPING	5/4/4
NO. OF FLS/STOP/LANDING	1
NO. OF CAR ENTRANCE (S)	1200
CAR INTERNAL WIDTH	1550
CAR INTERNAL DEPTH	2420
CAR INTERNAL HEIGHT	800
LIFT ENTRANCE HEIGHT	2100
DOOR OPERATION	2 PANELS CENTRAL OPENING
CONTROL SYSTEM	CTRL 70A
OPERATION	SMRFX
DIAMETER OF MAIN SHEAVE	Φ400
DIA. OF DEFLECTOR SHEAVE	Φ400/Φ350/Φ320
MAIN ROPE	8 x 8 x 6
CAR RAIL	XSQ15-13
COUNTERWEIGHT RAIL	TK54/B
TYPE OF CAR BUFFER	H-F808
TYPE OF CW BUFFER	H-F808
BUFFER STROKE	80
CAR WEIGHT	950 KG
MAX WT ALLOWANCE (FINISHES)	200 KG
COUNTERWEIGHT WT.	1500 KG
WT OF TRACTION MACHINE	600 x 280
FINISHES, DECORATION & CONTROLS	

ELECTRICAL REQUIREMENTS	
MAIN SUPPLY	3 PHASE 400V 60HZ
AUXILIARY SUPPLY	SINGLE PHASE 220V 60HZ
RATED CURRENT	12.0 A
STARTING CURRENT	18.0 A
MOTOR OUTPUT POWER	5.3 kW
MAXIMUM START HOUR	240
OPTIONAL DEVICES	
ARD	
REGENERATIVE SYSTEM	
ANNOUNCIATOR	
REACTIONS	
R1	HITCH BEAM SUPPORT FRONT SIDE
R2	BEAM SUPPORT REAR SIDE
R3	TRACTION MOTOR UPPER BRACKET
R4	TRACTION MOTOR LOWER BRACKET
R5	CAR BUFFER PLINTH
R6	COUNTERWT BUFFER PLINTH
R7	
R8	
R9	
R10	

1 ELEVATOR PLAN AND SECTION  
SCALE: 1:35M

GRAPHIC SCALE:

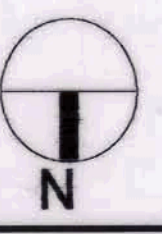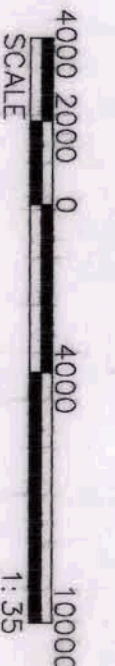

OWNER: NGAC PHASE I JV COMPANY

PREPARED BY: BCD&A AND MDC&A

REVIEWED AND VALIDATED BY: Hilmar's Construction Corporation

SUBMITTED BY: BANDAR HERBAT BUILDERS, INC.



CERTIFIED BY: TCGI ENGINEERS

PROJECT TITLE: AS-BUILT DRAWING

SHEET NO. M5-01a

PROJECT CONTENTS: ELEVATOR PLAN AND SECTION



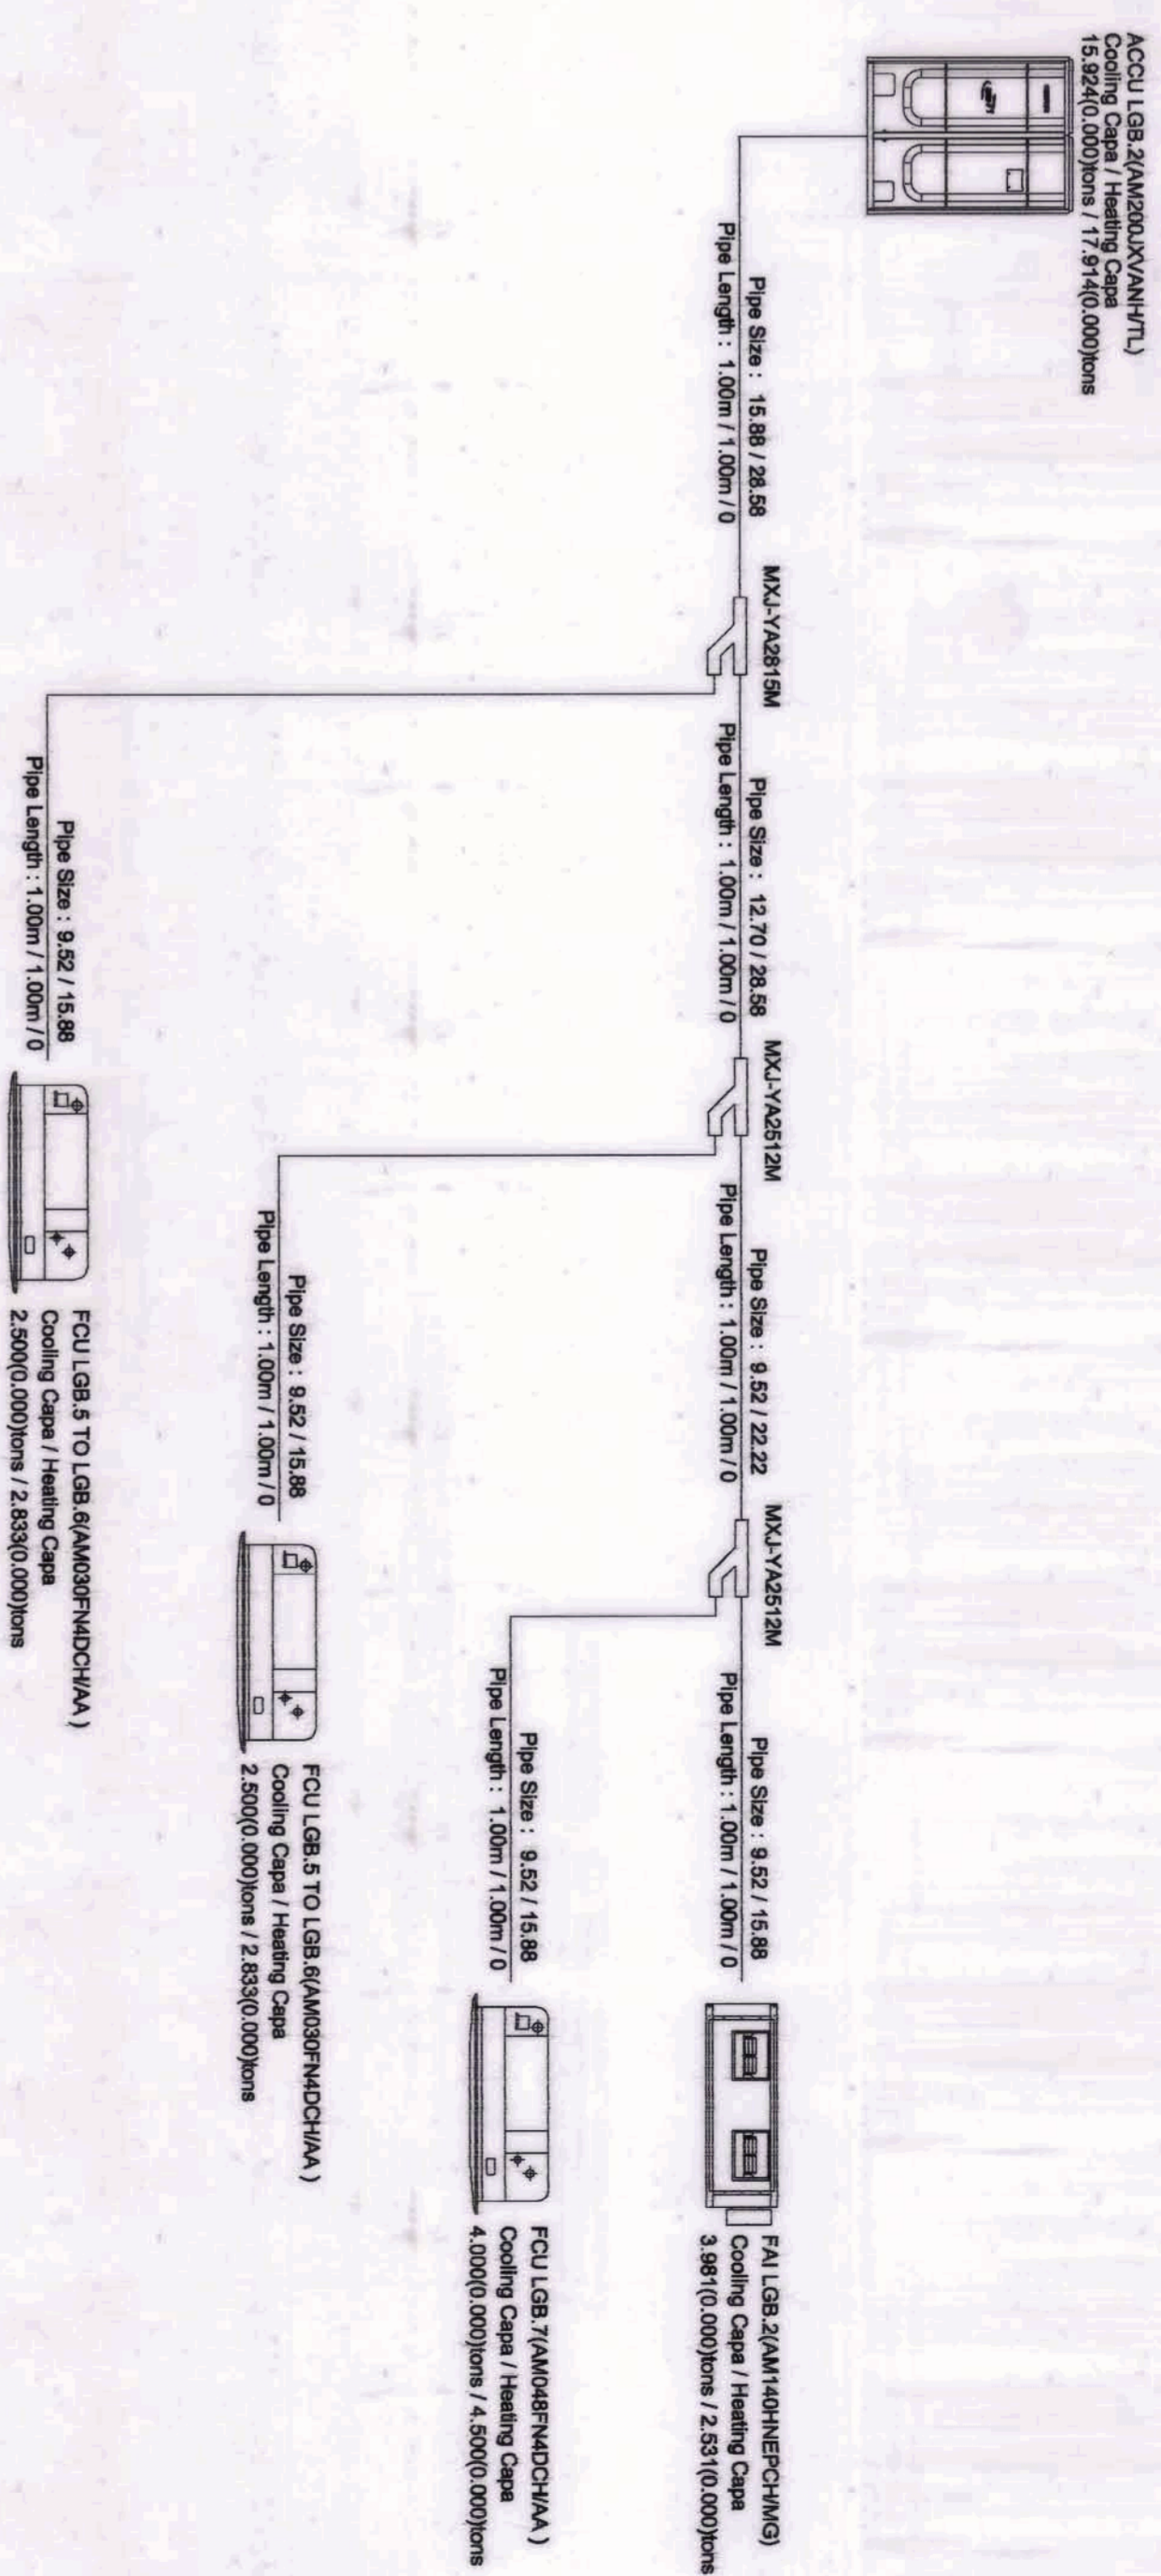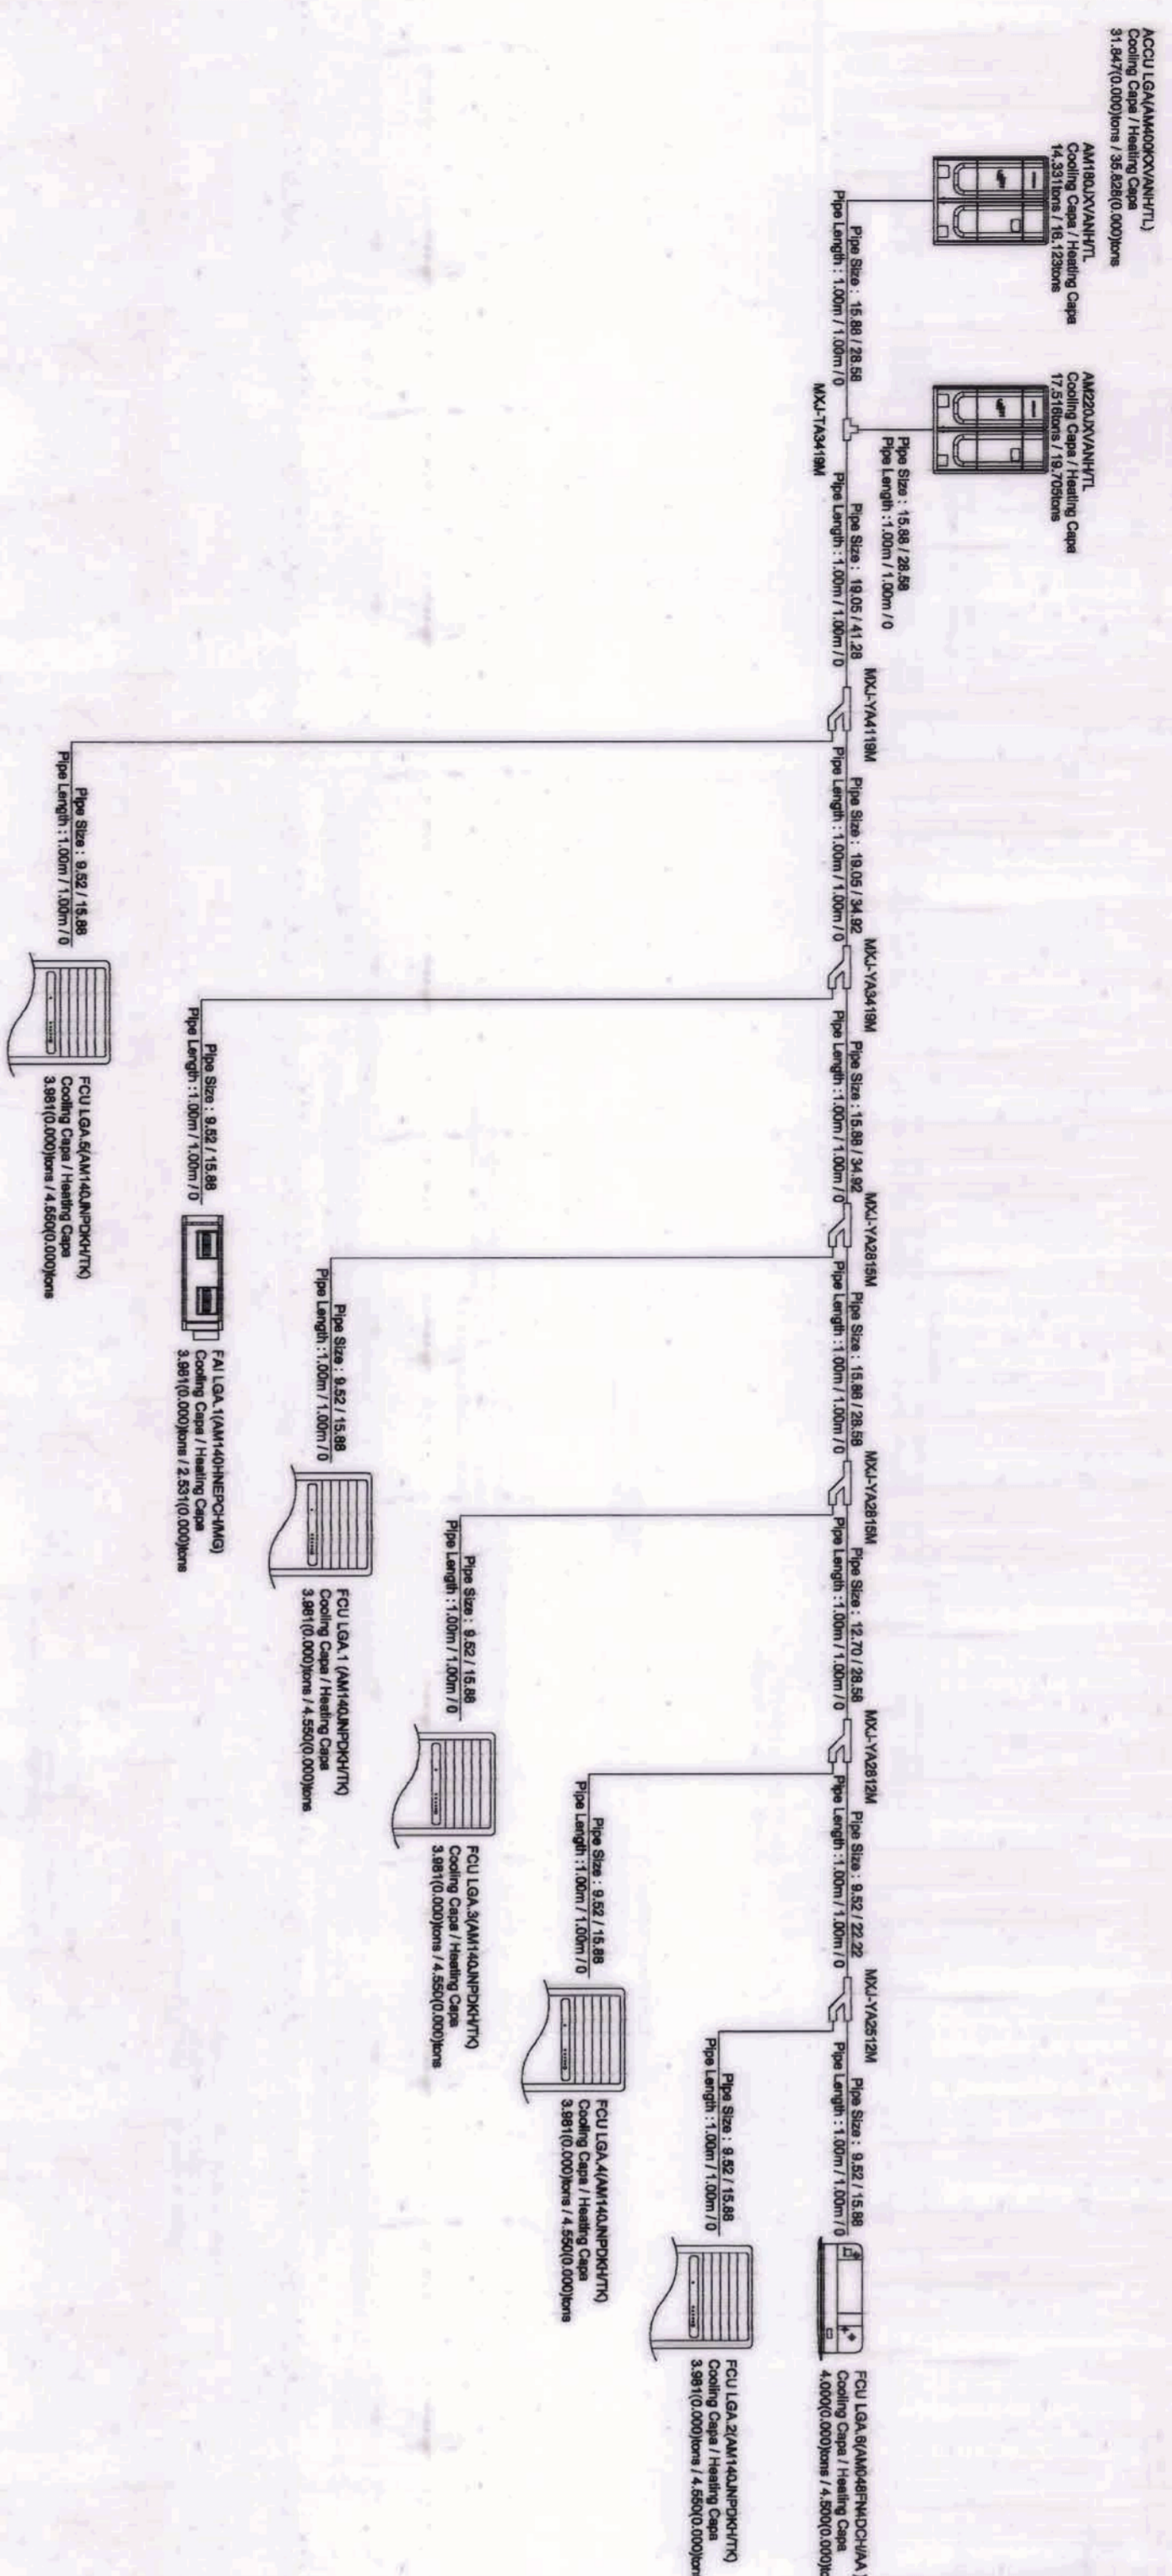



## LOWER GROUND FLOOR REFRIGERANT PIPING DIAGRAM (ACCU-LGA)

1  
M6-01

NOT

To

SCALE

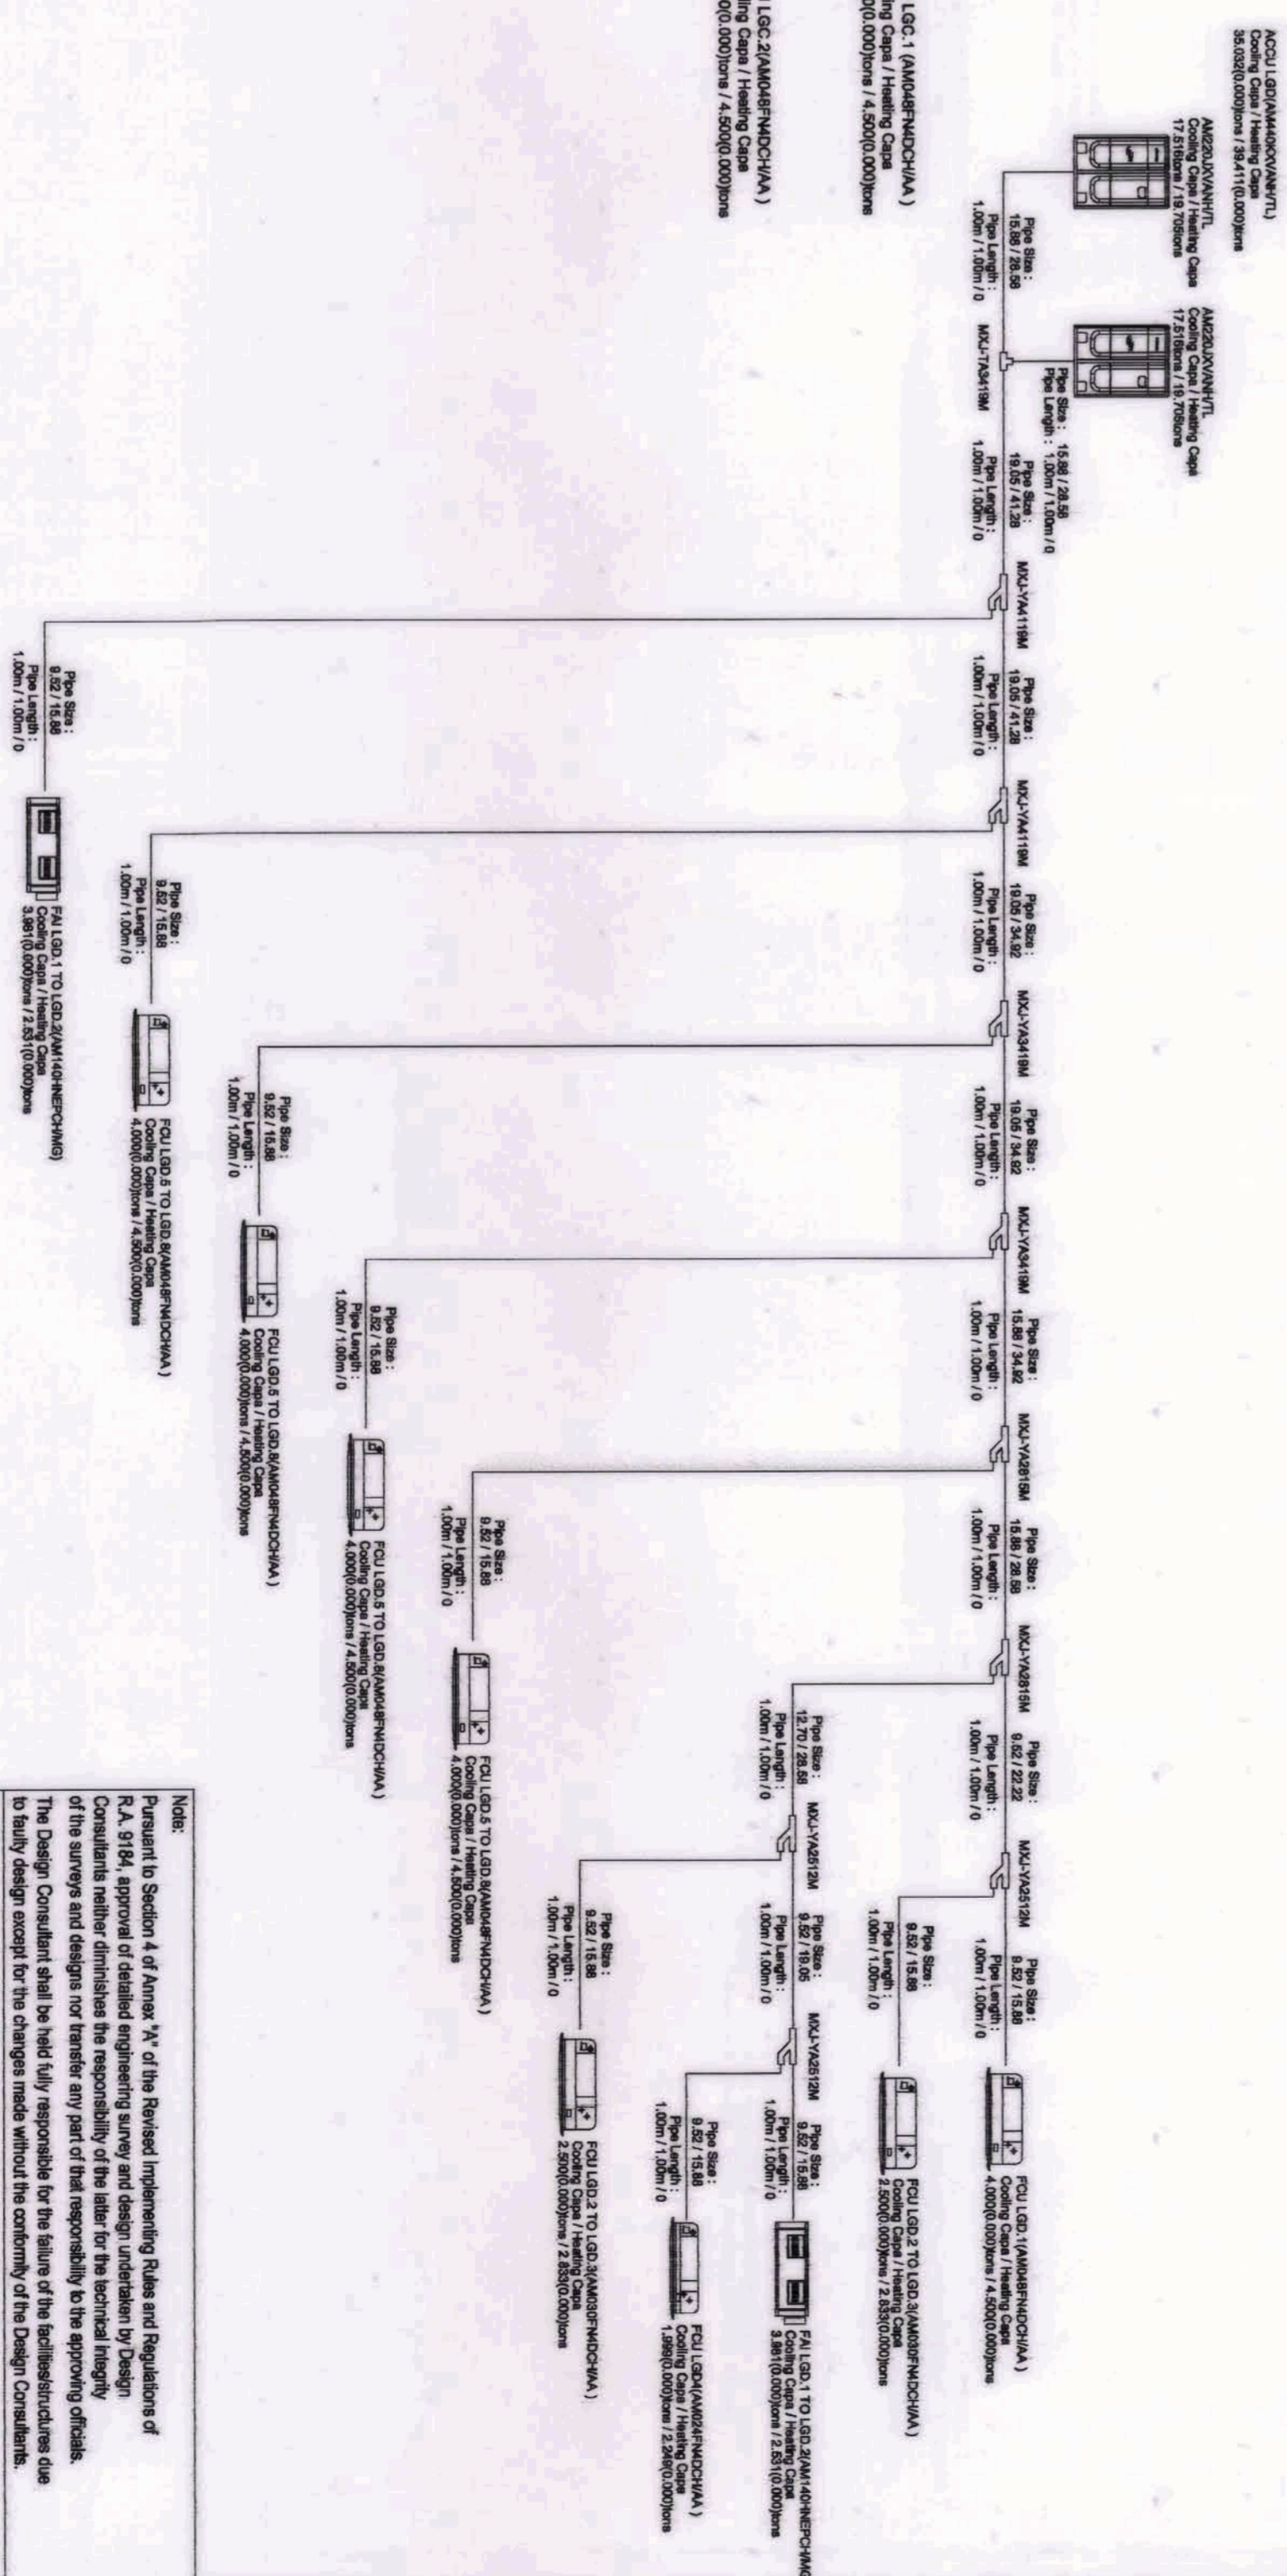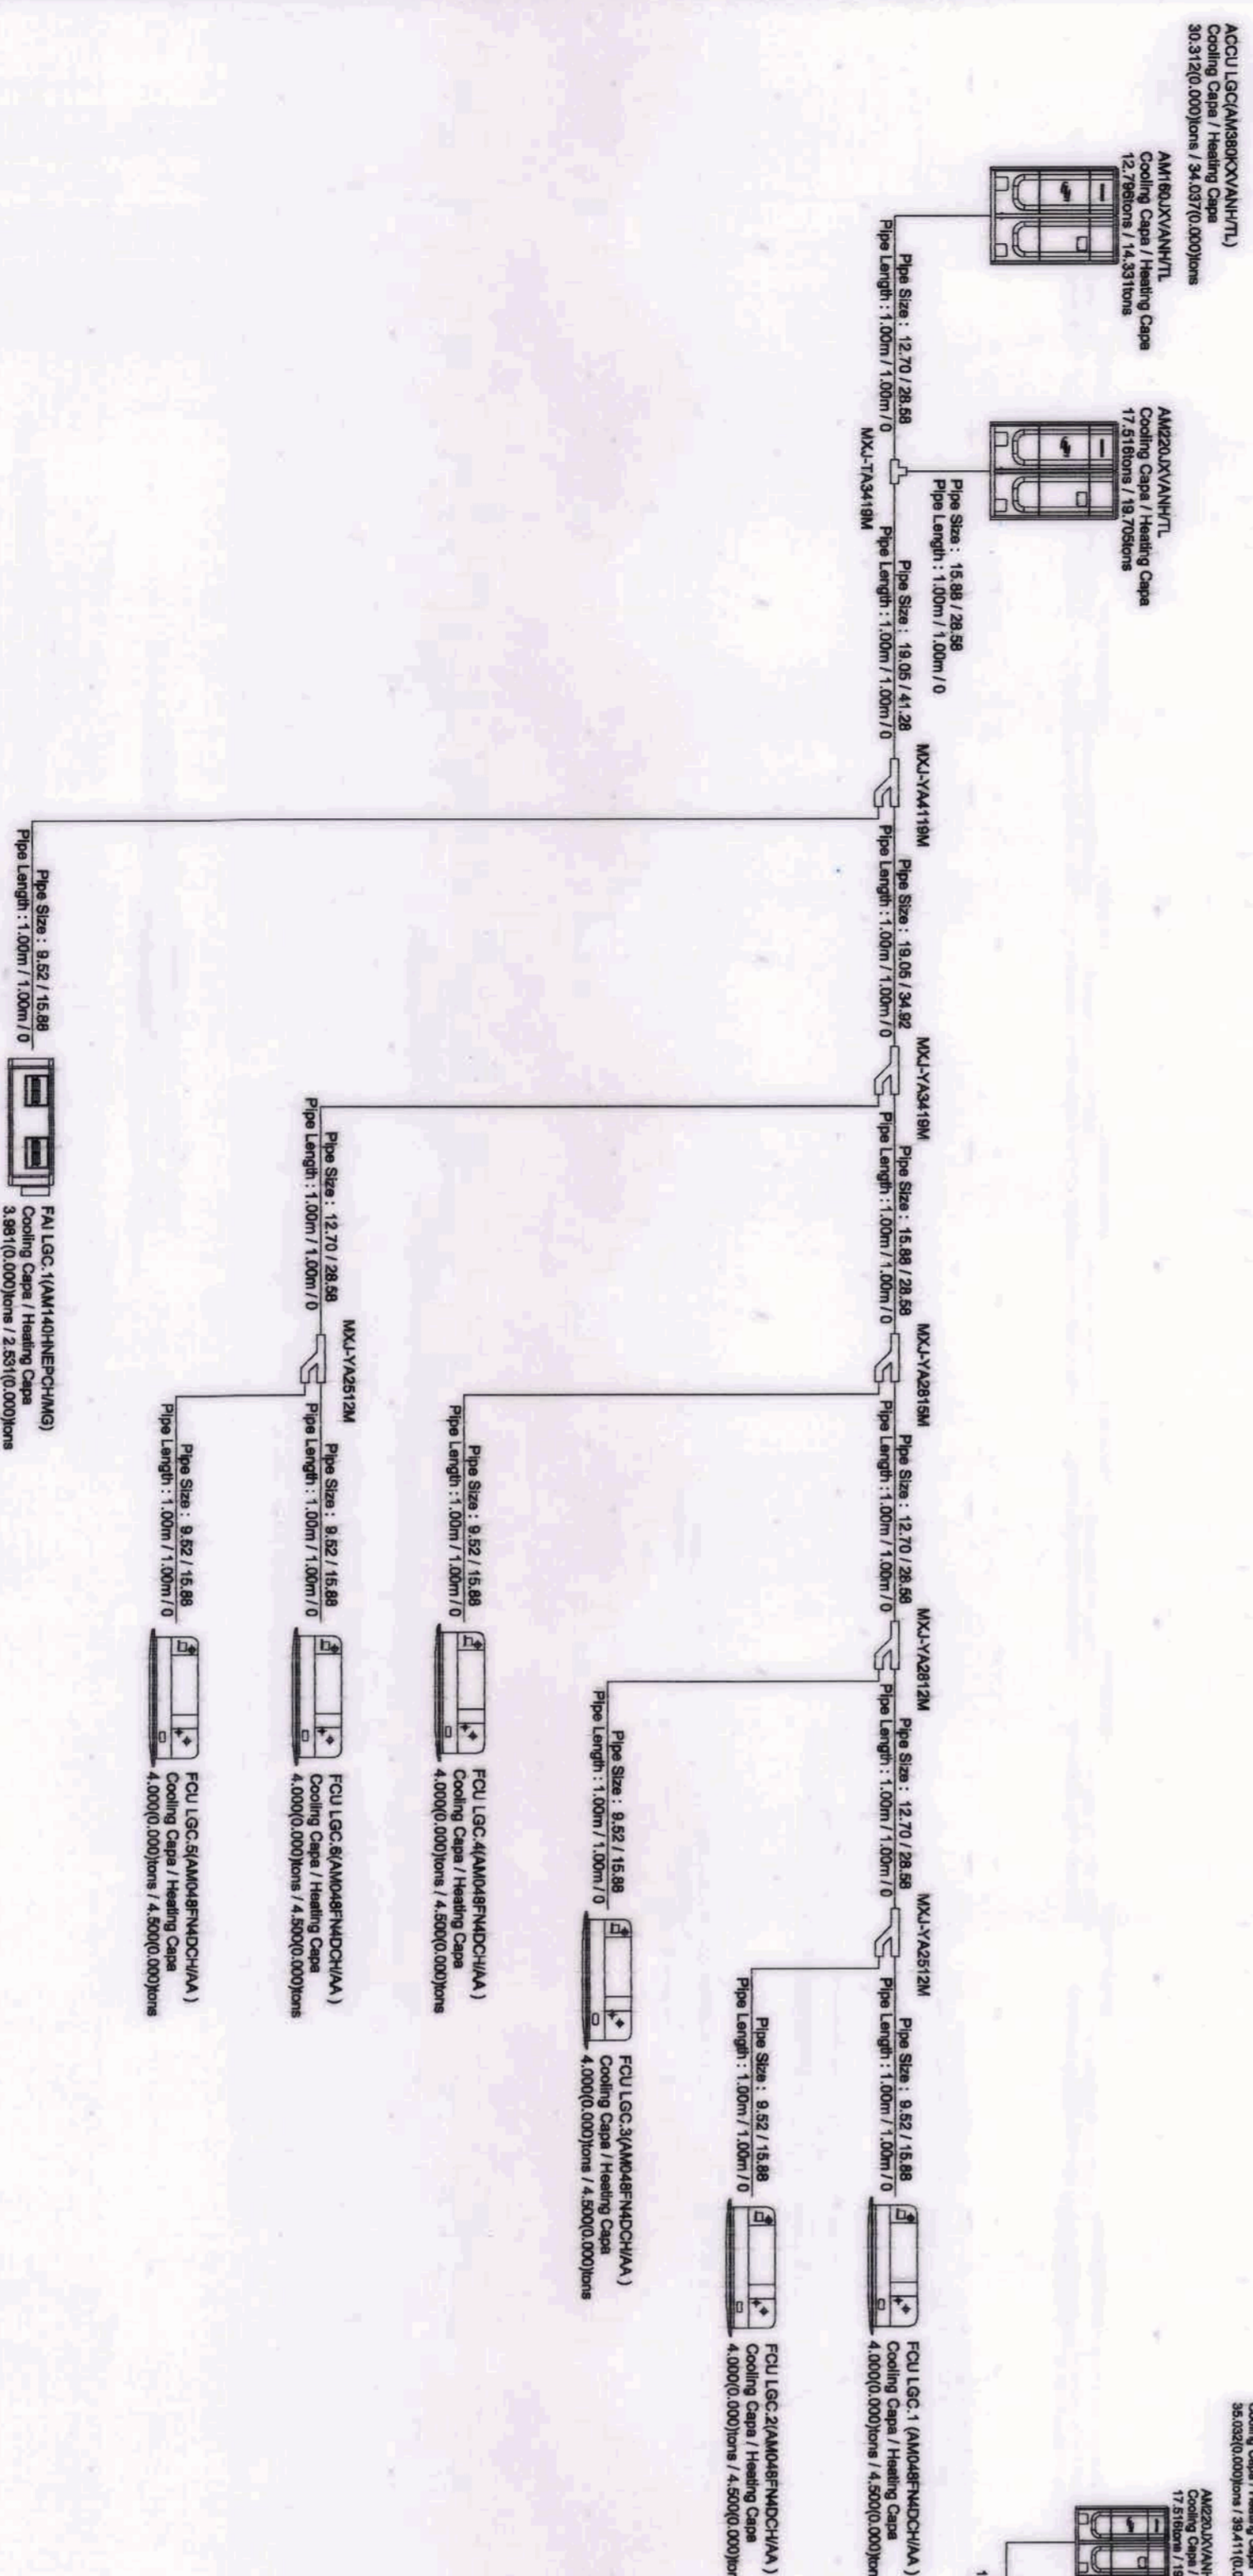

### LOWER GROUND FLOOR REFRIGERANT PIPING DIAGRAM (ACCU-LG)

3  
M6-01

NOT

SCALE

### LOWER GROUND FLOOR REFRIGERANT PIPING DIAGRAM (ACCU-LGD)

 
 



 
 


 



 


 



 




 
 



 
 




 
 


 


 
 


 
 



 



 
 



 














4  
M6-01

 
NOT

SCALE

**GRAPHIC SCALE:**

  


OWNER: NSAC PHASE 1 JV COMPANY	PREPARED BY:	REVIEWED AND VALIDATED BY:	SUBMITTED BY:	CERTIFIED BY: INDEPENDENT CONSULTANT	PROJECT TITLE:	SHEET CONTENTS:	SHEET NO.
<div><div><b>BCDA</b> BAY AREA CALIFORNIA DEVELOPMENT AUTHORITY 1000 BAYVIEW AVENUE, SUITE 100 OAKLAND, CA 94612 (415) 774-2000 WWW.BCDA.CA.GOV</div><div><b>AND</b><div><b>MND GROUP, INC.</b> 1000 BAYVIEW AVENUE, SUITE 100 OAKLAND, CA 94612 (415) 774-2000 WWW.MNDGROUP.COM</div></div><div><div><b>Hilmar's Construction Corporation</b> 1635 E. Rodriguez St., Avenue, Caguas, Puerto Rico 00981 (787) 841-1111 WWW.HILMARSCORP.COM</div><div><div><b>FILIPINAS DRAVO CORPORATION</b> Architectural &amp; Engineering Consultants 1000 BAYVIEW AVENUE, SUITE 100 OAKLAND, CA 94612 (415) 774-2000 WWW.FILIPINASDRAVO.COM</div><div><div><b>BANDAR HEBAT BUILDERS, INC.</b> 1000 BAYVIEW AVENUE, SUITE 100 OAKLAND, CA 94612 (415) 774-2000 WWW.BHBI.COM</div><div><div><b>TCGI ENGINEERS</b> 818 P. JAMES BOUL. 108 A, 108 B, 108 C, 108 D, 108 E, 108 F, 108 G, 108 H, 108 I, 108 J, 108 K, 108 L, 108 M, 108 N, 108 O, 108 P, 108 Q, 108 R, 108 S, 108 T, 108 U, 108 V, 108 W, 108 X, 108 Y, 108 Z 1000 BAYVIEW AVENUE, SUITE 100 OAKLAND, CA 94612 (415) 774-2000 WWW.TCGIENGINEERS.COM</div></div></div><div><div><b>WENOCO B. OZON</b> PRESIDENT</div><div><b>PATRICK NICHOLAS P. DAVID</b> PRESIDENT</div><div><div><b>Hilmar's Construction Corporation</b> 1635 E. Rodriguez St., Avenue, Caguas, Puerto Rico 00981 (787) 841-1111 WWW.HILMARSCORP.COM</div><div><div><b>FILIPINAS DRAVO CORPORATION</b> Architectural &amp; Engineering Consultants 1000 BAYVIEW AVENUE, SUITE 100 OAKLAND, CA 94612 (415) 774-2000 WWW.FILIPINASDRAVO.COM</div><div><div><b>BANDAR HEBAT BUILDERS, INC.</b> 1000 BAYVIEW AVENUE, SUITE 100 OAKLAND, CA 94612 (415) 774-2000 WWW.BHBI.COM</div><div><div><b>TCGI ENGINEERS</b> 818 P. JAMES BOUL. 108 A, 108 B, 108 C, 108 D, 108 E, 108 F, 108 G, 108 H, 108 I, 108 J, 108 K, 108 L, 108 M, 108 N, 108 O, 108 P, 108 Q, 108 R, 108 S, 108 T, 108 U, 108 V, 108 W, 108 X, 108 Y, 108 Z 1000 BAYVIEW AVENUE, SUITE 100 OAKLAND, CA 94612 (415) 774-2000 WWW.TCGIENGINEERS.COM</div></div></div><div><div><b>WENOCO B. OZON</b> PRESIDENT</div><div><b>PATRICK NICHOLAS P. DAVID</b> PRESIDENT</div><div><div><b>Hilmar's Construction Corporation</b> 1635 E. Rodriguez St., Avenue, Caguas, Puerto Rico 00981 (787) 841-1111 WWW.HILMARSCORP.COM</div><div><div><b>FILIPINAS DRAVO CORPORATION</b> Architectural &amp; Engineering Consultants 1000 BAYVIEW AVENUE, SUITE 100 OAKLAND, CA 94612 (415) 774-2000 WWW.FILIPINASDRAVO.COM</div><div><div><b>BANDAR HEBAT BUILDERS, INC.</b> 1000 BAYVIEW AVENUE, SUITE 100 OAKLAND, CA 94612 (415) 774-2000 WWW.BHBI.COM</div><div><div><b>TCGI ENGINEERS</b> 818 P. JAMES BOUL. 108 A, 108 B, 108 C, 108 D, 108 E, 108 F, 108 G, 108 H, 108 I, 108 J, 108 K, 108 L, 108 M, 108 N, 108 O, 108 P, 108 Q, 108 R, 108 S, 108 T, 108 U, 108 V, 108 W, 108 X, 108 Y, 108 Z 1000 BAYVIEW AVENUE, SUITE 100 OAKLAND, CA 94612 (415) 774-2000 WWW.TCGIENGINEERS.COM</div></div></div><div><div><b>WENOCO B. OZON</b> PRESIDENT</div><div><b>PATRICK NICHOLAS P. DAVID</b> PRESIDENT</div><div><div><b>Hilmar's Construction Corporation</b> 1635 E. Rodriguez St., Avenue, Caguas, Puerto Rico 00981 (787) 841-1111 WWW.HILMARSCORP.COM</div><div><div><b>FILIPINAS DRAVO CORPORATION</b> Architectural &amp; Engineering Consultants 1000 BAYVIEW AVENUE, SUITE 100 OAKLAND, CA 94612 (415) 774-2000 WWW.FILIPINASDRAVO.COM</div><div><div><b>BANDAR HEBAT BUILDERS, INC.</b> 1000 BAYVIEW AVENUE, SUITE 100 OAKLAND, CA 94612 (415) 774-2000 WWW.BHBI.COM</div><div><div><b>TCGI ENGINEERS</b> 818 P. JAMES BOUL. 108 A, 108 B, 108 C, 108 D, 108 E, 108 F, 108 G, 108 H, 108 I, 108 J, 108 K, 108 L, 108 M, 108 N, 108 O, 108 P, 108 Q, 108 R, 108 S, 108 T, 108 U, 108 V, 108 W, 108 X, 108 Y, 108 Z 1000 BAYVIEW AVENUE, SUITE 100 OAKLAND, CA 94612 (415) 774-2000 WWW.TCGIENGINEERS.COM</div></div></div><div><div><b>WENOCO B. OZON</b> PRESIDENT</div><div><b>PATRICK NICHOLAS P. DAVID</b> PRESIDENT</div><div><div><b>Hilmar's Construction Corporation</b> 1635 E. Rodriguez St., Avenue, Caguas, Puerto Rico 00981 (787) 841-1111 WWW.HILMARSCORP.COM</div><div><div><b>FILIPINAS DRAVO CORPORATION</b> Architectural &amp; Engineering Consultants 1000 BAYVIEW AVENUE, SUITE 100 OAKLAND, CA 94612 (415) 774-2000 WWW.FILIPINASDRAVO.COM</div><div><div><b>BANDAR HEBAT BUILDERS, INC.</b> 1000 BAYVIEW AVENUE, SUITE 100 OAKLAND, CA 94612 (415) 774-2000 WWW.BHBI.COM</div><div><div><b>TCGI ENGINEERS</b> 818 P. JAMES BOUL. 108 A, 108 B, 108 C, 108 D, 108 E, 108 F, 108 G, 108 H, 108 I, 108 J, 108 K, 108 L, 108 M, 108 N, 108 O, 108 P, 108 Q, 108 R, 108 S, 108 T, 108 U, 108 V, 108 W, 108 X, 108 Y, 108 Z 1000 BAYVIEW AVENUE, SUITE 100 OAKLAND, CA 94612 (415) 774-2000 WWW.TCGIENGINEERS.COM</div></div></div><div><div><b>WENOCO B. OZON</b> PRESIDENT</div><div><b>PATRICK NICHOLAS P. DAVID</b> PRESIDENT</div><div><div><b>Hilmar's Construction Corporation</b> 1635 E. Rodriguez St., Avenue, Caguas, Puerto Rico 00981 (787) 841-1111 WWW.HILMARSCORP.COM</div><div><div><b>FILIPINAS DRAVO CORPORATION</b> Architectural &amp; Engineering Consultants 1000 BAYVIEW AVENUE, SUITE 100 OAKLAND, CA 94612 (415) 774-2000 WWW.FILIPINASDRAVO.COM</div><div><div><b>BANDAR HEBAT BUILDERS, INC.</b> 1000 BAYVIEW AVENUE, SUITE 100 OAKLAND, CA 94612 (415) 774-2000 WWW.BHBI.COM</div><div><div><b>TCGI ENGINEERS</b> 818 P. JAMES BOUL. 108 A, 108 B, 108 C, 108 D, 108 E, 108 F, 108 G, 108 H, 108 I, 108 J, 108 K, 108 L, 108 M, 108 N, 108 O, 108 P, 108 Q, 108 R, 108 S, 108 T, 108 U, 108 V, 108 W, 108 X, 108 Y, 108 Z 1000 BAYVIEW AVENUE, SUITE 100 OAKLAND, CA 94612 (415) 774-2000 WWW.TCGIENGINEERS.COM</div></div></div><div><div><b>WENOCO B. OZON</b> PRESIDENT</div><div><b>PATRICK NICHOLAS P. DAVID</b> PRESIDENT</div><div><div><b>Hilmar's Construction Corporation</b> 1635 E. Rodriguez St., Avenue, Caguas, Puerto Rico 00981 (787) 841-1111 WWW.HILMARSCORP.COM</div><div><div><b>FILIPINAS DRAVO CORPORATION</b> Architectural &amp; Engineering Consultants 1000 BAYVIEW AVENUE, SUITE 100 OAKLAND, CA 94612 (415) 774-2000 WWW.FILIPINASDRAVO.COM</div><div><div><b>BANDAR HEBAT BUILDERS, INC.</b> 1000 BAYVIEW AVENUE, SUITE 100 OAKLAND, CA 94612 (415) 774-2000 WWW.BHBI.COM</div><div><div><b>TCGI ENGINEERS</b> 818 P. JAMES BOUL. 108 A, 108 B, 108 C, 108 D, 108 E, 108 F, 108 G, 108 H, 108 I, 108 J, 108 K, 108 L, 108 M, 108 N, 108 O, 108 P, 108 Q, 108 R, 108 S, 108 T, 108 U, 108 V, 108 W, 108 X, 108 Y, 108 Z 1000 BAYVIEW AVENUE, SUITE 100 OAKLAND, CA 94612 (415) 774-2000 WWW.TCGIENGINEERS.COM</div></div></div><div><div><b>WENOCO B. OZON</b> PRESIDENT</div><div><b>PATRICK NICHOLAS P. DAVID</b> PRESIDENT</div><div><div><b>Hilmar's Construction Corporation</b> 1635 E. Rodriguez St., Avenue, Caguas, Puerto Rico 00981 (787) 841-1111 WWW.HILMARSCORP.COM</div><div><div><b>FILIPINAS DRAVO CORPORATION</b> Architectural &amp; Engineering Consultants 1000 BAYVIEW AVENUE, SUITE 100 OAKLAND, CA 94612 (415) 774-2000 WWW.FILIPINASDRAVO.COM</div><div><div><b>BANDAR HEBAT BUILDERS, INC.</b> 1000 BAYVIEW AVENUE, SUITE 100 OAKLAND, CA 94612 (415) 774-2000 WWW.BHBI.COM</div><div><div><b>TCGI ENGINEERS</b> 818 P. JAMES BOUL. 108 A, 108 B, 108 C, 108 D, 108 E, 108 F, 108 G, 108 H, 108 I, 108 J, 108 K, 108 L, 108 M, 108 N, 108 O, 108 P, 108 Q, 108 R, 108 S, 108 T, 108 U, 108 V, 108 W, 108 X, 108 Y, 108 Z 1000 BAYVIEW AVENUE, SUITE 100 OAKLAND, CA 94612 (415) 774-2000 WWW.TCGIENGINEERS.COM</div></div></div><div><div><b>WENOCO B. OZON</b> PRESIDENT</div><div><b>PATRICK NICHOLAS P. DAVID</b> PRESIDENT</div><div><div><b>Hilmar's Construction Corporation</b> 1635 E. Rodriguez St., Avenue, Caguas, Puerto Rico 00981 (787) 841-1111 WWW.HILMARSCORP.COM</div><div><div><b>FILIPINAS DRAVO CORPORATION</b> Architectural &amp; Engineering Consultants 1000 BAYVIEW AVENUE, SUITE 100 OAKLAND, CA 94612 (415) 774-2000 WWW.FILIPINASDRAVO.COM</div><div><div><b>BANDAR HEBAT BUILDERS, INC.</b> 1000 BAYVIEW AVENUE, SUITE 100 OAKLAND, CA 94612 (415) 774-2000 WWW.BHBI.COM</div><div><div><b>TCGI ENGINEERS</b> 818 P. JAMES BOUL. 108 A, 108 B, 108 C, 108 D, 108 E, 108 F, 108 G, 108 H, 108 I, 108 J, 108 K, 108 L, 108 M, 108 N, 108 O, 108 P, 108 Q, 108 R, 108 S, 108 T, 108 U, 108 V, 108 W, 108 X, 108 Y, 108 Z 1000 BAYVIEW AVENUE, SUITE 100 OAKLAND, CA 94612 (415) 774-2000 WWW.TCGIENGINEERS.COM</div></div></div><div><div><b>WENOCO B. OZON</b> PRESIDENT</div><div><b>PATRICK NICHOLAS P. DAVID</b> PRESIDENT</div><div><div><b>Hilmar's Construction Corporation</b> 1635 E. Rodriguez St., Avenue, Caguas, Puerto Rico 00981 (787) 841-1111 WWW.HILMARSCORP.COM</div><div><div><b>FILIPINAS DRAVO CORPORATION</b> Architectural &amp; Engineering Consultants 1000 BAYVIEW AVENUE, SUITE 100 OAKLAND, CA 94612 (415) 774-2000 WWW.FILIPINASDRAVO.COM</div><div><div><b>BANDAR HEBAT BUILDERS, INC.</b> 1000 BAYVIEW AVENUE, SUITE 100 OAKLAND, CA 94612 (415) 774-2000 WWW.BHBI.COM</div><div><div><b>TCGI ENGINEERS</b> 818 P. JAMES BOUL. 108 A, 108 B, 108 C, 108 D, 108 E, 108 F, 108 G, 108 H, 108 I, 108 J, 108 K, 108 L, 108 M, 108 N, 108 O, 108 P, 108 Q, 108 R, 108 S, 108 T, 108 U, 108 V, 108 W, 108 X, 108 Y, 108 Z 1000 BAYVIEW AVENUE, SUITE 100 OAKLAND, CA 94612 (415) 774-2000 WWW.TCGIENGINEERS.COM</div></div></div><div><div><b>WENOCO B. OZON</b> PRESIDENT</div><div><b>PATRICK NICHOLAS P. DAVID</b> PRESIDENT</div><div><div><b>Hilmar's Construction Corporation</b> 1635 E. Rodriguez St., Avenue, Caguas, Puerto Rico 00981 (787) 841-1111 WWW.HILMARSCORP.COM</div><div><div><b>FILIPINAS DRAVO CORPORATION</b> Architectural &amp; Engineering Consultants 1000 BAYVIEW AVENUE, SUITE 100 OAKLAND, CA 94612 (415) 774-2000 WWW.FILIPINASDRAVO.COM</div><div><div><b>BANDAR HEBAT BUILDERS, INC.</b> 1000 BAYVIEW AVENUE, SUITE 100 OAKLAND, CA 94612 (415) 774-2000 WWW.BHBI.COM</div><div><div><b>TCGI ENGINEERS</b> 818 P. JAMES BOUL. 108 A, 108 B, 108 C, 108 D, 108 E, 108 F, 108 G, 108 H, 108 I, 108 J, 108 K, 108 L, 108 M, 108 N, 108 O, 108 P, 108 Q, 108 R, 108 S, 108 T, 108 U, 108 V, 108 W, 108 X, 108 Y, 108 Z 1000 BAYVIEW AVENUE, SUITE 100 OAKLAND, CA 94612 (415) 774-2000 WWW.TCGIENGINEERS.COM</div></div></div><div><div><b>WENOCO B. OZON</b> PRESIDENT</div><div><b>PATRICK NICHOLAS P. DAVID</b> PRESIDENT</div><div><div><b>Hilmar's Construction Corporation</b> 1635 E. Rodriguez St., Avenue, Caguas, Puerto Rico 00981 (787) 841-1111 WWW.HILMARSCORP.COM</div><div><div><b>FILIPINAS DRAVO CORPORATION</b> Architectural &amp; Engineering Consultants 1000 BAYVIEW AVENUE, SUITE 100 OAKLAND, CA 94612 (415) 774-2000 WWW.FILIPINASDRAVO.COM</div><div><div><b>BANDAR HEBAT BUILDERS, INC.</b> 1000 BAYVIEW AVENUE, SUITE 100 OAKLAND, CA 94612 (415) 774-2000 WWW.BHBI.COM</div><div><div><b>TCGI ENGINEERS</b> 818 P. JAMES BOUL. 108 A, 108 B, 108 C, 108 D, 108 E, 108 F, 108 G, 108 H, 108 I, 108 J, 108 K, 108 L, 108 M, 108 N, 108 O, 108 P, 108 Q, 108 R, 108 S, 108 T, 108 U, 108 V, 108 W, 108 X, 108 Y, 108 Z 1000 BAYVIEW AVENUE, SUITE 100 OAKLAND, CA 94612 (415) 774-2000 WWW.TCGIENGINEERS.COM</div></div></div><div><div><b>WENOCO B. OZON</b> PRESIDENT</div><div><b>PATRICK NICHOLAS P. DAVID</b> PRESIDENT</div><div><div><b>Hilmar's Construction Corporation</b> 1635 E. Rodriguez St., Avenue, Caguas, Puerto Rico 00981 (787) 841-1111 WWW.HILMARSCORP.COM</div><div><div><b>FILIPINAS DRAVO CORPORATION</b> Architectural &amp; Engineering Consultants 1000 BAYVIEW AVENUE, SUITE 100 OAKLAND, CA 94612 (415) 774-2000 WWW.FILIPINASDRAVO.COM</div><div><div><b>BANDAR HEBAT BUILDERS, INC.</b> 1000 BAYVIEW AVENUE, SUITE 100 OAKLAND, CA 94612 (415) 774-2000 WWW.BHBI.COM</div><div><div><b>TCGI ENGINEERS</b> 818 P. JAMES BOUL. 108 A, 108 B, 108 C, 108 D, 108 E, 108 F, 108 G, 108 H, 108 I, 108 J, 108 K, 108 L, 108 M, 108 N, 108 O, 108 P, 108 Q, 108 R, 108 S, 108 T, 108 U, 108 V, 108 W, 108 X, 108 Y, 108 Z 1000 BAYVIEW AVENUE, SUITE 100 OAKLAND, CA 94612 (415) 774-2000 WWW.TCGIENGINEERS.COM</div></div></div><div><div><b>WENOCO B. OZON</b> PRESIDENT</div><div><b>PATRICK NICHOLAS P. DAVID</b> PRESIDENT</div><div><div><b>Hilmar's Construction Corporation</b> 1635 E. Rodriguez St., Avenue, Caguas, Puerto Rico 00981 (787) 841-1111 WWW.HILMARSCORP.COM</div><div><div><b>FILIPINAS DRAVO CORPORATION</b> Architectural &amp; Engineering Consultants 1000 BAYVIEW AVENUE, SUITE 100 OAKLAND, CA 94612 (415) 774-2000 WWW.FILIPINASDRAVO.COM</div><div><div><b>BANDAR HEBAT BUILDERS, INC.</b> 1000 BAYVIEW AVENUE, SUITE 100 OAKLAND, CA 94612 (415) 774-2000 WWW.BHBI.COM</div><div><div><b>TCGI ENGINEERS</b> 818 P. JAMES BOUL. 108 A, 108 B, 108 C, 108 D, 108 E, 108 F, 108 G, 108 H, 108 I, 108 J, 108 K, 108 L, 108 M, 108 N, 108 O, 108 P, 108 Q, 108 R, 108 S, 108 T, 108 U, 108 V, 108 W, 108 X, 108 Y, 108 Z 1000 BAYVIEW AVENUE, SUITE 100 OAKLAND, CA 94612 (415) 774-2000 WWW.TCGIENGINEERS.COM</div></div></div><div><div><b>WENOCO B. OZON</b> PRESIDENT</div><div><b>PATRICK NICHOLAS P. DAVID</b> PRESIDENT</div><div><div><b>Hilmar's Construction Corporation</b> 1635 E. Rodriguez St., Avenue, Caguas, Puerto Rico 00981 (787) 841-1111 WWW.HILMARSCORP.COM</div><div><div><b>FILIPINAS DRAVO CORPORATION</b> Architectural &amp; Engineering Consultants 1000 BAYVIEW AVENUE, SUITE 100 OAKLAND, CA 94612 (415) 774-2000 WWW.FILIPINASDRAVO.COM</div><div><div><b>BANDAR HEBAT BUILDERS, INC.</b> 1000 BAYVIEW AVENUE, SUITE 100 OAKLAND, CA 94612 (415) 774-2000 WWW.BHBI.COM</div><div><div><b>TCGI ENGINEERS</b> 818 P. JAMES BOUL. 108 A, 108 B, 108 C, 108 D, 108 E, 108 F, 108 G, 108 H, 108 I, 108 J, 108 K, 108 L, 108 M, 108 N, 108 O, 108 P, 108 Q, 108 R, 108 S, 108 T, 108 U, 108 V, 108 W, 108 X, 108 Y, 108 Z 1000 BAYVIEW AVENUE, SUITE 100 OAKLAND, CA 94612 (415) 774-2000 WWW.TCGIENGINEERS.COM</div></div></div><div><div><b>WENOCO B. OZON</b> PRESIDENT</div><div><b>PATRICK NICHOLAS P. DAVID</b> PRESIDENT</div><div><div><b>Hilmar's Construction Corporation</b> 1635 E. Rodriguez St., Avenue, Caguas, Puerto Rico 00981 (787) 841-1111 WWW.HILMARSCORP.COM</div><div><div><b>FILIPINAS DRAVO CORPORATION</b> Architectural &amp; Engineering Consultants 1000 BAYVIEW AVENUE, SUITE 100 OAKLAND, CA 94612 (415) 774-2000 WWW.FILIPINASDRAVO.COM</div><div><div><b>BANDAR HEBAT BUILDERS, INC.</b> 1000 BAYVIEW AVENUE, SUITE 100 OAKLAND, CA 94612 (415) 774-2000 WWW.BHBI.COM</div><div><div><b>TCGI ENGINEERS</b> 818 P. JAMES BOUL. 108 A, 108 B, 108 C, 108 D, 108 E, 108 F, 108 G, 108 H, 108 I, 108 J, 108 K, 108 L, 108 M, 108 N, 108 O, 108 P, 108 Q, 108 R, 108 S, 108 T, 108 U, 108 V, 108 W, 108 X, 108 Y, 108 Z 1000 BAYVIEW AVENUE, SUITE 100 OAKLAND, CA 94612 (415) 774-2000 WWW.TCGIENGINEERS.COM</div></div></div><div><div><b>WENOCO B. OZON</b> PRESIDENT</div><div><b>PATRICK NICHOLAS P. DAVID</b> PRESIDENT</div><div><div><b>Hilmar's Construction Corporation</b> 1635 E. Rodriguez St., Avenue, Caguas, Puerto Rico 00981 (787) 841-1111 WWW.HILMARSCORP.COM</div><div><div><b>FILIPINAS DRAVO CORPORATION</b> Architectural &amp; Engineering Consultants 1000 BAYVIEW AVENUE, SUITE 100 OAKLAND, CA 94612 (415) 774-2000 WWW.FILIPINASDRAVO.COM</div><div><div><b>BANDAR HEBAT BUILDERS, INC.</b> 1000 BAYVIEW AVENUE, SUITE 100 OAKLAND, CA 94612 (415) 774-2000 WWW.BHBI.COM</div><div><div><b>TCGI ENGINEERS</b> 818 P. JAMES BOUL. 108 A, 108 B, 108 C, 108 D, 108 E, 108 F, 108 G, 108 H, 108 I, 108 J, 108 K, 108 L, 108 M, 108 N, 108 O, 108 P, 108 Q, 108 R, 108 S, 108 T, 108 U, 108 V, 108 W, 108 X, 108 Y, 108 Z 1000 BAYVIEW AVENUE, SUITE 100 OAKLAND, CA 94612 (415) 774-2000 WWW.TCGIENGINEERS.COM</div></div></div><div><div><b>WENOCO B. OZON</b> PRESIDENT</div><div><b>PATRICK NICHOLAS P. DAVID</b> PRESIDENT</div><div><div><b>Hilmar's Construction Corporation</b> 1635 E. Rodriguez St., Avenue, Caguas, Puerto Rico 00981 (787) 841-1111 WWW.HILMARSCORP.COM</div><div><div></div></div></div></div></div></div></div></div></div></div></div></div></div></div></div></div></div></div></div></div></div></div></div></div></div></div></div></div></div></div></div></div></div></div></div></div></div></div></div></div></div></div></div></div></div></div></div></div></div></div></div></div></div></div></div>							

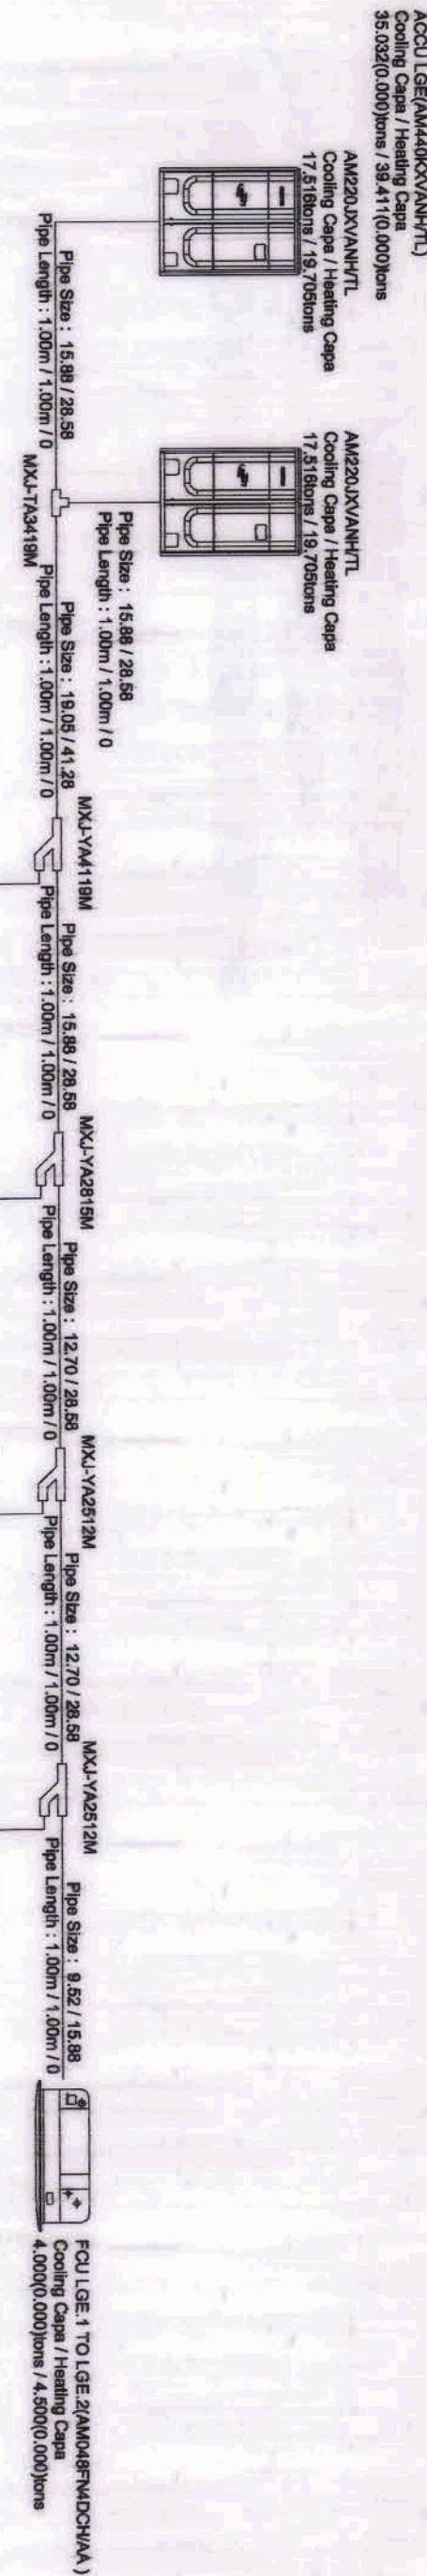

## LOWER GROUND FLOOR REFRIGERANT PIPING DIAGRAM (ACCU-LGE)

NOT TO SCALE

ACCU-LGE (M6-02) UNIT  
Cooling Capacity: 15.000 kW  
Heating Capacity: 15.000 kW  
Piping Length: 15.000 m

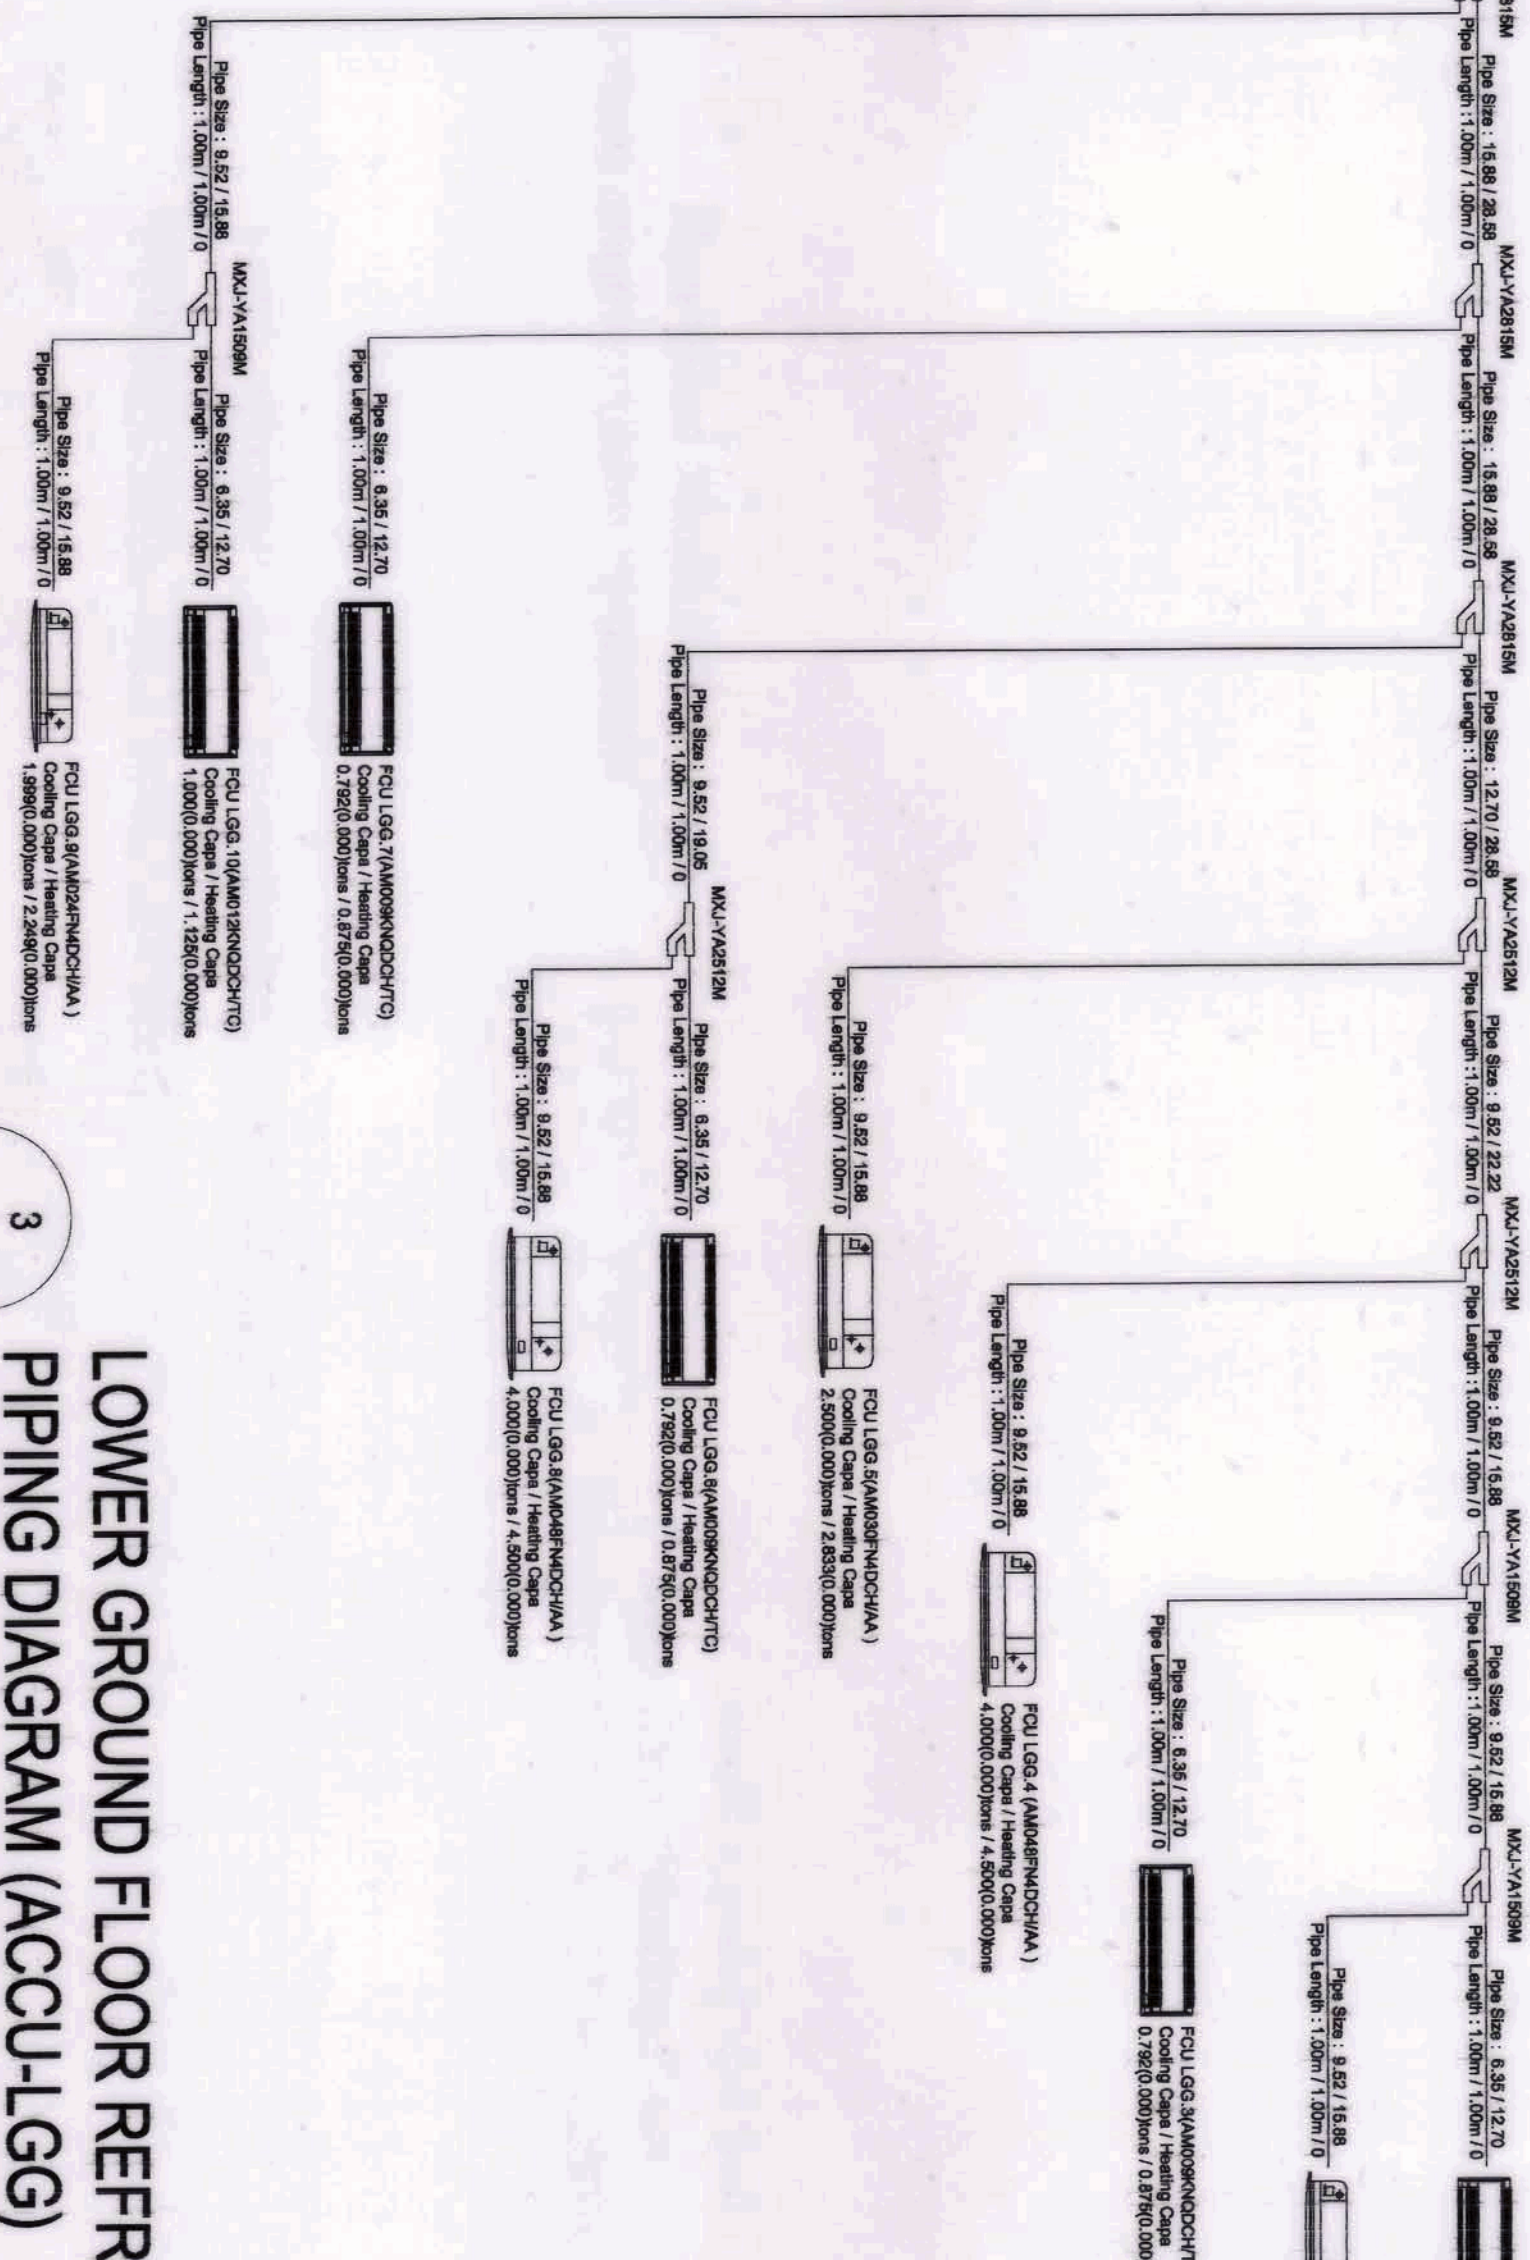


## LOWER GROUND FLOOR REFRIGERANT PIPING DIAGRAM (ACCU-LGG)

NOT TO SCALE

M6-02


M6-02

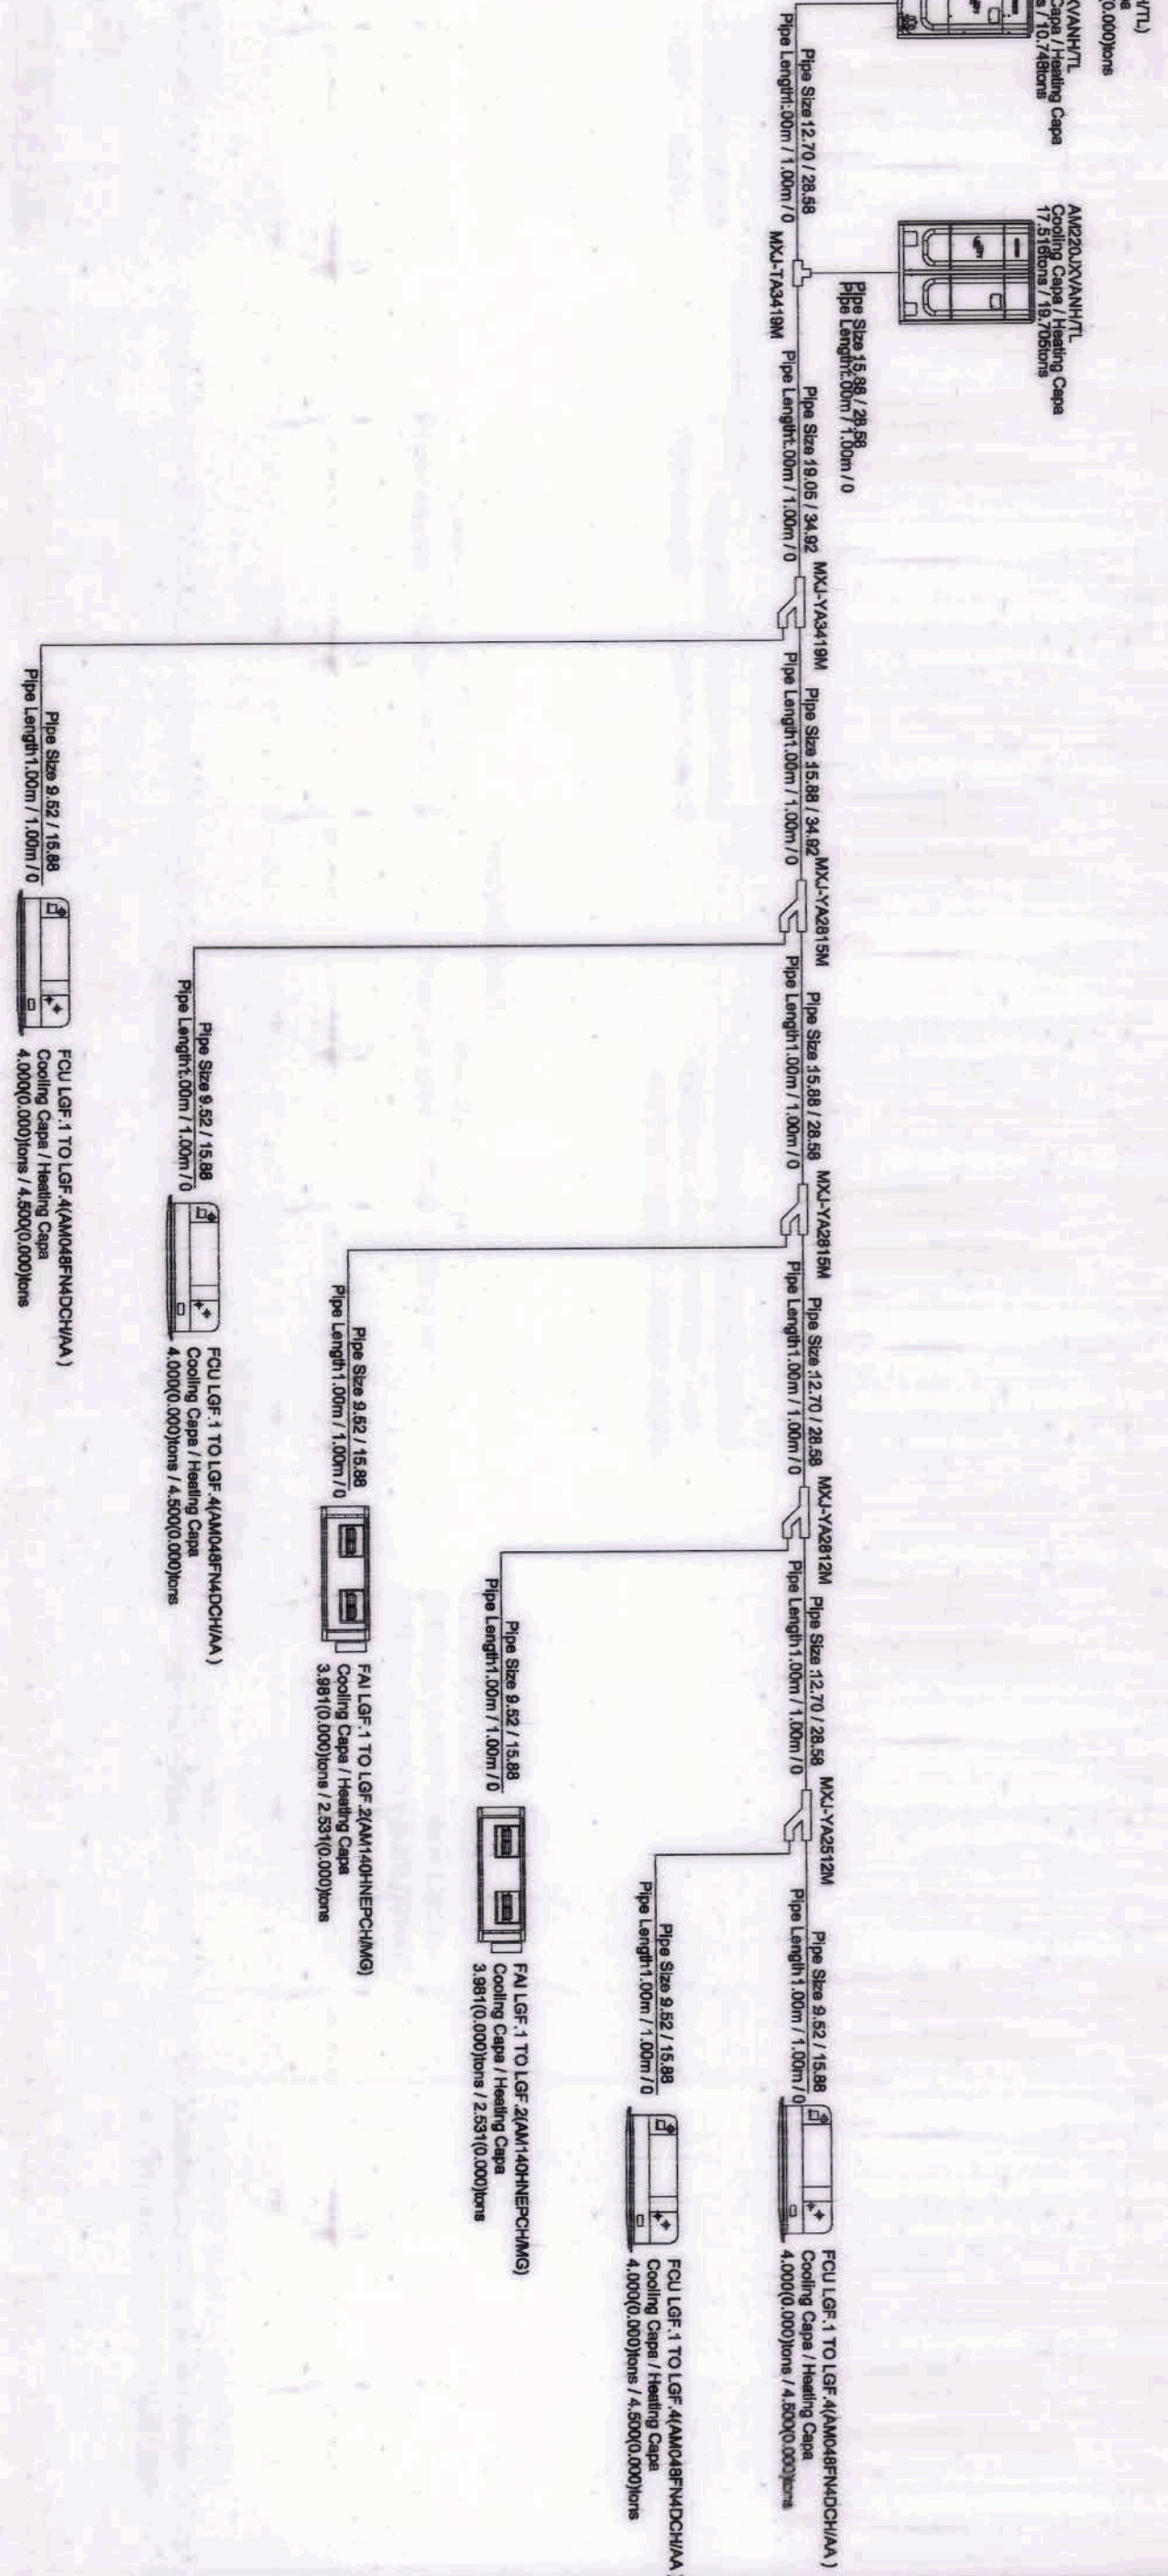

## LOWER GROUND FLOOR REFRIGERANT PIPING DIAGRAM (ACCU-LGF)

NOT TO SCALE


M6-02

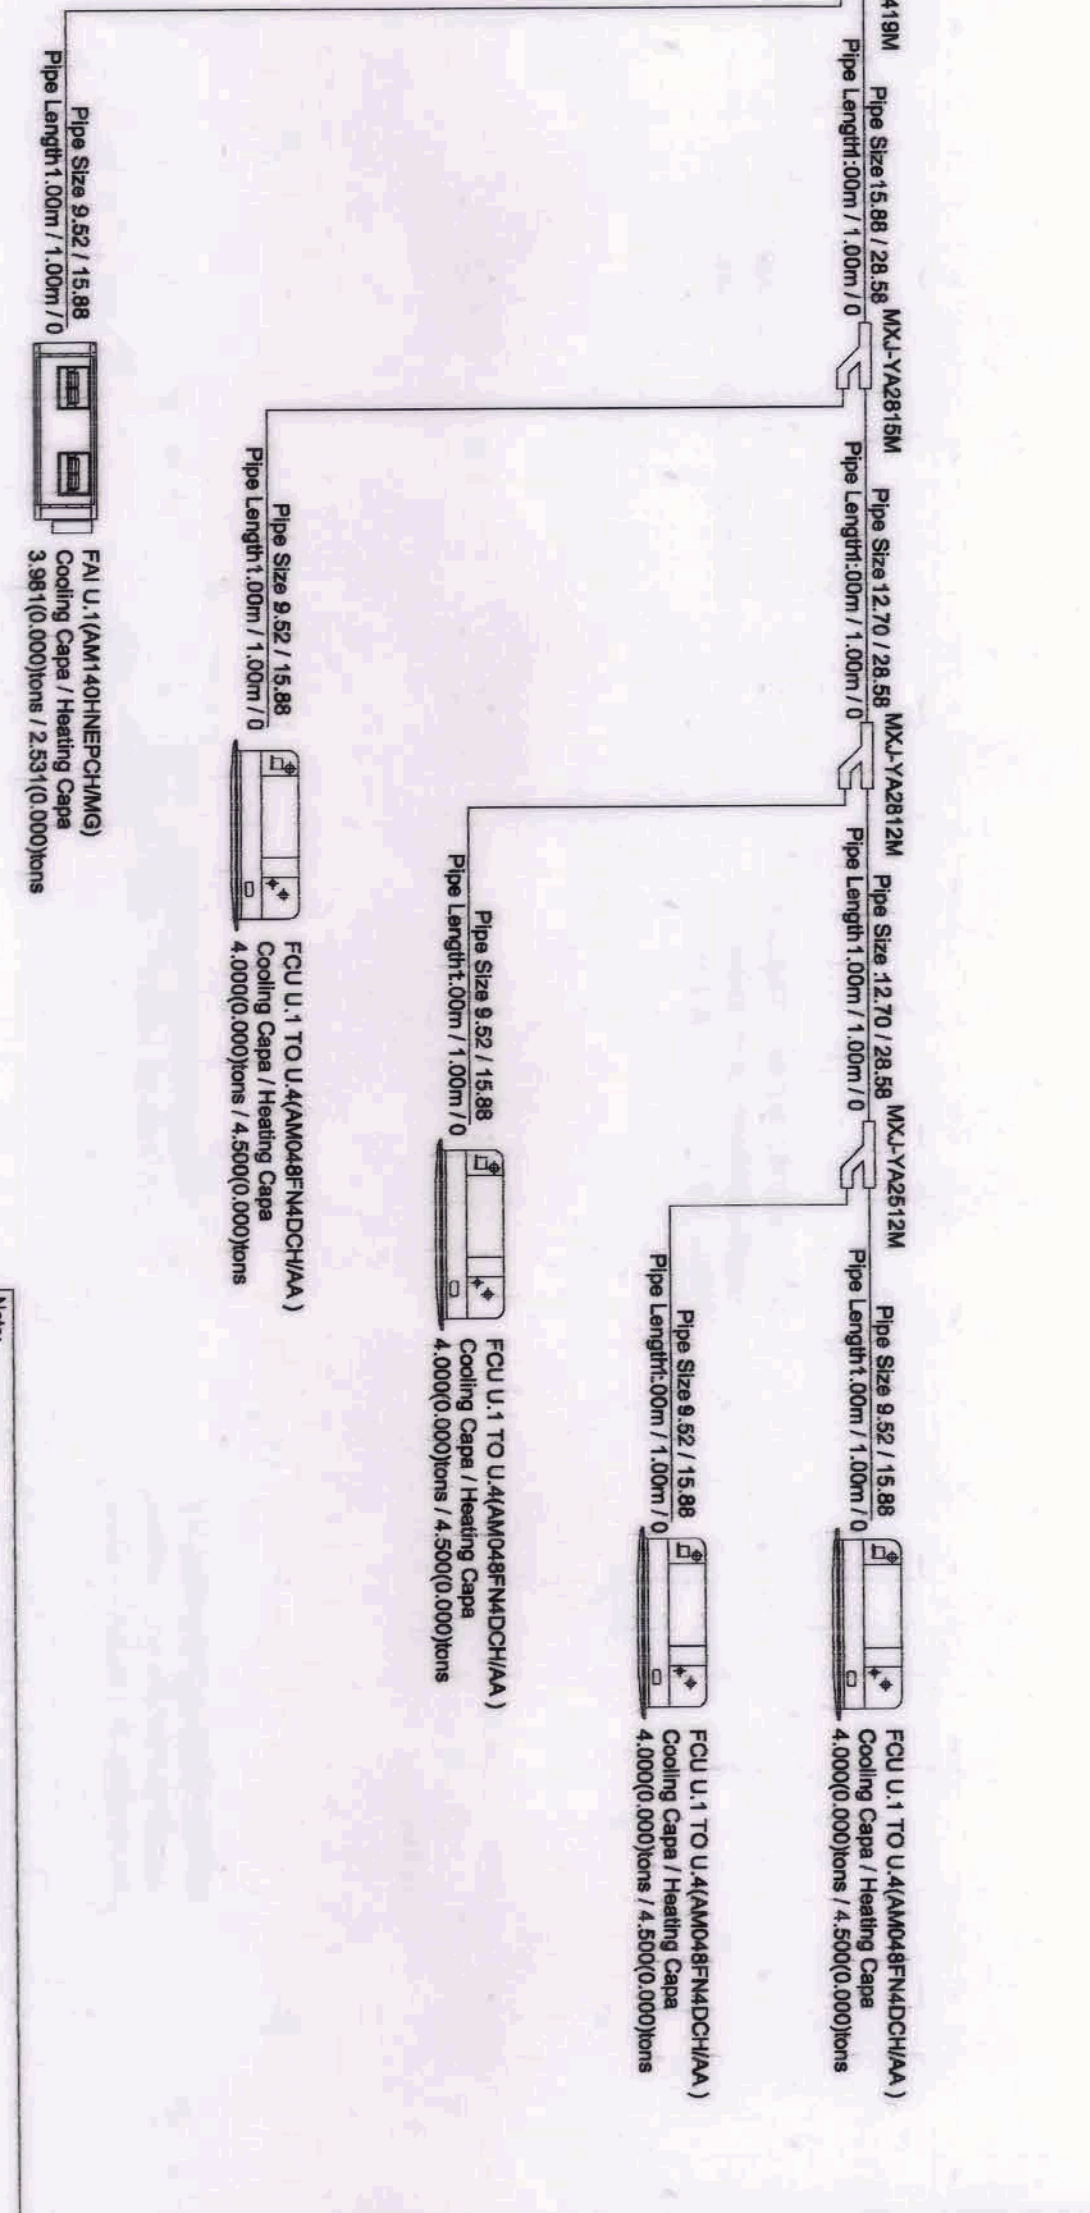

## LOWER GROUND FLOOR REFRIGERANT PIPING DIAGRAM (ACCU-LU)

NOT TO SCALE

M6-02

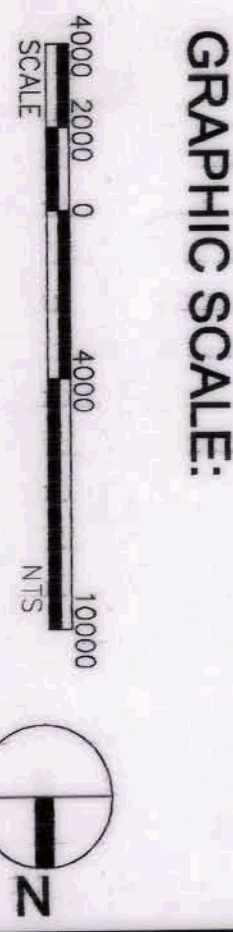

Note:  
Pursuant to Section 4 of Annex 'A' of the Revised Implementing Rules and Regulations of RA 9166, approval of electrical engineering drawings shall be the responsibility of the approving official. The Design Consultant shall be held liable responsible for the failure of the infrastructure due to faulty design except for the changes made without the conformity of the Design Consultant.

OWNER: NGAC PHASE 1 JV COMPANY

PREPARED BY:

REVIEWED AND VALIDATED BY:

SUBMITTED BY:

CERTIFIED BY: INDEPENDENT CONSULTANT

PROJECT TITLE:

SHEET NO.:

BCDA  
BAYAN LEPONAT  
CITY DEVELOPMENT AUTHORITY

MTC  
Metro Transit Corporation

Hillnart's Construction Corporation  
1635 E. Rodriguez St., Avenue Cebu, Quezon City  
- JESUS V. HERRERA  
PROJECT MANAGER

FILIPINAS DRAVO CORPORATION  
Architectural & Engineering Consultants  
1000 P. O. Box 1000, P. O. Box 1000, P. O. Box 1000  
- ARMANDO B. BERTILLO  
PROJECT MANAGER

BANDAR HEBAT BUILDERS, INC.  
- ISMAEL DAVID  
PRESIDENT


TCGI ENGINEERS  
1000 P. O. Box 1000, P. O. Box 1000, P. O. Box 1000  
- VIRGILIO A. MADRADO  
PRESIDENT/CEO

AS-BUILT DRAWING


LOWER GROUND REFRIGERANT PIPING SCHEMATIC DIAGRAM

M6-02

ACCU UGI(AM050FXMDEH/EU)  
Cooling Capa / Heating Capa  
3.981(0.000)tons / 4.550(0.000)tons

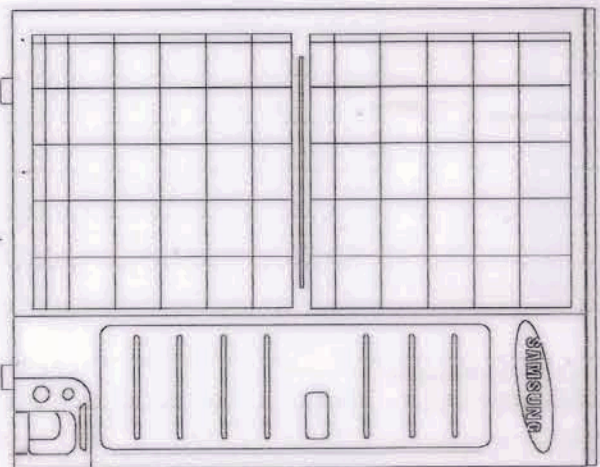


Pipe Size : 9.52 / 15.88  
Pipe Length : 1.00m / 1.00m / 0

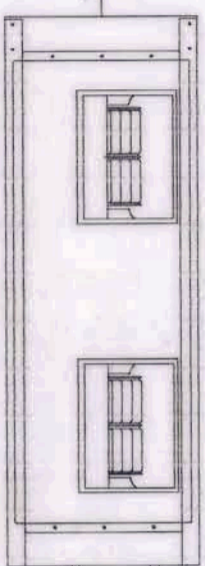


FAI UGI(AM140HNEPCH/MG)  
Cooling Capa / Heating Capa  
3.981(0.000)tons / 2.531(0.000)tons

ACCU UGI(1AM200JXVANH/TL)  
Cooling Capa / Heating Capa  
56.00(0.00)kW / 63.00(0.00)kW

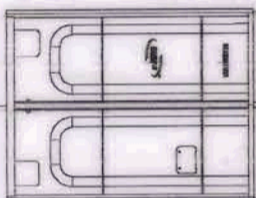


Pipe Size : 15.88 / 28.58  
Pipe Length : 1.00m / 1.00m / 0

MXJ-YA2815M  
Pipe Size : 9.52 / 15.88  
Pipe Length : 1.00m / 1.00m / 0

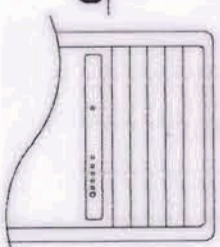


FCU SHP(AM140JNPDKH/TR)  
Cooling Capa / Heating Capa  
14.00(0.00)kW / 16.00(0.00)kW

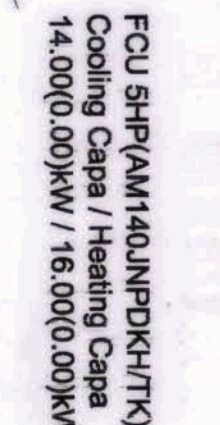


Pipe Size : 12.70 / 28.58  
Pipe Length : 1.00m / 1.00m / 0

MXJ-YA2812M  
Pipe Size : 9.52 / 15.88  
Pipe Length : 1.00m / 1.00m / 0

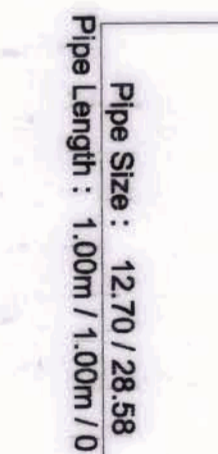


FCU SHP(AM140JNPDKH/TR)  
Cooling Capa / Heating Capa  
14.00(0.00)kW / 16.00(0.00)kW

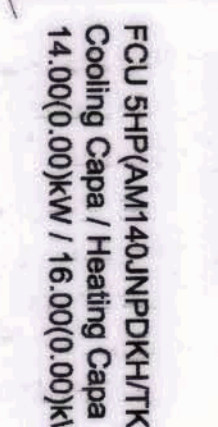


Pipe Size : 9.52 / 22.22  
Pipe Length : 1.00m / 1.00m / 0

MXJ-YA2512M  
Pipe Size : 9.52 / 15.88  
Pipe Length : 1.00m / 1.00m / 0

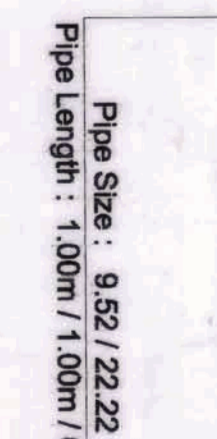


FCU SHP(AM140JNPDKH/TR)  
Cooling Capa / Heating Capa  
14.00(0.00)kW / 16.00(0.00)kW

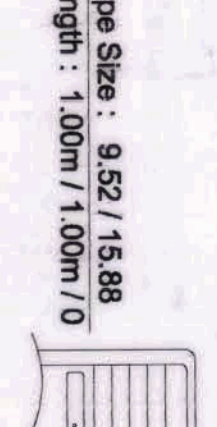

Pipe Size : 9.52 / 15.88  
Pipe Length : 1.00m / 1.00m / 0


FCU SHP(AM140JNPDKH/TR)  
Cooling Capa / Heating Capa  
14.00(0.00)kW / 16.00(0.00)kW

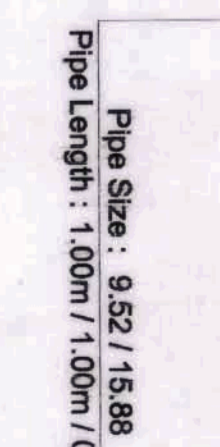


UPPER GROUND FLOOR REFRIGERANT  
PIPING DIAGRAM (ACCU-UGI)

1  
M6-03 NOT TO SCALE

ACCU UGH(AM050FXMDEH/EU)  
Cooling Capa / Heating Capa  
3.981(0.000)tons / 4.550(0.000)tons

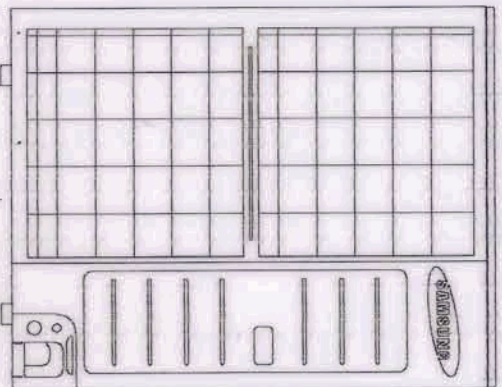


Pipe Size : 9.52 / 15.88  
Pipe Length : 1.00m / 1.00m / 0

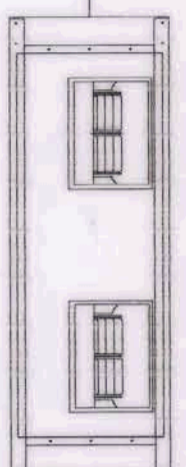


FAI UGH(AM140HNEPCH/MG)  
Cooling Capa / Heating Capa  
3.981(0.000)tons / 2.531(0.000)tons

ACCU UGH(1AM160JXVANH/TL)  
Cooling Capa / Heating Capa  
45.00(0.00)kW / 50.40(0.00)kW

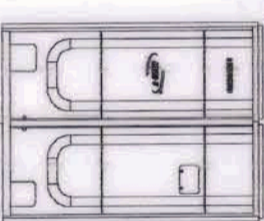


Pipe Size : 12.70 / 28.58  
Pipe Length : 1.00m / 1.00m / 0

MXJ-YA2812M  
Pipe Size : 9.52 / 15.88  
Pipe Length : 1.00m / 1.00m / 0

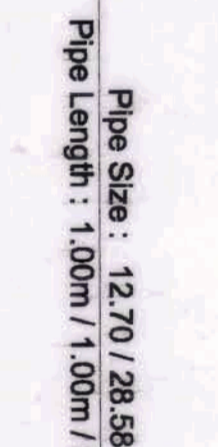


FCU SHP(AM140JNPDKH/TR)  
Cooling Capa / Heating Capa  
14.00(0.00)kW / 16.00(0.00)kW

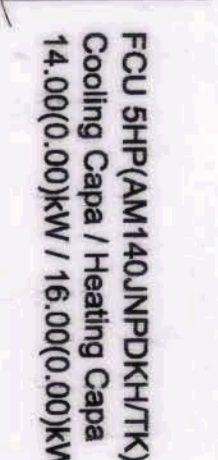


Pipe Size : 9.52 / 22.22  
Pipe Length : 1.00m / 1.00m / 0


MXJ-YA2512M  
Pipe Size : 9.52 / 15.88  
Pipe Length : 1.00m / 1.00m / 0

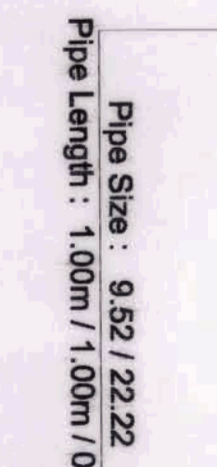

FCU SHP(AM140JNPDKH/TR)  
Cooling Capa / Heating Capa  
14.00(0.00)kW / 16.00(0.00)kW

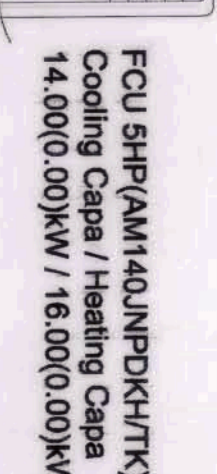

Pipe Size : 9.52 / 15.88  
Pipe Length : 1.00m / 1.00m / 0

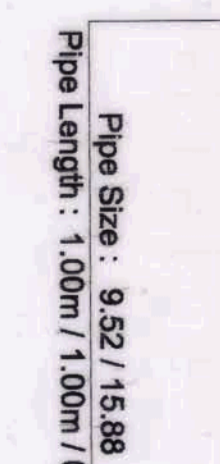

FCU SHP(AM140JNPDKH/TR)  
Cooling Capa / Heating Capa  
14.00(0.00)kW / 16.00(0.00)kW

UPPER GROUND FLOOR REFRIGERANT  
PIPING DIAGRAM (ACCU-UGH)

3  
M6-03 NOT TO SCALE

UPPER GROUND FLOOR REFRIGERANT  
PIPING DIAGRAM (ACCU-UGH.1)

4  
M6-03 NOT TO SCALE

GRAPHIC SCALE:



OWNER: NGAC PHASE 1 JV COMPANY

PREPARED BY:

REVIEWED AND VALIDATED BY:

SUBMITTED BY:

CERTIFIED BY: INDEPENDENT CONSULTANT

PROJECT TITLE:

SHEET CONTENTS:

SHEET NO.

BCDA  
AND  
WENGO B. DIZON  
PRESIDENT

MD CONSULTING  
PATRICK NICHOLAS P. DAVID  
PRESIDENT

Hillman's Construction Corporation  
1639 E. Rodriguez St., Avenue Cebu, Quezon City  
JESUS V. HERBAS  
PROJECT MANAGER

FILIPINAS DRAVO CORPORATION  
Architectural & Engineering Consultants  
1501 E. Rodriguez St., Avenue Cebu, Quezon City  
ALFREDO B. REYLLA  
PROJECT MANAGER

BANDAR HERBAT BUILDERS, INC.  
ISMAC S. DAVID  
PRESIDENT


TCGI ENGINEERS  
VIRGIL O. A. MADRADO  
PRESIDENT / CEO

AS-BUILT DRAWING  
NGAC PHASE 1A  
AQUATIC CENTER  
NEW CLARK CITY, CAPAS, TARLAC

UPPER GROUND REFRIGERANT  
PIPING SCHEMATIC DIAGRAM


M6-03

ACCU P.1,P.2,P.3,P.4&P.5(AM060HXMDBC/TC)  
Cooling Capa / Heating Capa  
4.550(0.000)tons

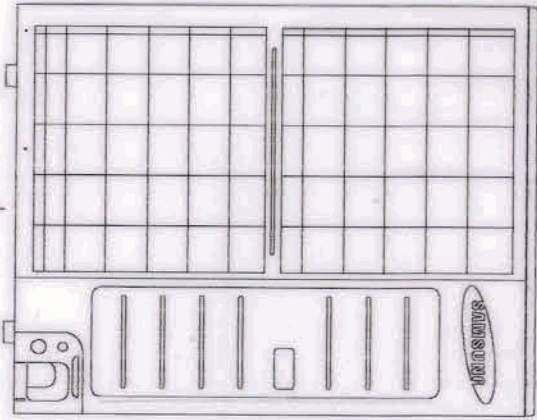

Pipe Size : 9.52 / 19.05  
Pipe Length : 1.00m / 1.00m / 0


FCU P.1 TO P.5(AM048FNHDCH/AA)  
Cooling Capa / Heating Capa  
4.000(0.000)tons / 4.500(0.000)tons

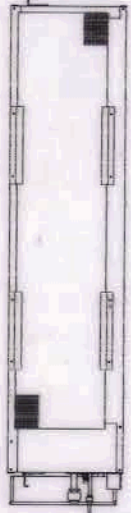

PRESIDENTIAL SUITE FLOOR REFRIGERANT  
PIPING DIAGRAM (ACCU-P.1,P.2,P.3,P.4&P.5)

1  
M6-04 NOT TO SCALE

ACCU P.6(AM060HXMDBC/TC)  
Cooling Capa / Heating Capa  
4.550(0.000)tons

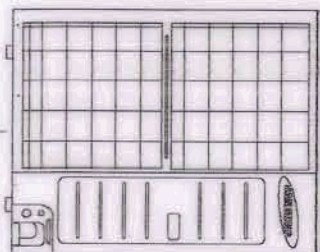


Pipe Size : 9.52 / 19.05  
Pipe Length : 1.00m / 1.00m / 0

MXJ-YA2512M

Pipe Size : 6.35 / 12.70  
Pipe Length : 1.00m / 1.00m / 0

FCU P.6 TO P.8(AM018FNMDCH/AA)  
Cooling Capa / Heating Capa  
1.500(0.000)tons / 1.667(0.000)tons

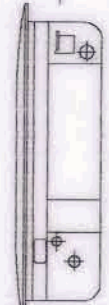


Pipe Size : 9.52 / 15.88  
Pipe Length : 1.00m / 1.00m / 0

MXJ-YA1509M

Pipe Size : 6.35 / 12.70  
Pipe Length : 1.00m / 1.00m / 0

FCU P.6 TO P.8(AM018FNMDCH/AA)  
Cooling Capa / Heating Capa  
1.500(0.000)tons / 1.667(0.000)tons

Pipe Size : 6.35 / 12.70  
Pipe Length : 1.00m / 1.00m / 0

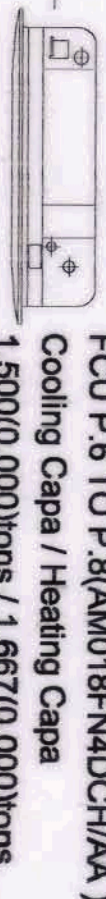

Pipe Size : 6.35 / 12.70  
Pipe Length : 1.00m / 1.00m / 0

FCU P.6 TO P.8(AM018FNMDCH/AA)  
Cooling Capa / Heating Capa  
1.500(0.000)tons / 1.667(0.000)tons




PRESIDENTIAL SUITE FLOOR REFRIGERANT  
PIPING DIAGRAM (ACCU-P.6)

2  
M6-04 NOT TO SCALE

Note:  
Pursuant to Section 4 of Annex "A" of the Revised Implementing Rules and Regulations of the Philippine Mechanical Code (RIRMC), the Design Consultant shall be held fully responsible for the safety of the facilities and ensure due to fully design except for the changes made without the conformity of the Design Consultants.

GRAPHIC SCALE:

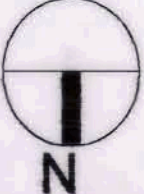

OWNER: NGAC PHASE I JV COMPANY

PREPARED BY:

REVIEWED AND VALIDATED BY:

SUBMITTED BY:

CERTIFIED BY: INDEPENDENT CONSULTANT

PROJECT TITLE:

SHEET CONTENTS:

SHEET NO.

BCDA

AND

AVENIO B. OZON  
PRESIDENT

Hilmarc's Construction Corporation

1635 E. Rodriguez St., Alameda, Cebu, Cebu City

AND  
PATRICK NICHOLAS P. DAMD  
PRESIDENT

FILIPINAS DRAYO CORPORATION

Architectural & Engineering Consultants  
1635 E. Rodriguez St., Alameda, Cebu, Cebu City  
Project Manager

BANDAR HEBAT BUILDERS, INC.

ISMAEL S. DAVID  
PRESIDENT

TCGI ENGINEERS

301 P. F. Plaza Bldg., 108 V.A. Bldg. St., Legaspi, Naga  
Bicol, Camarines Sur, 5400  
President/CEO

AS-BUILT DRAWING

NGAC PHASE 1A

AQUATIC CENTER














NEW CLARK CITY, CAPAS, TARLAC

PRESIDENTIAL SUITE





REFRIGERANT PIPING

SCHEMATIC DIAGRAM

M6-04

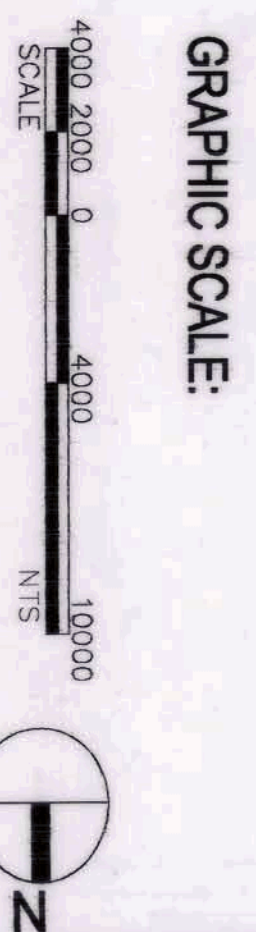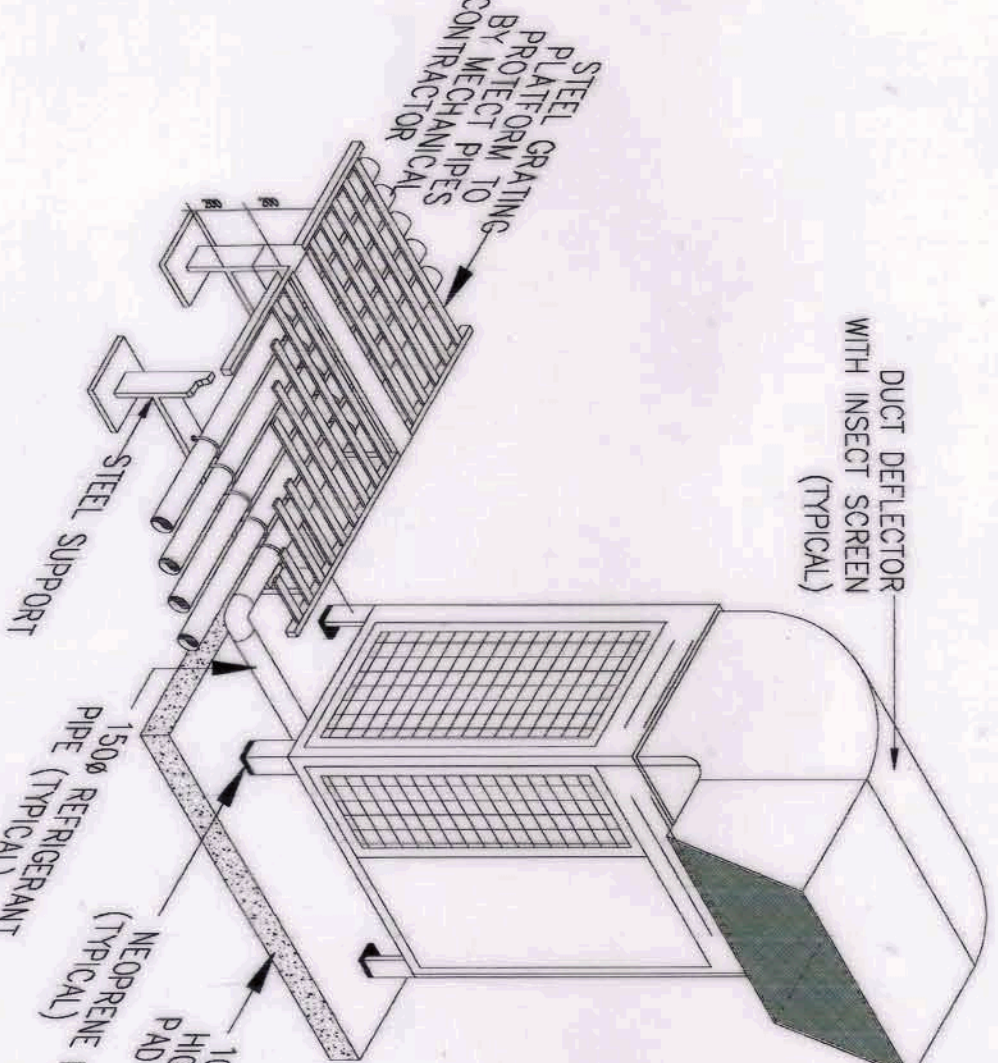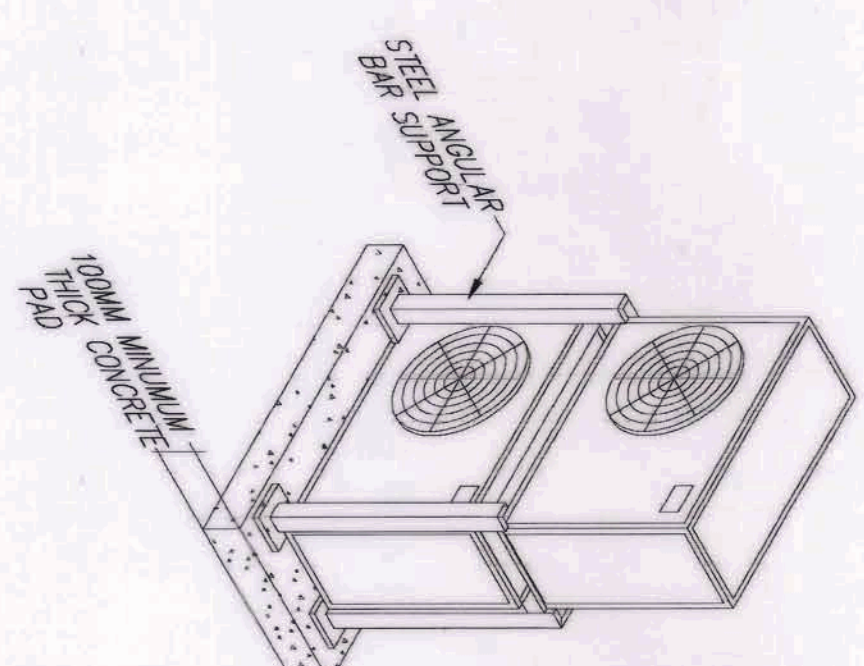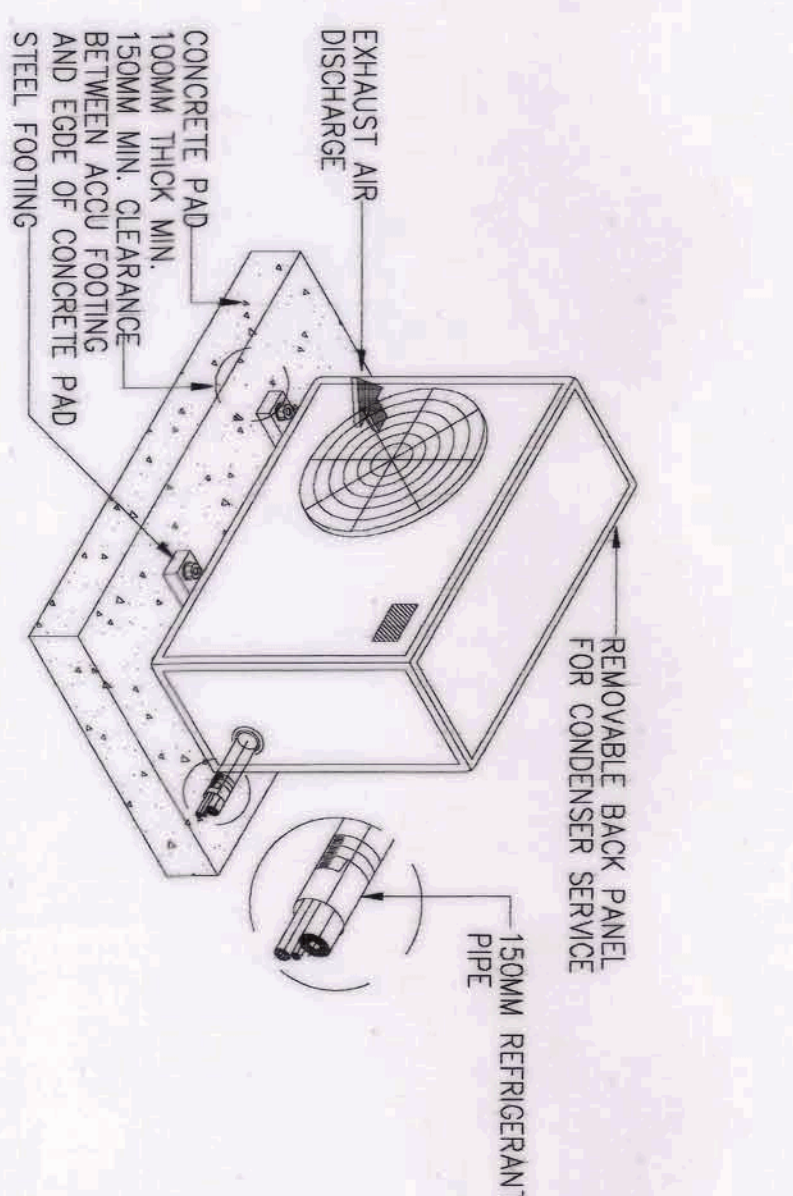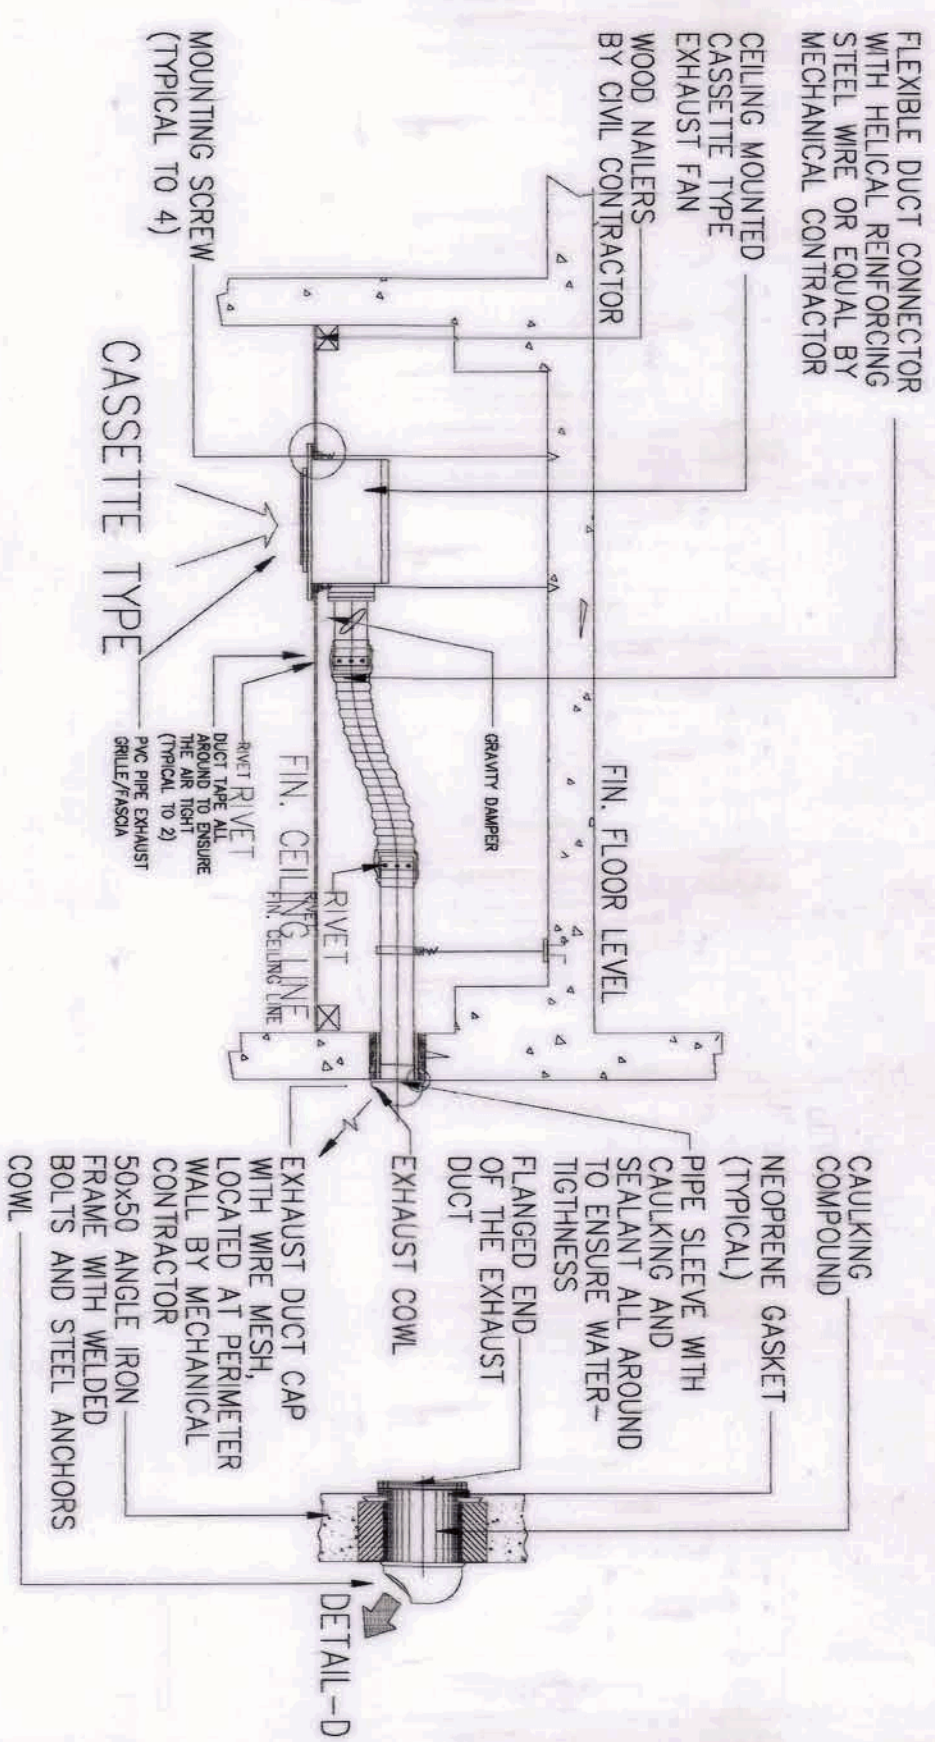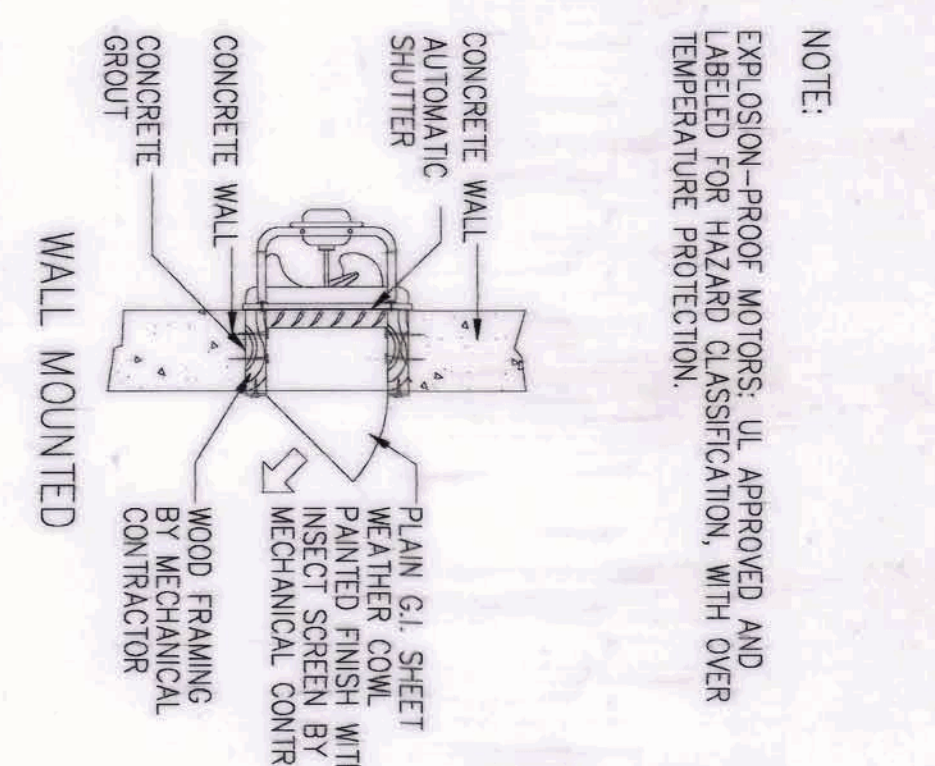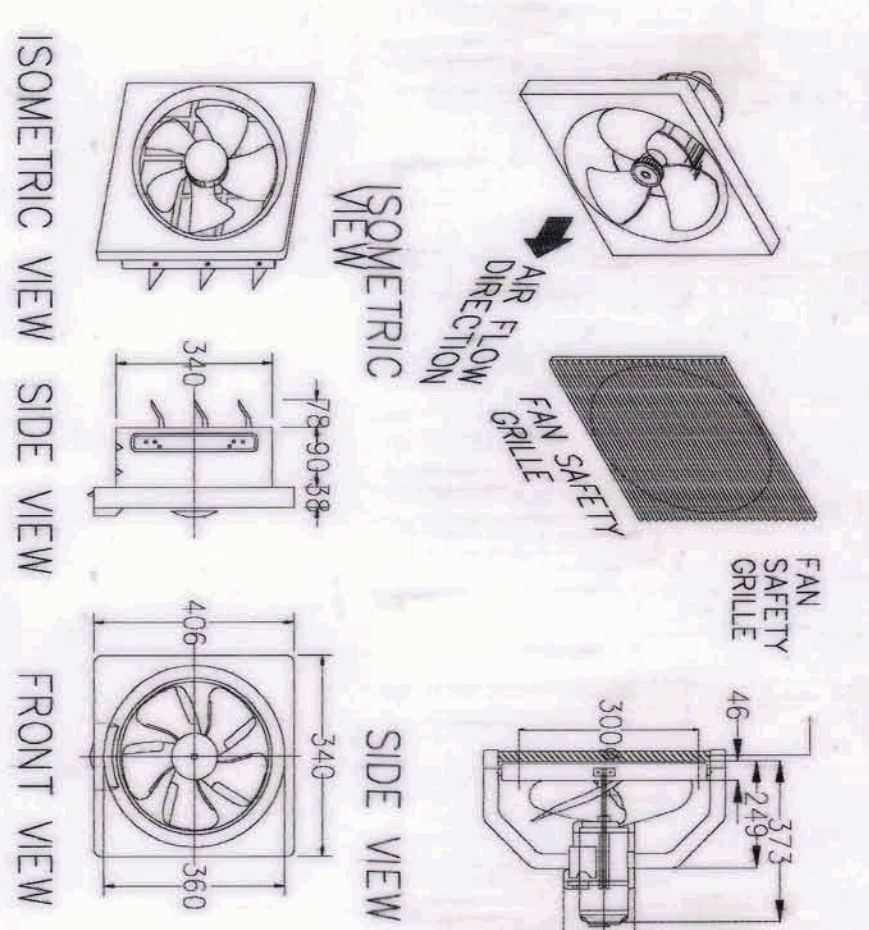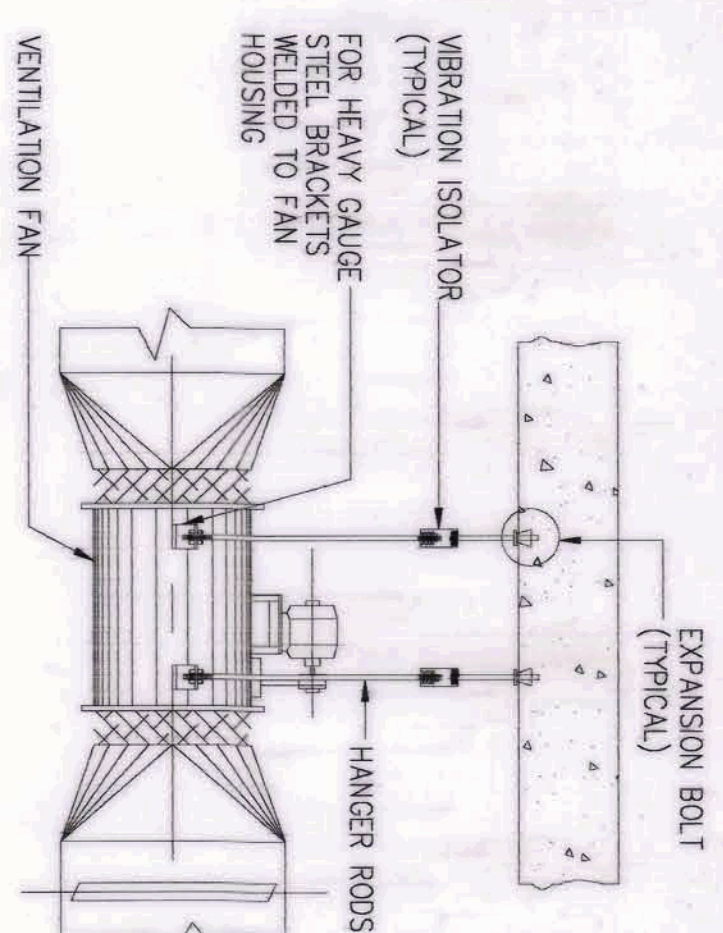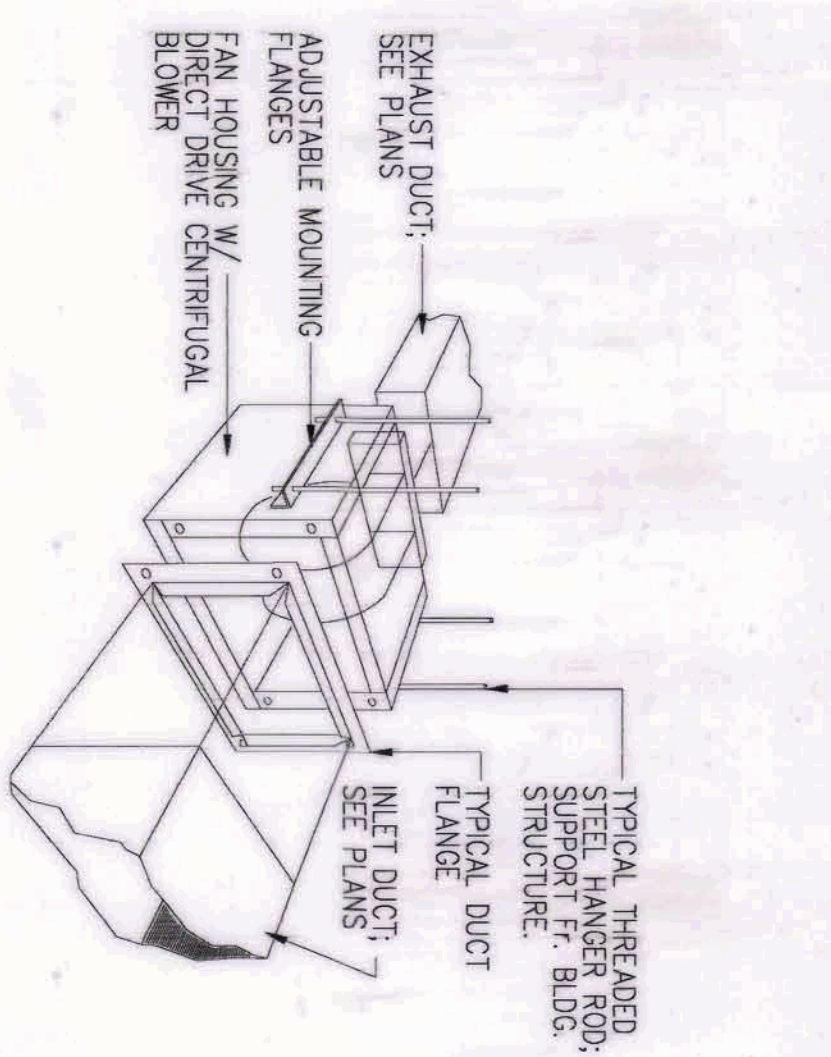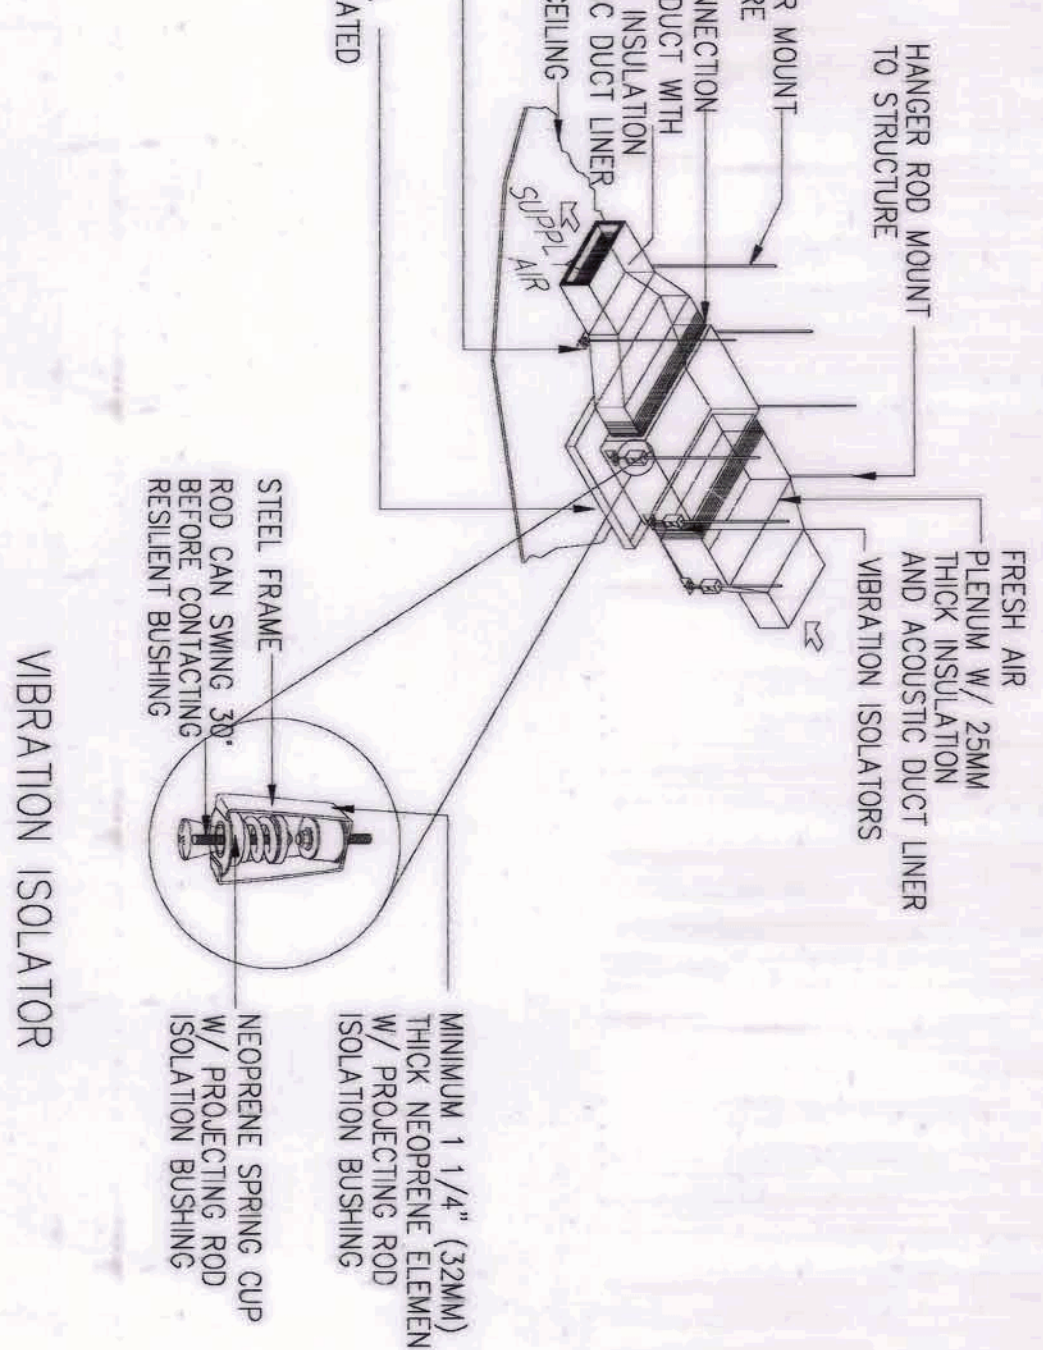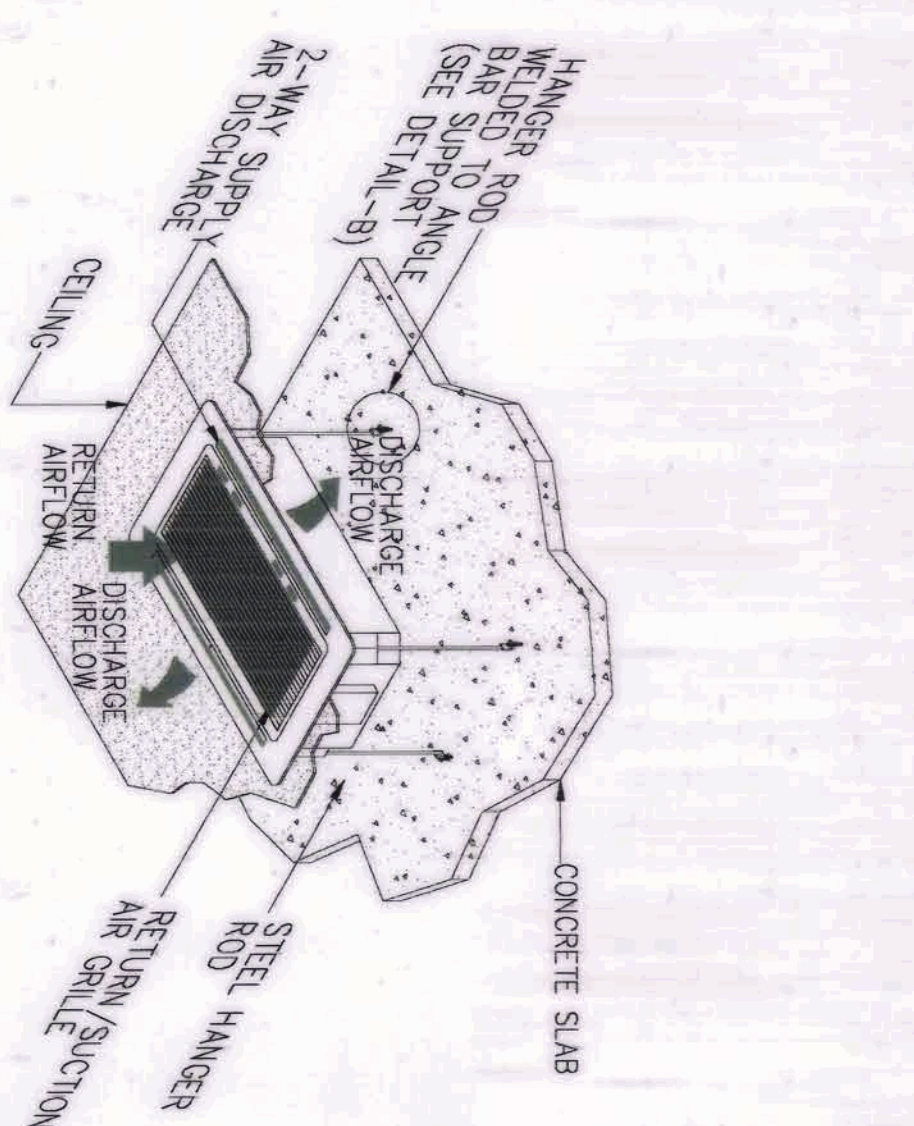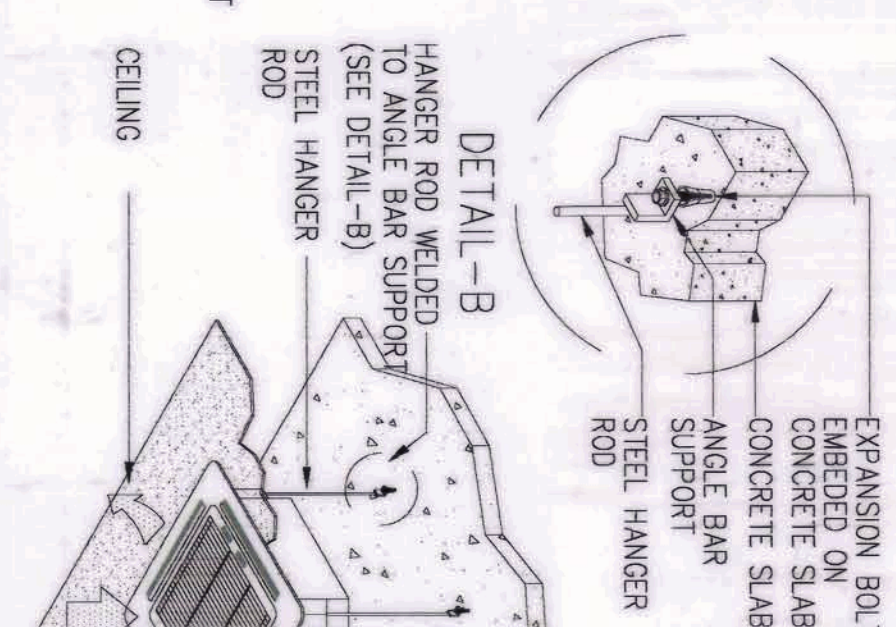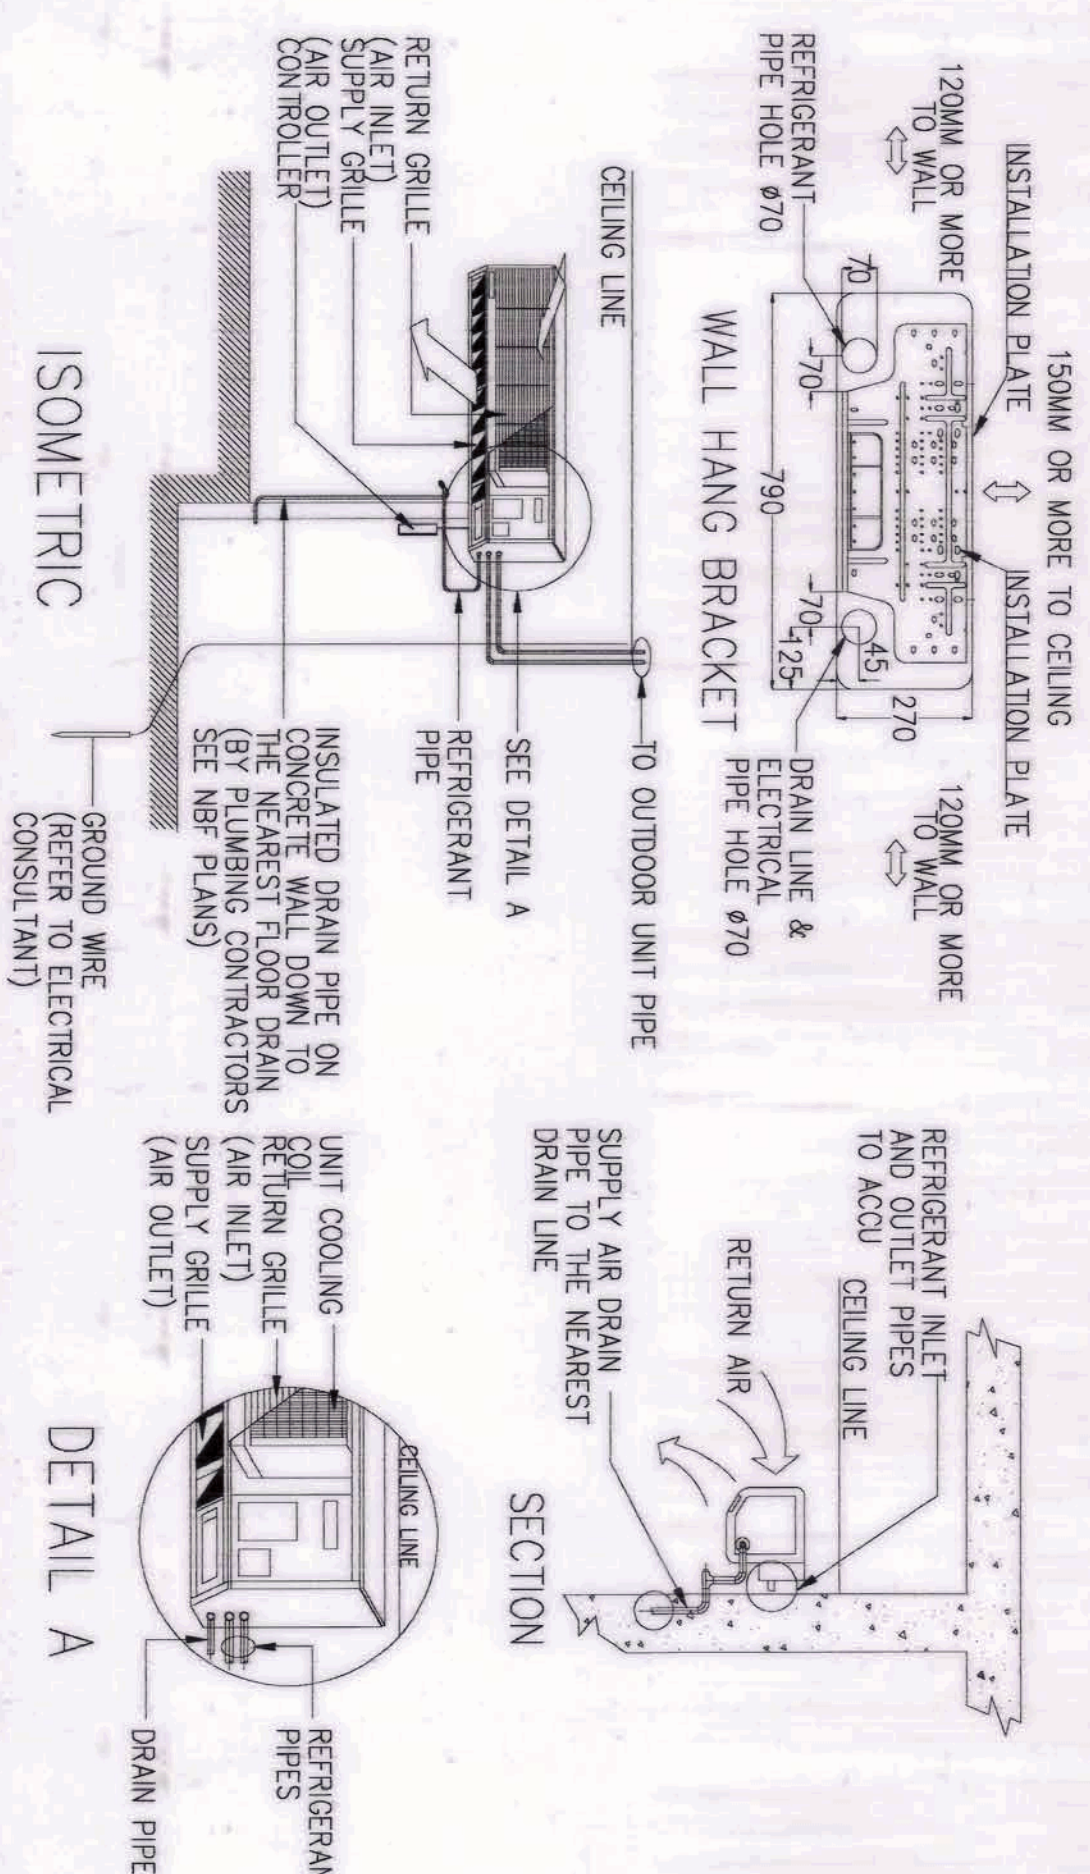

VERROLEC FLANGE AND CORNER SCHEDULE					
FLANGE SIZE	CORNER SIZE	DUCT SIZE	HANGER ROD	BOLT & NUT	
SYSTEM 20	SYSTEM 20	100 - 900	3/8" x (10mm)	5/16" x (10mm)	
SYSTEM 30	SYSTEM 30	950 - 2000	3/8" x (10mm)	3/8" x (10mm)	
SYSTEM 40	SYSTEM 40	2050 - UP	1/2" x (2mm)	1/2" x (2mm)	

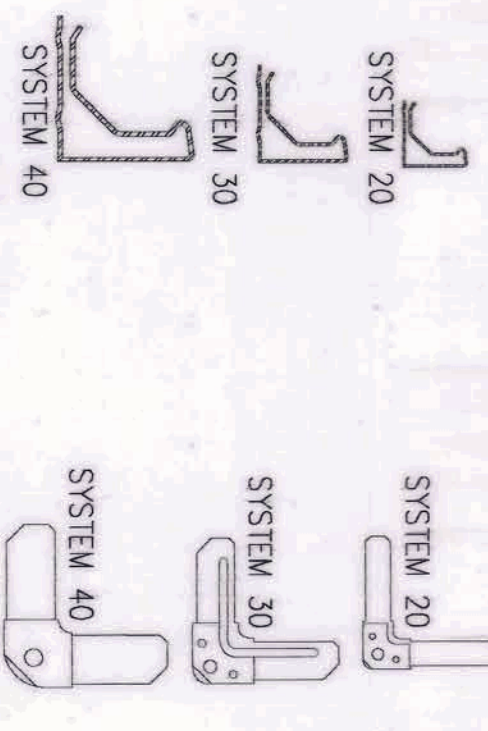
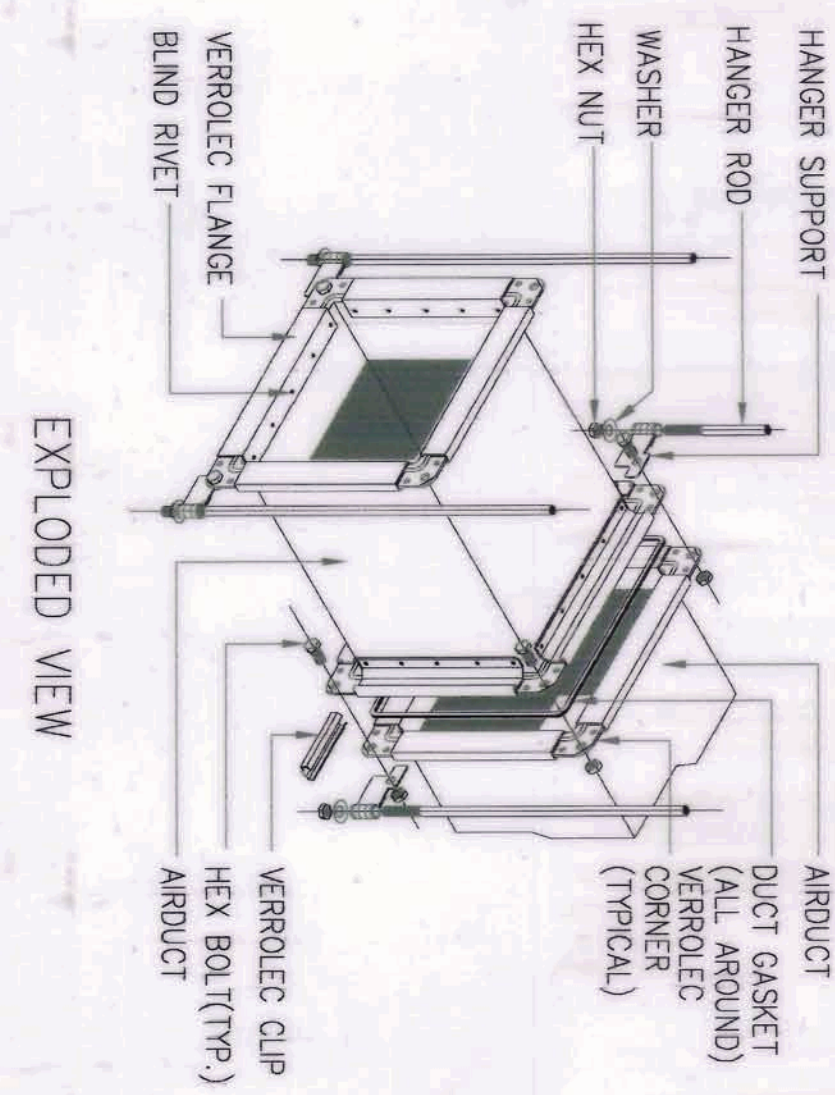
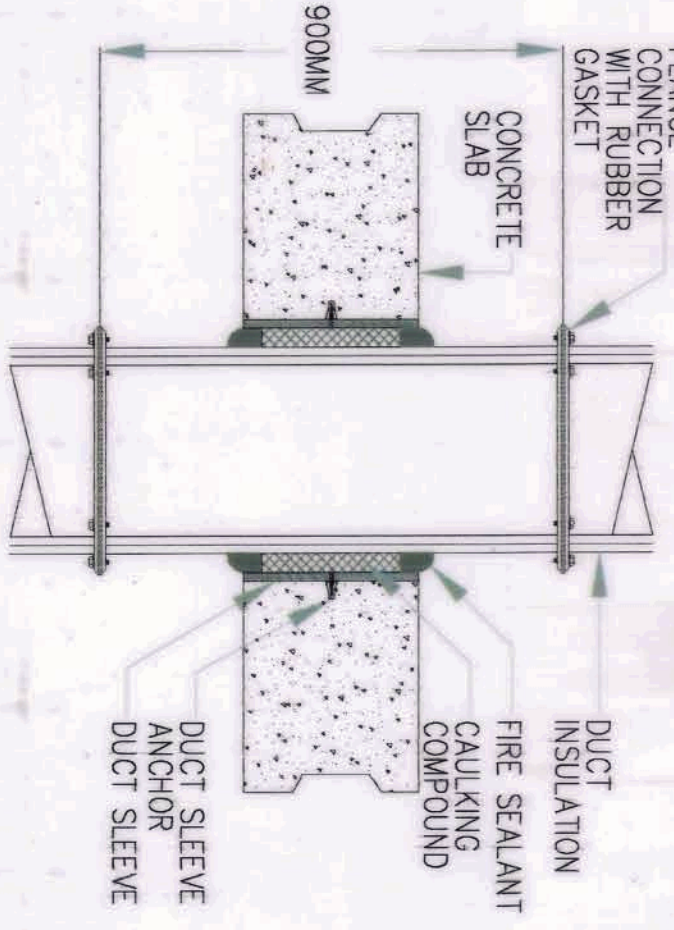
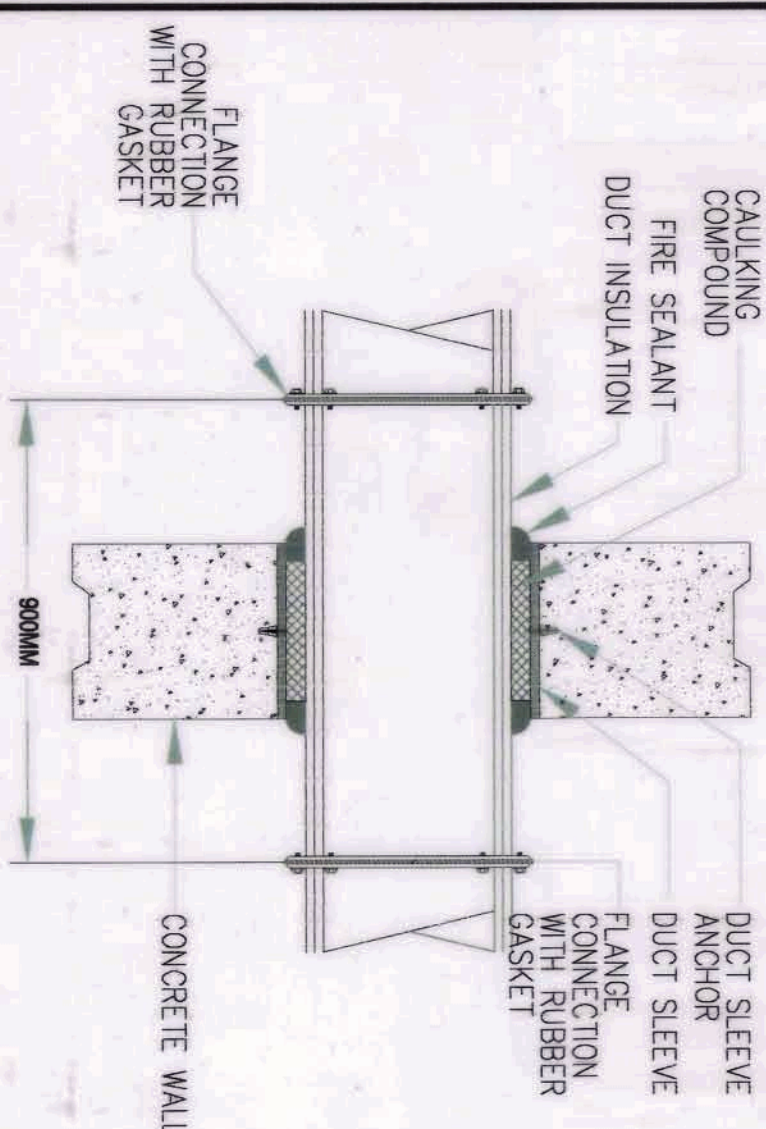


1 DUCT THRU WALL DETAIL  
NOT TO SCALE

2 DUCT THRU FLOOR DETAIL  
NOT TO SCALE

3 AIR DUCT ASSEMBLY DETAIL  
NOT TO SCALE

4 EXHAUST AIR GRILLE INSTALLATION DETAIL  
NOT TO SCALE

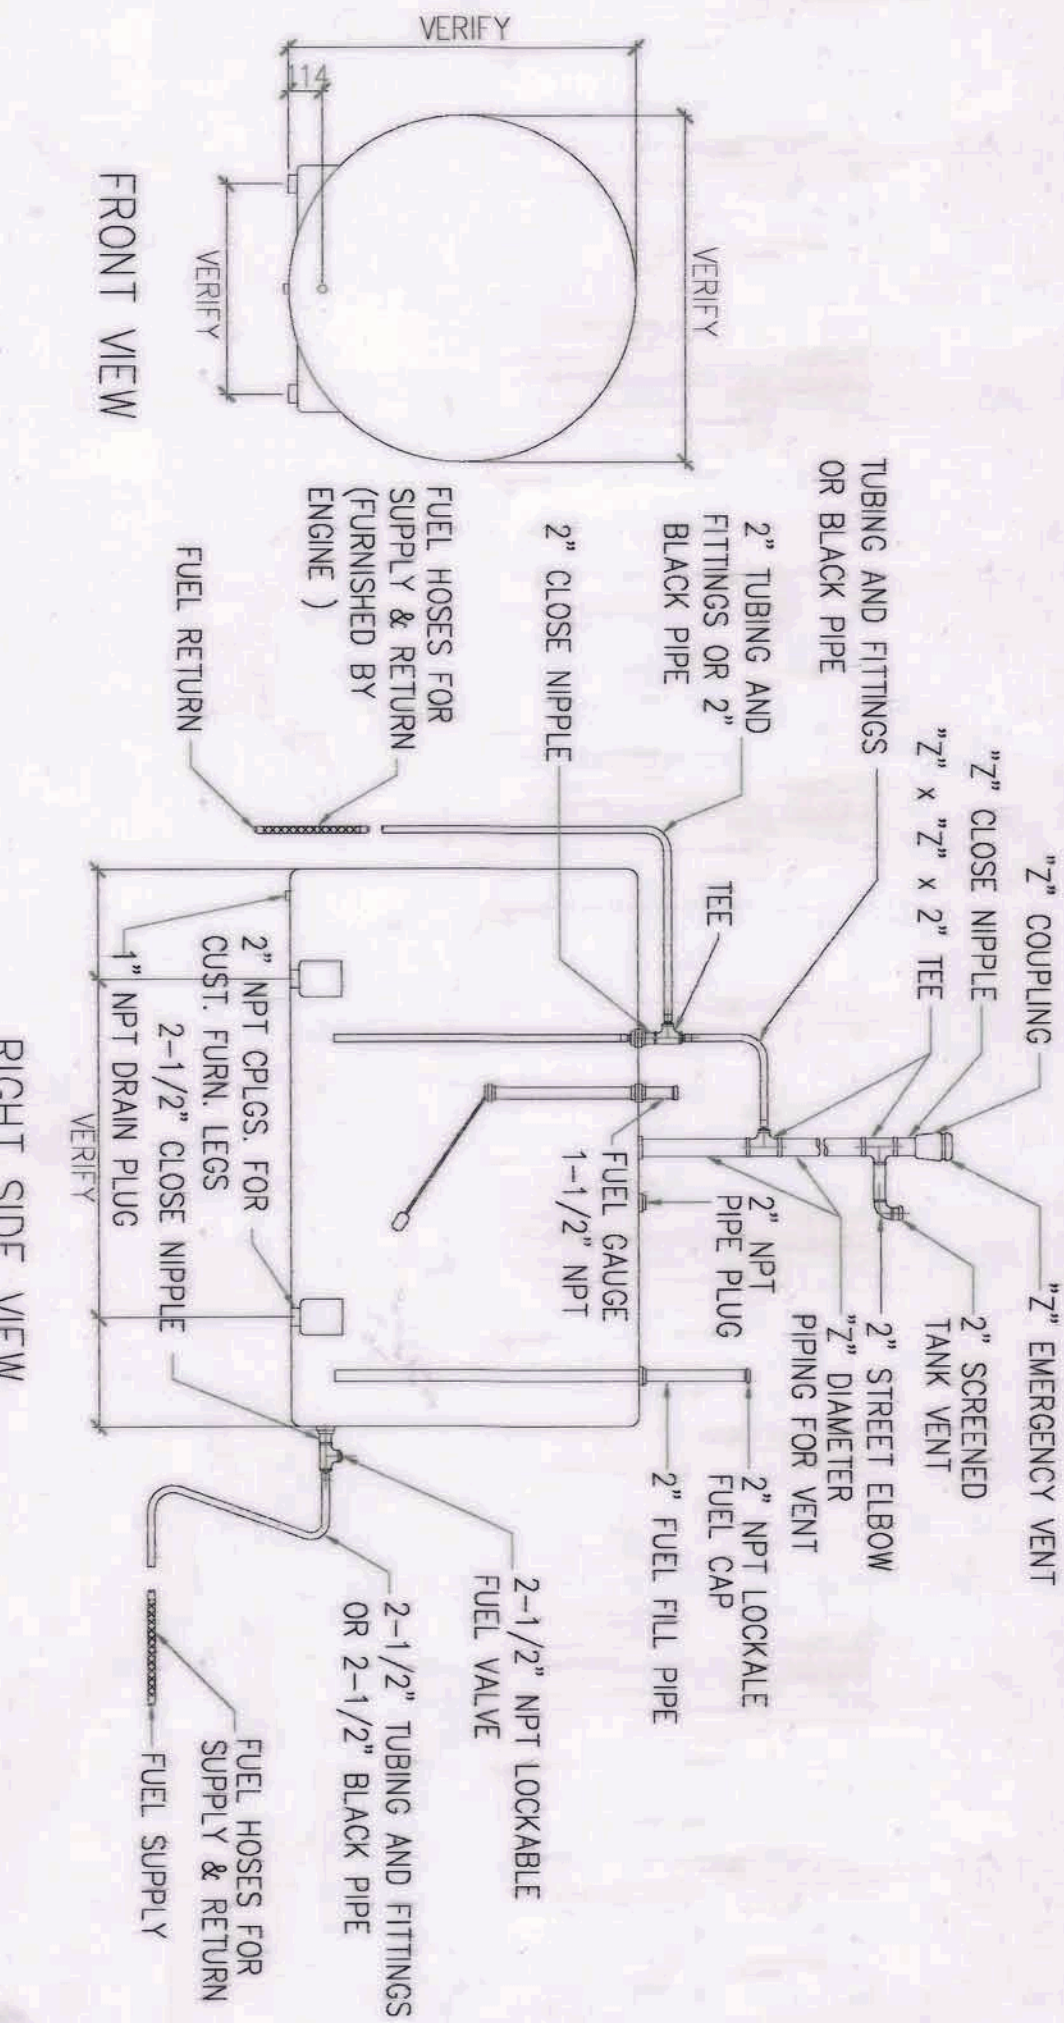
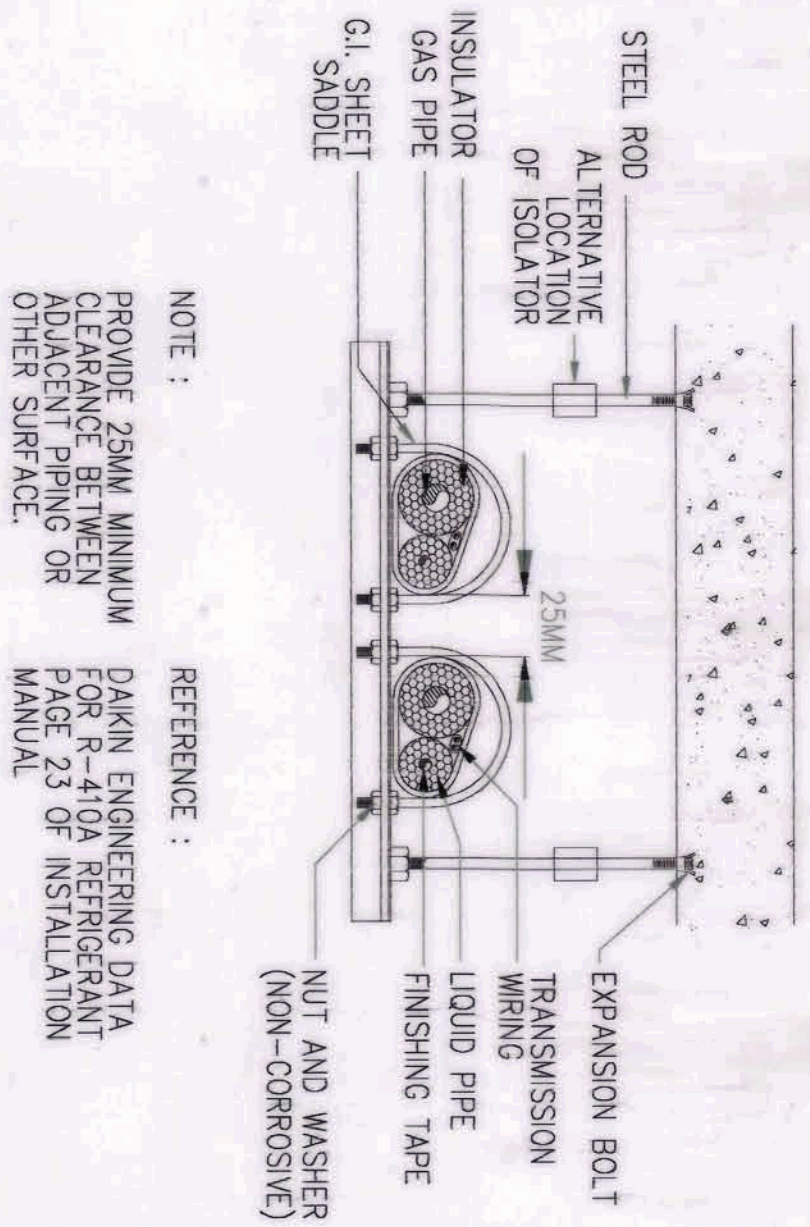
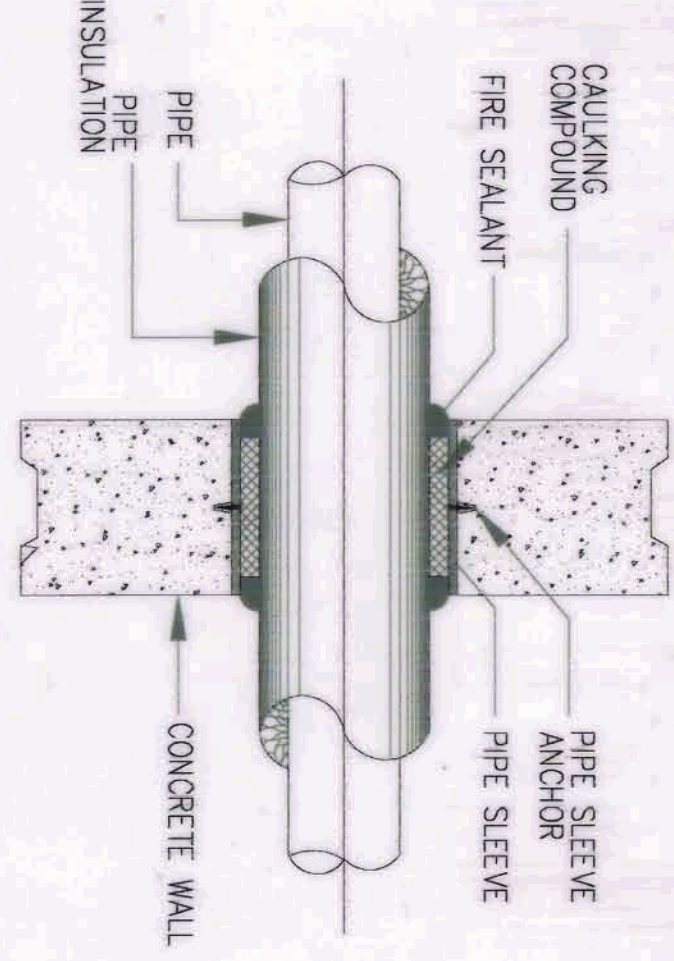
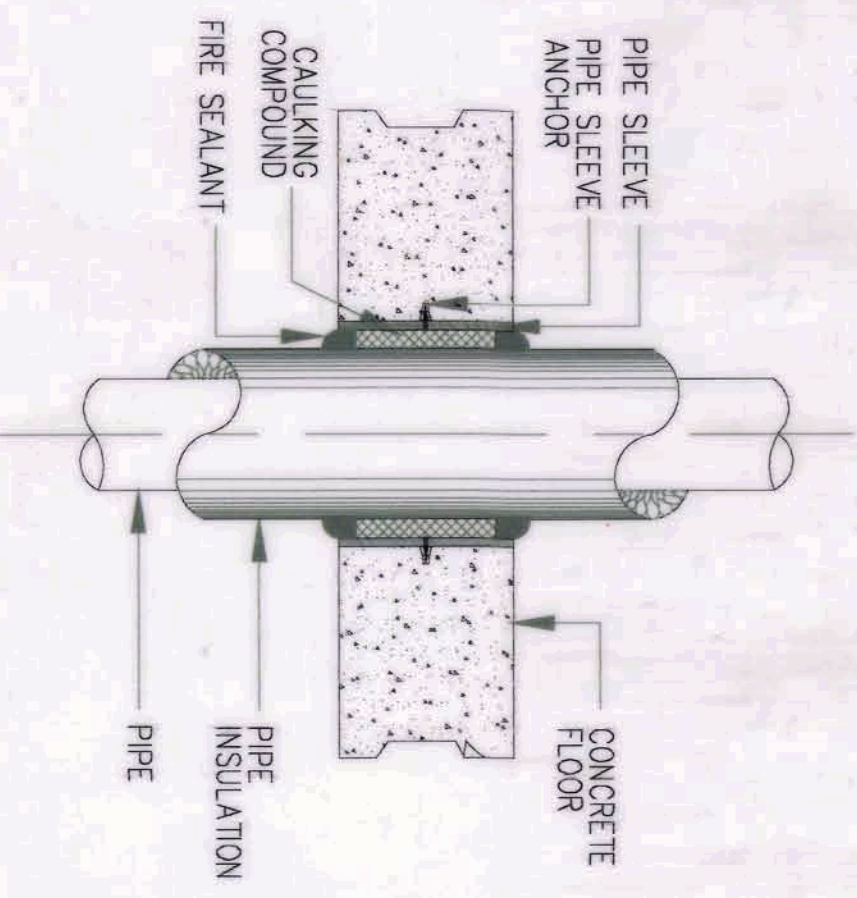


5 PIPE THRU ROOF DETAIL  
NOT TO SCALE

6 PIPE THRU WALL DETAIL  
NOT TO SCALE

7 REFRIGERANT PIPE HANGER DETAIL  
NOT TO SCALE

8 TYPICAL FUEL DAY TANK DETAIL  
NOT TO SCALE

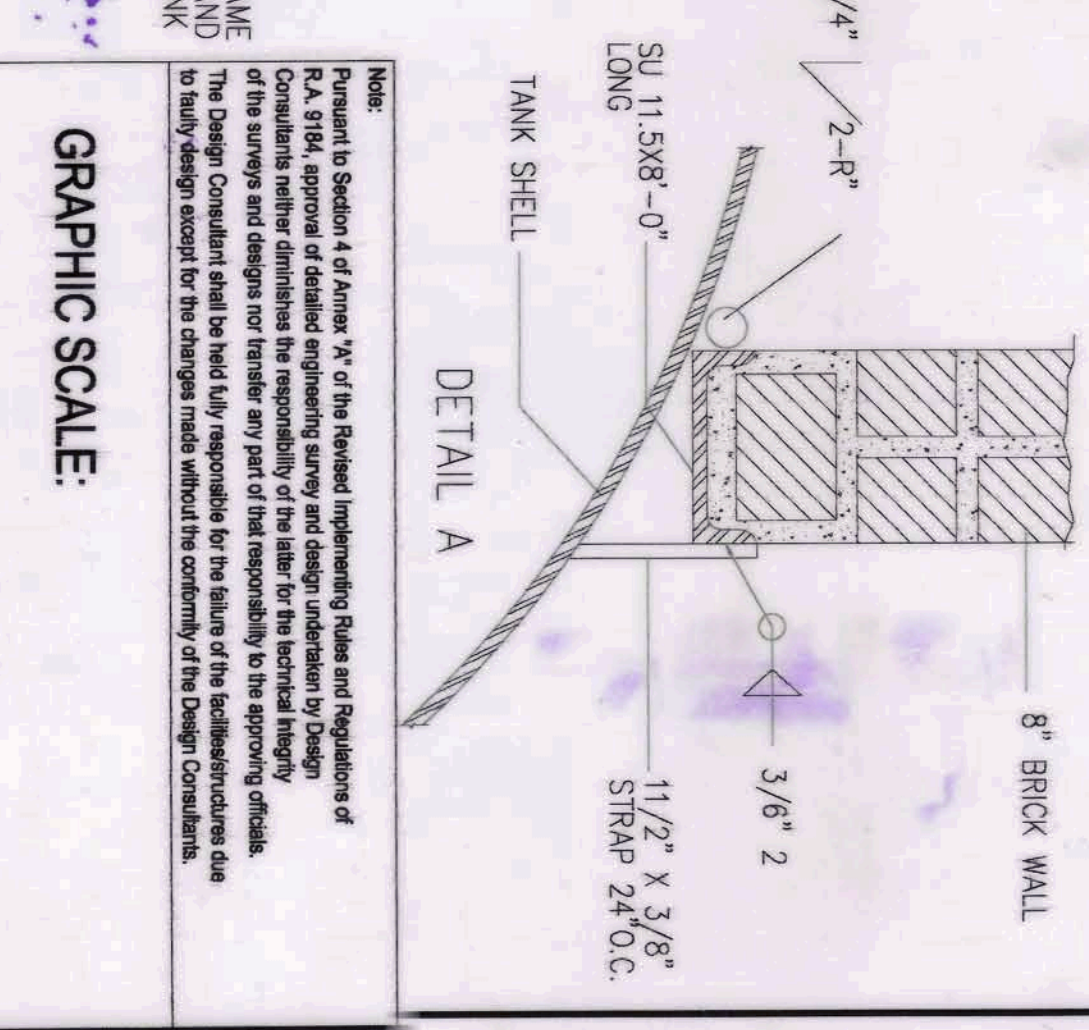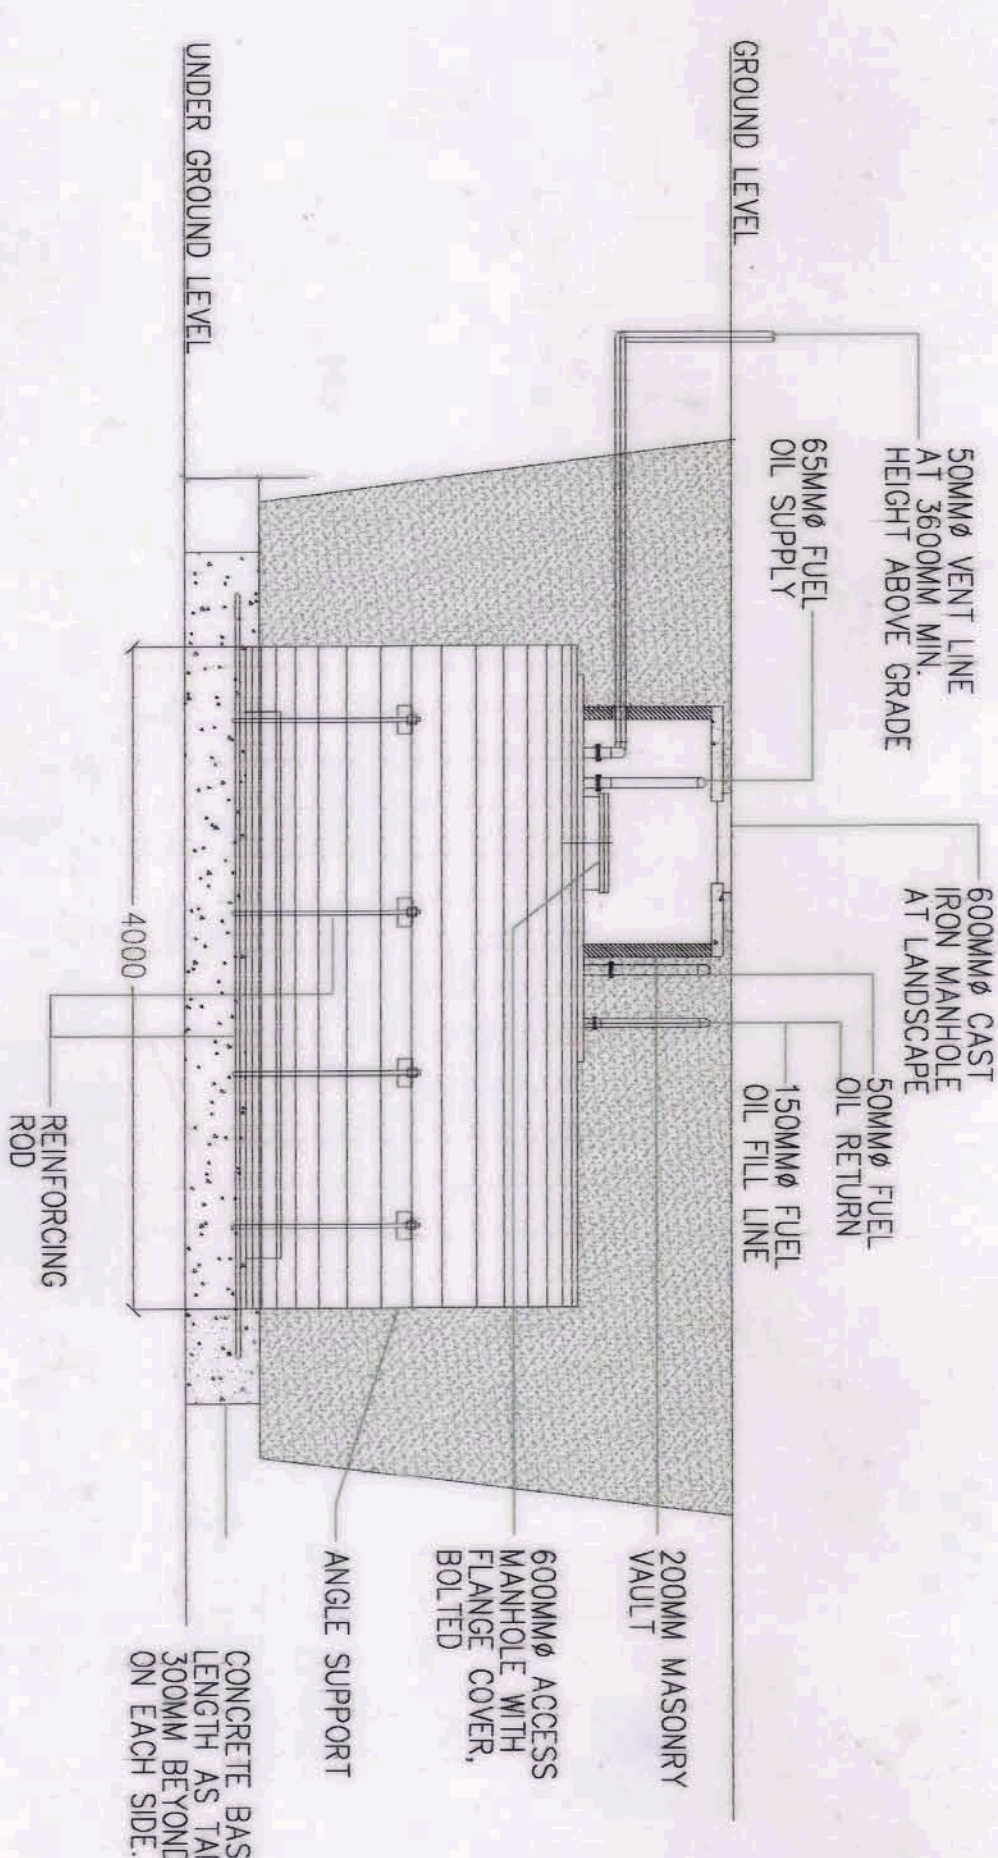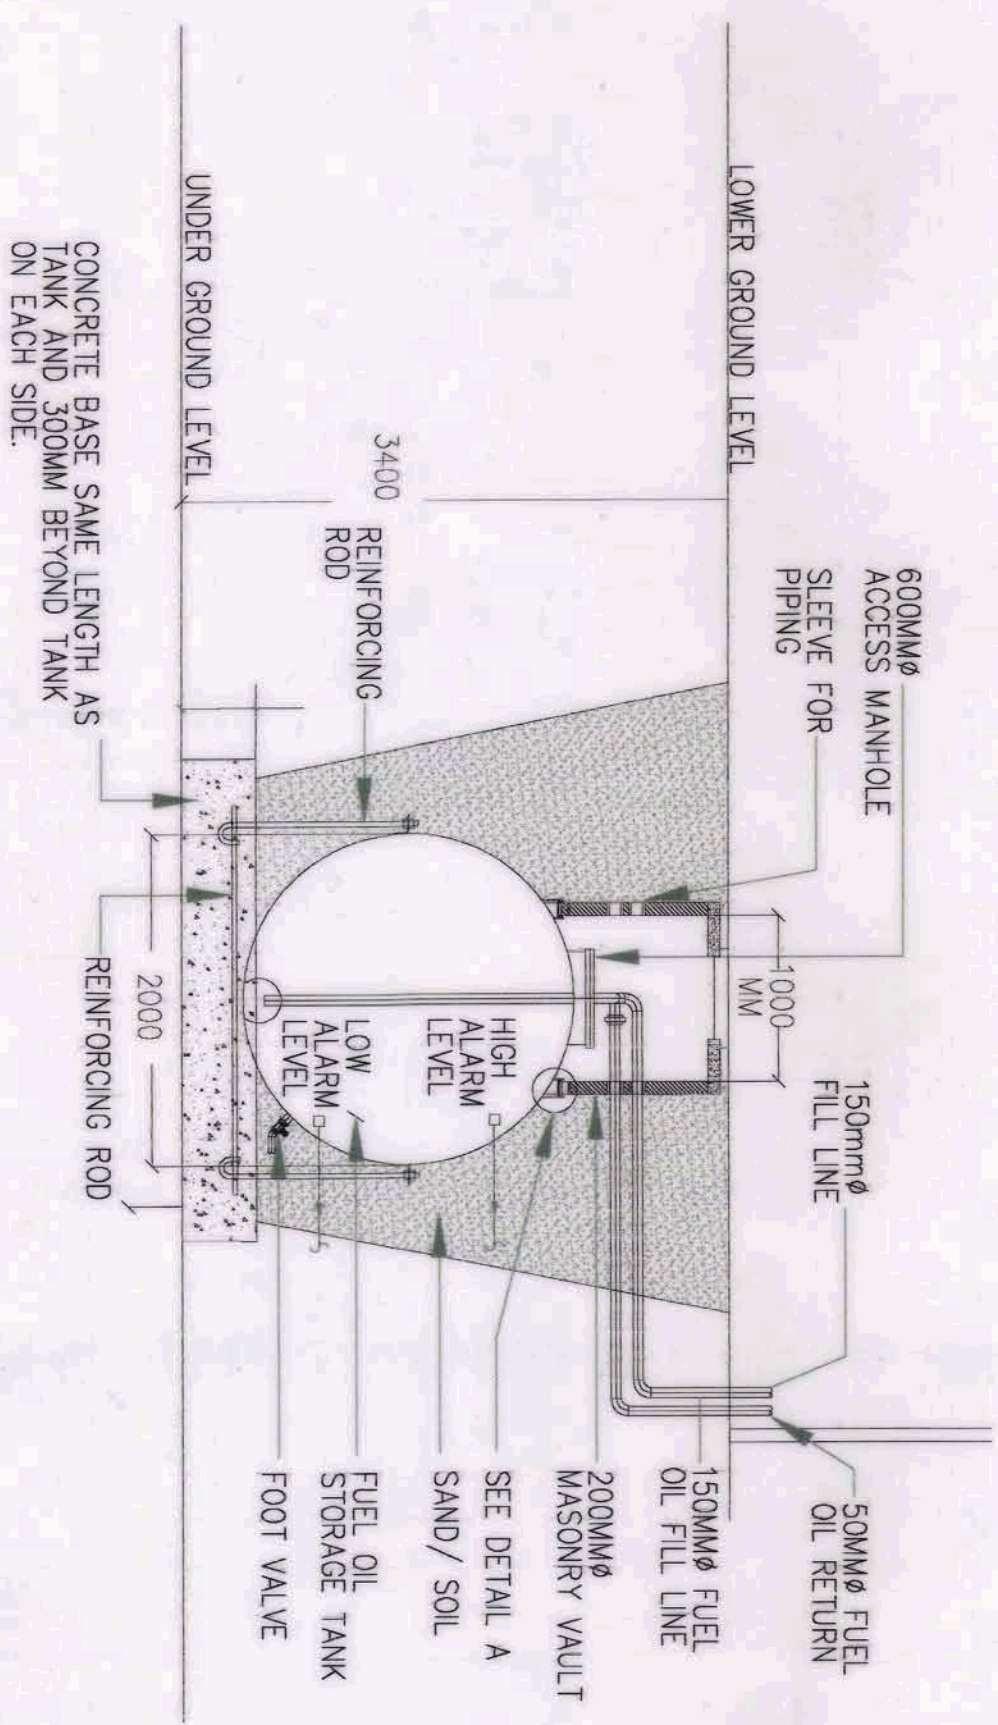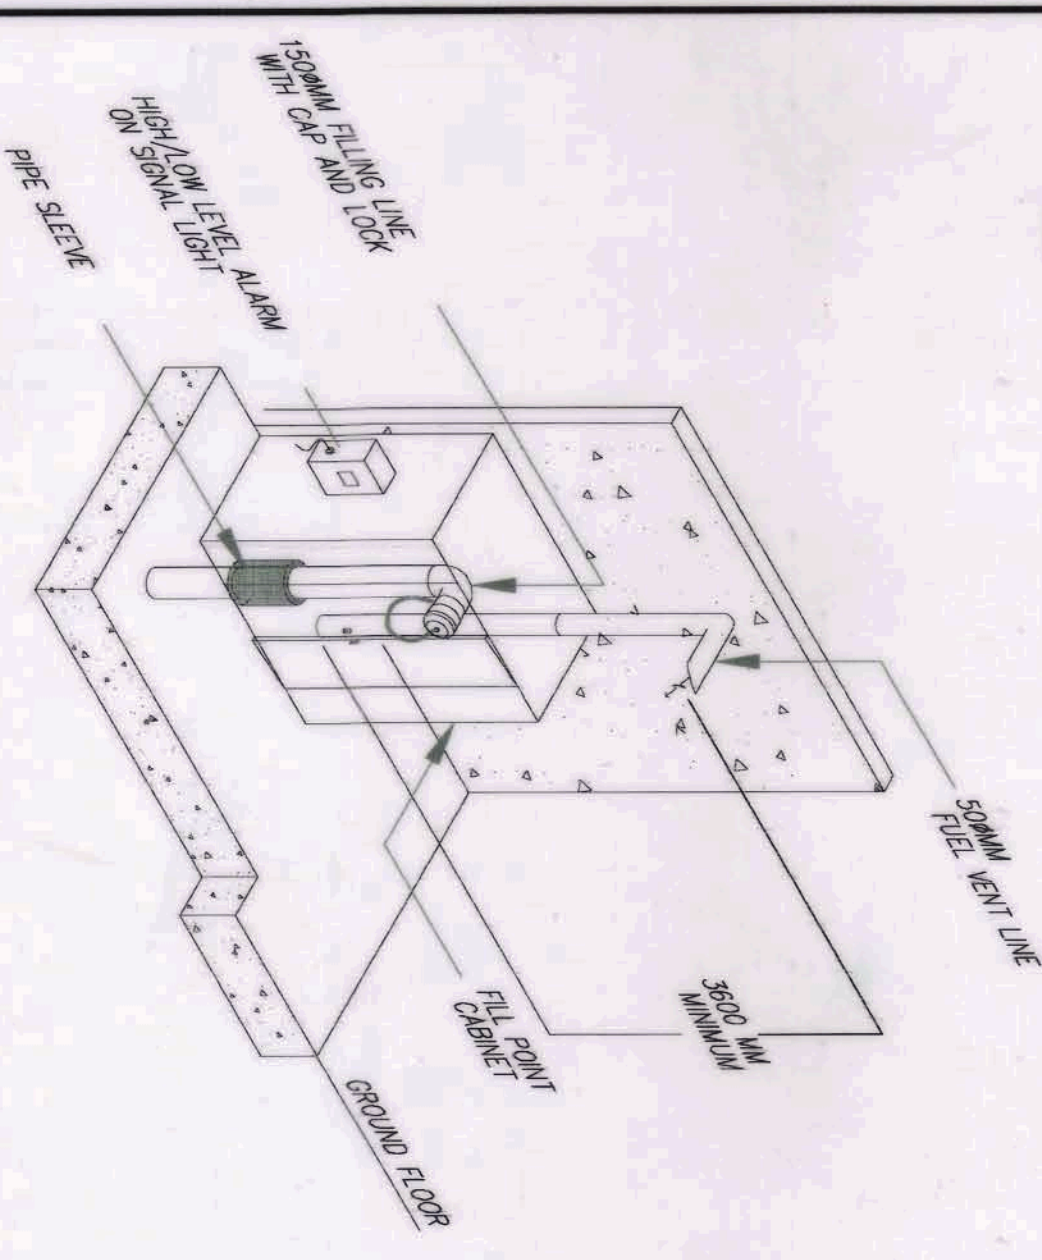

9 FUEL FILL LINE DETAIL  
NOT TO SCALE

10 FUEL OIL STORAGE MOUNTING DETAILS  
NOT TO SCALE

GRAPHIC SCALE:  
4000 2000 0 4000 10000  
SCALE NTS

OWNER: NGAC PHASE 1 JV COMPANY PREPARED BY: REVIEWED AND VALIDATED BY: SUBMITTED BY: CERTIFIED BY: INDEPENDENT CONSULTANT PROJECT TITLE: SHEET CONTENTS: SHEET NO.

BCDA  
BAYAN LEPONG  
CONSTRUCTION DEVELOPMENT AUTHORITY

Hilmar's Construction Corporation  
1835 E. Rodriguez St., Avenue Cidra, Quezon City  
JESUS V. HERBAS  
PROJECT MANAGER

FILIPINAS DRAVO CORPORATION  
Architectural & Engineering Consultants  
Rizal Drive, Alibon, Marikina City  
ALFREDO R. REY  
PROJECT MANAGER

BANDAR HEBAT BUILDERS, INC.  
ISMAEL DAVID  
PRESIDENT


TCGI ENGINEERS  
500 N. China Street, 10th Fl., Alibon, Marikina City  
VERILLO A. MADRADO  
PRESIDENT/CEO

AS-BUILT DRAWING  
NGAC PHASE 1A  
AQUATIC CENTER  
NEW CLARK CITY, CAPAS, TARLAC

MISCELLANEOUS DETAIL  
M7-02

# **ATHLETES' VILLAGE**


**AS-BUILT  
MECHANICAL PLANS**

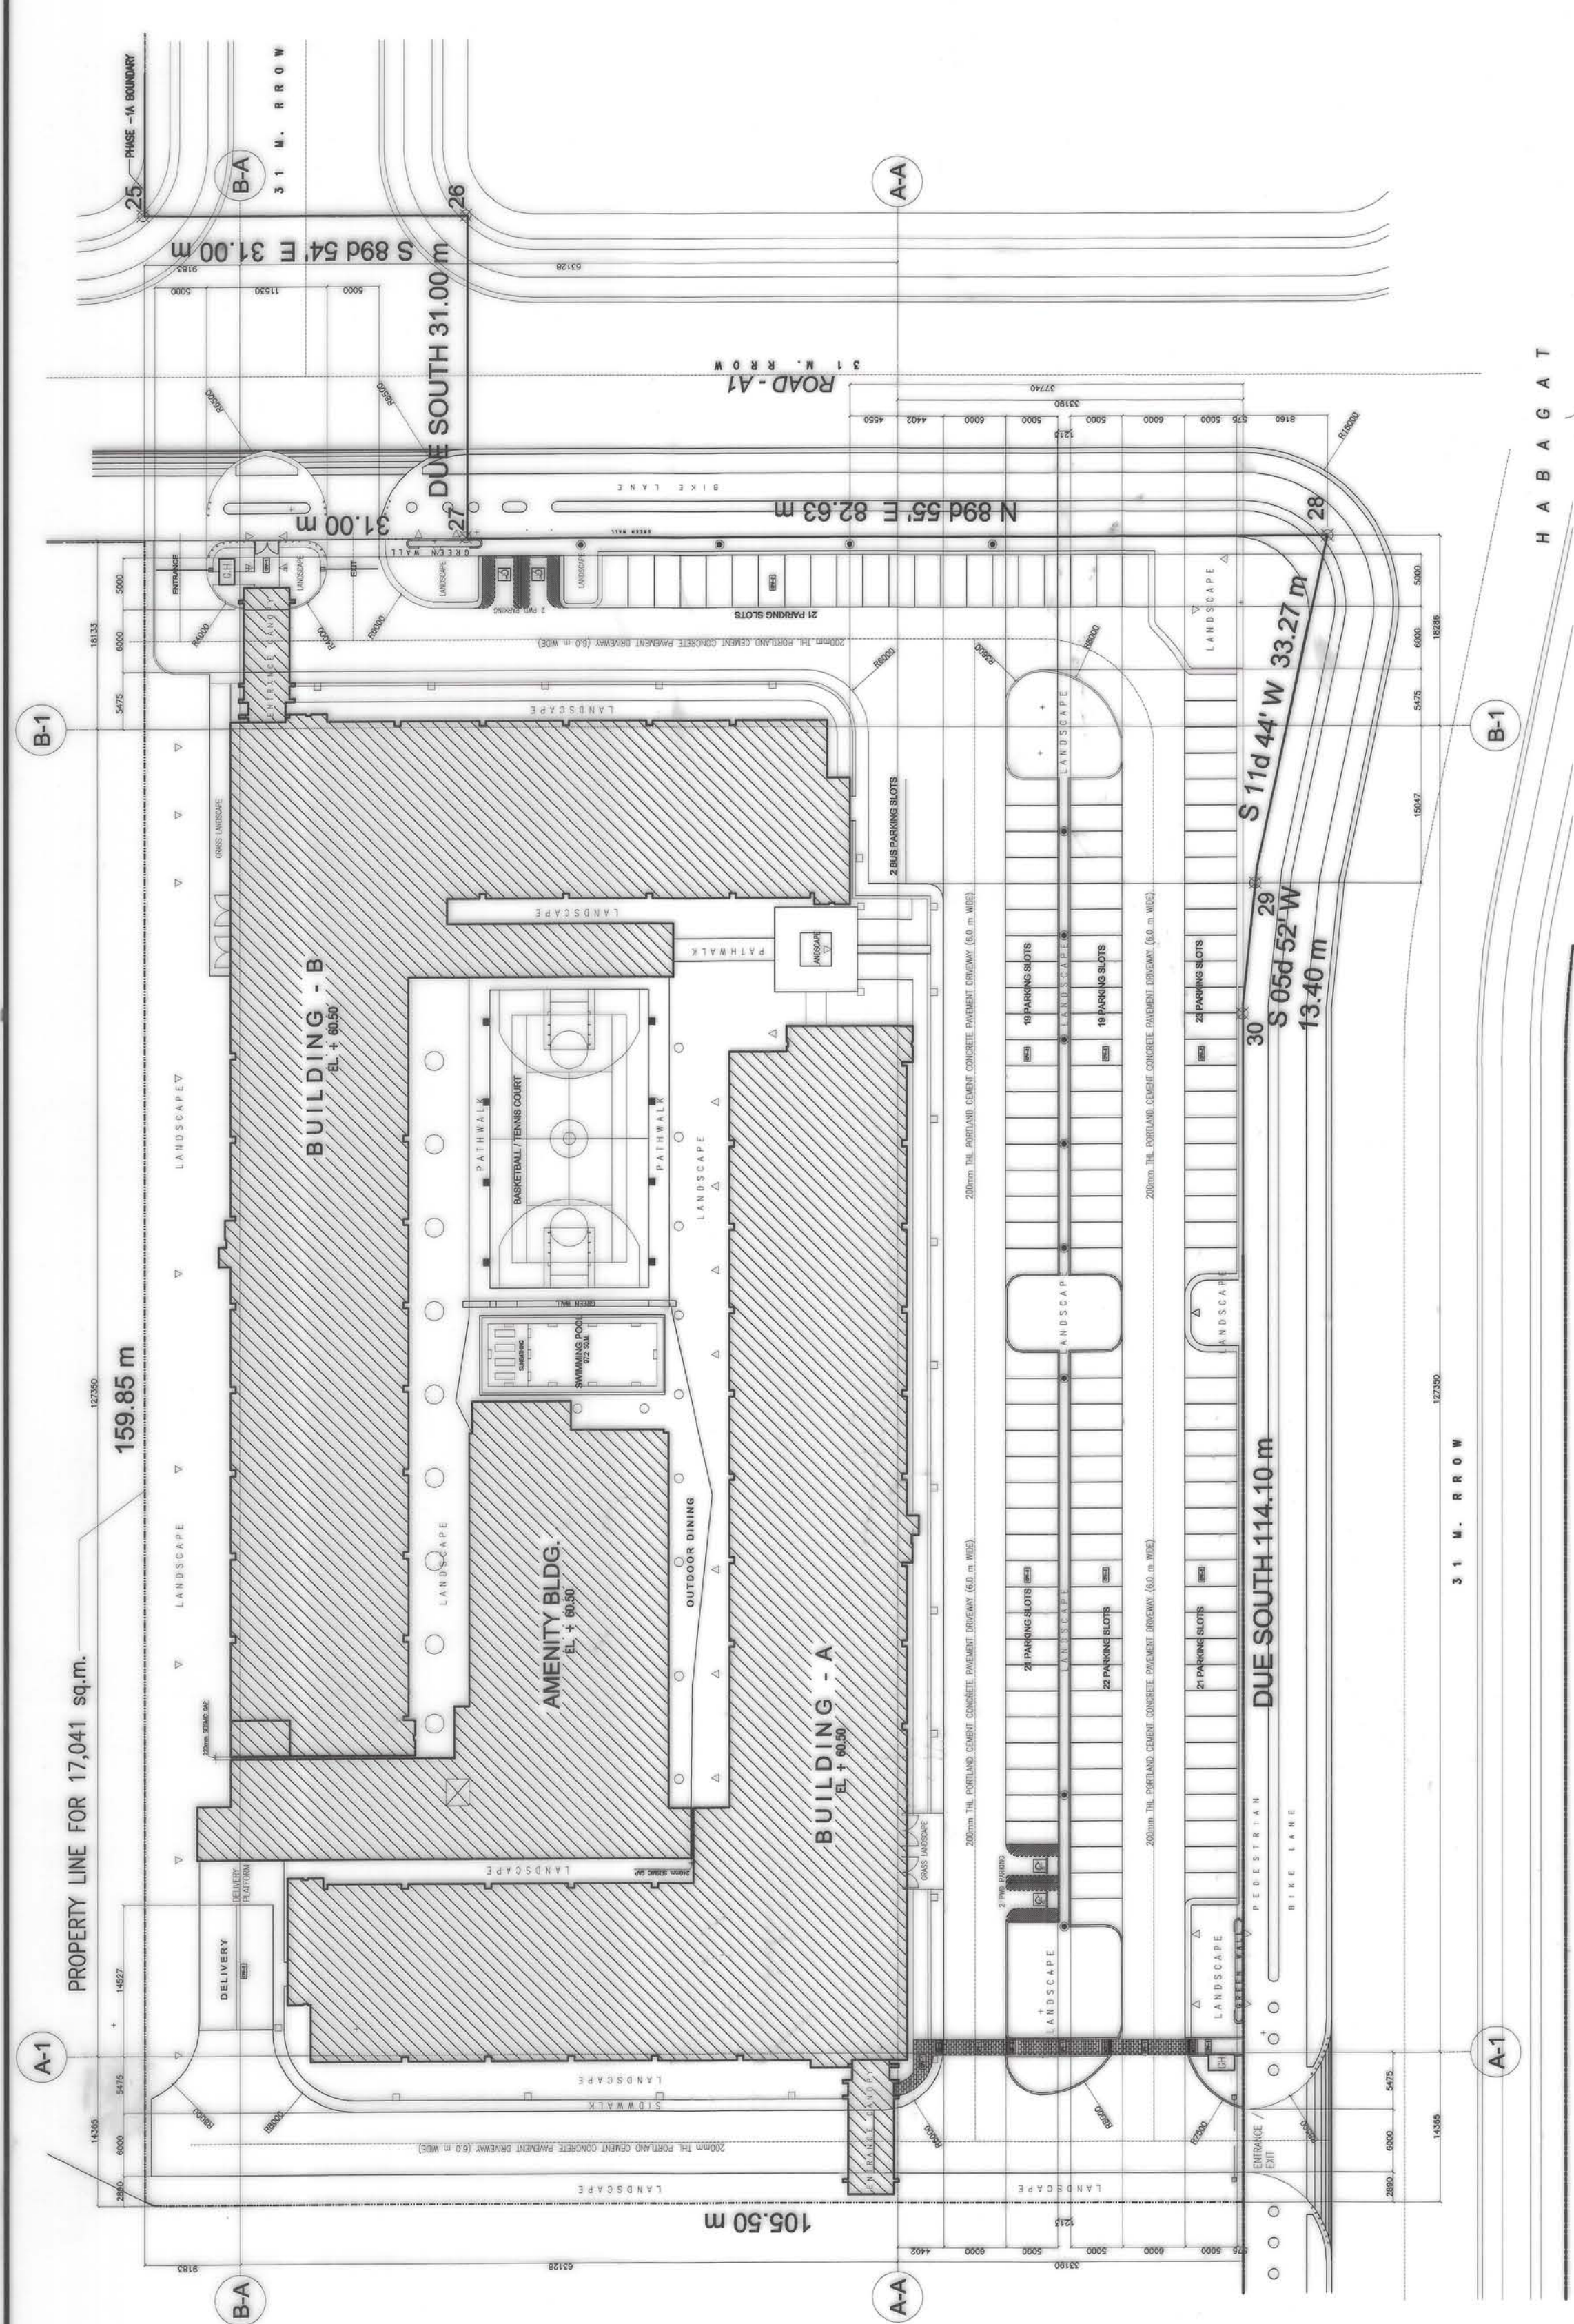

1 SITE DEVELOPMENT PLAN



THE SITE

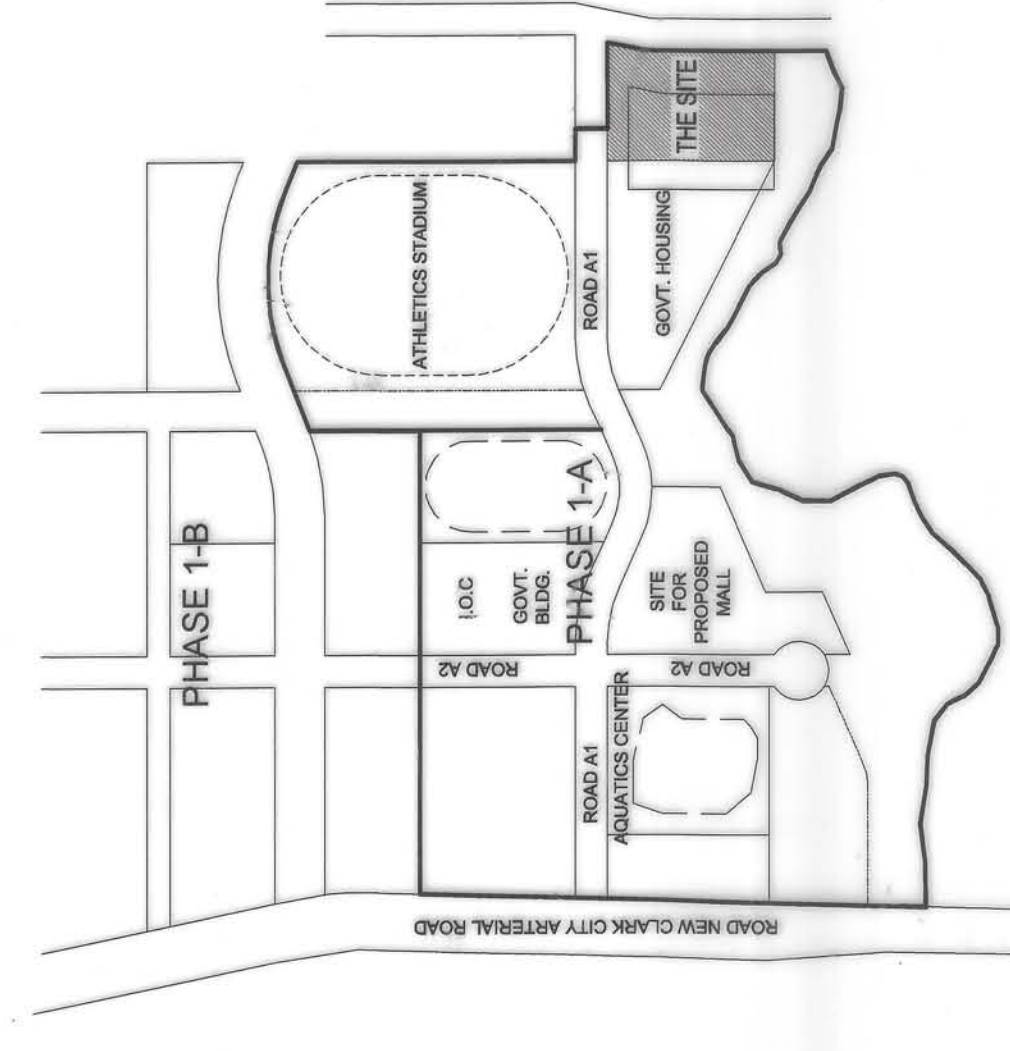

3 LOCATION MAP

2 VICINITY MAP

# TABLE OF CONTENTS

M-000	SITE DEVELOPMENT PLAN, TABLE OF CONTENTS, LOCATION MAP, & VICINITY MAP
M-001	GENERAL NOTES, LEGEND, SYMBOLS, & ABBREVIATION
M-002	SCHEDULE OF AIRCONDITIONING EQUIPMENTS - VRF/VRV SYSTEM
M-003	SCHEDULE OF AIRCONDITIONING & VENTILATION EQUIPMENTS
M-004	SCHEDULE OF VENTILATING EQUIPMENTS
M-01	BUILDING "A" & AMENITY BUILDING GROUND FLOOR AIRCONDITIONING LAYOUT PLAN
M-02	BUILDING "B" GROUND FLOOR AIRCONDITIONING LAYOUT PLAN
M-03	BUILDING "A" & AMENITY BUILDING SECOND FLOOR AIRCONDITIONING LAYOUT PLAN
M-04	BUILDING "B" SECOND FLOOR AIRCONDITIONING LAYOUT PLAN
M-05	BUILDING "A" & AMENITY BUILDING THIRD FLOOR AIRCONDITIONING LAYOUT PLAN
M-06	BUILDING "B" THIRD FLOOR AIRCONDITIONING LAYOUT PLAN
M-07	BUILDING "A" FOURTH FLOOR AIRCONDITIONING LAYOUT PLAN
M-08	BUILDING "B" FOURTH FLOOR AIRCONDITIONING LAYOUT PLAN
M-09	BUILDING "A" FIFTH FLOOR AIRCONDITIONING LAYOUT PLAN
M-10	BUILDING "B" FIFTH FLOOR AIRCONDITIONING LAYOUT PLAN
M-11	BUILDING "A" ROOF DECK AIRCONDITIONING LAYOUT PLAN
M-12	BUILDING "B" ROOF DECK AIRCONDITIONING LAYOUT PLAN
M-13	BUILDING "A" BASEMENT FLOOR VENTILATION LAYOUT PLAN
M-14	BUILDING "A" & AMENITY BUILDING GROUND FLOOR VENTILATION LAYOUT PLAN
M-15	BUILDING "B" GROUND FLOOR VENTILATION LAYOUT PLAN
M-16	BUILDING "A" & AMENITY BUILDING SECOND FLOOR VENTILATION LAYOUT PLAN
M-17	BUILDING "B" SECOND FLOOR VENTILATION LAYOUT PLAN
M-18	BUILDING "A" & AMENITY BUILDING THIRD FLOOR VENTILATION LAYOUT PLAN
M-19	BUILDING "B" THIRD FLOOR VENTILATION LAYOUT PLAN
M-20	BUILDING "A" FOURTH FLOOR VENTILATION LAYOUT PLAN
M-21	BUILDING "B" FOURTH FLOOR VENTILATION LAYOUT PLAN
M-22	BUILDING "A" FIFTH FLOOR VENTILATION LAYOUT PLAN
M-23	BUILDING "B" FIFTH FLOOR VENTILATION LAYOUT PLAN
M-24	BUILDING "A" ROOF DECK VENTILATION LAYOUT PLAN
M-25	BUILDING "B" ROOF DECK VENTILATION LAYOUT PLAN
M-26	BUILDING "A" VARIOUS TOILET EAD RISER DIAGRAM
M-27	BUILDING "B" VARIOUS TOILET EAD RISER DIAGRAM
M-28	BUILDING "A" SYSTEM 4 - CENTRALIZED TOILET VENTILATION EAD RISER DIAGRAM
M-29	BUILDING "B" SYSTEM 4 - CENTRALIZED TOILET VENTILATION EAD RISER DIAGRAM
M-30	BUILDING "A" SYSTEM 5 - CENTRALIZED TOILET VENTILATION EAD RISER DIAGRAM
M-31	BUILDING "B" SYSTEM 5 - CENTRALIZED TOILET VENTILATION EAD RISER DIAGRAM
M-32	BUILDING "A" SYSTEM 6 - CENTRALIZED TOILET VENTILATION EAD RISER DIAGRAM
M-33	BUILDING "B" SYSTEM 6 - CENTRALIZED TOILET VENTILATION EAD RISER DIAGRAM
M-34	BUILDING "A" AND "B" SMOKE EVACUATION RISER DIAGRAM
M-35	MISCELLANEOUS DETAILS 01
M-36	MISCELLANEOUS DETAILS 02
M-37	MISCELLANEOUS DETAILS 03
M-38	MISCELLANEOUS DETAILS 04

OWNER :	NGAC PHASE 1 JV COMPANY	AND	PREPARED BY:	NGAC PHASE 1 JV COMPANY	CERTIFIED BY:	INDEPENDENT CONSULTANT	PROJECT TITLE:	AS-BUILT DRAWING	SHEET CONTENTS:	SHEET NO.
	BCDA					TCGI ENGINEERS	NGAC PHASE 1A	TABLE OF CONTENTS	TABLE OF CONTENTS	M-000
	WENCIO B. DEON					VIRGLIO A. MADRADO	ATHLETES VILLAGE	LOCATION MAP	LOCATION MAP	
	PATRICK NICHOLAS P. DAVID					ISAAC S. DAWD	(AIR CONDITIONING & VENTILATION SYSTEM)	VICINITY MAP	VICINITY MAP	
							New Clark City, Capas, Tarlac			

GENERAL NOTES :

1. ALL MECHANICAL WORKS HEREIN INCLUDED IN ACCORDANCE WITH THE LATEST ASHRAE AND SMACNA, UNIFORM MECH. CODE, PHILIPPINE MECHANICAL ENGINEERING CODE, AND NFPA 96 AS PER NATIONAL BUILDING CODE.

2. INSTALLATION OF ALL WORKS DONE IN A NEAT AND WORKMANLIKE MANNER. IMPROPER SET/WORK OR FINISH AS DETERMINED BY THE ARCHITECT SHALL BE REMOVED AND REPLACED AT NO EXTRA COST.

3. ALL MECHANICAL WORKS EXECUTED IN CLOSED COORDINATED WITH THE OTHER TRADES.

4. ALL DIMENSIONS ARE IN MILLIMETER, UNLESS OTHERWISE SPECIFIED.

5. ALL PIPE SIZE ARE IN MM.

6. ALL MATERIALS TO BE USED WERE BRAND NEW AND CLEAN.

7. ALL POWER WIRING DONE BY THE ELECTRICAL CONTRACTOR.

8. ALL AIR-CONDITIONING DUCT AS PER SMACNA USING G.I SHEET GALVABOND MATERIALS AND FULLY INSULATED WITH CLOSE CELL ELASTOMERIC RUBBER INSULATIONS 25MM THICK, AND OR MINIMUM OF 19MM MIN. THICK FOR POLYOLEFIN INSULATION WITH REINFORCED ALUMINUM SHEETING AND ADHESIVE BACKING, CLASS 0 FIRE RATING.

9. FRESH AND EXHAUST AIR VENTILATING EQUIPMENTS FOR KITCHEN CONTROL PANEL SWITCH LOCATED NEAR AT THE COOKING AREA.

10. ALL FRESH AIR DUCT EXPOSED TO WEATHER WERE PAINTED WITH ANTI-CORROSIVE PAINT/USE EPOXY PRIMER FOR ALL APPLICATION.

11. SEAL TYPE ELECTRIC MOTOR FOR BLOWERS DRIVE, AND FOR KITCHEN EXHAUST BLOWER ARE SPARK - RESISTANT CONSTRUCTION.

12. ALL METAL SUPPORTS ARE FULLY WELDED.

13. ALL CONTROL WIRING WERE DONE BY THE CONTRACTOR INCLUDE LOAD SIDE.

14. POWER SUPPLY/WIRINGS FOR THE UNITS ARE BY THE ELECTRICAL CONTRACTOR.

15. ALL AIR-CONDITIONING UNITS WERE PROVIDED WITH REFRIGERANT FILTER DRIERS.

16. REFRIGERANT PIPING ARE TYPE "L" HARD DRAWN SEAMLESS COPPER PIPE HAS A THICKNESS OF 0.71 MM.

17. REFRIGERANT PIPE INSULATION WERE 25MM MIN. THICK CLOSED CELL ELASTOMERIC RUBBER INSULATION FOR BRANCH RUN, AND 40MM FOR MAIN PIPE, OR USE 20MM MIN. THICK FOR POLYOLEFIN INSULATION WITH REINFORCED ALUMINUM SHEETING AND ADHESIVE BACKING, CLASS 0 FIRE RATING.

18. AC CONDENSATE DRAIN LINE WERE CLOSED CELL ELASTOMERIC RUBBER INSULATIONS 15MM MIN. THICK.

19. ANY REQUIREMENT NOT FOUND IN PSME CODE, THE MATERIALS, CONSTRUCTION AND INSTALLATION OF DUCTWORK COMPLIED WITH THE REQUIREMENT OF SMACNA OR ASHRAE.

20. ALL DUCTWORKS CONFORMED WITH THE PHILIPPINE MECHANICAL ENGINEERING CODE, AMERICAN STANDARDS FOR TESTING MATERIALS/AMERICAN SOCIETY OF HEATING, REFRIGERATION AND AIR CONDITIONING ENGINEERS, AIR CONDITIONING AND REFRIGERATION INSTITUTE/NATIONAL FIRE PROTECTION ASSOCIATION, SHEET METAL AND AIR-CONDITIONING CONTRACTORS, NATIONAL ASSOCIATION, BUILDING OFFICIALS, AND CODE ADMINISTRATORS, INTERNATIONAL MANUFACTURERS STANDARDIZATION, SOCIETY OF VALVES AND FITTINGS INDUSTRY, INC., AND OTHER LOCAL AND INTERNATIONAL CODES PERTINENT TO THIS WORKS.

21. ALL AIR-CONDITIONING, FRESH AIR AND EXHAUST VENTILATION DUCTS ARE OF 653 ASTM HOT DIPPED, ZINC COATED STEEL SHEET CONFIRMING TO SMACNA STANDARDS AND LOCK FORMED AND SEALED WITH DUCT SEALANT CONFORMING TO ASTM E 84.

22. KITCHEN EXHAUST DUCT WERE MADE OF ASTM 653 BLACK STEEL (B.I) SHEET WITH A MINIMUM THICKNESS OF 1.2MM (GA. 18). FULL WELDED ON DUCT CONNECTIONS, KED WERE INSULATED WITH 25MM THICK FIBER GLASS BOARD WITH ALUMINUM FOIL VAPOR BARRIER WITH A DENSITY OF ATLEAST 48 Kg per cubic meter (8pcf). PROVIDE SERVICE HOLES/ACCESS DOOR FOR CLEANING.

23. PRIOR TO INSULATION, ALL DUCTWORKS WERE SMOKE OR LIGHT TESTED AND WERE WITNESSED BY AUTHORIZED REPRESENTATIVE.

24. PROVIDED CONTINUOUS CORNER BENDS ON ALL DUCTS MADE OF 0.6MM ASTM 653 HOT DIPPED, ZINC COATED STEEL SHEET, PROPERLY FASTENED WITH PLASTIC STRAPS EVERY 300MM.

25. ALL HVAC WORKS WERE SUPERVISED IN A REGISTERED MECHANICAL ENGINEER OF GOOD STANDING.

26. PROVIDED SECONDARY DRAIN PAN FOR CEILING CONCEALED AHU/FCU AND REFER TO MANUFACTURE STANDARD FOR THE REFRIGERANT ACCEPTABLE PIPE SIZES WITH RESPECT TO LENGTH OF THE PIPING.

27. AIR-CONDITIONING UNIT CMD/FAHU/AHU RETURN AIR FILTERS PROVIDED BY MANUFACTURER.

28. THESE DRAWING WERE DIAGRAMMATIC AND ARE NOT INTENDED TO INDICATE ALL NECESSARY PIPING OFFSET OR FITTINGS. THE CONTRACTOR INSTALLED MATERIALS AND EQUIPMENTS IN A MANNER AS TO CONFORMED TO STRUCTURE, AVOID OBSTRUCTION, PRESERVE HEADROOM, AND KEEP OPENINGS AND PASSAGEWAYS CLEAR. ALL INSTALLATION WERE CONSISTENT WITH NORMALLY ACCEPTABLE INDUSTRY STANDARDS. THE CONTRACTORS HAS NOTIFY THE MANAGING OFFICE IN WRITING OF ANY DISCREPANCIES OR CONFLICTS THAT WOULD AFFECT THE SYSTEM PERFORMANCE OR WHICH WOULD INCUR ADDITIONAL COSTS. THIS NOTIFICATION WERE MADE BY PRIOR TO THE INSTALLATION OF THE ITEMS AND EQUIPMENTS CONCERNED.

LEGEND, SYMBOLS, & ABBREVIATIONS :

LEGEND, SYMBOLS & ABBREVIATION:

SYMBOL/ ABBREVIATION	DESCRIPTION	ABBREVIATION	DESCRIPTION
	EQUIPMENT TAG	ACCU	AIR COOLED CONDENSING UNIT
	FCU 4-WAY CEILING CASSETTE	ACU	AIR-CONDITIONING UNIT
	FCU WALL MOUNTED	BTU	BRITISH THERMAL UNIT
	AIR COOLED CONDENSING UNIT	CEF	CEILING EXHAUST FAN
	WINDOW-TYPE AIRCON UNIT	CDP	CONDENSATE DRAIN PIPE
	CEILING MOUNTED DUCT-TYPE	CFM	CUBIC FEET PER MINUTE
	CASSETTE TYPE/TOILET EXHAUST FAN	CMH	CUBIC METER PER HOUR
	EXHAUST HOOD DUCT - RISER (B.I. MATERIAL)	EAD	EXHAUST AIR DUCT
	SINGLE DEF. EXHAUST AIR GRILLE	EAG	EXHAUST AIR GRILLE
	SUPPLY AIR DUCT RISER	EAF	EXHAUST AIR FAN
	PRESSURIZATION AIR DUCT RISER	EF	EXHAUST FAN
	FRESH AIR DUCT RISER	ESP	EXTERNAL STATIC PRESSURE
	EXHAUST AIR DUCT RISER	FAG	FRESH AIR GRILLE
	SMOKE EXTRACTION DUCT RISER	FAD	FRESH AIR DUCT
	CEILING AND ORBIT FAN	FAB	FRESH AIR BLOWER
	4-WAY DIFFUSER	FAF	FRESH AIR FAN
	TOILET EXHAUST AIR GRILLE	FAHU	FRESH AIR HANDLING UNIT
	SMOKE EXTRACTION AIR GRILLES	FCU	FAN COIL UNIT
	WALL-MOUNTED FAN	HKEF	HOUSEKEEPING EXHAUST FAN
	LOUVER DOOR - DIRECTION (INTAKE)	HP	HORSEPOWER
	DUCTING ACCESS DOOR	IMG	INCH OF WATER GAUGE
	FIRE DAMPER	KED	KITCHEN EXHAUST DUCT
	SIDE THROW AIR GRILLE	KEG	KITCHEN EXHAUST GRILLE

EQUIPMENT CONTROLLER SYMBOLS:

SYMBOL/ ABBREVIATION	DESCRIPTION
	WALL MOUNTED REMOTE CONTROLLER - WIRELESS
	WALL MOUNTED THERMOSTAT - ACU WIRED CONTROLLER
	ELECTRONIC SINGLE PHASE SPEED CONTROLLER (KRUGER)
	ISOLATION SWITCH/ EXHAUST OR FRESH AIR FAN SWITCH
	ISOLATION CIRCUIT BREAKER
	OCCILLATING FAN INDEPENDENT SWITCH ( 4 -SPEED)
	CEILING FAN INDEPENDENT SWITCH ( 4-SPEED)
	MOTOR CONTROL PANEL
	DIFFERENTIAL PRESSURE SENSOR
	DIFFERENTIAL PRESSURE CONTROLLER
	SMOKE DETECTOR (BY - ECEEE)
	NORMALLY OPEN MOTORIZED DAMPER
	NORMALLY CLOSED MOTORIZED DAMPER
	POWER SUPPLY (BY -EE)

PIPE DESIGNATION:

--- --- --- BELOW GRADE/UNDERGROUND PIPE  
\_\_\_\_\_ NORMAL PIPE LAYOUT

OWNER :  
BCDA  
Regional Office of the Department of Public Works and Highways  
Office of the Regional Engineer  
Davao Region Office  
Davao City

AND  
WENCIO B. DIZON  
PRESIDENT

PREPARED BY:  
FREY-FIL CORPORATION  
REG. NO.: 028697  
MANILA - DAVAO - CEBU - ILOILO  
13 West Gate Drive, 3rd Floor, Davao City  
www.frey-fil.com.ph  
Tel. No. 221-8401

PROJECT MANAGER  
ALFREDO R. REVILLA

VICE PRESIDENT - OPERATION  
ZOILO S. DELA CRUZ  
REG. NO.: 028697  
TIN. NO.: 116-426-274  
DATE: 01/20/2019

FILIPINAS DRAVO CORPORATION  
Architectural & Engineering Consultants  
Engineers: R. S. Dela Cruz, R. S. Dela Cruz, R. S. Dela Cruz  
Architects: R. S. Dela Cruz, R. S. Dela Cruz, R. S. Dela Cruz

BANDAR HEBAT BUILDERS, INC.  
ISAAC S. DAVID  
PRESIDENT

TCGI ENGINEERS  
200 P.O. Box 200, 100 U.S. Route 101, Davao City  
Davao City, Philippines  
Tel. No. 221-8401

VIRGIOLO A. MADRAZO  
PRESIDENT/CEO

PROJECT TITLE:  
AS-BUILT DRAWING  
NGAC PHASE 1A  
ATHLETES VILLAGE  
(AIR CONDITIONING & VENTILATION SYSTEM)  
New Clark City, Capas, Tarlac

GENERAL NOTES, LEGEND,  
SYMBOLS, & ABBREVIATION

M-001

SHEET CONTENTS:

SHEET NO.

EQUIPMENT SCHEDULE: AIRCONDITIONING UNITS

BUILDING A - VRF/VRV, R410A AIRCONDITIONING UNITS

EQUIPMENT TAG OR UNIT DESIGNATION	SYSTEM	QUANTITY	UNITS	LOCATION OR AREA SERVED	DESIGN COOLING			MANUFACTURER SELECTED CAPACITY				ELECTRICAL CHARACTERISTICS			TYPE LHD SEAMLESS CONDENSATE DRAIN PIPE SIZE (MM)	UNIT DESCRIPTION
					SENSIBLE BTU/HR	LATENT BTU/HR	TOTAL BTU/HR	INDOOR AIRFLOW H/W/L (CM)	INDOOR COOLING HP	OUTDOOR AIRFLOW CMM	OUTDOOR COOLING BTU/HR	POWER CONSUMPTION (KW)	VOLTS	PHASE		
VRF-OU008-RD-A1	VRF OUTDOOR-1	1	UNIT	ROOF DECK BLOC-A	37,445	6,339	43,800	39/33/28	5.0	178	95,900	6.84	400	3	60	VRV A - OUTDOOR UNIT
VRF-OU008-RD-A1	INDOOR UNIT	1	UNIT	LOBBY, GROUND FLOOR BLOC-A	15,304	776	16,304	15/12	2.0			0.283	220	1	60	CEILING MOUNTED DUCT-TYPE
VRF-OU008-RD-A1	INDOOR UNIT	1	UNIT	ELECTRONICS ROOM, GROUND FLOOR BLOC-A	3,918	607	4,500	7.5/4.5	0.8			0.019	220	1	60	WALL MOUNTED TYPE
VRF-OU008-RD-A1	INDOOR UNIT	1	UNIT	DOCTOR'S ROOM, GROUND FLOOR BLOC-A	913	5,100	6,019	8.0/5.0	1.0			0.019	220	1	60	WALL MOUNTED TYPE
VRF-OU008-RD-A1	INDOOR UNIT	1	UNIT	NURSE ROOM, GROUND FLOOR BLOC-A	7,409	704	8,100	8.0/5.0	1.0			0.028	220	1	60	WALL MOUNTED TYPE
VRF-OU008-RD-A1	INDOOR UNIT	1	UNIT	PATIENT ROOM, GROUND FLOOR BLOC-A				TOTAL (9.6)								
VRF-OU008-RD-A2	VRF OUTDOOR-2	1	UNIT	ROOF DECK BLOC-A						257	152,900	12.9	400	3	60	VRV A - OUTDOOR UNIT
VRF-OU008-RD-A2	INDOOR UNIT	3	UNITS	EXERCISE ROOM, GROUND FLOOR BLOC-A	57,885/3	18,977/3	6,800/3	25/22.5/20	3.2			0.184	220	1	60	CEILING MOUNTED DUCT-TYPE
VRF-OU008-RD-A2	INDOOR UNIT	1	UNIT	EXERCISE ROOM, GROUND FLOOR BLOC-A	7,627	6,002	13,629	356.64	18			0.359	220	1	60	FRESH AIR HANDLING UNIT DUCT-TYPE
VRF-OU008-RD-A2	INDOOR UNIT	1	UNIT	EXERCISE ROOM, GROUND FLOOR BLOC-A				TOTAL (15)								
VRF-OU008-RD-A3	VRF OUTDOOR-3	1	UNIT	ROOF DECK FOR 2ND-5TH FLOOR BLOC-A						257	172,000	12.9	400	3	60	VRV A - OUTDOOR UNIT
VRF-OU008-RD-A3	INDOOR UNIT	3	UNITS	CONFERENCE ROOMS, 2ND-4TH FLR BLOC-A	27,809	6,425	34,300	39/27/23	4.0			0.214	220	1	60	CEILING MOUNTED DUCT-TYPE
VRF-OU008-RD-A3	INDOOR UNIT	1	UNIT	CONFERENCE ROOM, 5TH FLR BLOC-A	35,054	6,008	42,700	39/33/28	5.0			0.283	220	1	60	CEILING MOUNTED DUCT-TYPE
VRF-OU008-RD-A3	INDOOR UNIT	1	UNIT	CONFERENCE ROOM, 5TH FLR BLOC-A				TOTAL (17)								

BUILDING B - VRF/VRV, R410A AIRCONDITIONING UNITS

EQUIPMENT TAG OR UNIT DESIGNATION	SYSTEM	QUANTITY	UNITS	LOCATION OR AREA SERVED	DESIGN COOLING			MANUFACTURER SELECTED CAPACITY				ELECTRICAL CHARACTERISTICS			TYPE LHD SEAMLESS CONDENSATE DRAIN PIPE SIZE (MM)	UNIT DESCRIPTION
					SENSIBLE BTU/HR	LATENT BTU/HR	TOTAL BTU/HR	INDOOR AIRFLOW H/W/L (CM)	INDOOR COOLING HP	OUTDOOR AIRFLOW CMM	OUTDOOR COOLING BTU/HR	POWER CONSUMPTION (KW)	VOLTS	PHASE		
VRF-OU008-RD-B1	VRF OUTDOOR-4	1	UNIT	ROOF DECK BLOC-B	42,080	6,450	48,500	46/39/32	6.0	178	76,400	5.17	400	3	60	VRV A - OUTDOOR UNIT
VRF-OU008-RD-B1	INDOOR UNIT	1	UNIT	LOBBY, GROUND FLOOR BLOC-B	15,304	776	16,304	15/12	2.0			0.404	220	1	60	CEILING MOUNTED DUCT-TYPE
VRF-OU008-RD-B1	INDOOR UNIT	1	UNIT	ELECTRONICS ROOM, GROUND FLOOR BLOC-B								0.033	220	1	60	WALL MOUNTED TYPE
VRF-OU008-RD-B1	INDOOR UNIT	1	UNIT	ROOF DECK BLOC-B						257	152,900	12.9	400	3	60	VRV A - OUTDOOR UNIT
VRF-OU008-RD-B2	VRF OUTDOOR-5	1	UNIT	EXERCISE ROOM, GROUND FLOOR BLOC-B	52,697/2	18,975/3	71,300/3	29/22.5/20	3.2			0.184	220	1	60	CEILING MOUNTED DUCT-TYPE
VRF-OU008-RD-B2	INDOOR UNIT	3	UNITS	EXERCISE ROOM, GROUND FLOOR BLOC-B	7,627	6,002	13,629	356.64	18			0.359	220	1	60	FRESH AIR HANDLING UNIT DUCT-TYPE
VRF-OU008-RD-B2	INDOOR UNIT	1	UNIT	EXERCISE ROOM, GROUND FLOOR BLOC-B				TOTAL (15)								
VRF-OU008-RD-B3	VRF OUTDOOR-6	1	SET	ROOF DECK BLOC-B						257	172,000	13.9	400	3	60	VRV A - OUTDOOR UNIT
VRF-OU008-RD-B4	COMBINATION UNITS	1	UNIT													
VRF-OU008-RD-B4	OUTDOOR 6A	1	UNIT													
VRF-OU008-RD-B4	OUTDOOR 6B	1	UNIT													
VRF-OU008-RD-B5	VRF OUTDOOR-7	1	UNIT	ATHLETE'S DINING AREA, GRND FLR BLOC-C	26,517/1	15,693/5	54,000/5	9.05/5	8.0			1.49	220	1	60	CEILING MOUNTED DUCT-TYPE
VRF-OU008-RD-B5	INDOOR UNIT	1	UNIT	KITCHEN OFFICE AREA, GRND FLR BLOC-C	3,561	625	4,200	7.5/4.5	0.8			0.019	220	1	60	WALL MOUNTED TYPE
VRF-OU008-RD-B5	INDOOR UNIT	1	UNIT	ROOF DECK BLOC-C						257+297	362,200	35.4	400	3	60	VRV A - OUTDOOR UNIT
VRF-OU008-RD-B5	INDOOR UNIT	1	UNIT	LIBRARY READING AREA, SECOND FLOOR BLOC-C	2,852/2	6,937/2	35,500/2	18/13/13.5	2.0			0.040	220	1	60	CEILING MOUNTED CASSETTE TYPE
VRF-OU008-RD-B5	INDOOR UNIT	2	UNITS	COMPUTER AREA, SECOND FLOOR BLOC-C	28,136	3,984	32,100	39/29/26	4.0			0.158	220	1	60	CEILING MOUNTED CASSETTE TYPE
VRF-OU008-RD-B5	INDOOR UNIT	1	UNIT	LIBRARIAN'S OFFICE, SECOND FLR BLOC-C	13,043	1,092	14,100	17/13.5/13	1.6			0.036	220	1	60	CEILING MOUNTED CASSETTE TYPE
VRF-OU008-RD-B5	INDOOR UNIT	1	UNIT	HALLWAY / 2F VARIOUS OFFICES - BLOC-C	13,622	10,721	24,343	18	5.0			0.359	220	1	60	FRESH AIR HANDLING UNIT DUCT-TYPE
VRF-OU008-RD-B5	INDOOR UNIT	1	UNIT	SECOND FLOOR BLOC-C				TOTAL (14.6)								
VRF-OU008-RD-B5	INDOOR UNIT	1	UNIT	ADMINISTRATION, SECOND FLOOR BLOC-C	29,474	3,217	32,700	39/29/26	4			0.198	220	1	60	CEILING MOUNTED CASSETTE TYPE
VRF-OU008-RD-B5	INDOOR UNIT	1	UNIT	OFFICE-1, SECOND FLOOR BLOC-C	9,302	1,064	10,400	13/12.5/11	1.25			0.029	220	1	60	CEILING MOUNTED CASSETTE TYPE
VRF-OU008-RD-B5	INDOOR UNIT	1	UNIT	OFFICE-2, SECOND FLOOR BLOC-C	8,414	1,253	9,500	13/12.5/11.5	1.25			0.029	220	1	60	CEILING MOUNTED CASSETTE TYPE
VRF-OU008-RD-B5	INDOOR UNIT	1	UNIT	OFFICE-3, SECOND FLOOR BLOC-C	13,259	988	14,200	17/13.5/13	1.6			0.036	220	1	60	CEILING MOUNTED CASSETTE TYPE
VRF-OU008-RD-B5	INDOOR UNIT	1	UNIT	LOUNGE/RECEPTION AREA, SECOND FLR BLOC-C	10,045	1554	11,600	17/13.5/13	1.6			0.036	220	1	60	CEILING MOUNTED CASSETTE TYPE
VRF-OU008-RD-B5	INDOOR UNIT	1	UNIT	CONFERENCE ROOM, SECOND FLOOR BLOC-C	30,483	7,681	38,200	25/23/21	5.0			0.178	220	1	60	CEILING MOUNTED CASSETTE TYPE
VRF-OU008-RD-B5	INDOOR UNIT	1	UNIT	CONFERENCE ROOM, SECOND FLOOR BLOC-C				TOTAL (14.7)								






BUILDING C - VRF/VRV, R410A AIRCONDITIONING UNITS

EQUIPMENT TAG OR UNIT DESIGNATION	SYSTEM	QUANTITY	UNITS	LOCATION OR AREA SERVED	DESIGN COOLING			MANUFACTURER SELECTED CAPACITY				ELECTRICAL CHARACTERISTICS			TYPE LHD SEAMLESS CONDENSATE DRAIN PIPE SIZE (MM)	UNIT DESCRIPTION
					SENSIBLE BTU/HR	LATENT BTU/HR	TOTAL BTU/HR	INDOOR AIRFLOW H/W/L (CM)	INDOOR COOLING HP	OUTDOOR AIRFLOW CMM	OUTDOOR COOLING BTU/HR	POWER CONSUMPTION (KW)	VOLTS	PHASE		
VRF-OU008-RD-C1	VRF OUTDOOR-7	1	SET	ROOF DECK BLOC-C						257+297	362,200	35.4	400	3	60	VRV A - OUTDOOR UNIT
VRF-OU008-RD-C2	COMBINATION UNITS	1	UNIT													
VRF-OU008-RD-C2	OUTDOOR 7A	1	UNIT													
VRF-OU008-RD-C2	OUTDOOR 7B	1	UNIT													
VRF-OU008-RD-C2	INDOOR UNIT	5	UNITS	ATHLETE'S DINING AREA, GRND FLR BLOC-C	26,517/1	15,693/5	54,000/5	9.05/5	8.0			1.49	220	1	60	CEILING MOUNTED DUCT-TYPE
VRF-OU008-RD-C2	INDOOR UNIT	1	UNIT	KITCHEN OFFICE AREA, GRND FLR BLOC-C	3,561	625	4,200	7.5/4.5	0.8			0.019	220	1	60	WALL MOUNTED TYPE
VRF-OU008-RD-C2	INDOOR UNIT	1	UNIT	ROOF DECK BLOC-C						257	152,900	12.9	400	3	60	VRV A - OUTDOOR UNIT
VRF-OU008-RD-C2	INDOOR UNIT	2	UNITS	LIBRARY READING AREA, SECOND FLOOR BLOC-C	2,852/2	6,937/2	35,500/2	18/13/13.5	2.0			0.040	220	1	60	CEILING MOUNTED CASSETTE TYPE
VRF-OU008-RD-C2	INDOOR UNIT	1	UNIT	COMPUTER AREA, SECOND FLOOR BLOC-C	28,136	3,984	32,100	39/29/26	4.0			0.158	220	1	60	CEILING MOUNTED CASSETTE TYPE
VRF-OU008-RD-C2	INDOOR UNIT	1	UNIT	LIBRARIAN'S OFFICE, SECOND FLR BLOC-C	13,043	1,092	14,100	17/13.5/13	1.6			0.036	220	1	60	CEILING MOUNTED CASSETTE TYPE
VRF-OU008-RD-C2	INDOOR UNIT	1	UNIT	HALLWAY / 2F VARIOUS OFFICES - BLOC-C	13,622	10,721	24,343	18	5.0			0.359	220	1	60	FRESH AIR HANDLING UNIT DUCT-TYPE
VRF-OU008-RD-C2	INDOOR UNIT	1	UNIT	SECOND FLOOR BLOC-C				TOTAL (14.6)								
VRF-OU008-RD-C2	INDOOR UNIT	1	UNIT	ADMINISTRATION, SECOND FLOOR BLOC-C	29,474	3,217	32,700	39/29/26	4			0.198	220	1	60	CEILING MOUNTED CASSETTE TYPE
VRF-OU008-RD-C2	INDOOR UNIT	1	UNIT	OFFICE-1, SECOND FLOOR BLOC-C	9,302	1,064	10,400	13/12.5/11	1.25			0.029	220	1	60	CEILING MOUNTED CASSETTE TYPE
VRF-OU008-RD-C2	INDOOR UNIT	1	UNIT	OFFICE-2, SECOND FLOOR BLOC-C	8,414	1,253	9,500	13/12.5/11.5	1.25			0.029	220	1	60	CEILING MOUNTED CASSETTE TYPE
VRF-OU008-RD-C2	INDOOR UNIT	1	UNIT	OFFICE-3, SECOND FLOOR BLOC-C	13,259	988	14,200	17/13.5/13	1.6			0.036	220	1	60	CEILING MOUNTED CASSETTE TYPE
VRF-OU008-RD-C2	INDOOR UNIT	1	UNIT	LOUNGE/RECEPTION AREA, SECOND FLR BLOC-C	10,045	1554	11,600	17/13.5/13	1.6			0.036	220	1	60	CEILING MOUNTED CASSETTE TYPE
VRF-OU008-RD-C2	INDOOR UNIT	1	UNIT	CONFERENCE ROOM, SECOND FLOOR BLOC-C	30,483	7,681	38,200	25/23/21	5.0			0.178	220	1	60	CEILING MOUNTED CASSETTE TYPE
VRF-OU008-RD-C2	INDOOR UNIT	1	UNIT	CONFERENCE ROOM, SECOND FLOOR BLOC-C				TOTAL (14.7)								






NOTE: EQUIPMENT SELECTION AS PER DASHIN VRF/VRV SYSTEM SOFTWARE AND PROJECT INDICATED CONSTRUCTION TO BE AT 15% RH

OWNER : NSAC PHASE I JV COMPANY	PREPARED BY : ZOLO S. DELACRUZ VICE PRESIDENT-OPERATION	REVIEWED AND VALIDATED BY : FILIPINAS DRAVO CORPORATION Architectural & Engineering Consultants REGISTERED PROFESSIONAL ENGINEER No. 005274 REGISTERED PROFESSIONAL ARCHITECT No. 005274	SUBMITTED BY : BANDAR HEBAT BUILDERS, INC. ISAAC S. DAVID PRESIDENT	CERTIFIED BY : TCGI ENGINEERS 10000 Old Highway 100, Suite 100, New Clark City, Pampanga 210000 Virgilio A. Madrazo PRESIDENT/CEO	PROJECT TITLE : AS-BUILT DRAWING NGAC PHASE 1A ATHLETES VILLAGE (AIR CONDITIONING & VENTILATION SYSTEM)	SHEET CONTENTS : SCHEDULE OF AIRCONDITIONING EQUIPMENTS - VRF/VRV SYSTEM	SHEET NO. : M-002
AND BCDA Bureau of Construction and Development Administration VINCENZO B. DION PRESIDENT							


# EQUIPMENT SCHEDULE: AIRCONDITIONING UNITS

EQUIPMENT TAG OR UNIT DESIGNATION	SYSTEM	QUANTITY	UNITS	LOCATION OR AREA SERVED	CAPACITY		ELECTRICAL CHARACTERISTICS				UNIT DESCRIPTION	REMARKS
					INDOOR	COOLING (HP)	POWER CONSUMPTION (KW)	CYCLE				
								VOLTS	PHASE			
	INDOOR UNIT	180	UNITS	STUDIO & HDCCP UNITS, GRND-4TH FLR BLDG-A GF-SUI07 TO 08-SOUTH GF-SUI10 TO 15-NORTH GF-SUI16 TO 17-SOUTH GF-SUI18 TO 23-SOUTH GF-SUI24 TO 30-NORTH GF-SUI31 TO 38 2F-SUI01 2F-SUI02 TO 06-SOUTH 2F-SUI07 2F-SUI08 TO 10-NORTH 2F-SUI11 TO 16 2F-SUI17 2F-SUI18 TO 19 2F-SUI20 TO 30N 2F-SUI31 2F-SUI32 TO 38N 2F-SUI39 2F-SUI40, 41, & 51 2F-SUI41, 42, & 44	1.5	1.21	220	1	60	R410A WINDOW-TYPE AIRCON UNIT	APPROVED EQUAL	
	INDOOR UNIT	1	UNIT	CONFERENCE ROOM, GROUND FLOOR BLDG-A	1.5	1.21	220	1	60			
	INDOOR UNIT	1	UNIT	OFFICE, GROUND FLOOR BLDG-A	1.5	1.21	220	1	60			
	INDOOR UNIT	71	UNITS	STUDIO & HDCCP UNITS, GRND-5TH FLR BLDG-A GF-SUI01-NORTH GF-SUI02-SOUTH GF-SUI03 GF-SUI04 GF-SUI05 GF-SUI06 TO 08 GF-SUI09 GF-SUI10 TO 16 GF-SUI17 GF-SUI18 TO 24, & SUI03 GF-SUI00 GF-SUI00 GF-SUI19 TO 28 GF-SUI00 GF-SUI00	2.0	1.70	220	1	60			
	INDOOR UNIT	6	UNITS	STUDIO & HDCCP UNITS, GRND-5TH FLR BLDG-A GF-SUI01 GF-SUI02 GF-SUI03 GF-SUI1000	2.5	2.1	220	1	60			

## BUILDING B - R410A WINDOW TYPE AIRCONDITIONING UNITS

EQUIPMENT TAG OR UNIT DESIGNATION	SYSTEM	QUANTITY	UNITS	LOCATION OR AREA SERVED	CAPACITY		ELECTRICAL CHARACTERISTICS			UNIT DESCRIPTION	REMARKS	
					INDOOR	COOLING (HP)	POWER CONSUMPTION (kW)	VOLTS	PHASE			CYCLE
	INDOOR UNIT	179	UNITS	STUDIO & HDCP UNITS, GRND-4TH FLR BLDG-B 05-SU04-5407 3F-SU04 4F-SU04 TO 01 0F-SU04 07 TO 20 3F-SU05 4F-SU05 2F-SU07 3F-SU08 3F-SU09-52 0F-SU-21 3F10-30 2F-SU06-55 0F-SU-44 4F10-48 3F-SU01 2F-SU02 3F-SU02 TO 06 & 4F-SU07 TO 14 0F-SU10 3F-SU10 TO 15 4F-SU04 2F-SU10 TO 18 & 3F-SU04 2F-SU10 TO 17 3F-SU04 2F-SU09 4F-SU09 TO 05 2F-SU09 3F-SU09 TO 04 4F-SU04 2F-SU09	1.5	1.21	220	1	60			
	INDOOR UNIT	1	UNIT	CONFERENCE ROOM, GROUND FLR BLDG-B	1.5	1.21	220	1	60		R410A WINDOW-TYPE ARCON UNIT  APPROVED EQUAL	
	INDOOR UNIT	1	UNIT	OFFICE, GROUND FLOOR BLDG-B	1.5	1.21	220	1	60			
	INDOOR UNIT	74	UNITS	STUDIO & HDCP UNITS, GRND-5TH FLR BLDG-B 0F-SU05 02 TO 03 & 2F-SU09-03 4F-SU05 & 06 5F-SU02 0F13 TO 16 4F-SU14 5F-SU14 TO 08 0F-SU11 & 12 2F-SU09 3F-SU03 5F-SU03 0F-SU11 3F-SU09 5F-SU11 0F-SU01 3F-SU15 5F-SU14 TO 31 0F-SU09 3F-SU03 5F-SU02 5F-SU05 TO 11 & 3102 5F-SU04 TO 01	2.0	1.70	220	1	60			
	INDOOR UNIT	10	UNITS	STUDIO & HDCP UNITS, GRND-5TH FLR BLDG-B 0F-SU09-WEST 2F-SU01 4F-SU01 0F-SU09 3F-SU01 5F-SU02	2.5	2.1	220	1	60			

## BUILDING C - R410A WINDOW TYPE AIRCONDITIONING UNIT

EQUIPMENT TAG OR UNIT DESIGNATION	SYSTEM	QUANTITY	UNITS	LOCATION OR AREA SERVED	ELECTRICAL CHARACTERISTICS					UNIT DESCRIPTION	REMARKS		
					CAPACITY		POWER CONSUMPTION (kW)	CYCLE	PHASE				
					INDOOR	COOLING							
	INDOOR UNIT	1	UNIT	CARSHAGE COLD STG., GRND FLOOR BLDG-C			2	1.70	220	1	60	R410A WINDOW-TYPE AIRCON UNIT	APPROVED EQUAL

## BUILDING C - CEILING FANS

EQUIPMENT TAG OR UNIT DESIGNATION	SYSTEM	QUANTITY	UNITS	LOCATION OR AREA SERVED	CAPACITY		ELECTRICAL CHARACTERISTICS			UNIT DESCRIPTION	
					SIZE (IN.)	AIR FLOW (CFM)	POWER CONSUMPTION (KW)	VOLTS	PHASE		CYCLE
CEILING FAN	CEILING FAN	18	UNIT	ATHLETE'S DINING AREA, GROUND FLR BLDG-C	36	-	50	220	1	60	CEILING FAN ORBIT-TYPE
CEILING FAN	CEILING FAN	2	UNIT	STORAGE AREA, SECOND FLOOR BLDG-C	36	-	50	220	1	60	CEILING FAN ORBIT-TYPE
CEILING FAN	CEILING FAN	1	UNIT	LOUNGE	36	-	50	220	1	60	CEILING FAN ORBIT-TYPE

BUILDING A&B - R410A SPLIT TYPE AIRCONDITIONING UNITS (ELECTRONICS ROOM BACK-UP UNIT)

EQUIPMENT TAG OR UNIT DESIGNATION	SYSTEM	QUANTITY	UNITS	LOCATION OR AREA SERVED	CAPACITY		HARD DRAWN, REF. PIPE SIZE, TYPE & L	ELECTRICAL CHARACTERISTICS			UNIT DESCRIPTION	
					INDOOR/OUTDOOR			POWER CONNECTION (KW)	VOLTS	PHASE		CYCLE
					COOLING	LIQUID						
ACCU/FOU		2	SETS	ELECTRONICS ROOM (BACK-UP UNITS)- BLD'G. A4B	17,999 (18,990)	6.46	1.2.76	1.54	220	1	60	SPUT TYPE DX INVERTER UNIT

[illegible]









1 SECOND FLOOR AIRCONDITIONING LAYOUT PLAN  
1:1500

NOTE: FOR SECONDARY CONDENSATE DRAIN/RAIN DETAILS, REFER TO THE UNIT PERMITS.


NOTE: FOR SECONDARY CONDENSATE DRAIN/RAIN DETAILS, REFER TO THE UNIT PERMITS.

OWNER :	NGAC PHASE 1 JV COMPANY		PREPARED BY :	FREY-FIL CORPORATION		REVIEWED AND VALIDATED BY :	FILIPINAS DRAGO CORPORATION		SUBMITTED BY :	BANDAR HEBAT BUILDERS, INC.		CERTIFIED BY :	TCGI ENGINEERS		PROJECT TITLE :	AS-BUILT DRAWING		SHEET NO. :	M-03	
AND		VICENTE B. DIZON		VICENTE B. DIZON		VICENTE B. DIZON		VICENTE B. DIZON		VICENTE B. DIZON		VICENTE B. DIZON		VICENTE B. DIZON		VICENTE B. DIZON		VICENTE B. DIZON		
VICENTE B. DIZON		VICENTE B. DIZON		VICENTE B. DIZON		VICENTE B. DIZON		VICENTE B. DIZON		VICENTE B. DIZON		VICENTE B. DIZON		VICENTE B. DIZON		VICENTE B. DIZON		VICENTE B. DIZON		
VICENTE B. DIZON		VICENTE B. DIZON		VICENTE B. DIZON		VICENTE B. DIZON		VICENTE B. DIZON		VICENTE B. DIZON		VICENTE B. DIZON		VICENTE B. DIZON		VICENTE B. DIZON		VICENTE B. DIZON		
VICENTE B. DIZON		VICENTE B. DIZON		VICENTE B. DIZON		VICENTE B. DIZON														









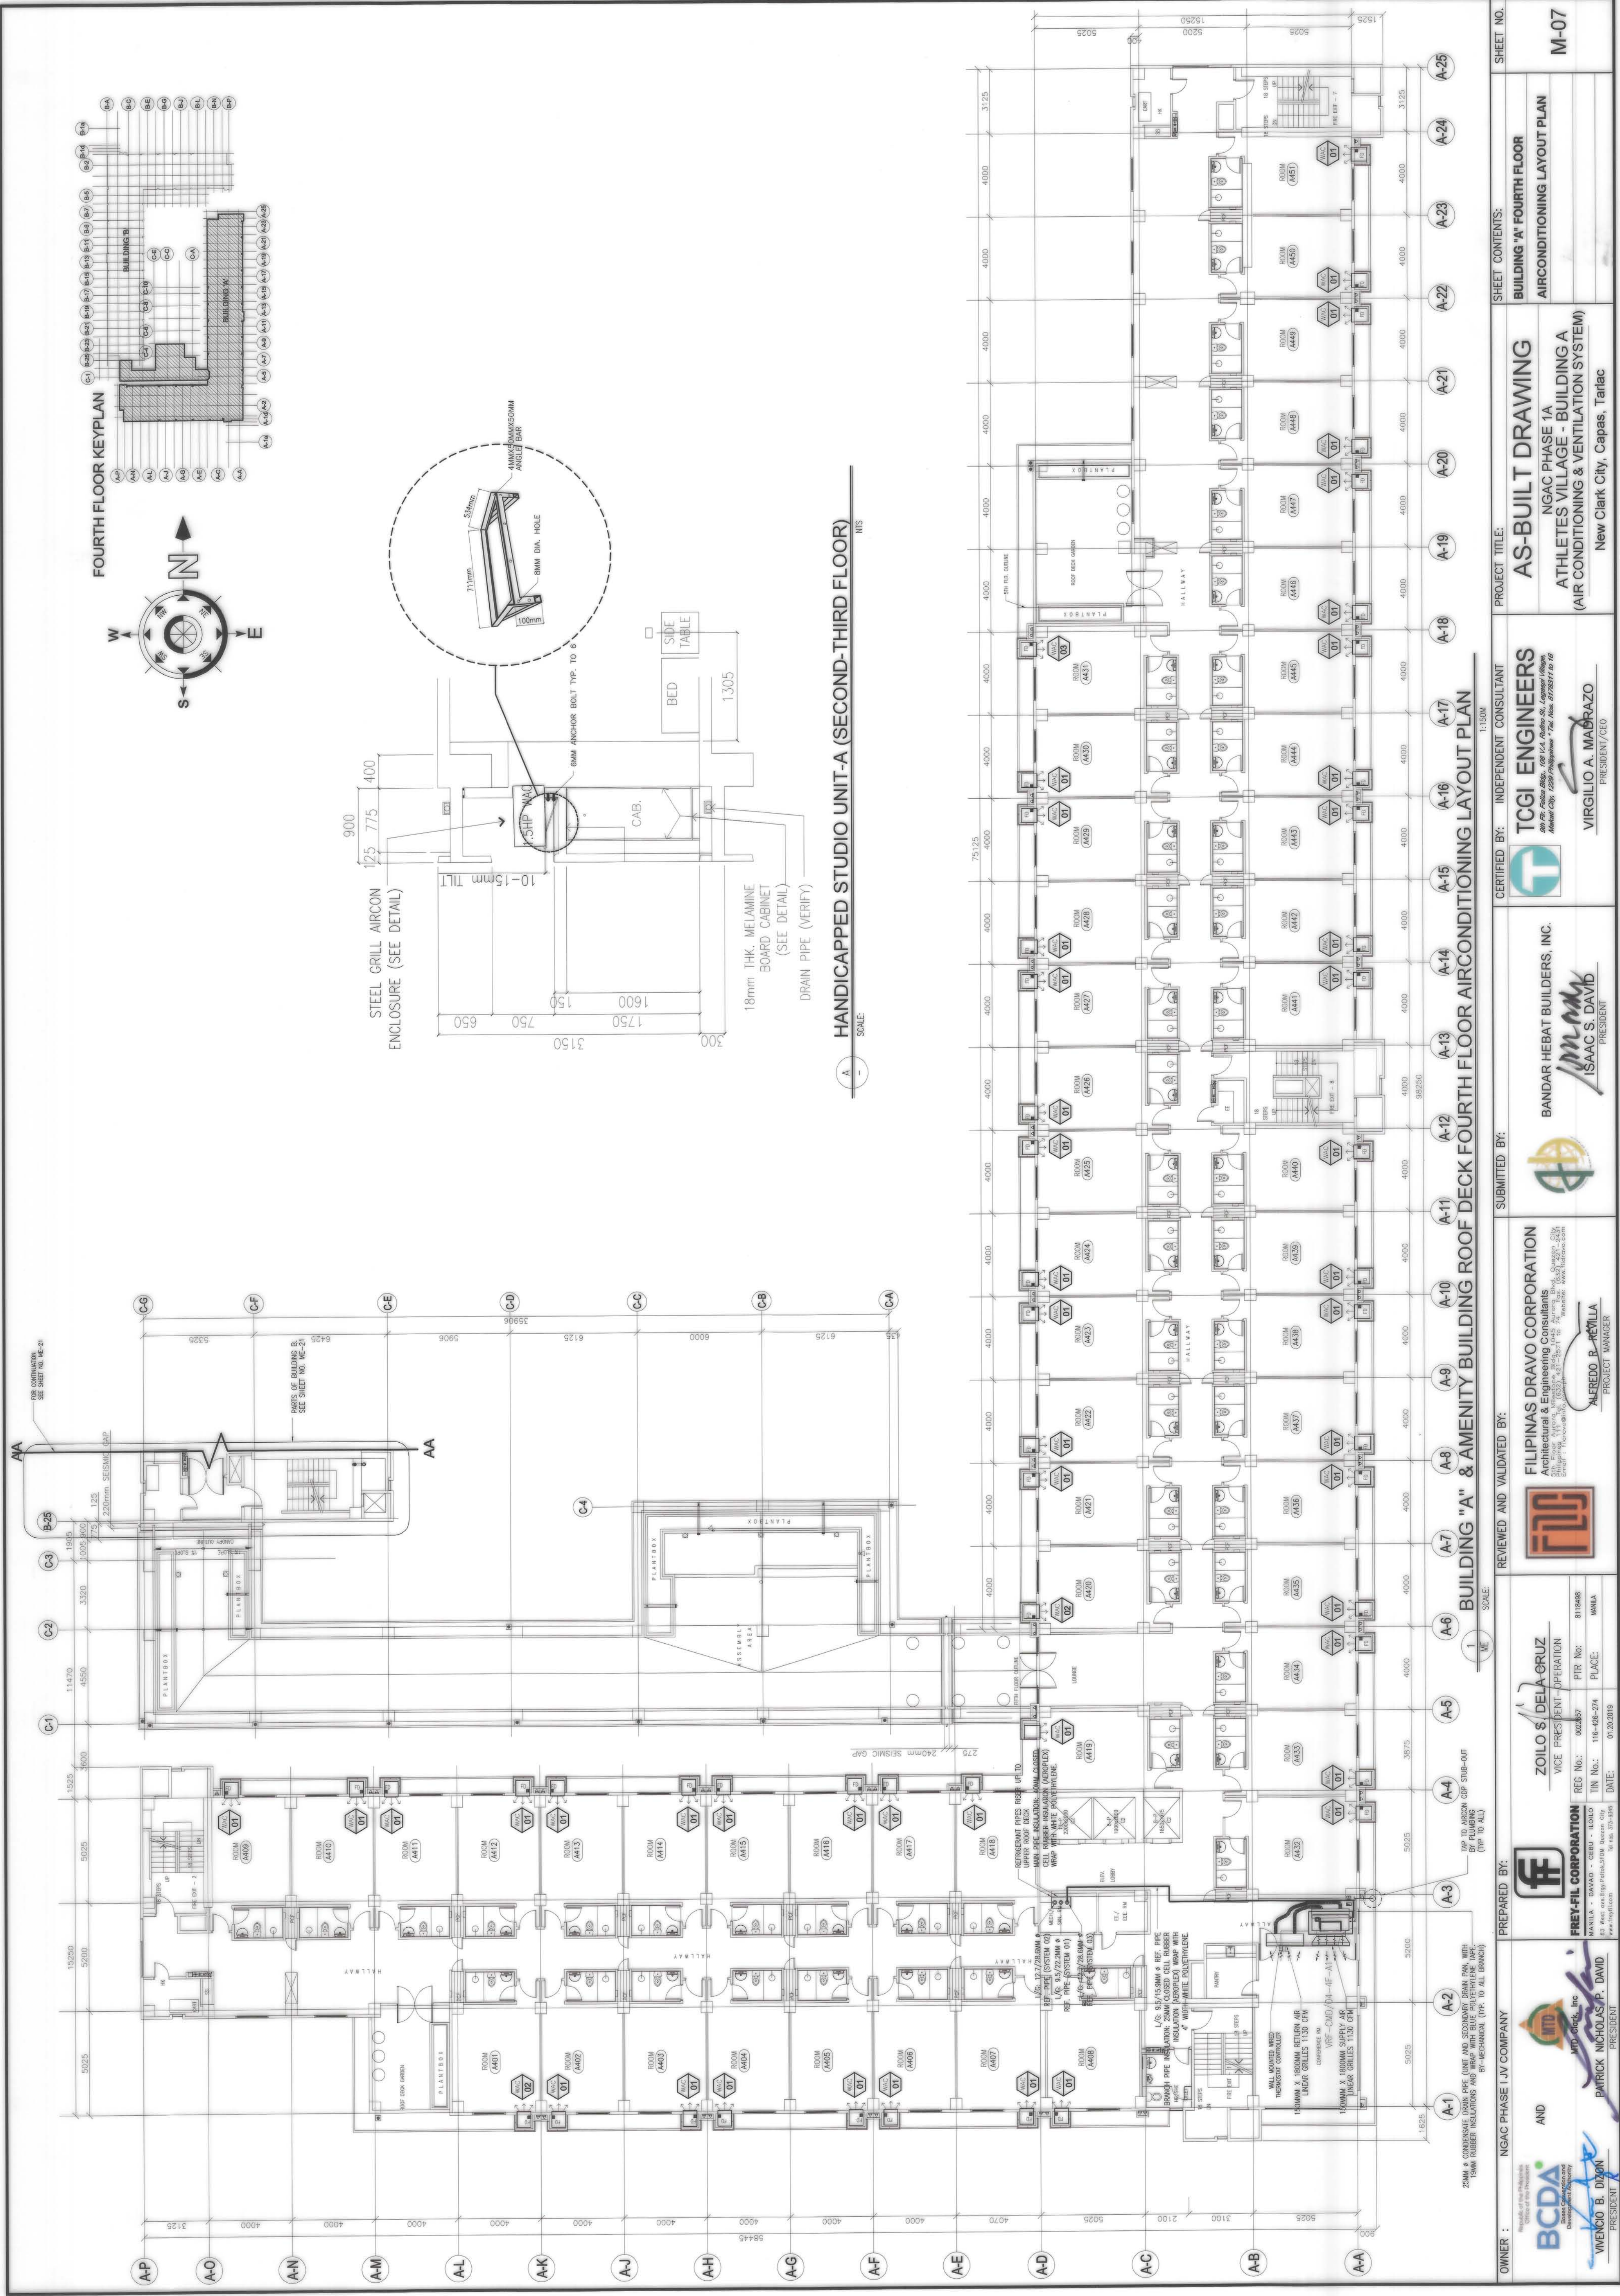




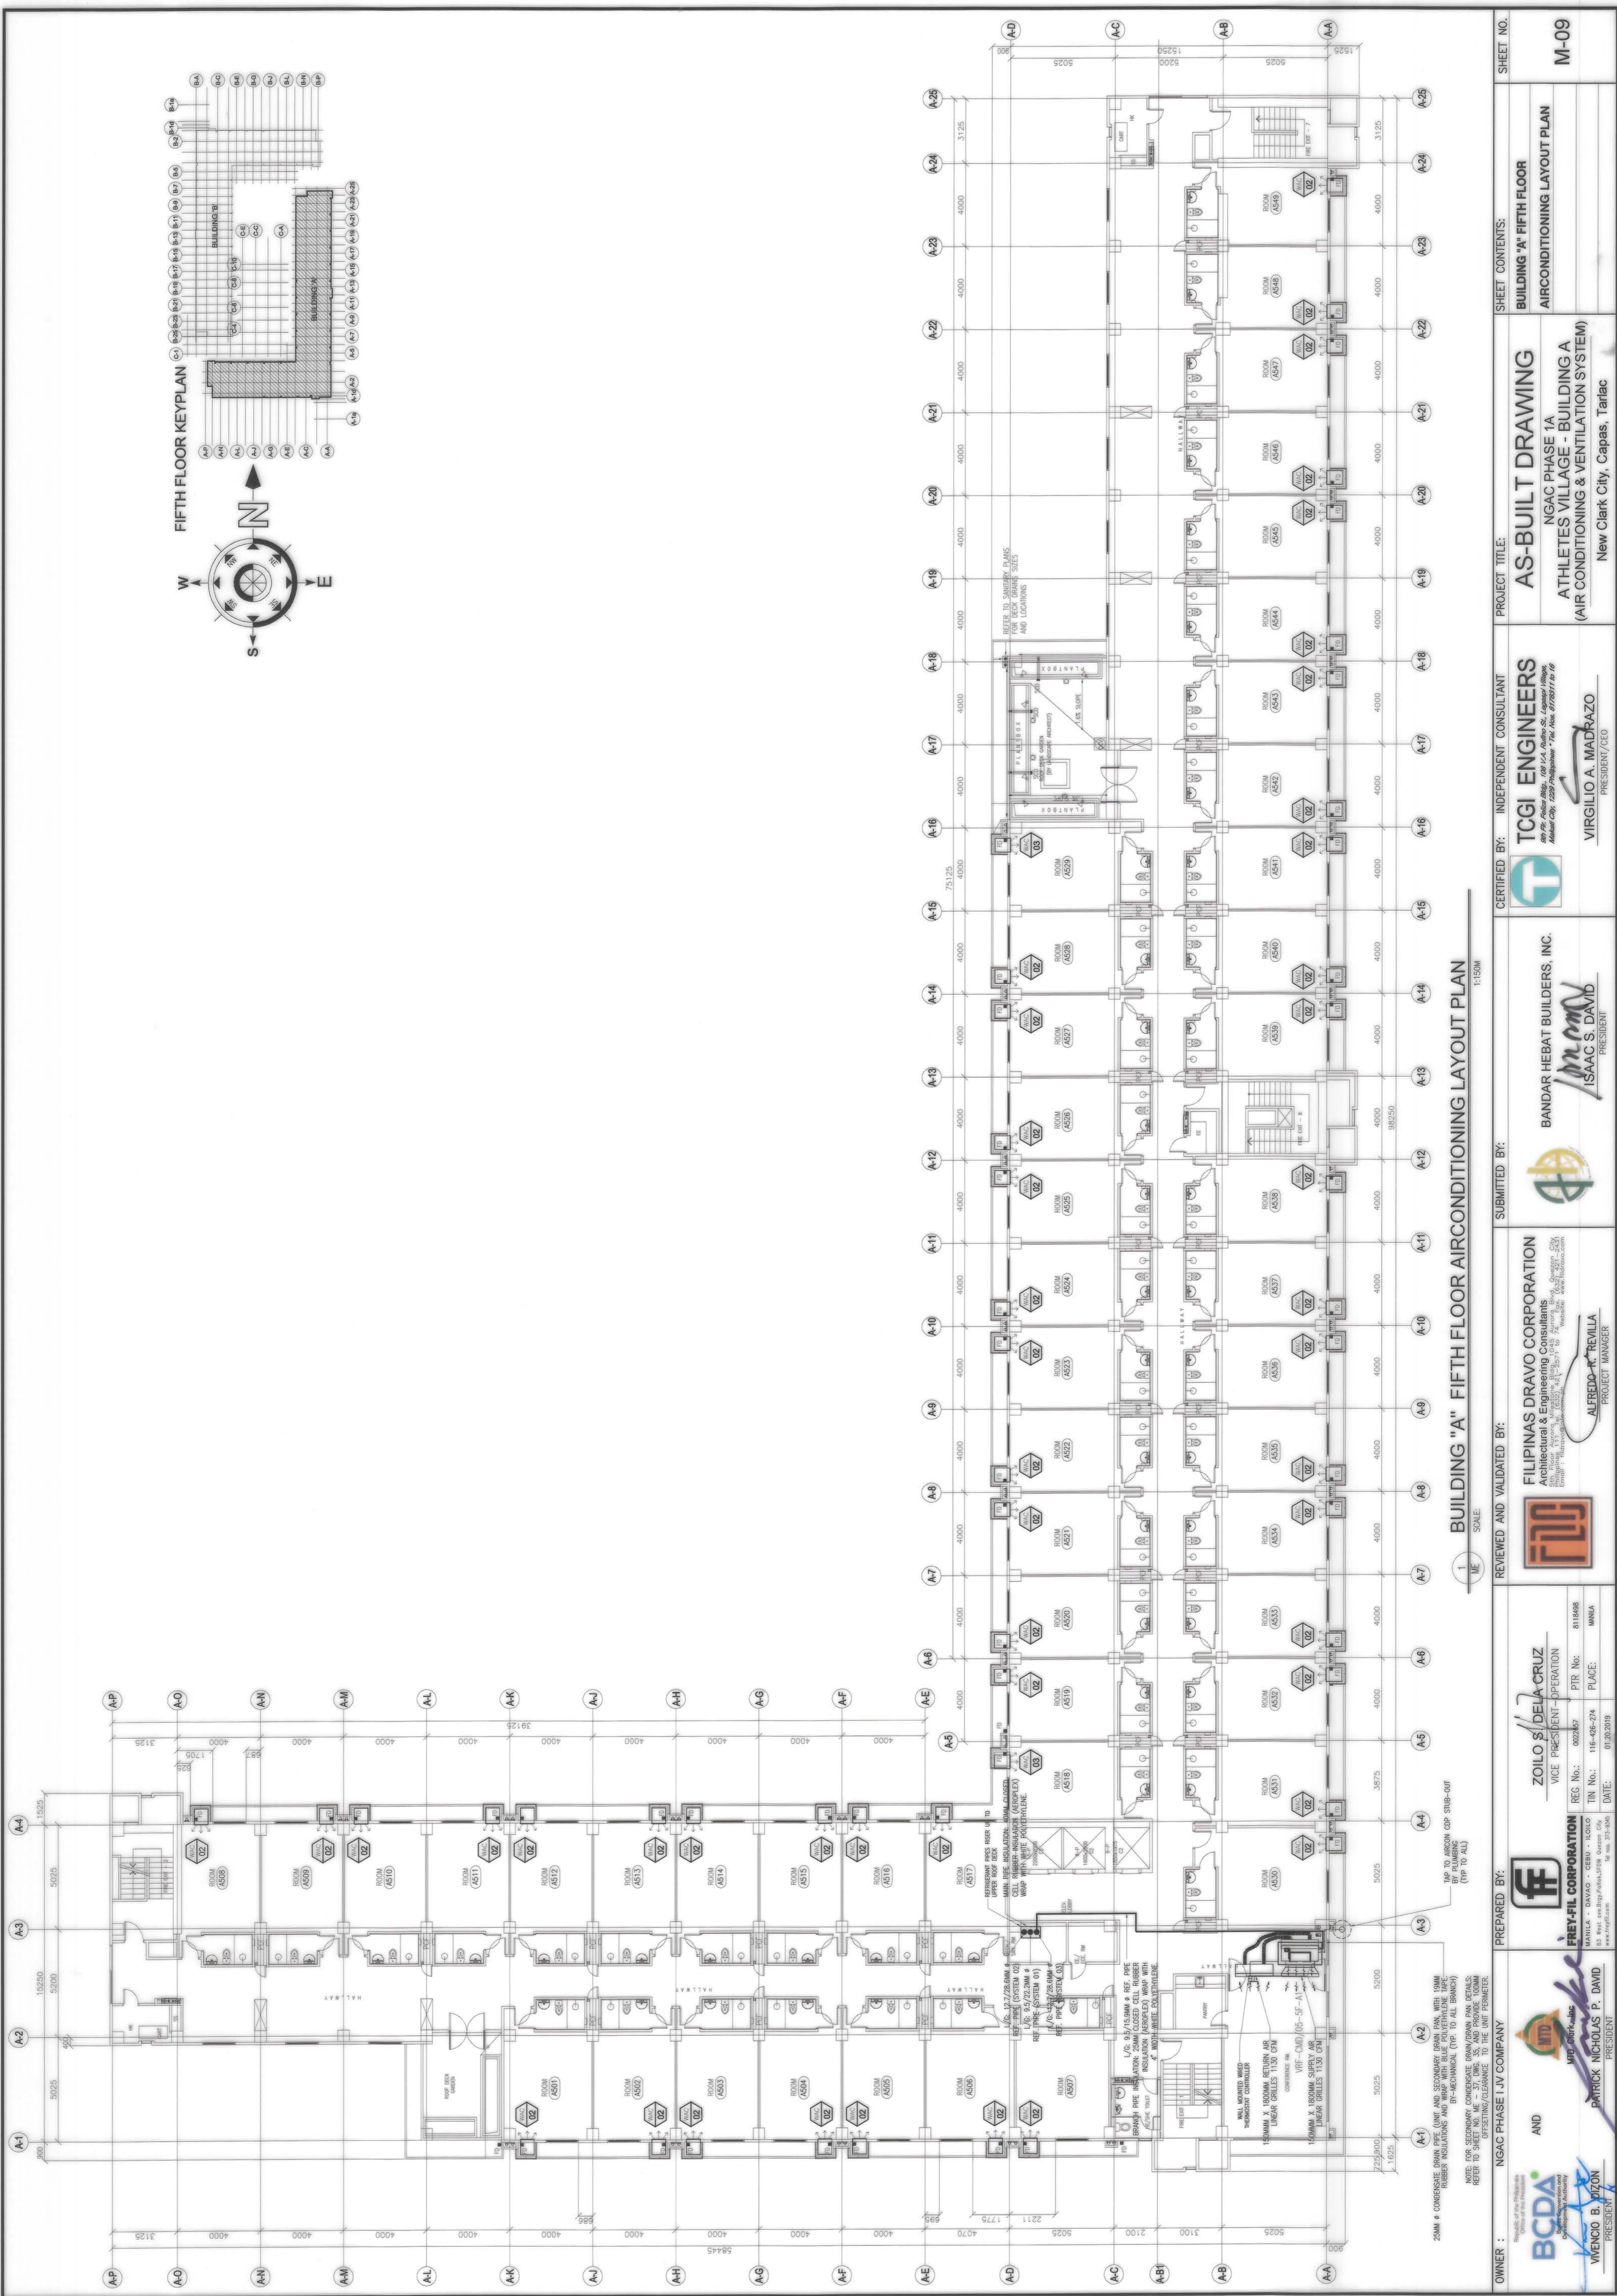

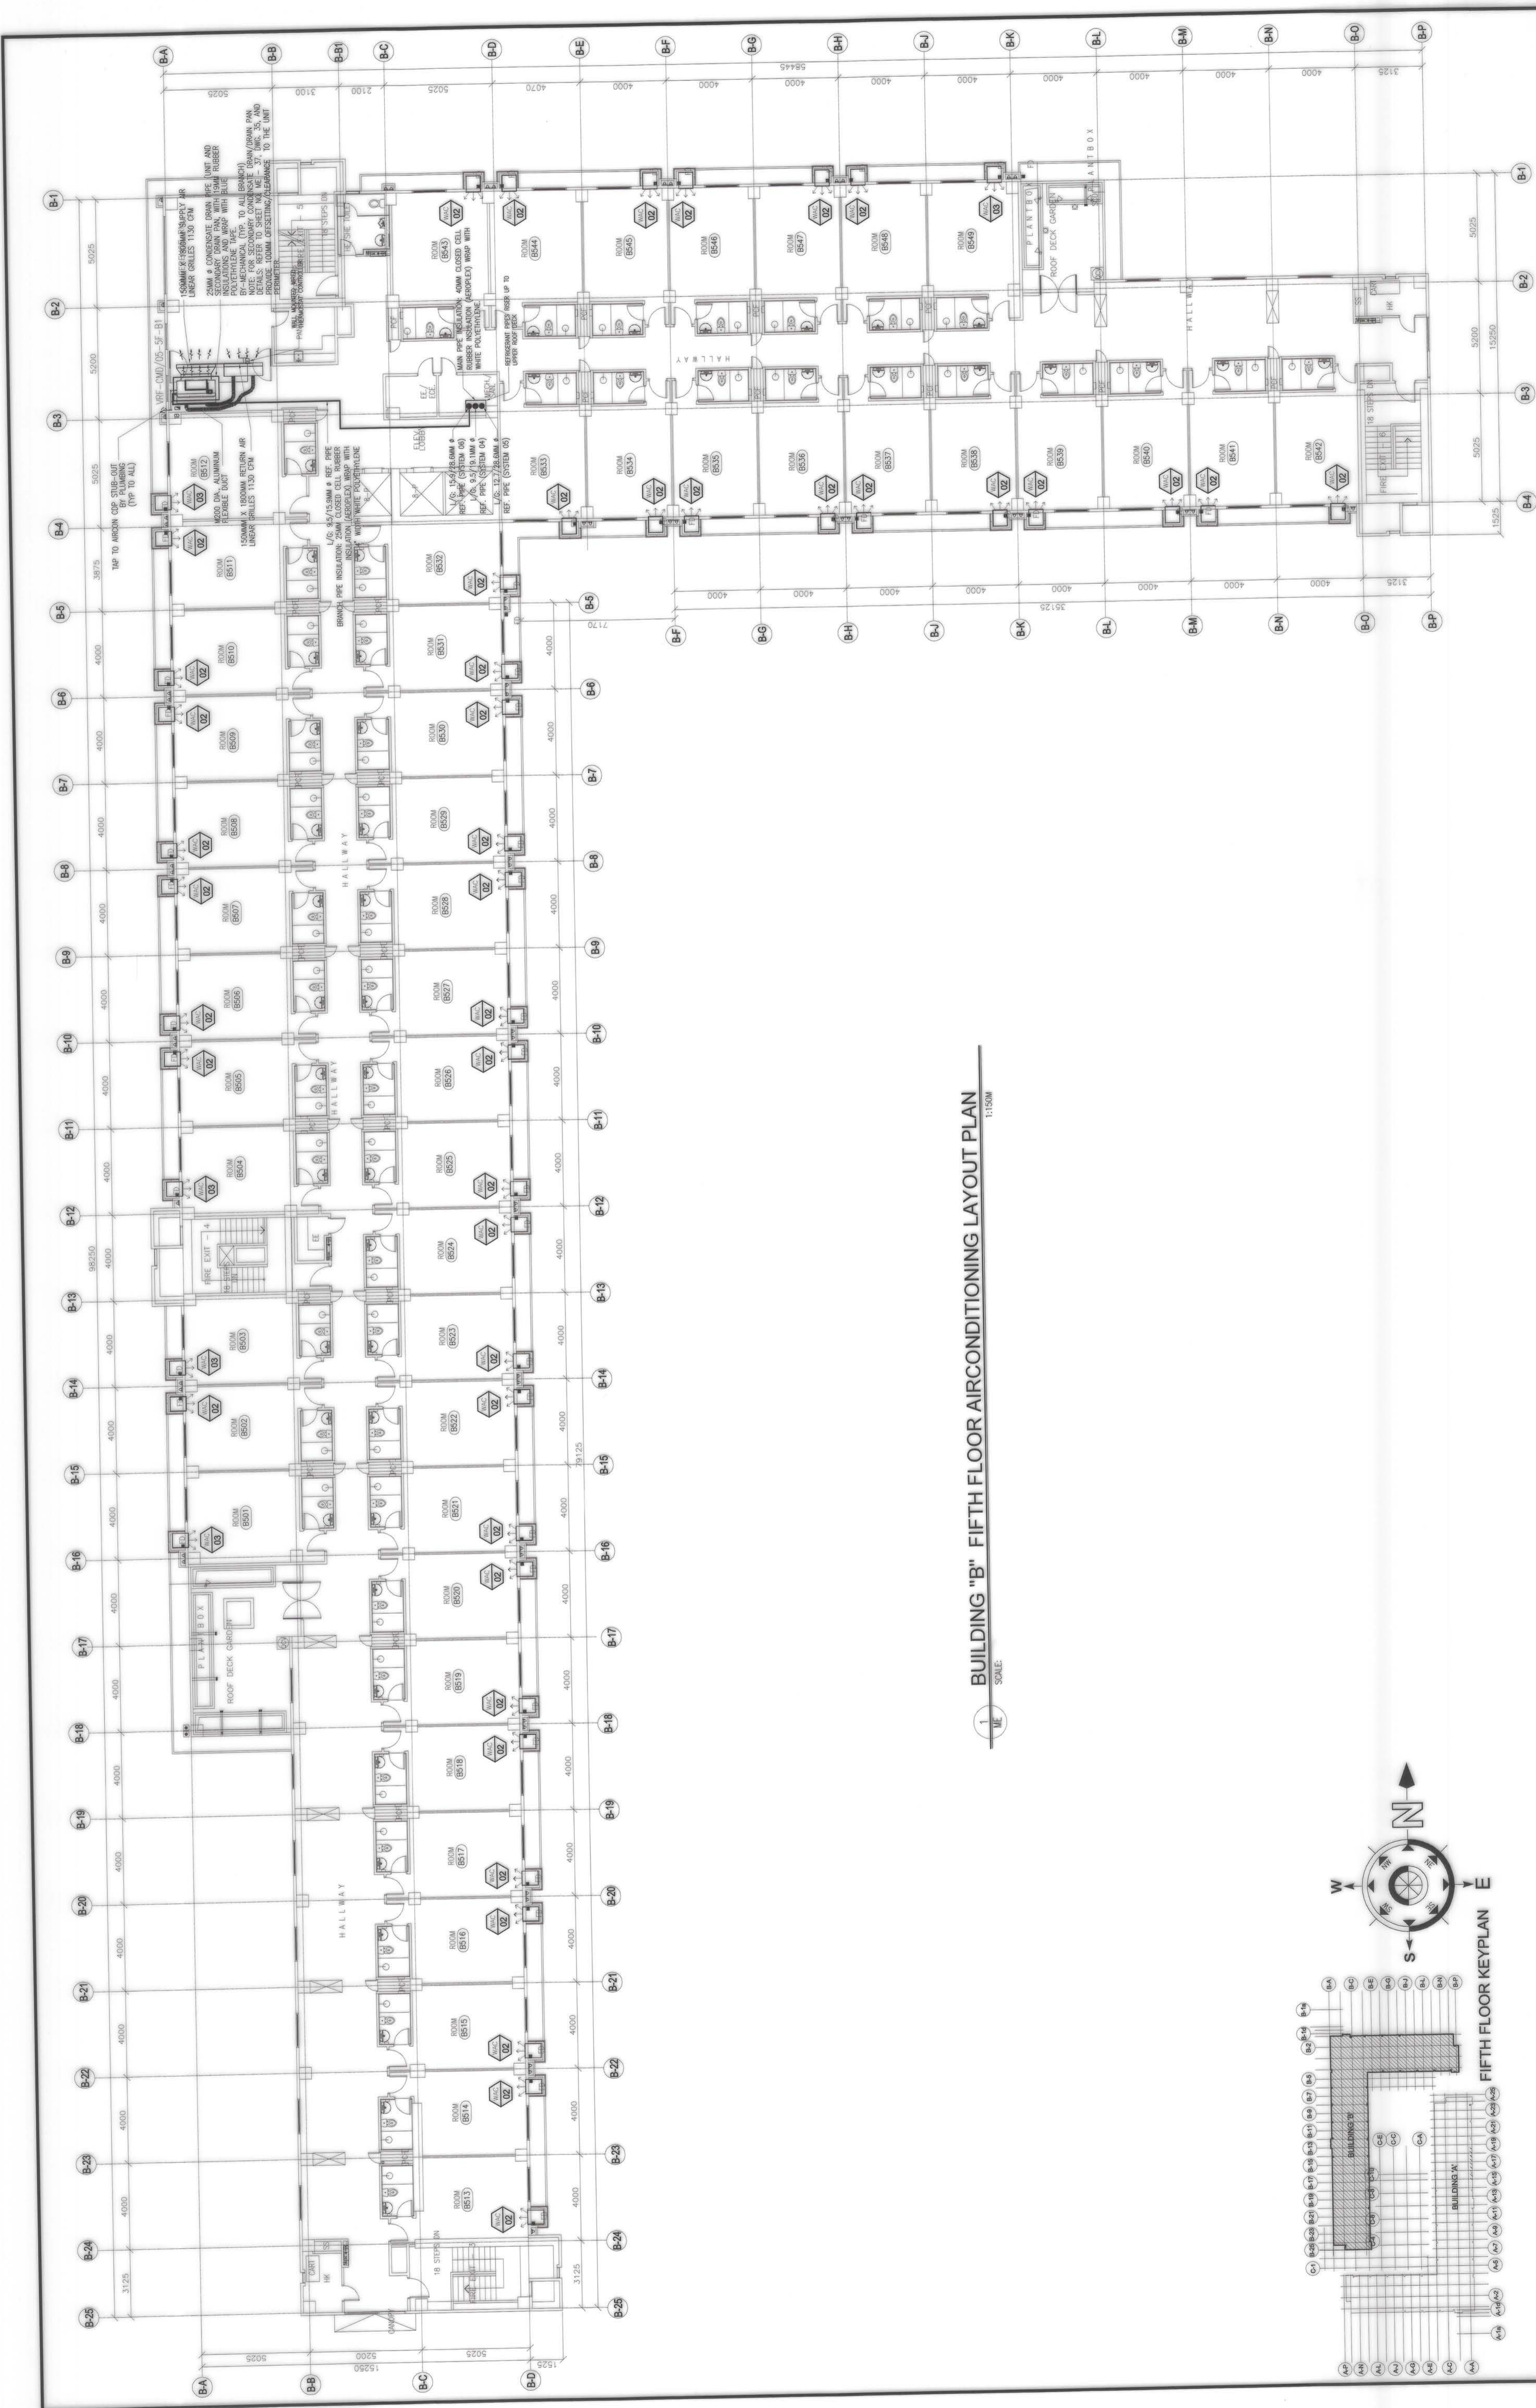


BUILDING "B" FIFTH FLOOR AIRCONDITIONING LAYOUT PLAN  
1:150M

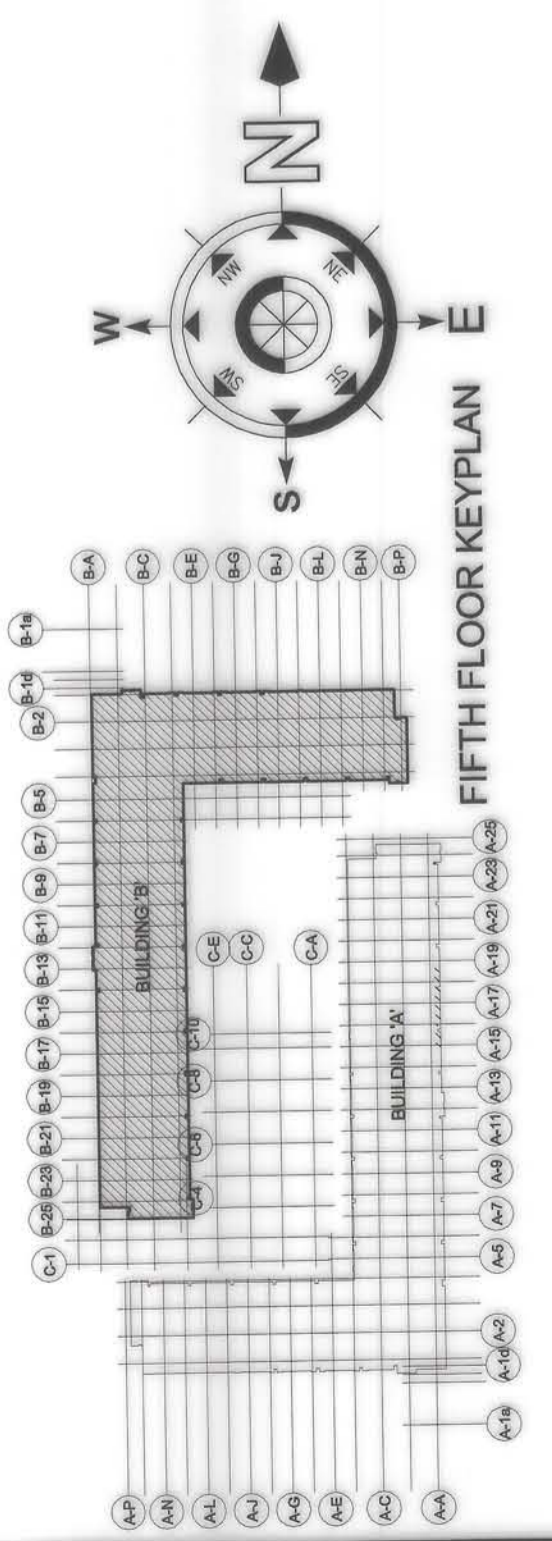




OWNER : NGAC PHASE I JV COMPANY		PREPARED BY: ZOILO S. DELA CRUZ VICE PRESIDENT-OPERATION		REVIEWED AND VALIDATED BY: FILIPINAS DRAVO CORPORATION Architectural & Engineering Consultants		SUBMITTED BY: BANDAR HEBAT BUILDERS, INC.		CERTIFIED BY: INDEPENDENT CONSULTANT TCGI ENGINEERS		PROJECT TITLE: AS-BUILT DRAWING NGAC PHASE 1A ATHLETES VILLAGE - BUILDING B (AIR CONDITIONING & VENTILATION SYSTEM)		SHEET NO. M-10	
VENCIO B. UYON PRESIDENT		AND PATRICK NICHOLAS P. DAVID PRESIDENT		ALFREDO B. REVILLA PROJECT MANAGER		ISAAC S. DAVID PRESIDENT		VIRGILIO A. MADRAZO PRESIDENT/CEO		New Clark City, Capas, Tarlac			



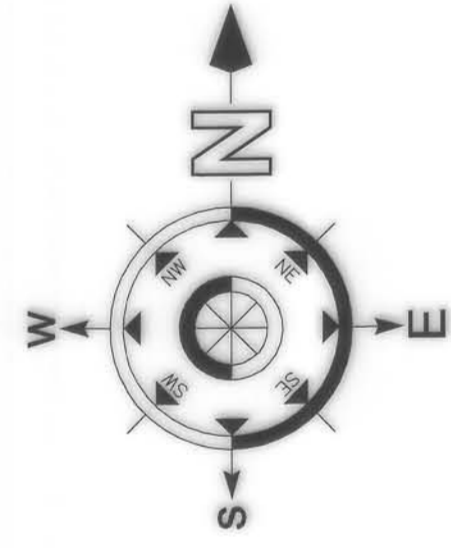





OWNER :	NGAC PHASE I JV COMPANY	PREPARED BY:	FREY-FIL CORPORATION MANILA • SAKAY • GEBU • LOLOLO TEL: 02-8592-1000 • FAX: 02-8592-1001 E-MAIL: info@frey-fil.com • www.frey-fil.com		REG. No.:	0028697	PIR No.:	8116488
	 Bureau of the Capital Development Authority Office of the President	 JTC Corp. Inc.	AND	 JTC Corp. Inc.				
	 PATRICK NICHOLAS P. DAVID PRESIDENT	 VIVENCIO B. DIZON PRESIDENT						
						</		





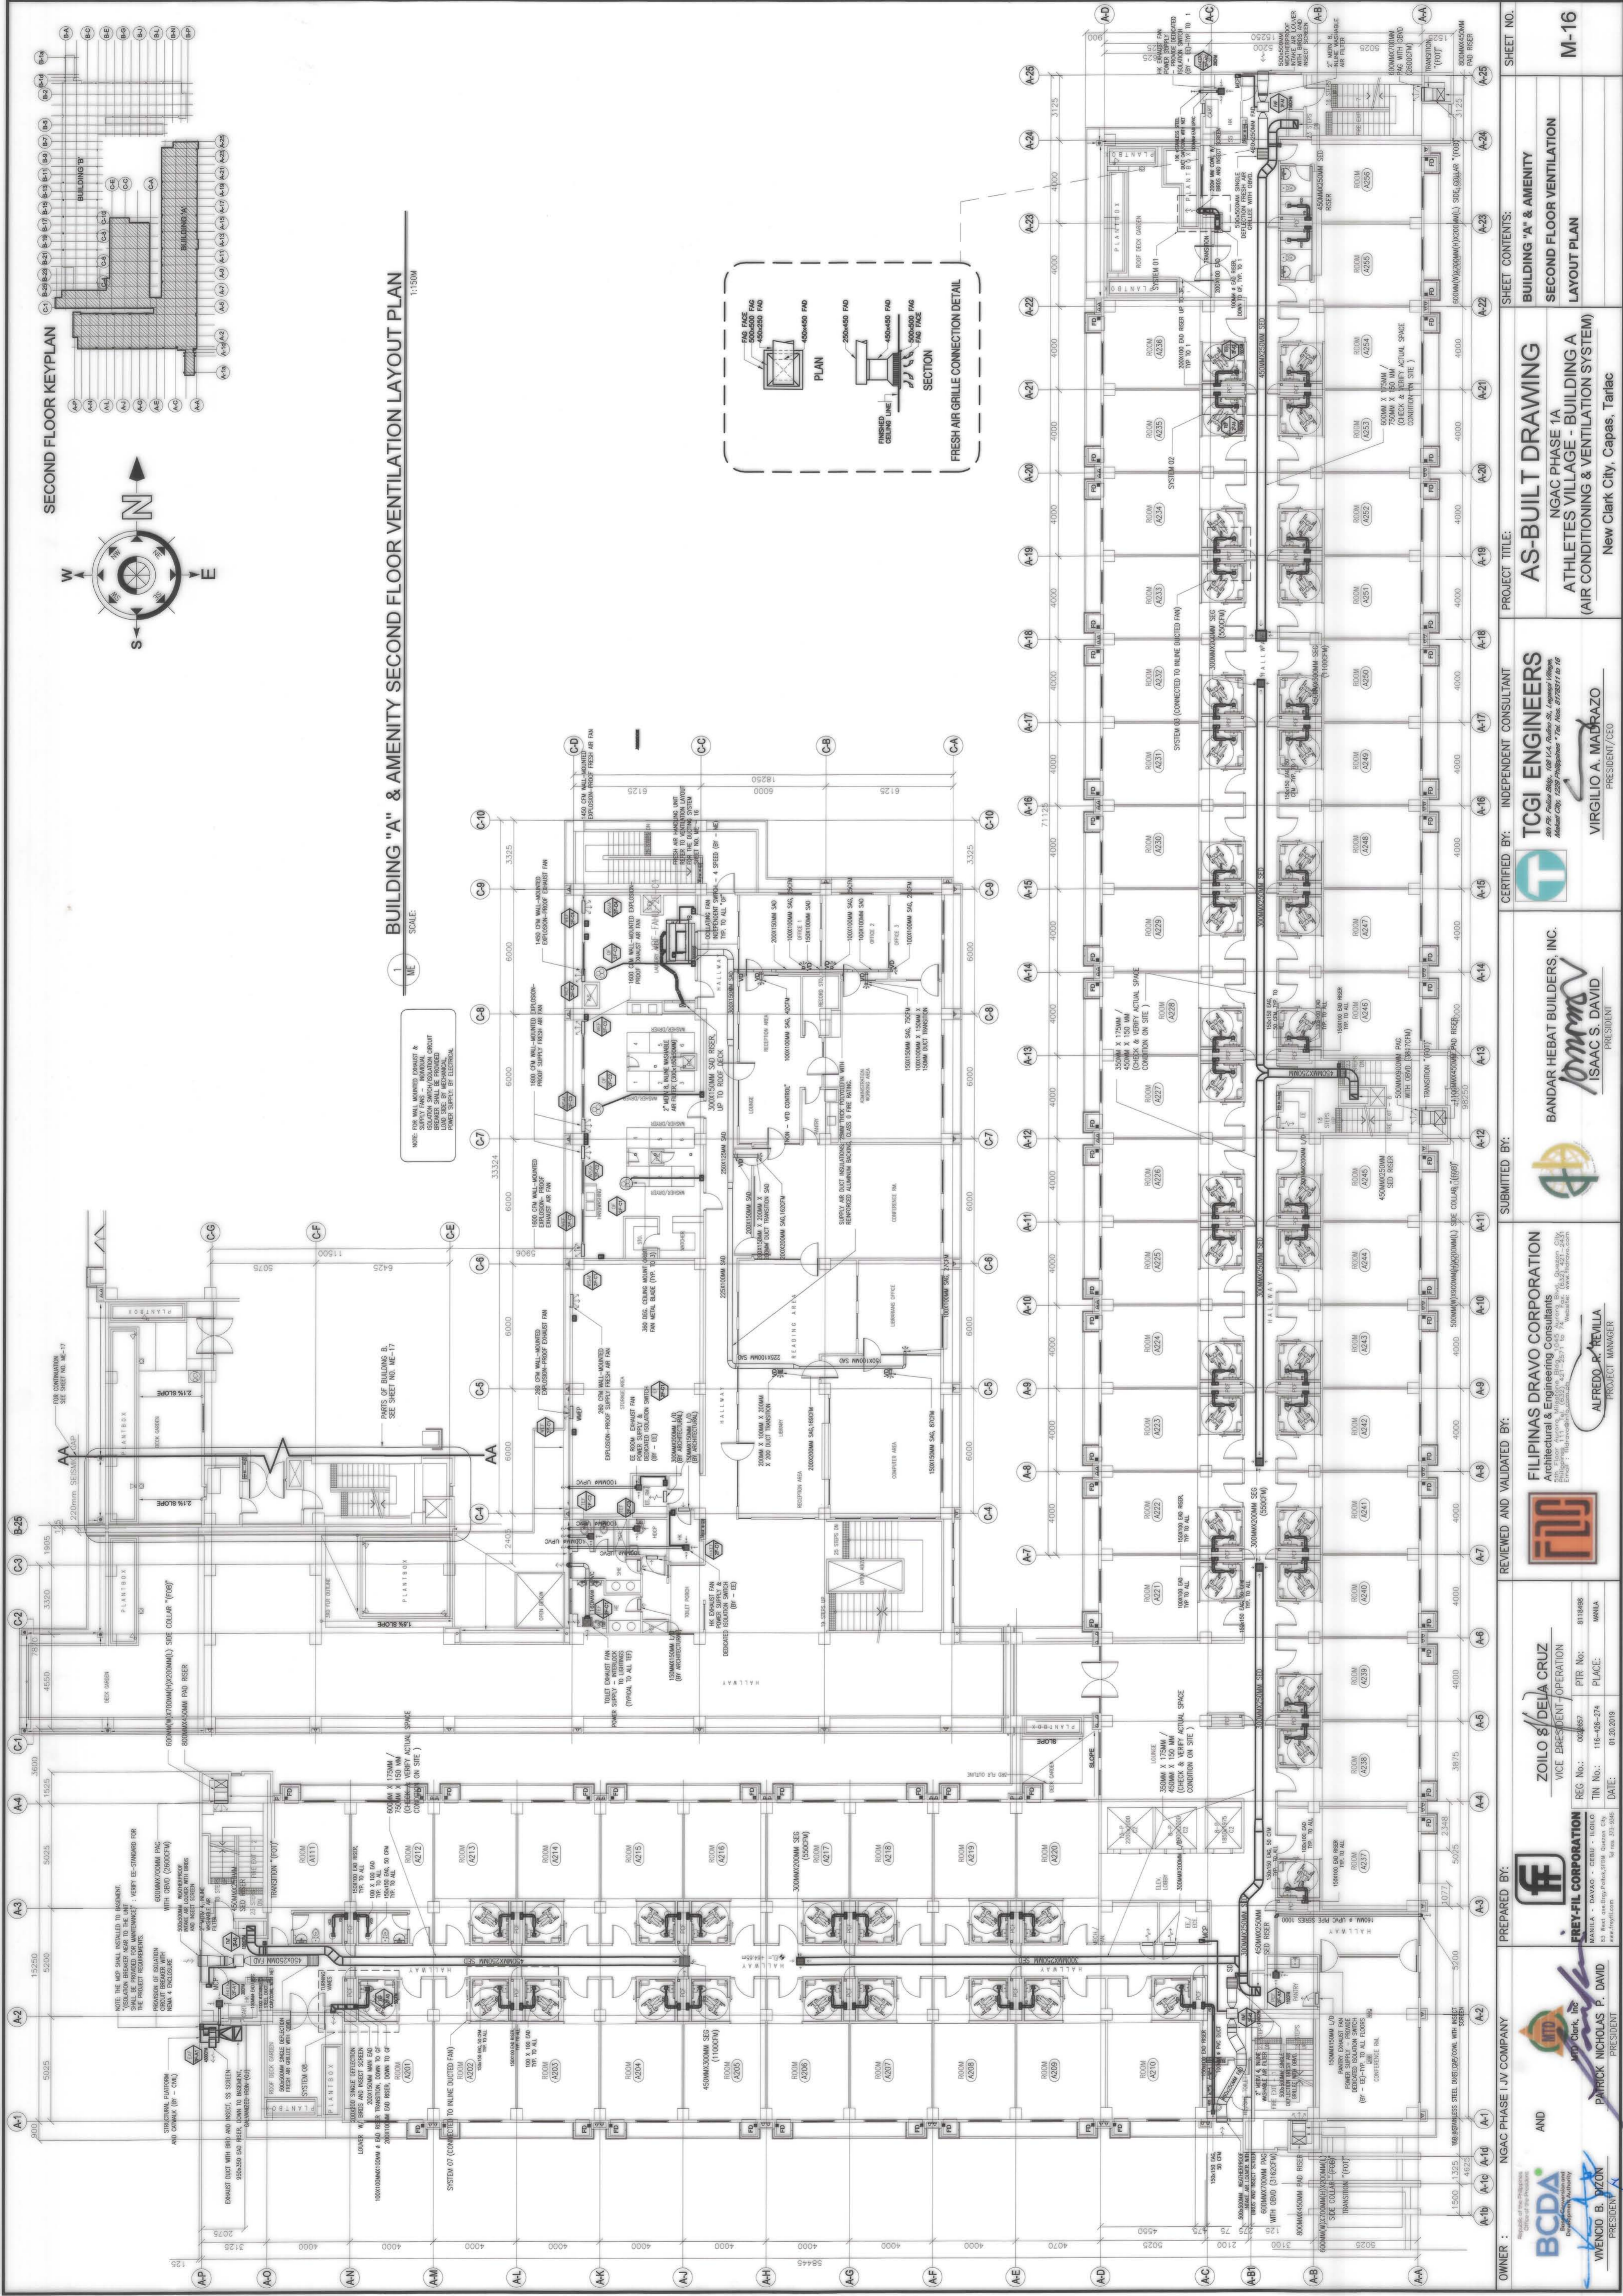



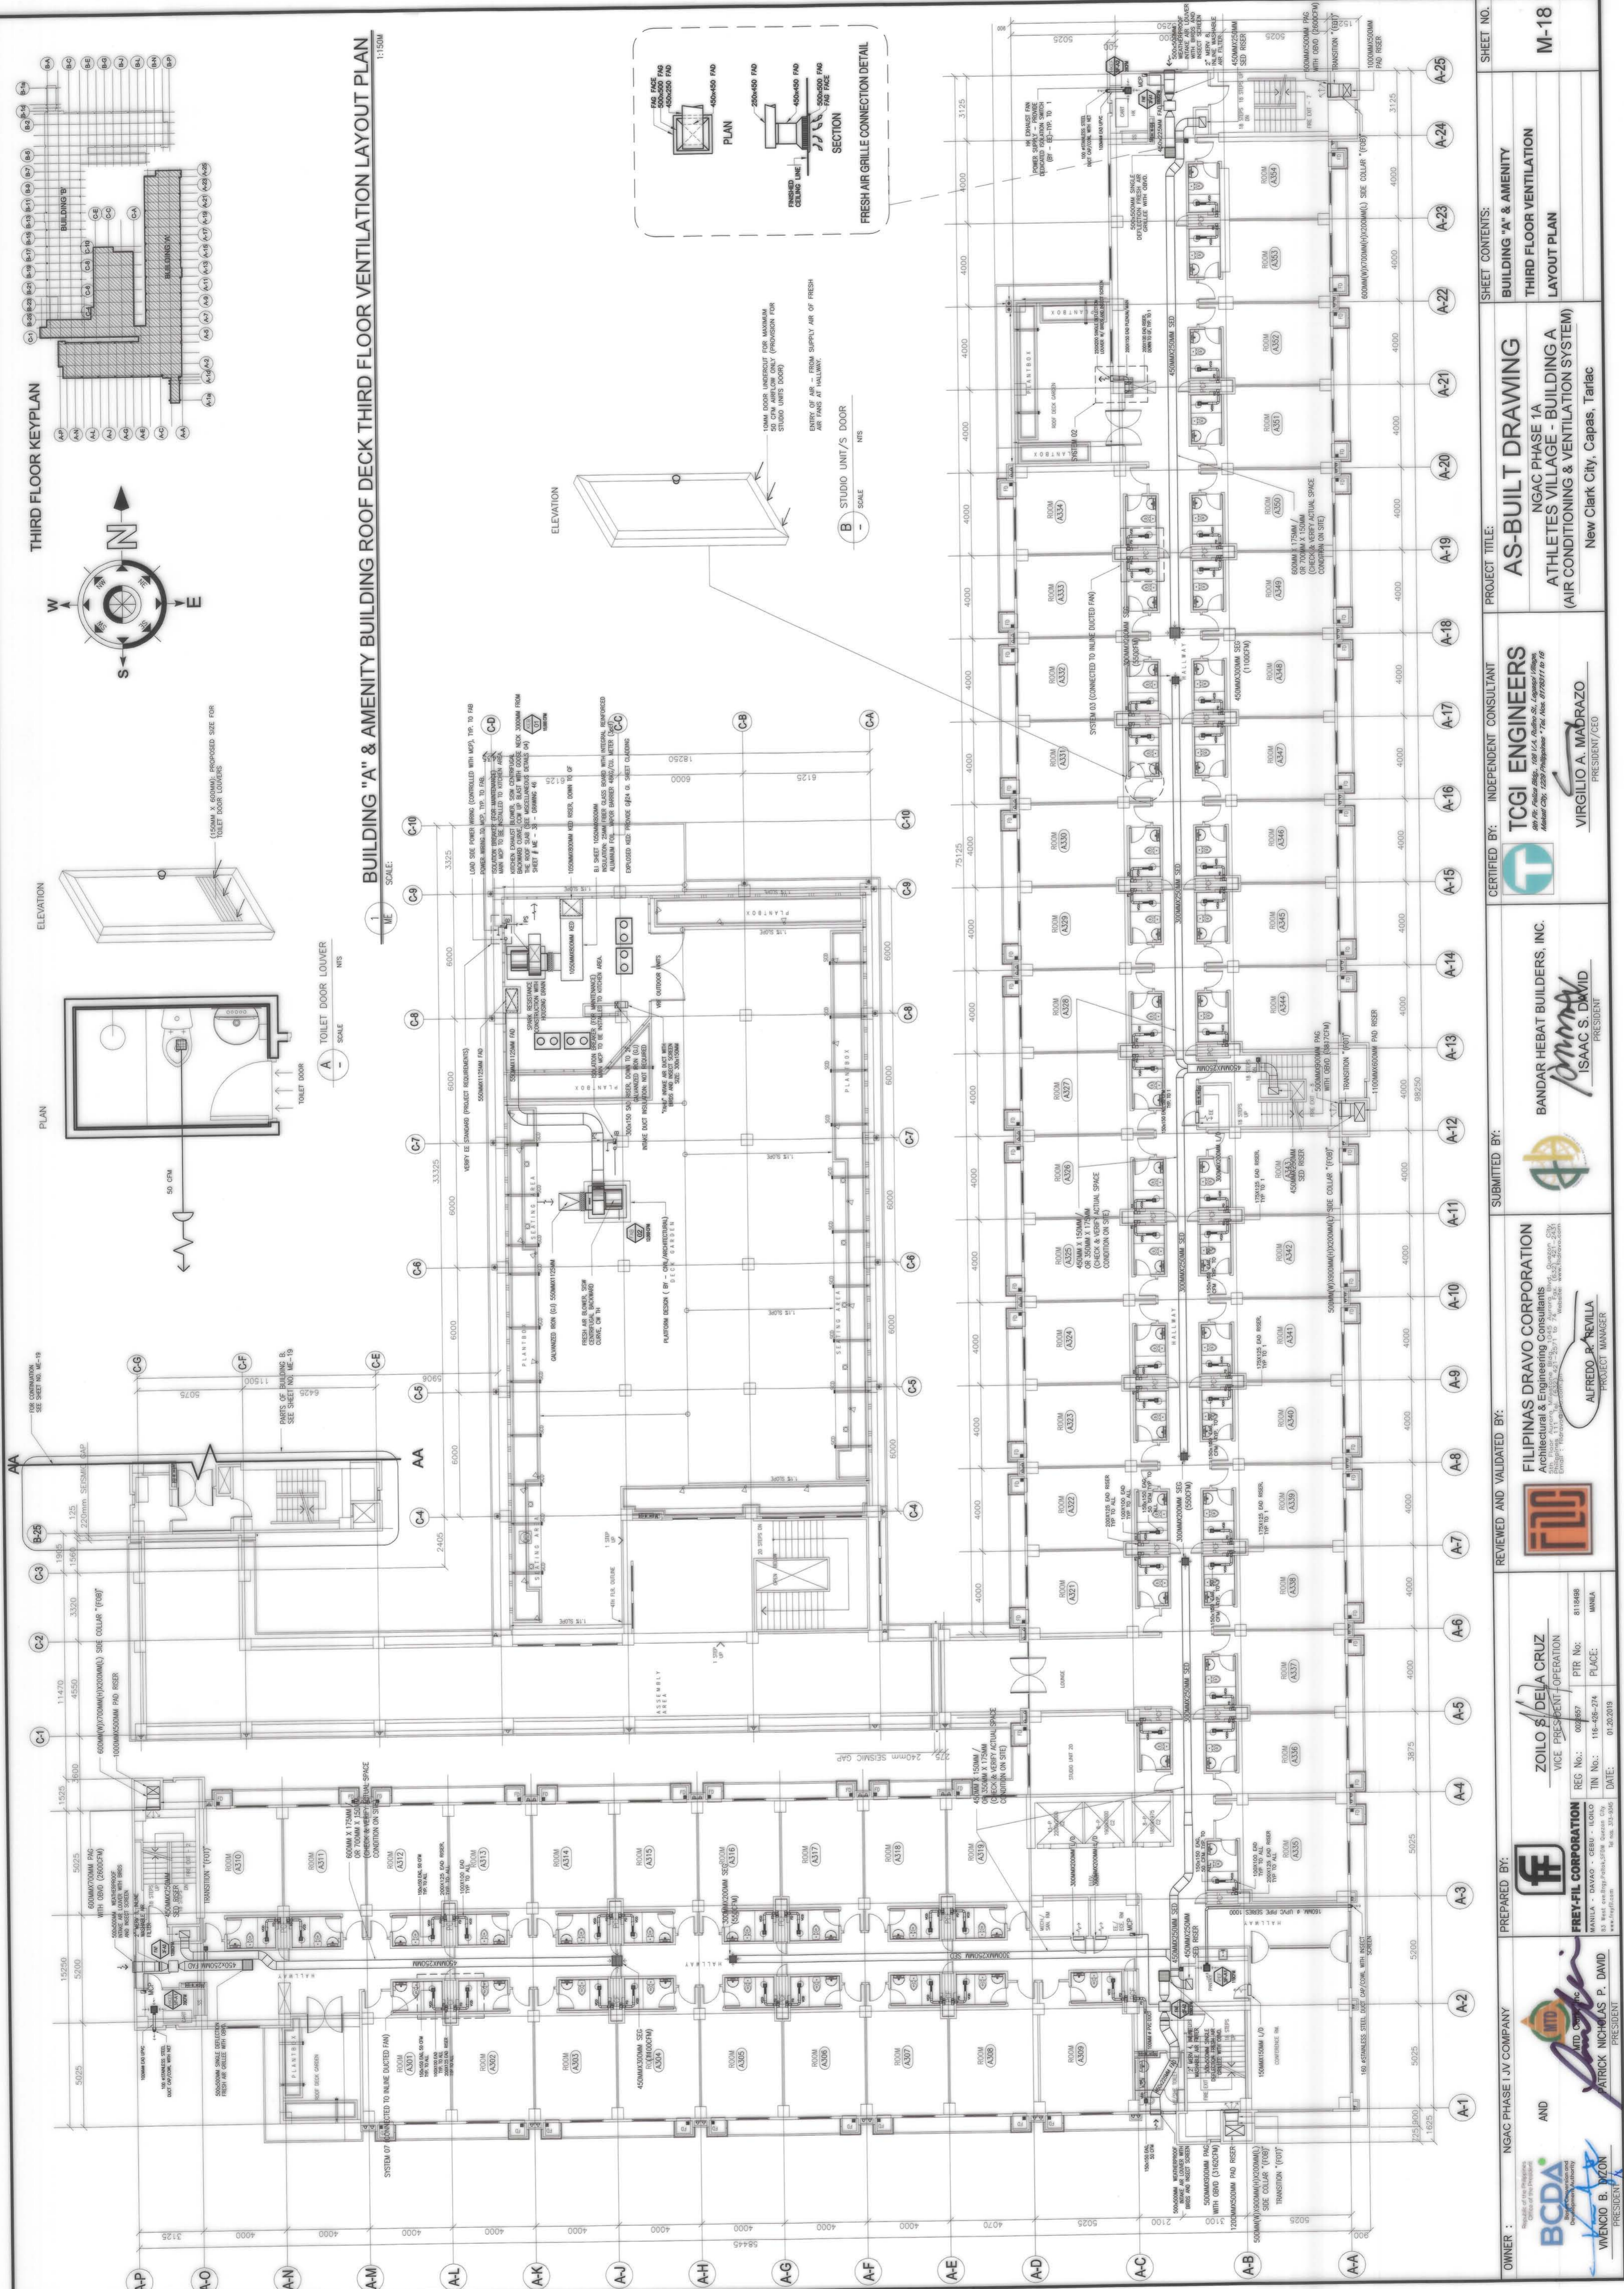














OWNER :	NGAC PHASE 1 JV COMPANY			PREPARED BY:	 <b>FREY-FIL CORPORATION</b> MANILA - DAVAO - CEBU - ILOILO 85 West, over Regal Mall, 5th Street, City For more info, visit: <a href="http://www.freyfil.com">www.freyfil.com</a>			REG. NO.: 009857 PIR. NO: 01144808 DATE: 01-20-2019 PLACE: MANILA			REVIEWED AND VALIDATED BY:	 <b>FILIPINAS DRAVO CORPORATION</b> Architectural & Engineering Consultants Filinvest Corporate City - Alabang, 2301 P.O. Box 100, Alabang, Muntinlupa City, 1780 Phone: (02) 885-1111 to 885-1115 Fax: (02) 885-1116 to 885-1117 E-mail: <a href="mailto:info@fdr.com.ph">info@fdr.com.ph</a>			SUBMITTED BY:	 <b>BANDAR HEBAT BUILDERS, INC.</b>  <b>ISAAC S. DAVID</b> PRESIDENT			CERTIFIED BY:	 <b>TCGI ENGINEERS</b> Independent Consultant Makam 20th, 2288 Pongpang, 7th Ave. 4770117-19			PROJECT TITLE:	AS-BUILT DRAWING NGAC PHASE 1A ATHLETES VILLAGE - BUILDING A (AIR CONDITIONING & VENTILATION SYSTEM)			SHEET NO.	M-18
	AND				 <b>BCDA</b> Bureau of Construction, Design and Architecture Department of Public Works and Highways			 <b>PATRICK NICHOLAS P. DAVID</b> PRESIDENT				 <b>WENCIO B. BIZON</b> PRESIDENT				New Clark City, Capas, Tarlac												

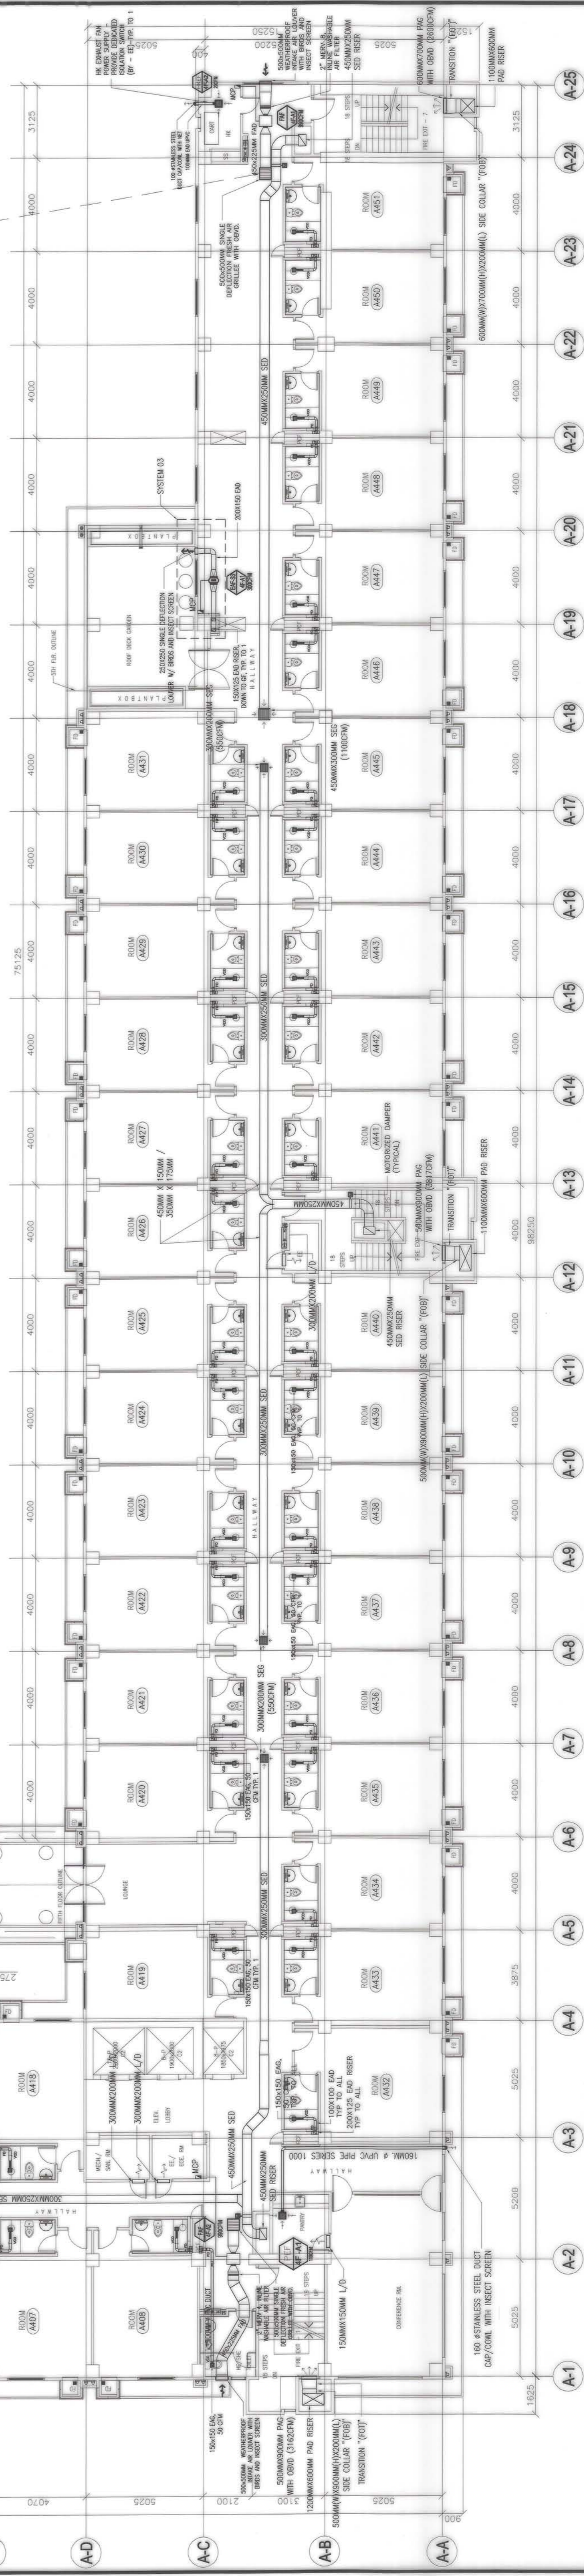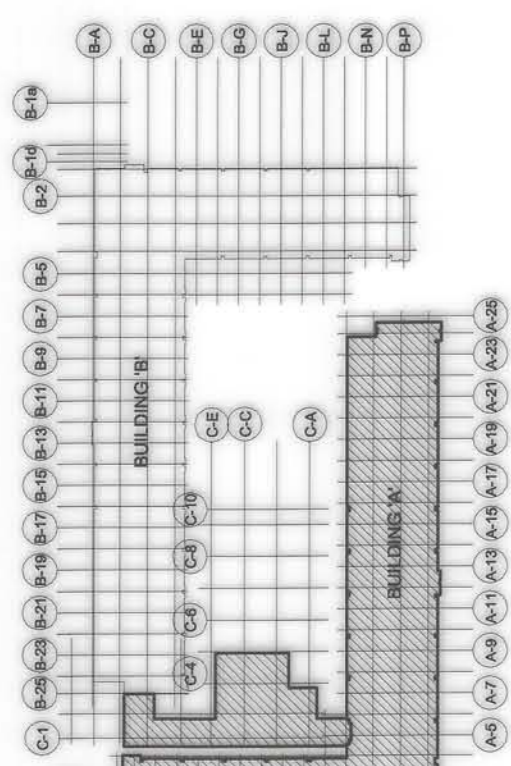





OWNER :	NGAC PHASE I JV COMPANY	PREPARED BY:	 <p><b>FREY-FIL CORPORATION</b>          REG. NO.: 002657          MANILA - DAVAO - CEBU - LOLOLO          85 Real Estate Plaza, 5th Floor, Ortigas City          Tel. no. 875-5566          www.freyfil.com</p>	REVIEWED AND VALIDATED BY:	 <p><b>FILIPINAS DRAVO CORPORATION</b>          Architectural &amp; Engineering Consultants          1117 Alibon Road, 11th Floor, Alibon Center, Alibon, Marikina City, 1800          Tel. no. 875-5566          www.freyfil.com</p>	SUBMITTED BY:	 <p><b>BANDAR HEBAT BUILDERS, INC.</b>    <b>ISAAC S. DAVID</b>          PRESIDENT</p>	CERTIFIED BY:	 <p><b>TCGI ENGINEERS</b>          389-7th Avenue Bldg., 108-1/4, Avenue St., Leganes Village          Marikina City, 1800          Tel. no. 875-5566</p>	PROJECT TITLE:	<p><b>AS-BUILT DRAWING</b>          NGAC PHASE 1A          ATHLETES VILLAGE - BUILDING A          (AIR CONDITIONING &amp; VENTILATION SYSTEM)</p>	SHEET CONTENTS:	<p><b>BUILDING "A" FOURTH FLOOR</b>  <b>VENTILATION LAYOUT PLAN</b></p>	SHEET NO.	<p><b>M-20</b></p>
OWNER :	NGAC PHASE I JV COMPANY	PREPARED BY:	 <p><b>FREY-FIL CORPORATION</b>          REG. NO.: 002657          MANILA - DAVAO - CEBU - LOLOLO          85 Real Estate Plaza, 5th Floor, Ortigas City          Tel. no. 875-5566          www.freyfil.com</p>	REVIEWED AND VALIDATED BY:	 <p><b>FILIPINAS DRAVO CORPORATION</b>          Architectural &amp; Engineering Consultants          1117 Alibon Road, 11th Floor, Alibon Center, Alibon, Marikina City, 1800          Tel. no. 875-5566          www.freyfil.com</p>	SUBMITTED BY:	 <p><b>BANDAR HEBAT BUILDERS, INC.</b>    <b>ISAAC S. DAVID</b>          PRESIDENT</p>	CERTIFIED BY:	 <p><b>TCGI ENGINEERS</b>          389-7th Avenue Bldg., 108-1/4, Avenue St., Leganes Village          Marikina City, 1800          Tel. no. 875-5566</p>	PROJECT TITLE:	<p><b>AS-BUILT DRAWING</b>          NGAC PHASE 1A          ATHLETES VILLAGE - BUILDING A          (AIR CONDITIONING &amp; VENTILATION SYSTEM)</p>	SHEET CONTENTS:	<p><b>BUILDING "A" FOURTH FLOOR</b>  <b>VENTILATION LAYOUT PLAN</b></p>	SHEET NO.	<p><b>M-20</b></p>

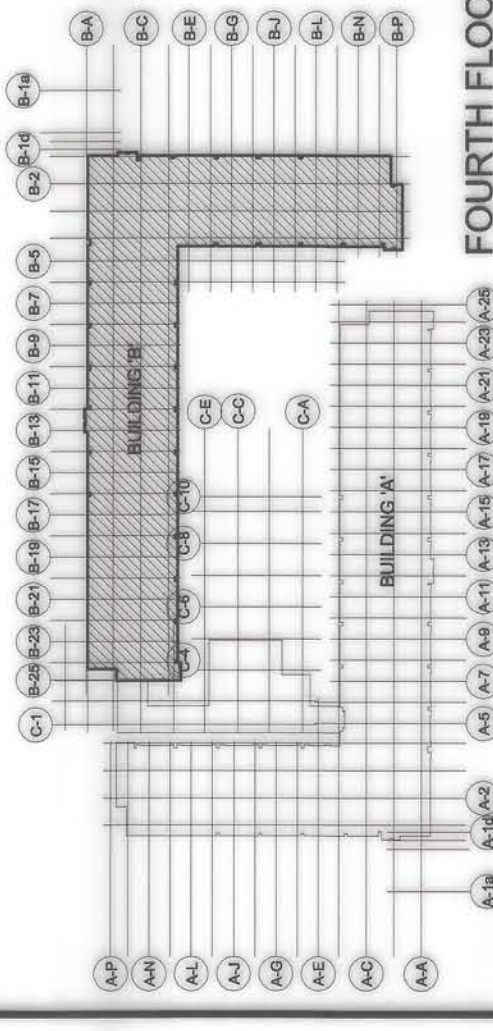


FOURTH FLOOR KEYPLAN

<p>OWNER: NSAC PHASE I JV COMPANY</p> <p>AND</p> <p>BCDA Baltimore County Department of Community and Economic Development Baltimore, Maryland</p> <p>WENICIO B. DIZON PRESIDENT</p>	<p>PREPARED BY:</p> <p> <b>FREY-FIL CORPORATION</b> 10000 W. WILSON AVE. SUITE 200 DALLAS, TEXAS 75243-2000 TEL: 972.355.2500 FAX: 972.355.2501 www.frey-fil.com</p> <p>REG. NO.: 0096507 PIR NO: 8188498</p> <p>DATE: 01/20/2018 PLACE: MANILA</p>	<p>REVIEWED AND VALIDATED BY:</p> <p> <b>FILIPINAS DRAVO CORPORATION</b> Architectural &amp; Engineering Consultants 10000 W. WILSON AVE. SUITE 200 DALLAS, TEXAS 75243-2000 TEL: 972.355.2500 FAX: 972.355.2501 www.frey-fil.com</p> <p>ALFREDO R. REVILLA PROJECT MANAGER</p>	<p>SUBMITTED BY:</p> <p> <b>BANDAR HEBAT BUILDERS, INC.</b></p> <p>ISAAC S. DAVID PRESIDENT</p>	<p>CERTIFIED BY:</p> <p> <b>TCGI ENGINEERS</b> 800 P.O. BOX 10000, 1001 U.S. ROUTE 32, SUITE 10000 HOUSTON, TEXAS 77058-1000 TEL: 281.488.7171 FAX: 281.488.7172</p> <p>VIRGLIO A. MADRAZO PRESIDENT/CEO</p>	<p>PROJECT TITLE:</p> <p><b>AS-BUILT DRAWING</b></p> <p>NSAC PHASE 1A ATHLETES VILLAGE - BUILDING B (AIR CONDITIONING &amp; VENTILATION SYSTEM)</p> <p>New Clark City, Capas, Tarlac</p>	<p>SHEET CONTENTS:</p> <p><b>BUILDING "B" FOURTH FLOOR</b></p> <p><b>VENTILATION LAYOUT PLAN</b></p>	<p>SHEET NO.</p> <p><b>M-21</b></p>
--	--	--	--	---	--	--	-------------------------------------

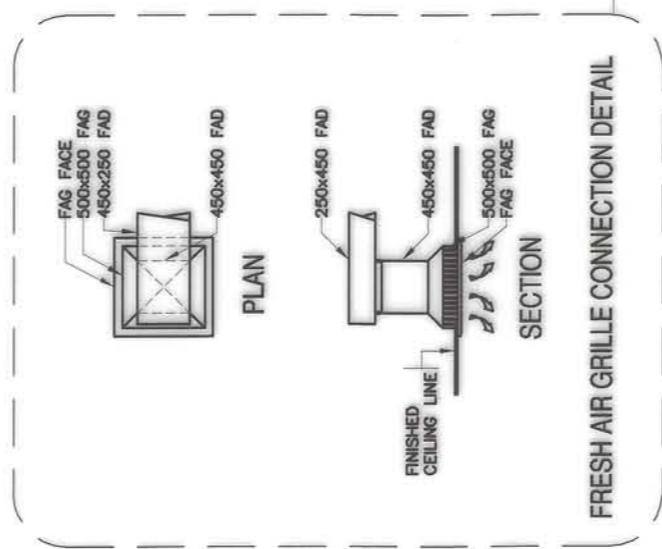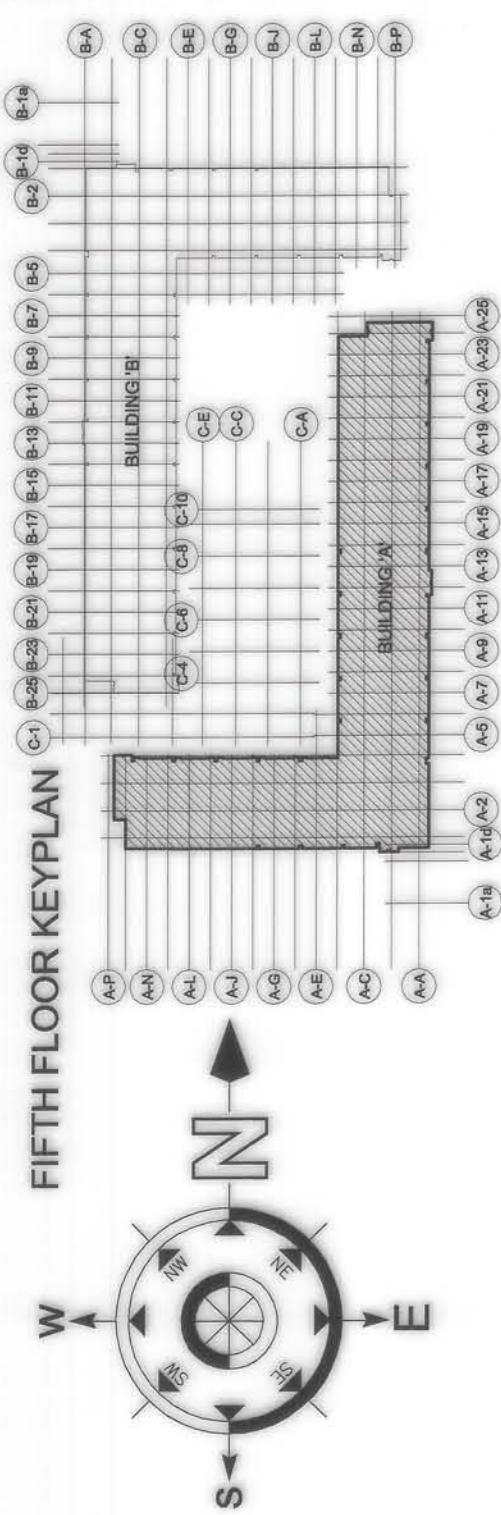

ENLARGE PLAN DETAILS OF TOILET EXHAUST AIR GRILLE AND BRANCH  
DUCT TYPICAL TO ALL FLOOR

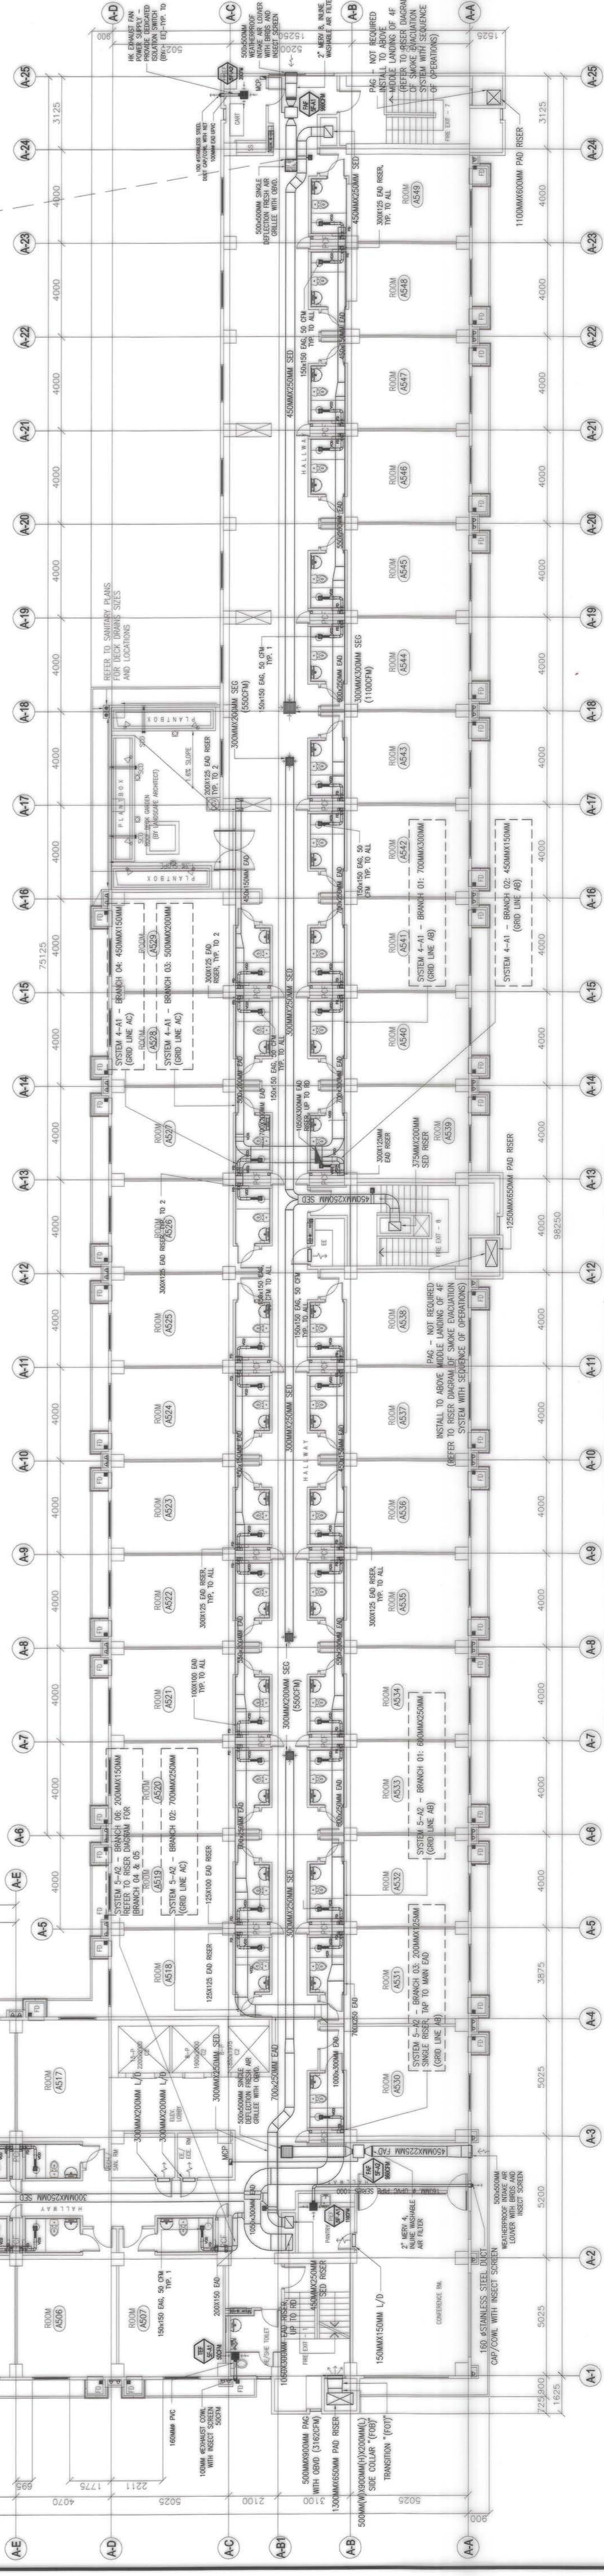


1 BUILDING "A" FIFTH FLOOR VENTILATION LAYOUT PLAN


[illegible]






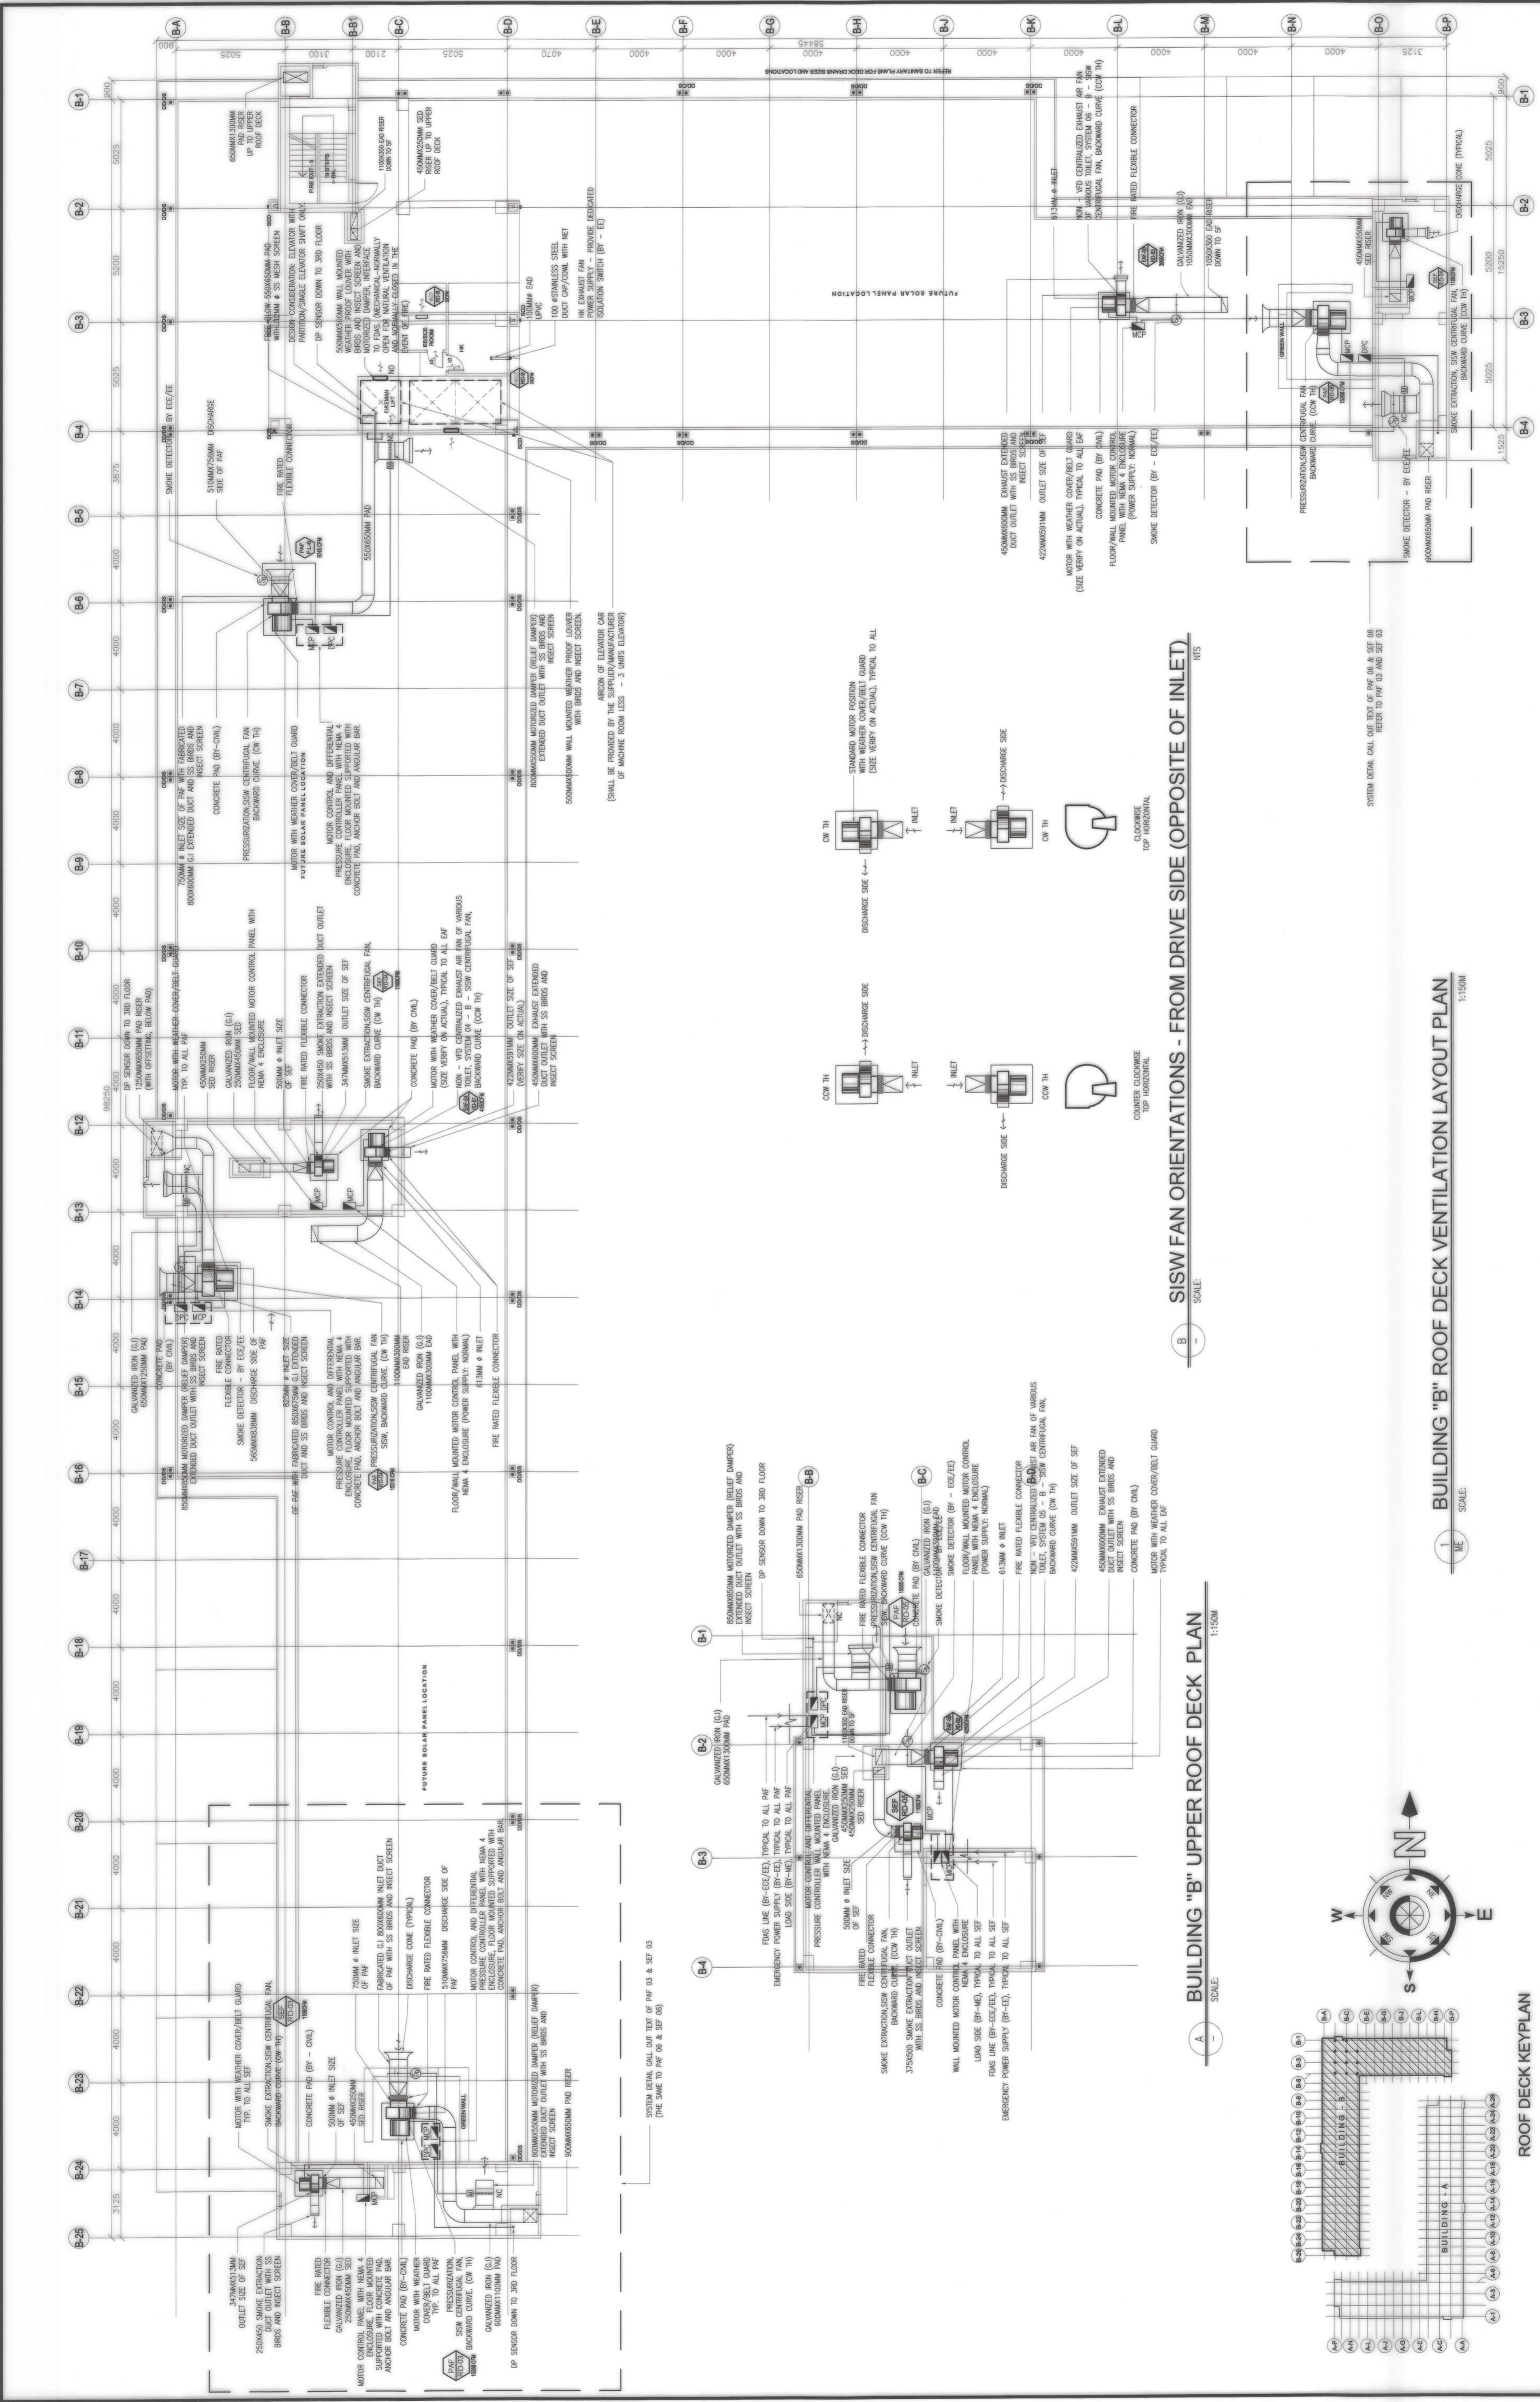


OWNER : NGAC PHASE 1 JV COMPANY		PREPARED BY:  <b>FREY-FIL CORPORATION</b> REG. NO. 082687 PTR NO. 8118488 MANTUA - CEBU - ILOILO TIN NO. 116-426-274 DATE: 01-20-2019 www.frey-fil.com Tel. nos. 233-3345		REVIEWED AND VALIDATED BY:  <b>FILIPINAS DRAVO CORPORATION</b> Architectural & Engineering Consultants 1000 N. ZION AVE. 2ND FLOOR SUITE 202, DAVAO CITY TEL. 082-220-2533 WWW.FILIPINAS-DRAVO.COM		SUBMITTED BY:  <b>BANDAR HEBAT BUILDERS, INC.</b> Architectural & Engineering Consultants 1000 N. ZION AVE. 2ND FLOOR SUITE 202, DAVAO CITY TEL. 082-220-2533 WWW.BHBI.COM		CERTIFIED BY:  <b>TCGI ENGINEERS</b> 899 PFE, PULUTAN BLDG., 108 P.A. RUFFALO ST., JAGORAN MINGOS JAGORAN, CEBU TEL. 031-777-1176		PROJECT TITLE: <b>AS-BUILT DRAWING</b> NGAC PHASE 1A ATHLETES VILLAGE - BUILDING B (AIR CONDITIONING & VENTILATION SYSTEM) New Clark City, Capas, Tarlac		SHEET CONTENTS: <b>BUILDING "B" ROOF DECK VENTILATION LAYOUT PLAN</b>		SHEET NO. <b>M-25</b>	
AND  <b>BCDA</b> Regional Office of the Philippine Board of Civil Engineers Office of the President 1000 N. ZION AVE. 2ND FLOOR SUITE 202, DAVAO CITY TEL. 082-220-2533 WWW.BCDA-CEP.COM		 <b>VENCIO B. OJON</b> PRESIDENT		 <b>PATRICK NICHOLAS P. DAVID</b> PRESIDENT											

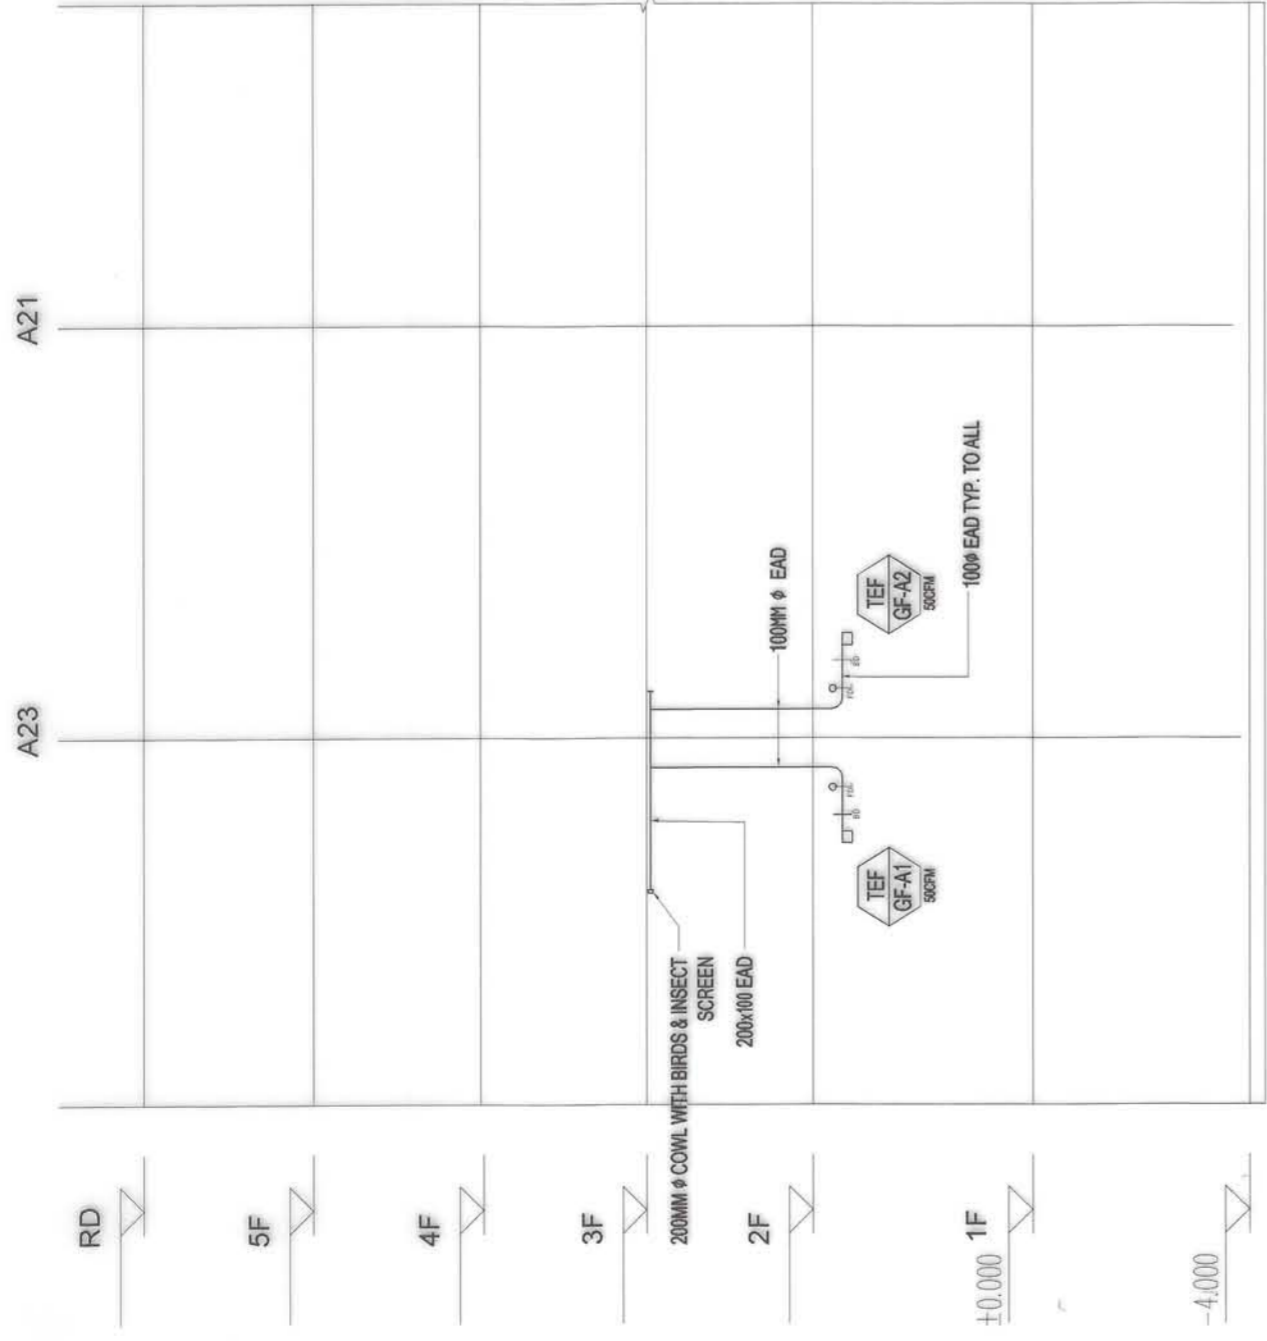


SYSTEM 01 - EAD RISER DIAGRAM  
(50CFM X 2 UNITS TEF)  
BLDG. A

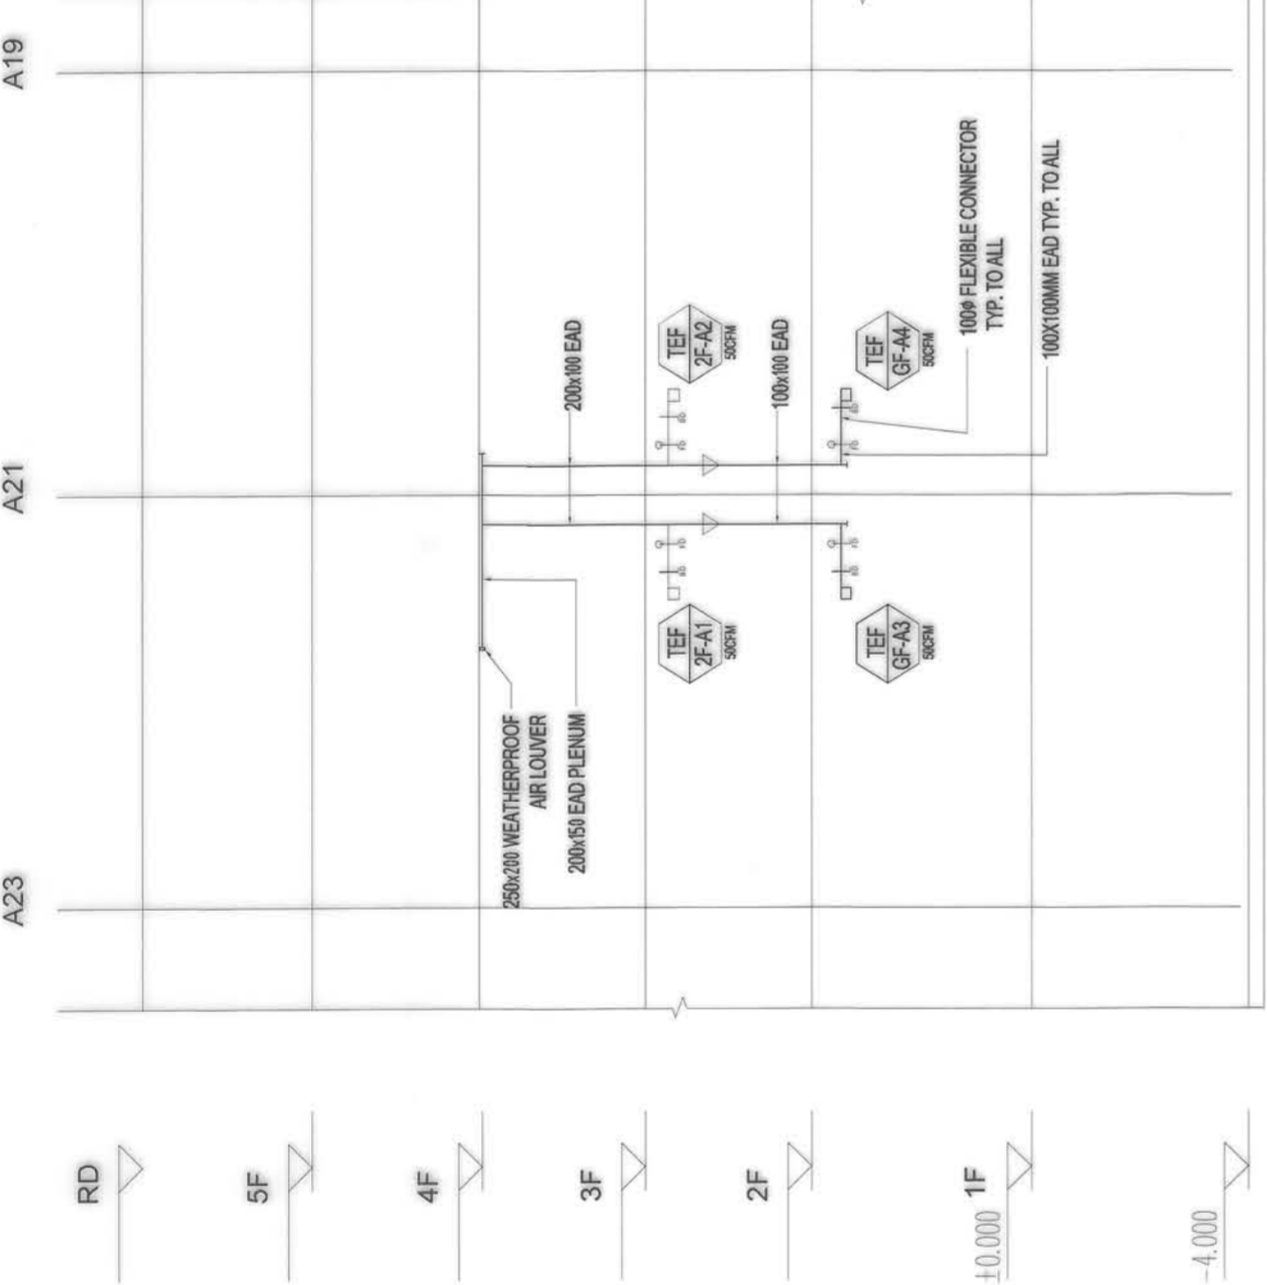


SYSTEM 02 - EAD RISER DIAGRAM  
(50CFM X 4 UNITS TEF)  
BLDG. A

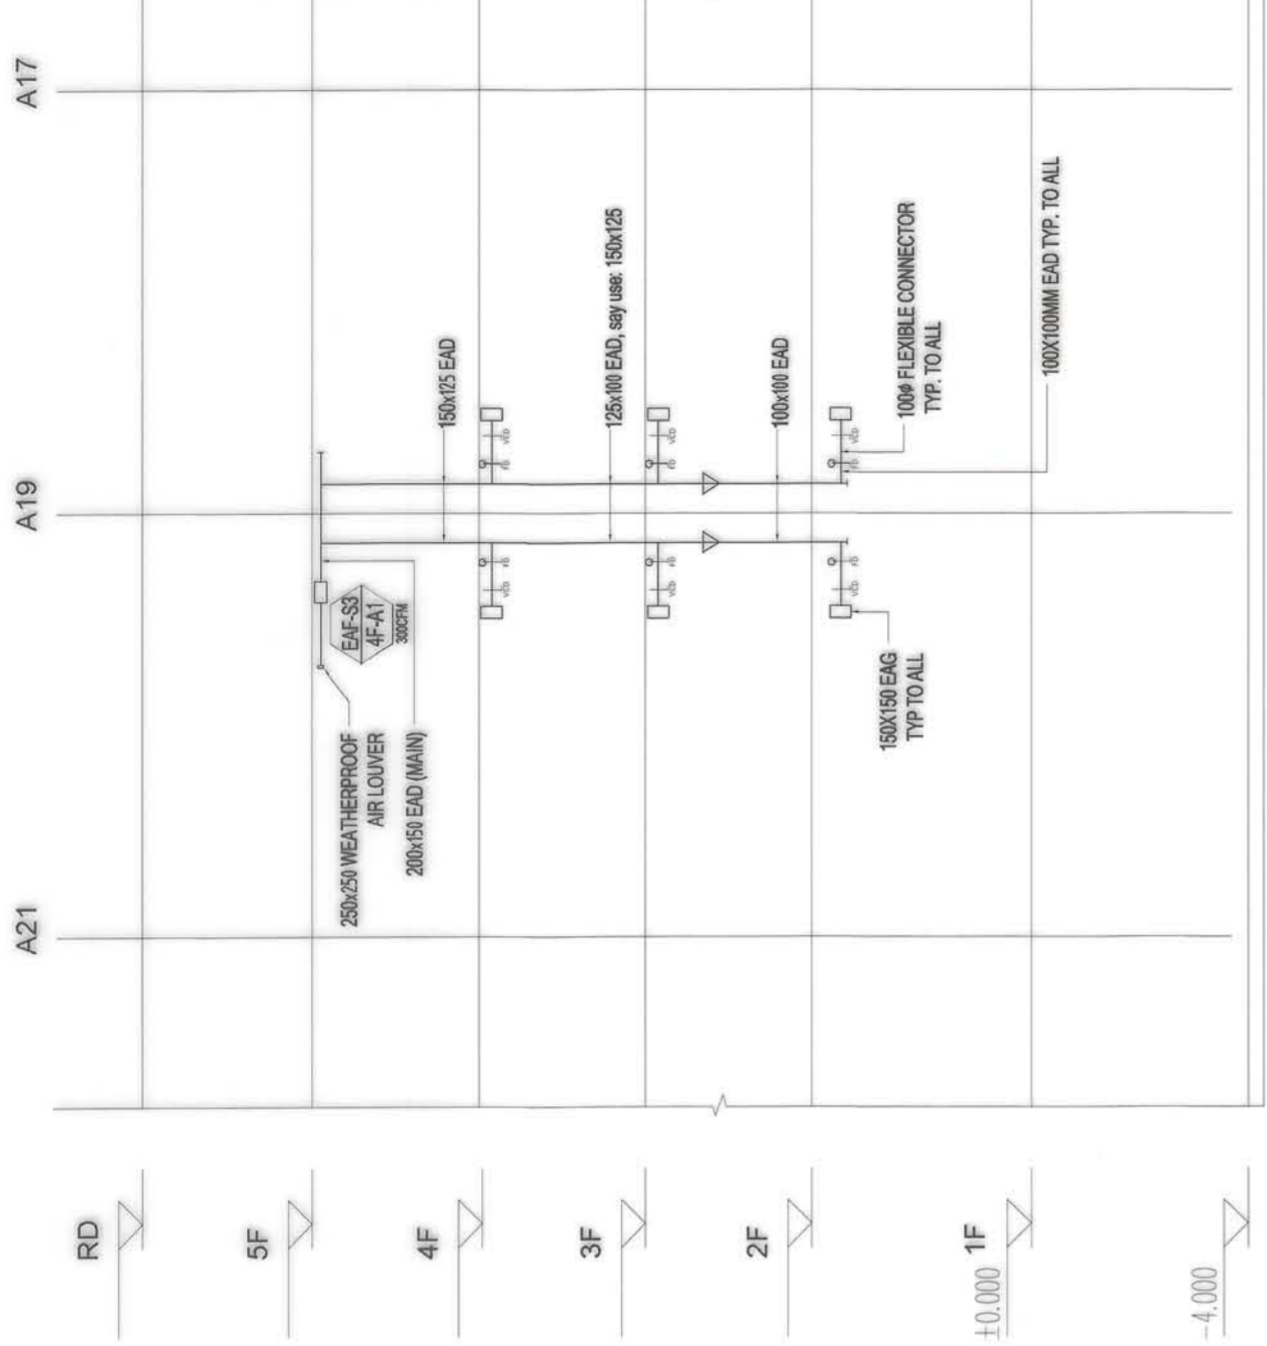


SYSTEM 03 - EAD RISER DIAGRAM  
(300CFM X 1 UNIT EAF)  
BLDG. A

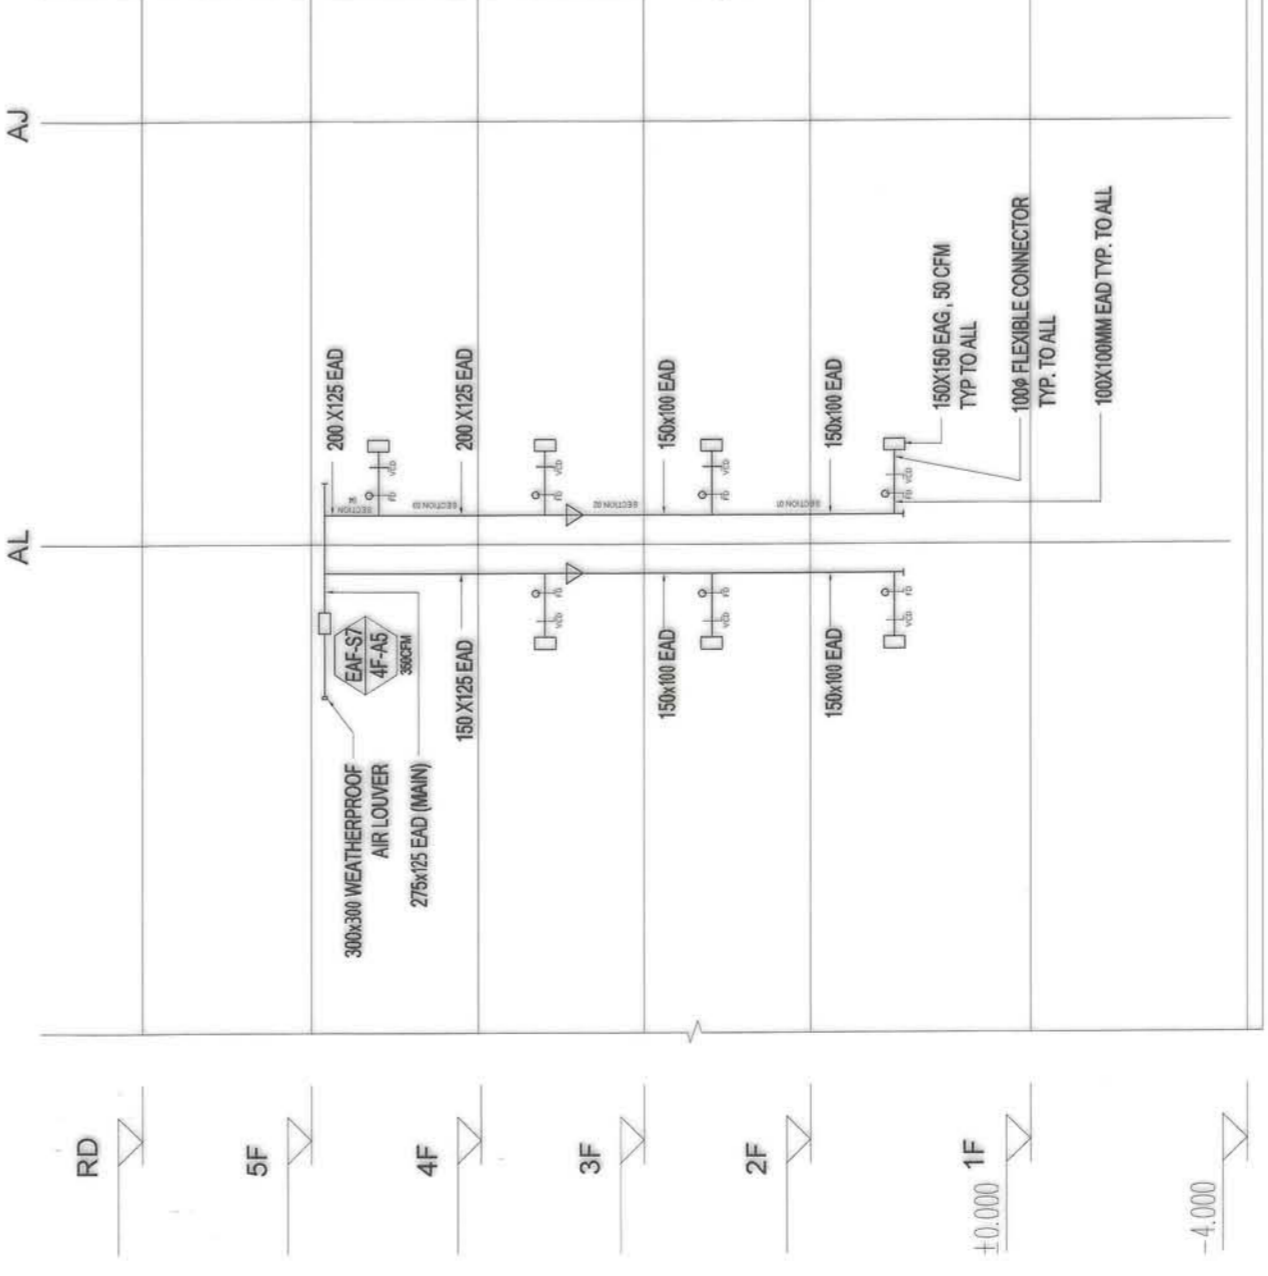

SYSTEM 07 - EAD RISER DIAGRAM  
(350CFM X 1 UNIT EAF)  
BLDG. A

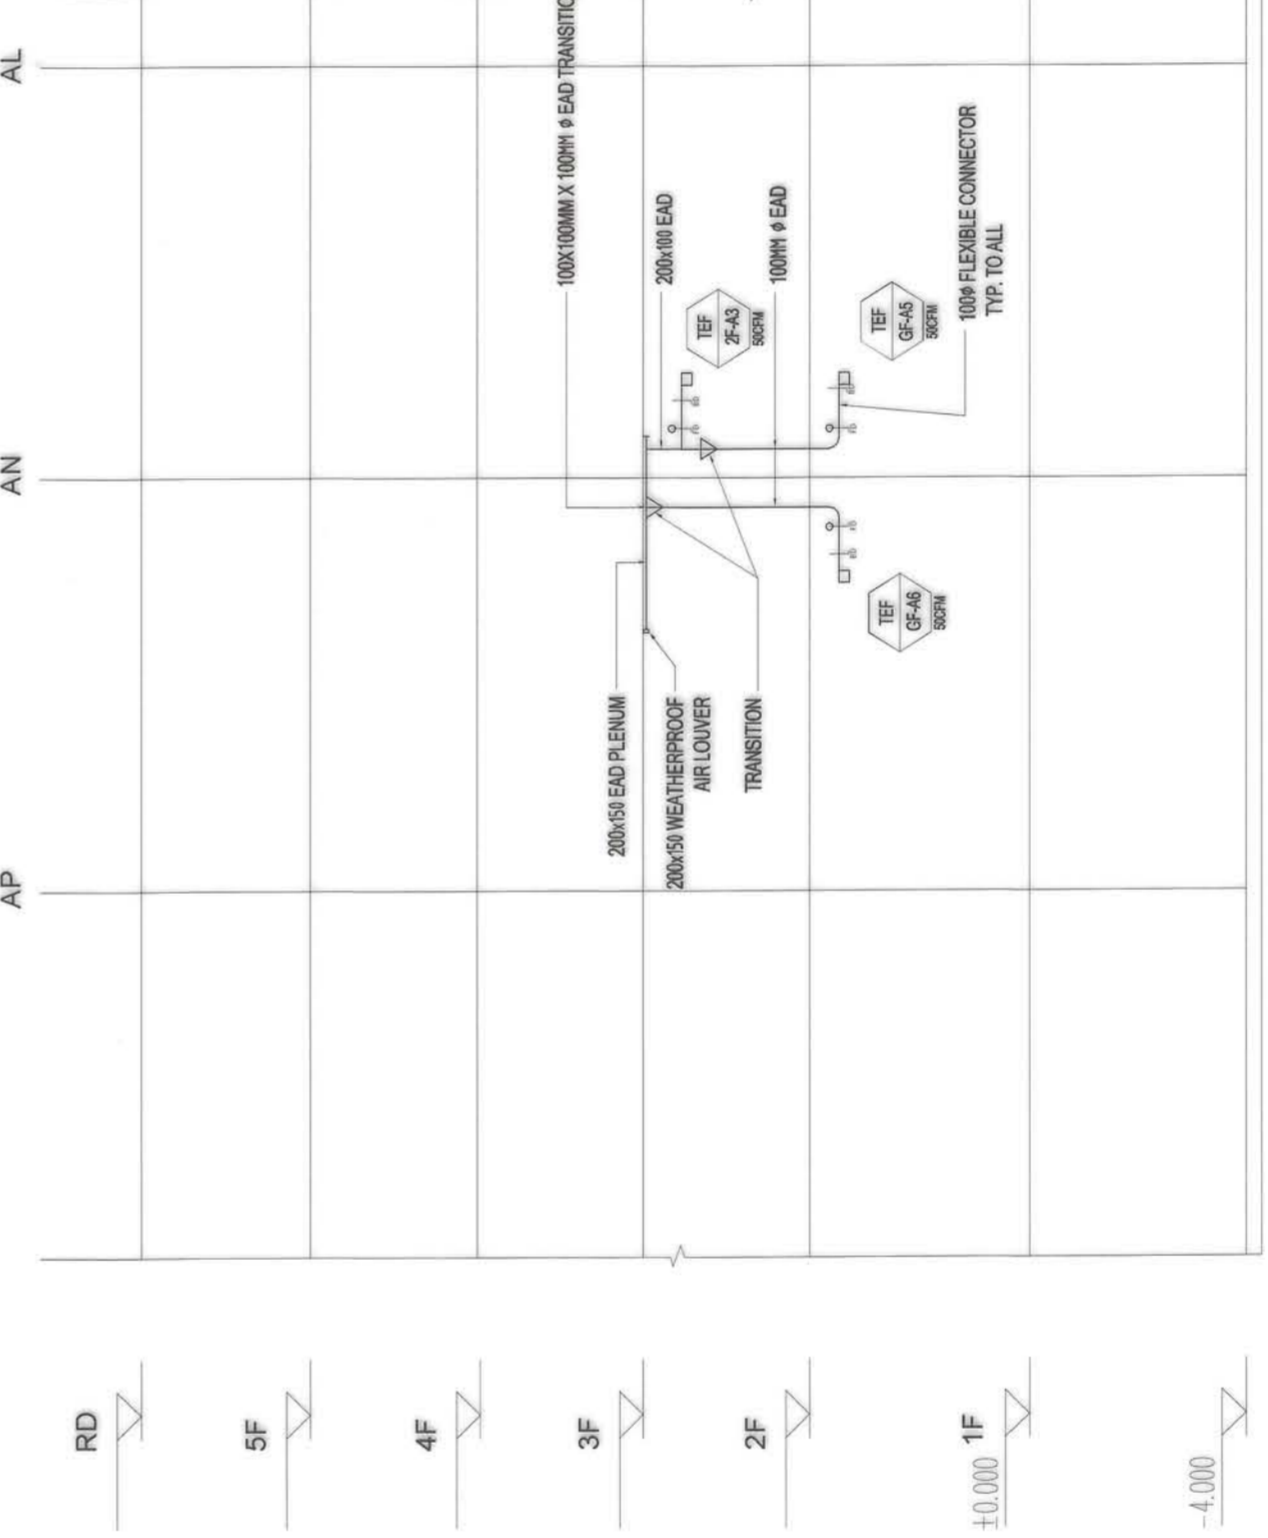

SYSTEM 08 - EAD RISER DIAGRAM  
(50CFM X 3 UNITS TEF)  
BLDG. A

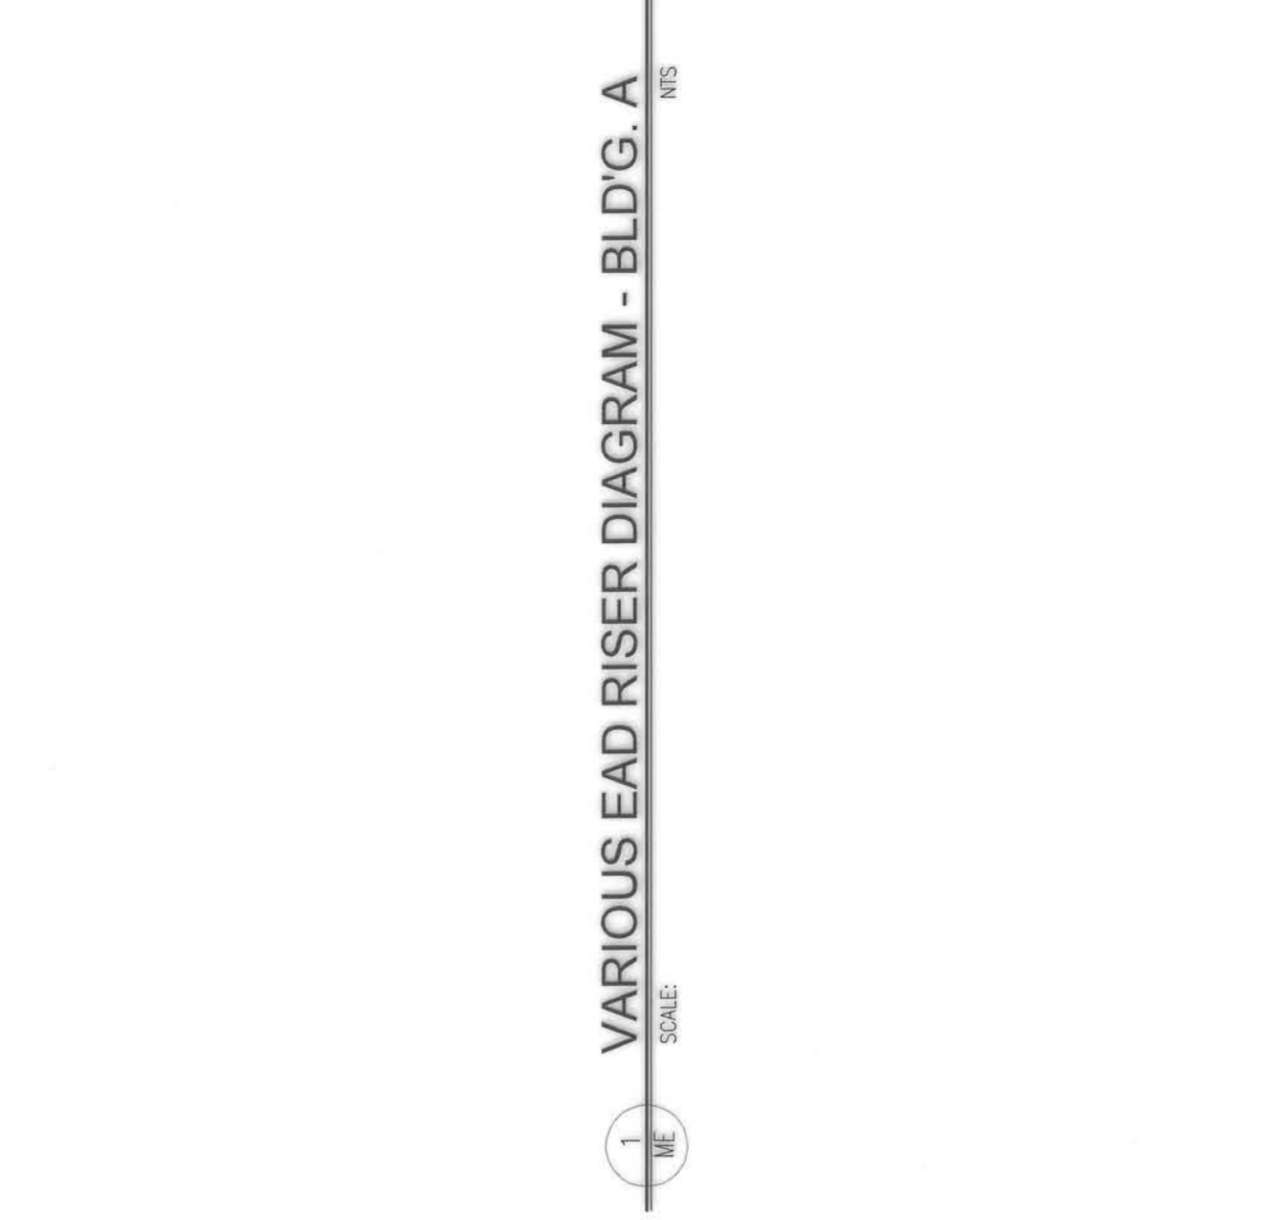

VARIOUS EAD RISER DIAGRAM - BLDG. A

OWNER : NGAC PHASE I JV COMPANY

AND

BCDA

WENCIO B. OZON

PATRICK NICHOLAS P. DAVID

PREPARED BY:

FREY-FIL CORPORATION

VICE PRESIDENT-OPERATION

REG. No.: 028507 PTR. No.: 0116986

TIN No.: 116-435-274 PLACE: MANILA

DATE: 01.20.2019

DATE: 01.20.2019

REVIEWED AND VALIDATED BY:

FILIPINAS DRAGO CORPORATION

Architectural & Engineering Consultants

Alfredo P. Revilla

PROJECT MANAGER

SUBMITTED BY:

BANDAR HEBAT BUILDERS, INC.

ISAAC S. DAVID

PRESIDENT

CERTIFIED BY: INDEPENDENT CONSULTANT

TCGI ENGINEERS

VIRGILIO A. MAGRAZO

PRESIDENT/CEO

PROJECT TITLE:

AS-BUILT DRAWING

NGAC PHASE 1A

ATHLETES VILLAGE - BUILDING A

(AIR CONDITIONING & VENTILATION SYSTEM)






New Clark City, Capas, Tarlac

SHEET CONTENTS:




BUILDING "A" - VARIOUS

TOILET EAD RISER DIAGRAM



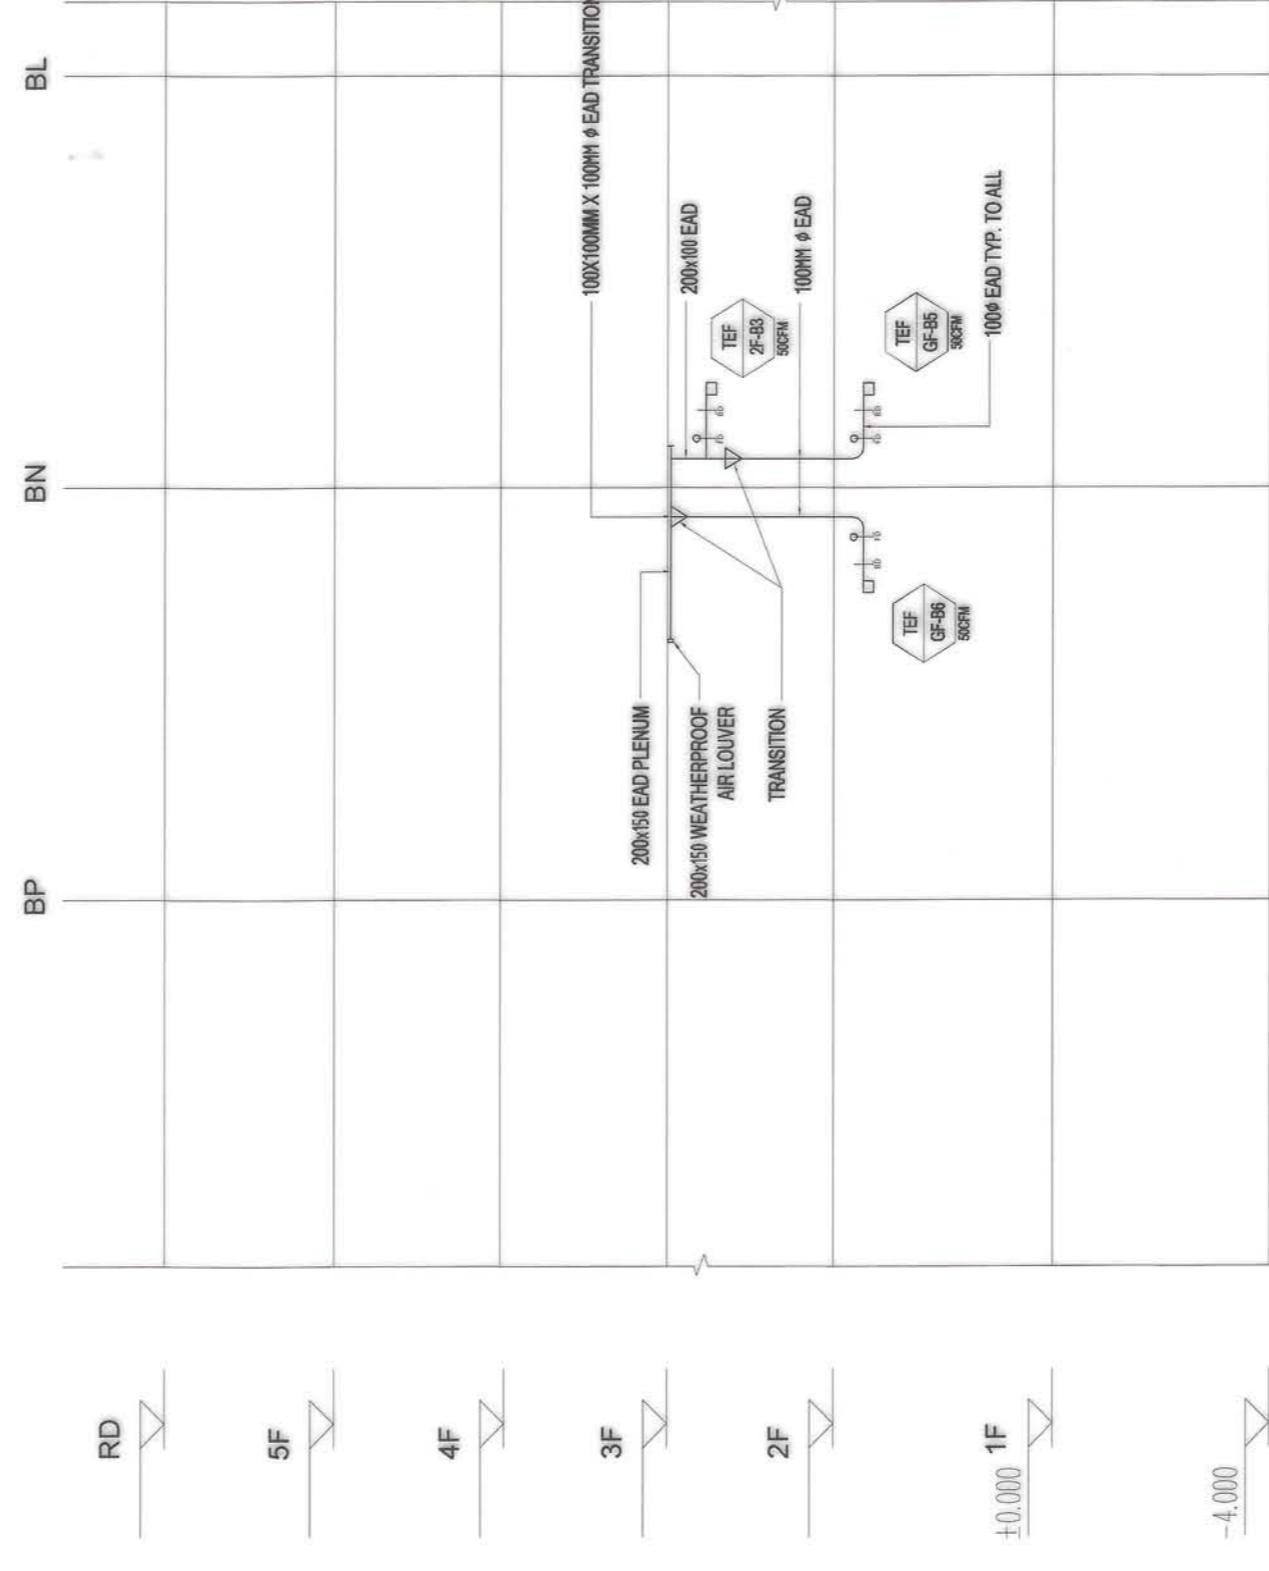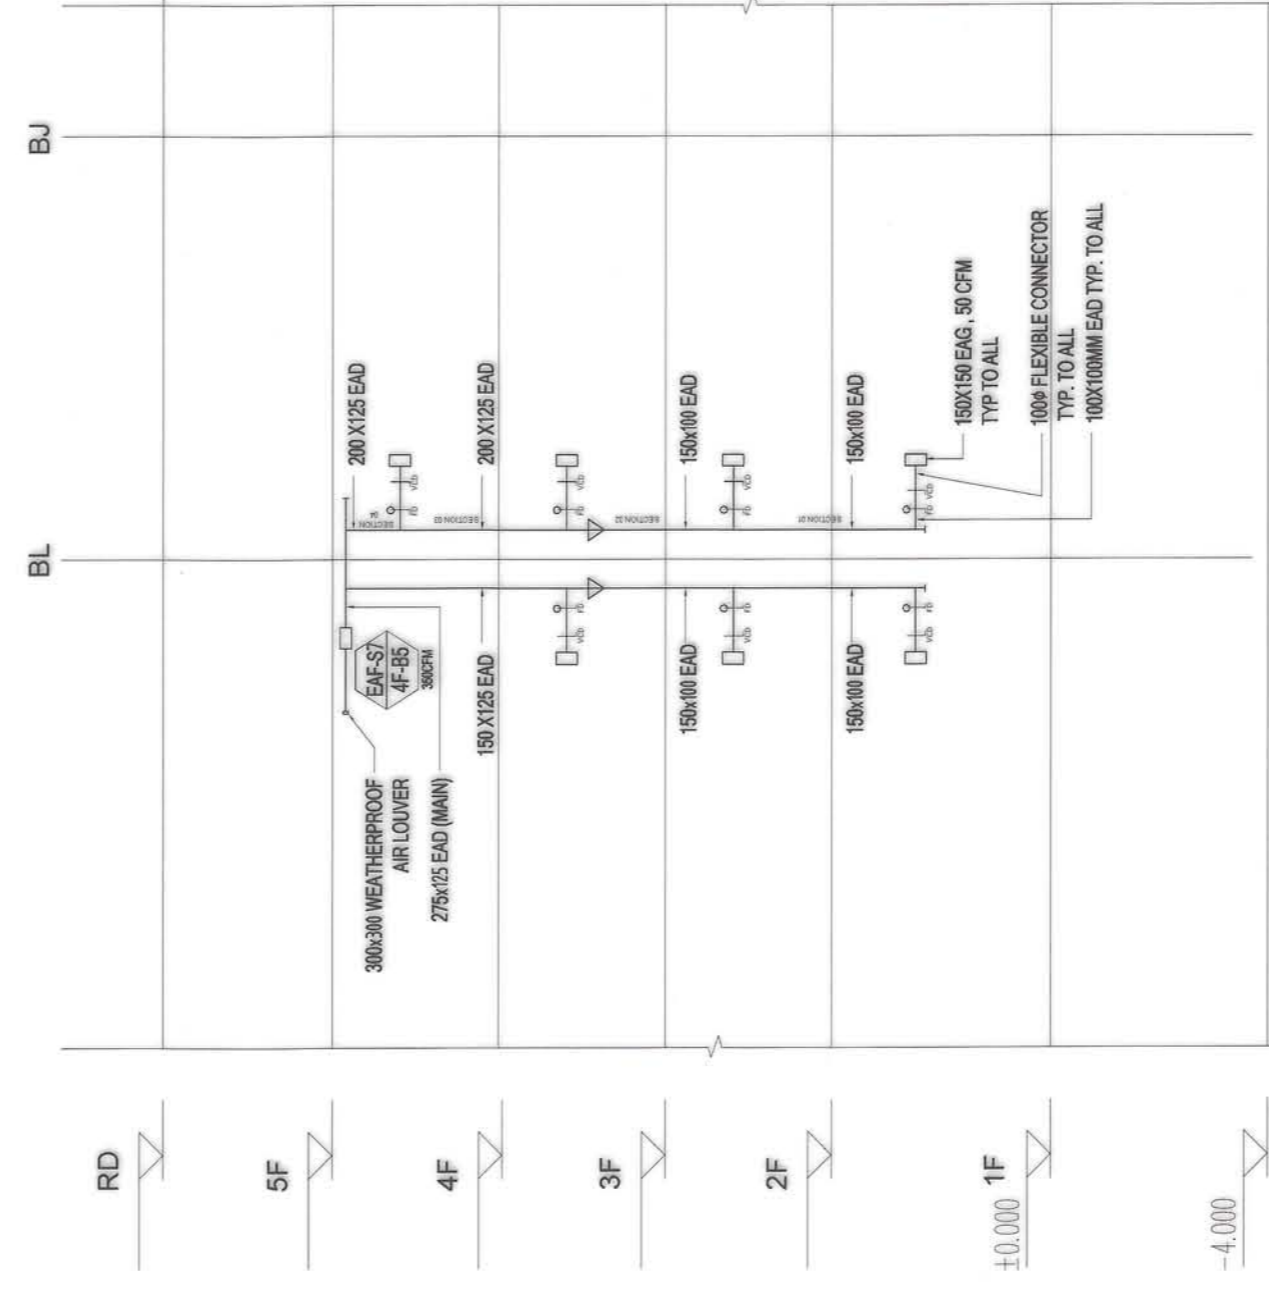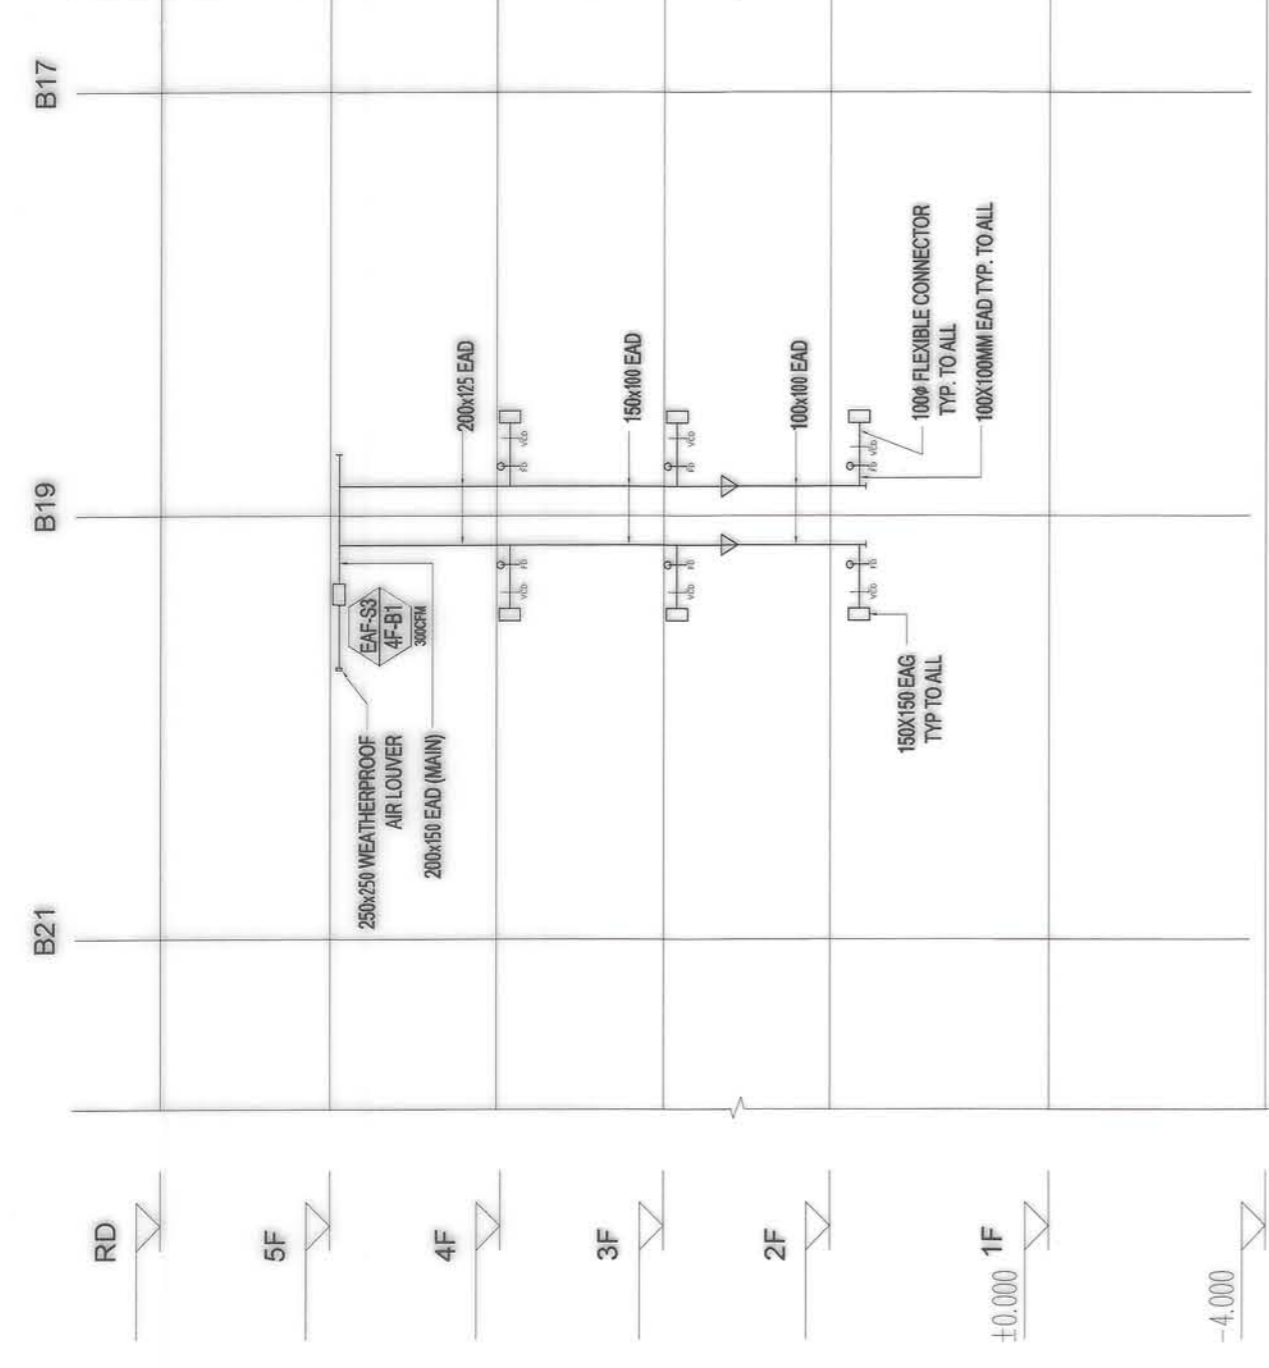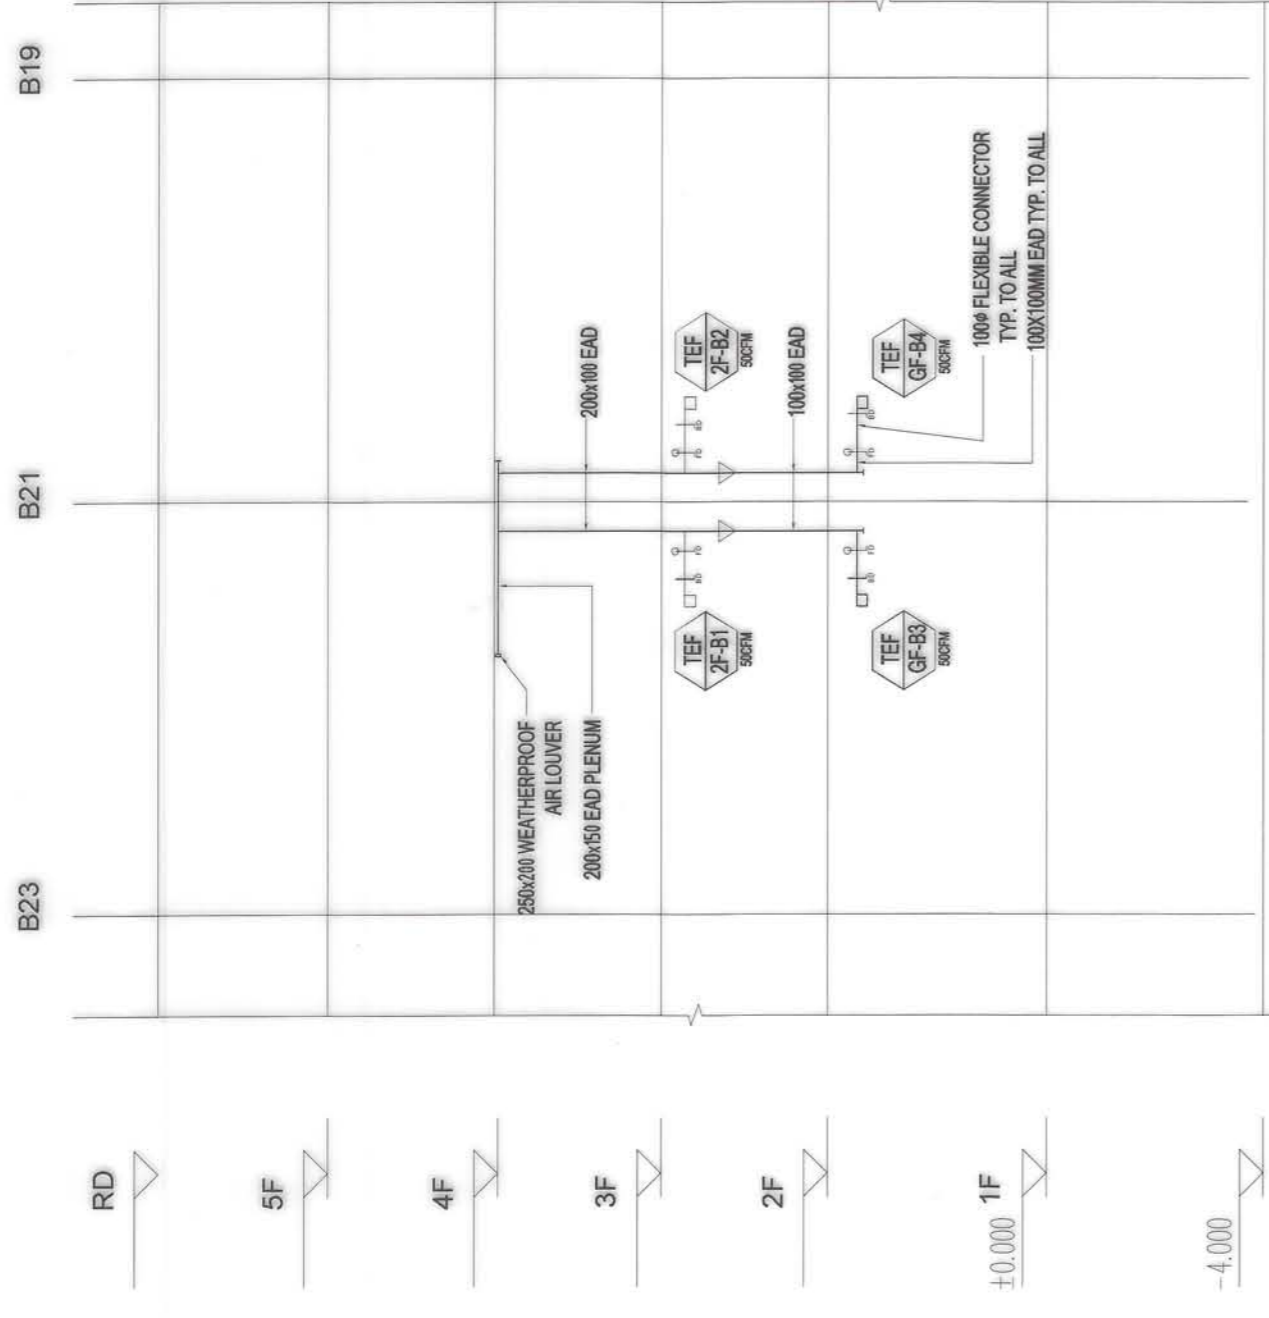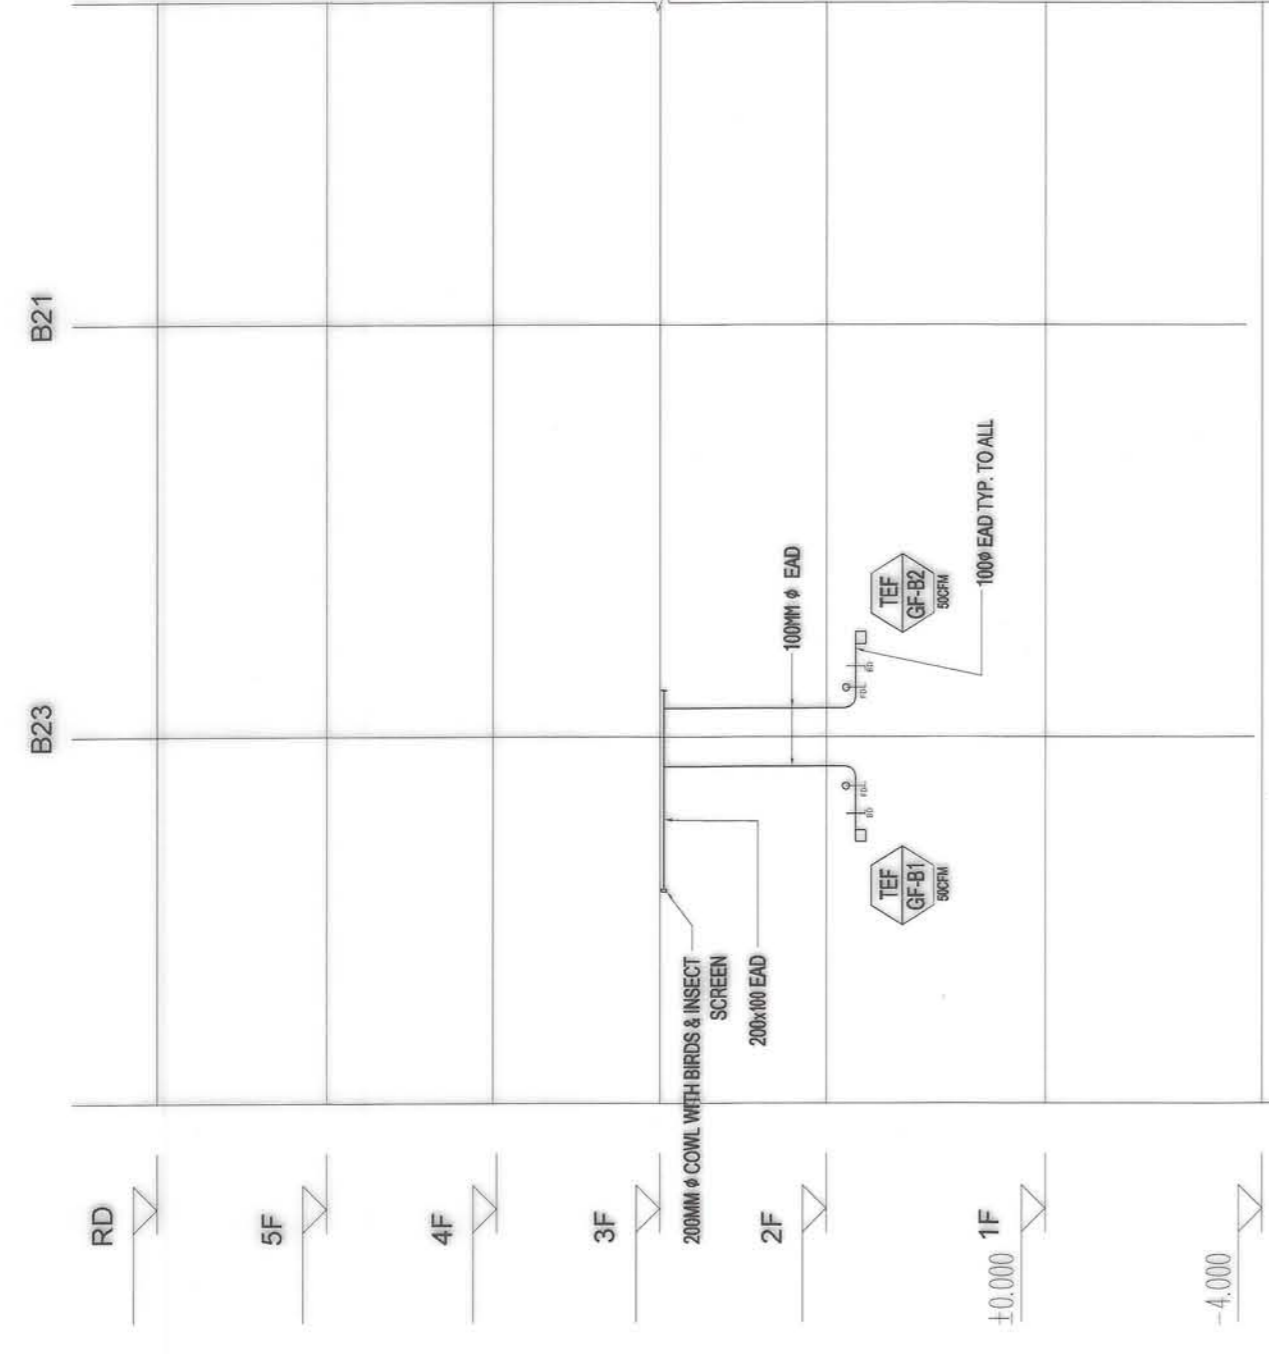


M-26

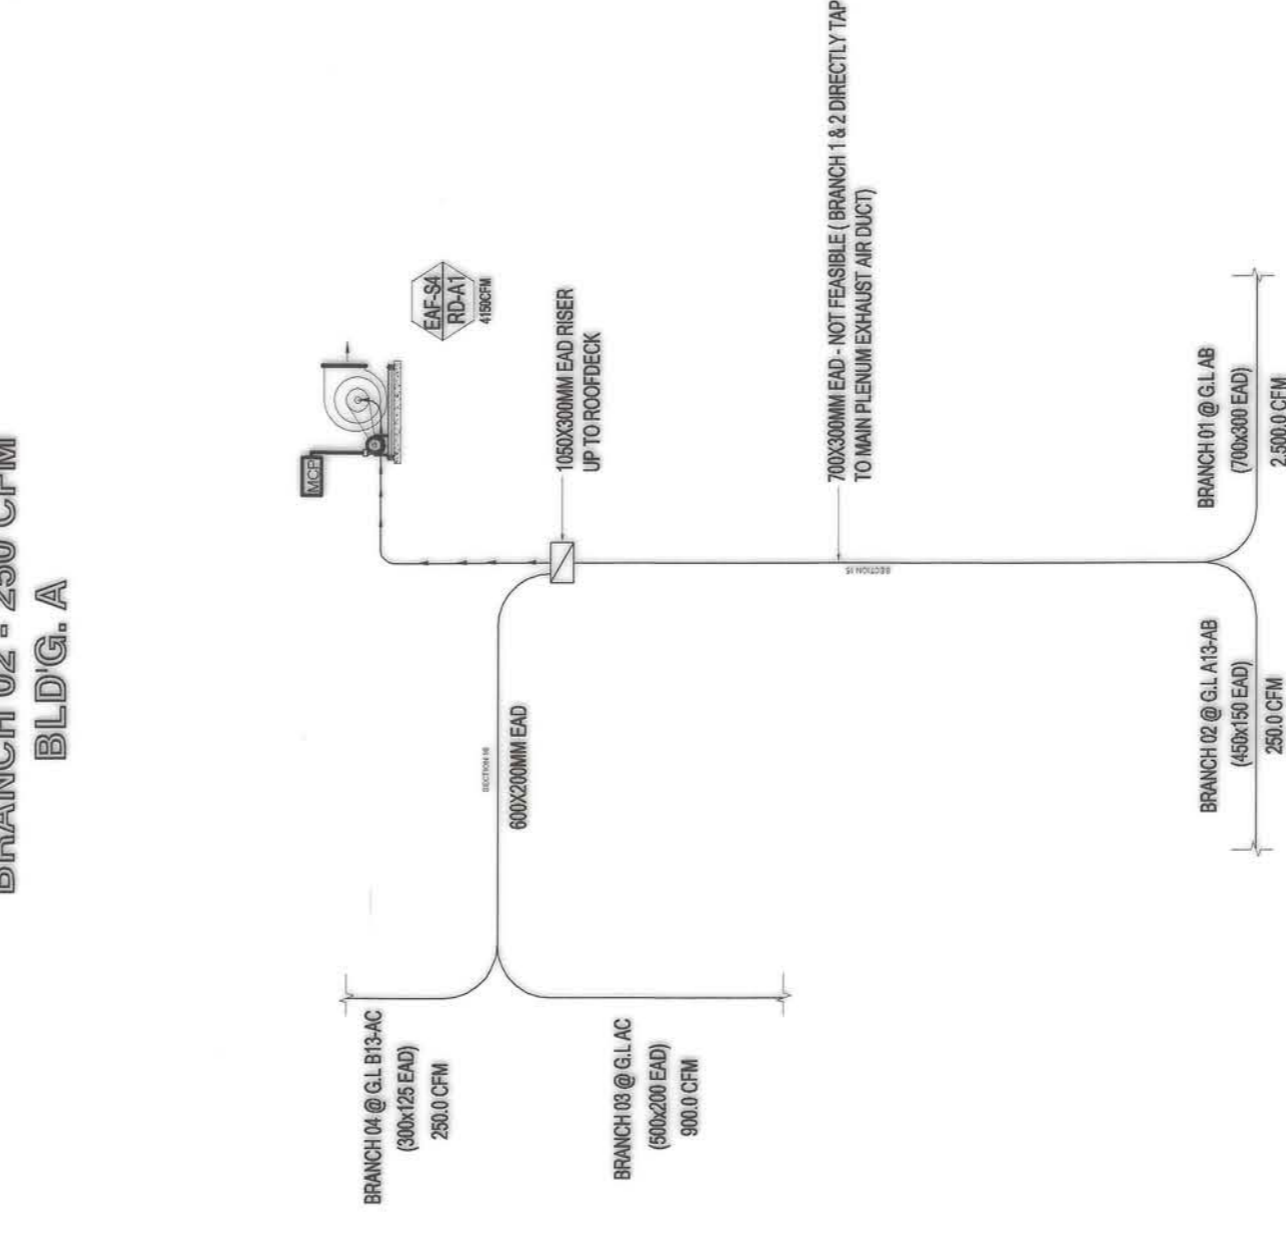
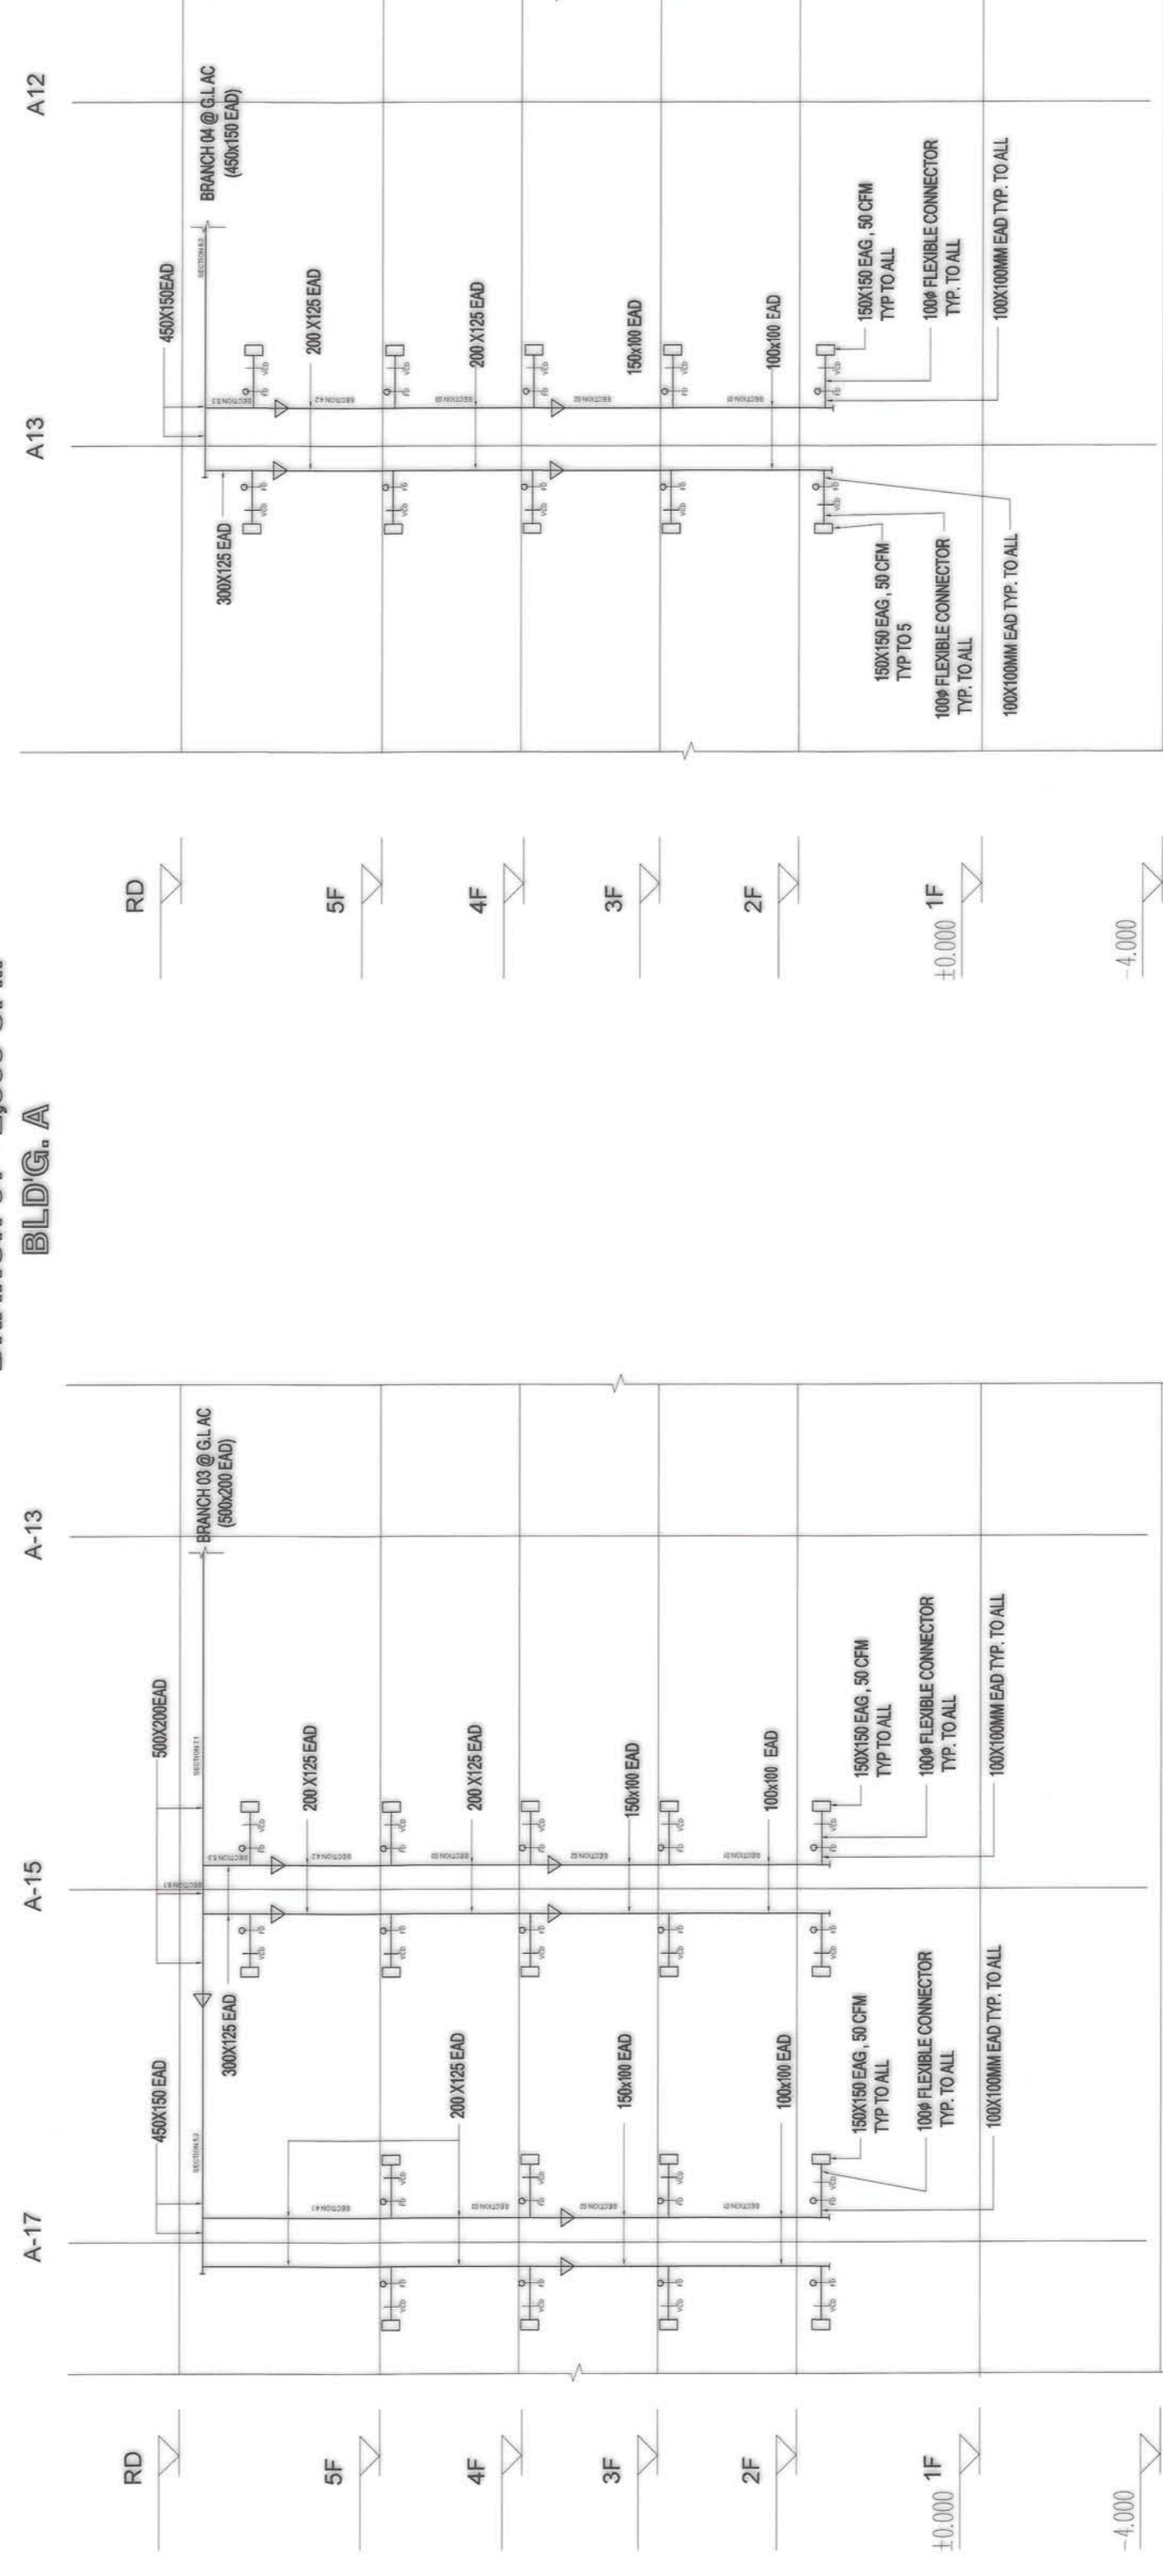
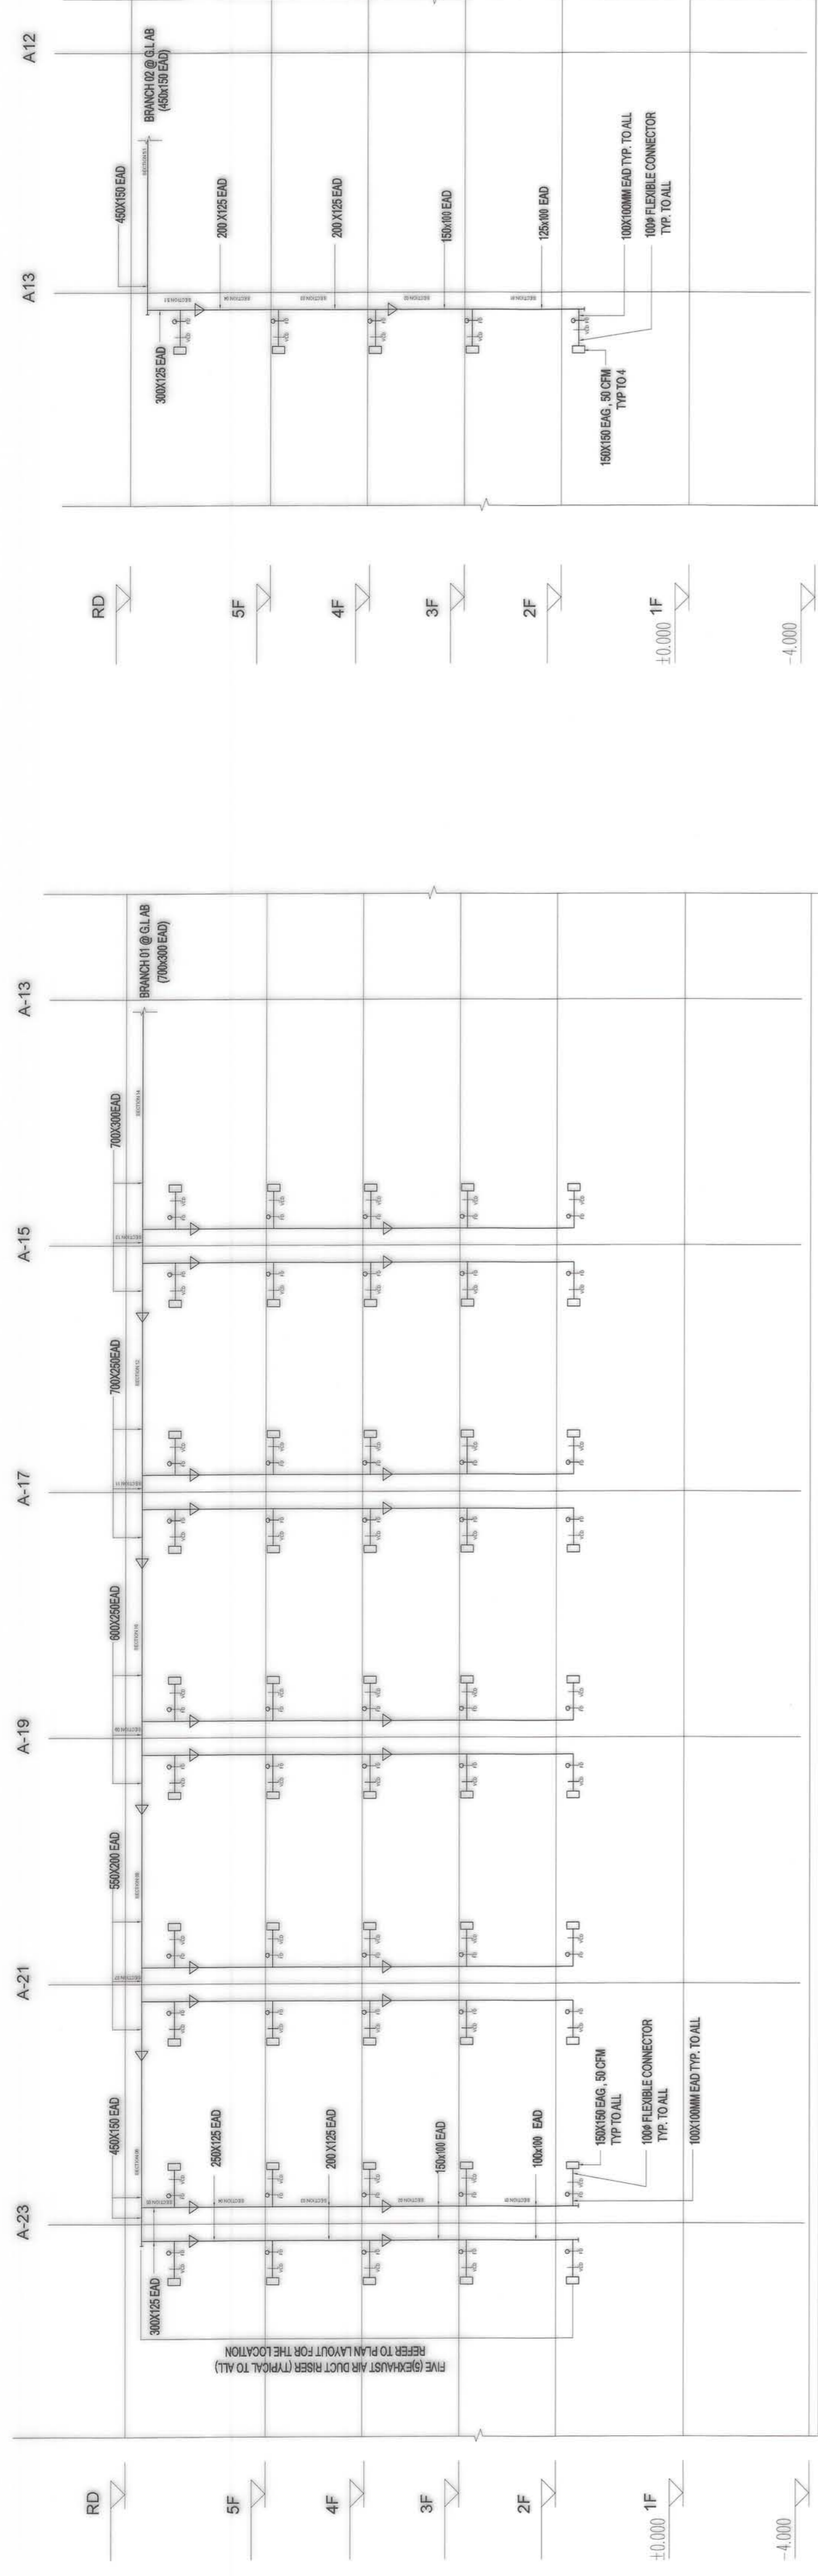


<b>OWNER :</b>	NGAC PHASE I JV COMPANY	<b>PREPARED BY:</b>	<b>REVIEWED AND VALIDATED BY:</b>	<b>SUBMITTED BY:</b>	<b>CERTIFIED BY:</b>	<b>PROJECT TITLE:</b>	<b>SHEET CONTENTS:</b>	<b>SHEET NO.</b>
	 AND 	<b>FREY-FIL CORPORATION</b>  <b>MONTAÑA • CORDERO • TORRES</b> 83 West Ave Bldg 3-309A Bonanza City Tel. nos. 331-3545 <a href="http://www.freyfil.com">www.freyfil.com</a>	 <b>ZOILLOS/DELA CRUZ</b> VICE PRESIDENT - OPERATION REC No.: 006857    PTR No.: 8119468 TIN No.: 116-406-274    PLACE: MANILA DATE: 01.20.2019	 <b>BANDAR HEBAT BUILDERS, INC.</b> 5th Fl., Palaro Bldg., 18B L/A, Palaro St., Legaspi Village, Alabang City, 1529 Philippines *Tel. Nos. 81708171 to 18 Fax: 81708172 *E-mail: info@bandarhebat.com.ph Website: www.bandarhebat.com	 <b>TCGI ENGINEERS</b> 5th Fl., Palaro Bldg., 18B L/A, Palaro St., Legaspi Village, Alabang City, 1529 Philippines *Tel. Nos. 81708171 to 18 Fax: 81708172 *E-mail: info@tcgiengineers.com.ph Website: www.tcgiengineers.com	<b>AS-BUILT DRAWING</b>  NGAC PHASE 1A ATHLETES VILLAGE - BUILDING B (AIR CONDITIONING & VENTILATION SYSTEM)	<b>BUILDING "B" VARIOUS</b>  <b>TOILET EAD RISER DIAGRAM</b>	<b>M-27</b>
	<b>WENCIO B. DIZON</b> PRESIDENT	<b>PATRICK NICHOLAS P. DAVID</b> PRESIDENT	<b>AFREDO R. REVILLA</b> PROJECT MANAGER	<b>ISAAC S. DAVID</b> PRESIDENT	<b>VIRGILIO A. MADRAZO</b> PRESIDENT / CEO	New Clark City, Capas, Tarlac		




1  
ME SCALE: NTS

OWNER :	NGAC PHASE I JV COMPANY	PREPARED BY:	 <p><b>FREY-FIL CORPORATION</b>          MANILA • SINGAPORE • CEBU • LOS ANGELES          53 West ave Brgy. Poblacion, Marikina City          Tel. nos. 375-3365          www.freyfil.com</p>	REVIEWED AND VALIDATED BY:	 <p><b>FILIPINAS DRAVO CORPORATION</b>          Architectural &amp; Engineering Consultants          10th Floor, 1000 "A" Building, 10th Ave. Extension, Alabang, Muntinlupa City, 1780          Contact: (02) 885-2200          Fax: (02) 885-2201          Website: www.fdravo.com</p>	SUBMITTED BY:	 <p><b>BANDAR HEBAT BUILDERS, INC.</b>    <b>ISAAC S. DAVID</b>          PRESIDENT</p>	CERTIFIED BY:	 <p><b>TCGI ENGINEERS</b>          5th Fl. - Plaza Bldg., 108 U.A. Rubin St., Lapasan Village,          Marikina City, 1229 Philippines *Tel. Nos. 8775511 to 16</p>	PROJECT TITLE:	<p><b>AS-BUILT DRAWING</b></p> <p>NGAC PHASE 1A          ATHLETES VILLAGE - BUILDING A          (AIR CONDITIONING &amp; VENTILATION SYSTEM)</p> <p>New Clark City, Capas, Tarlac</p>	SHEET NO.	M-28
---------	-------------------------	--------------	--	----------------------------	---	---------------	--	---------------	---	----------------	--	-----------	------

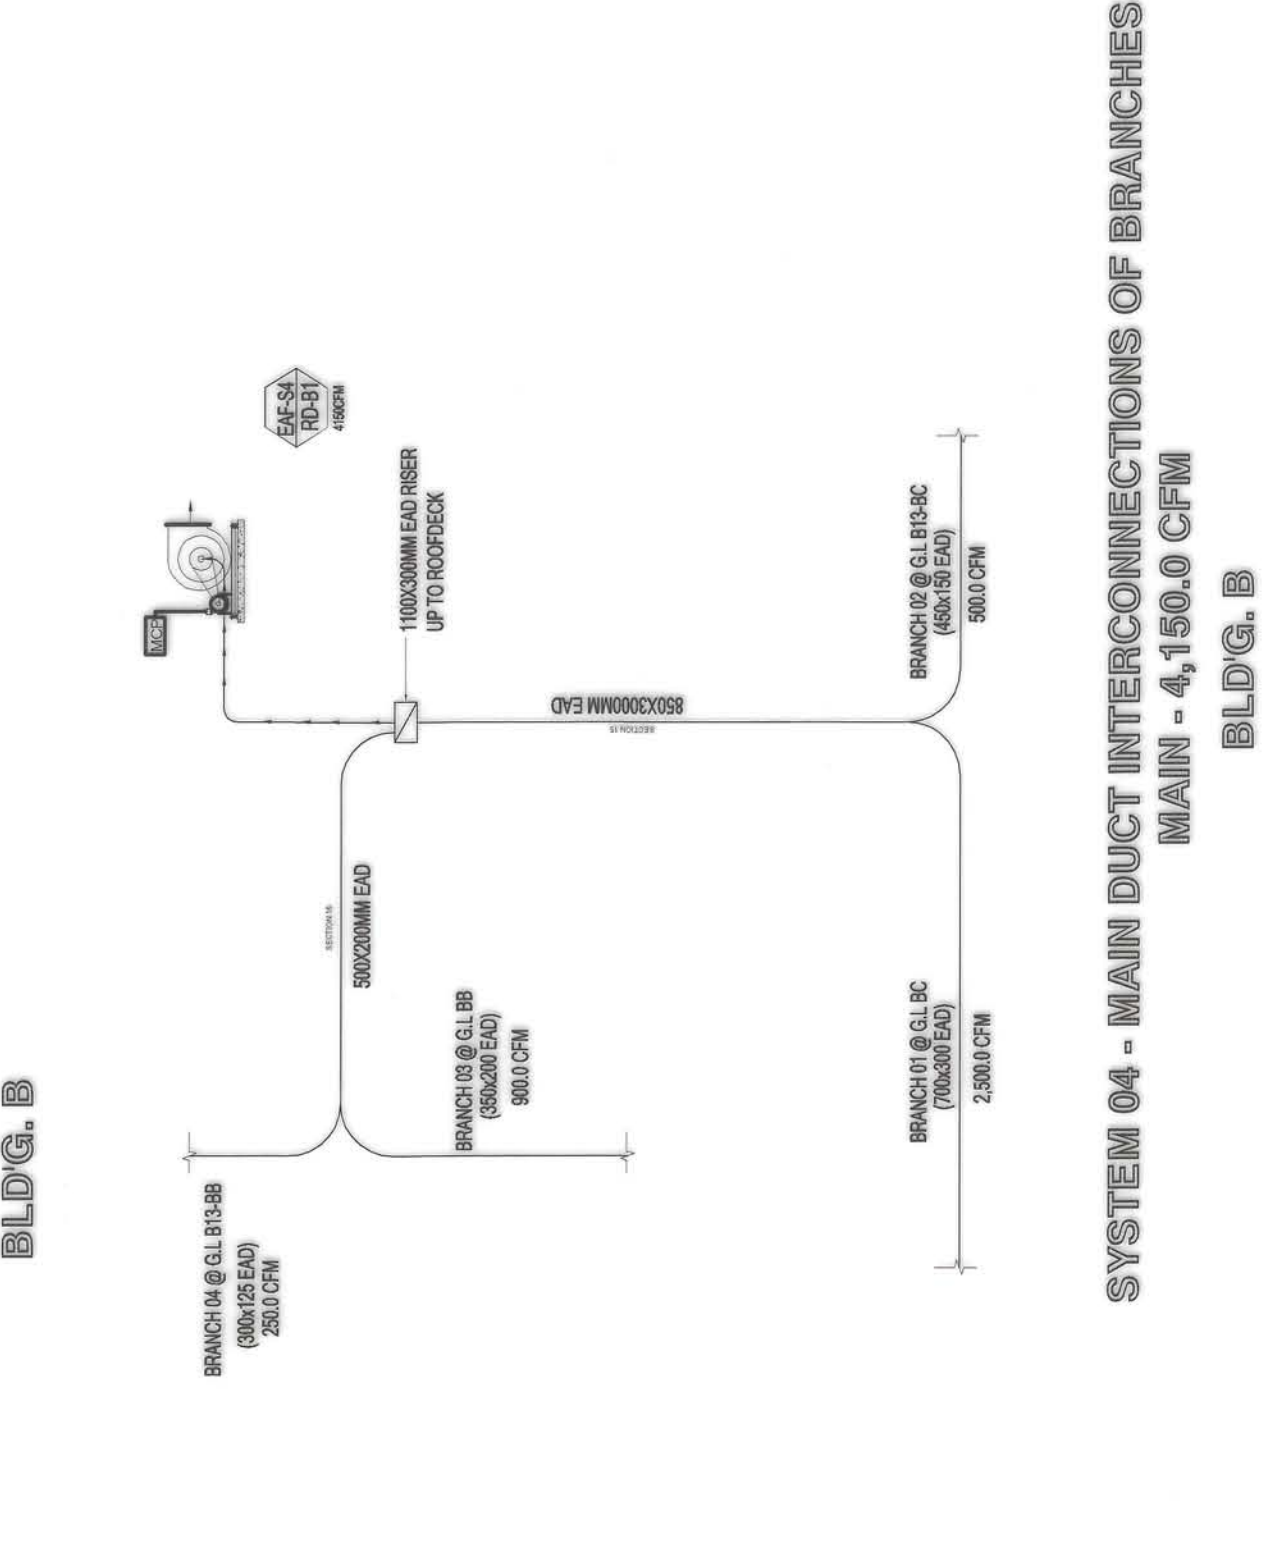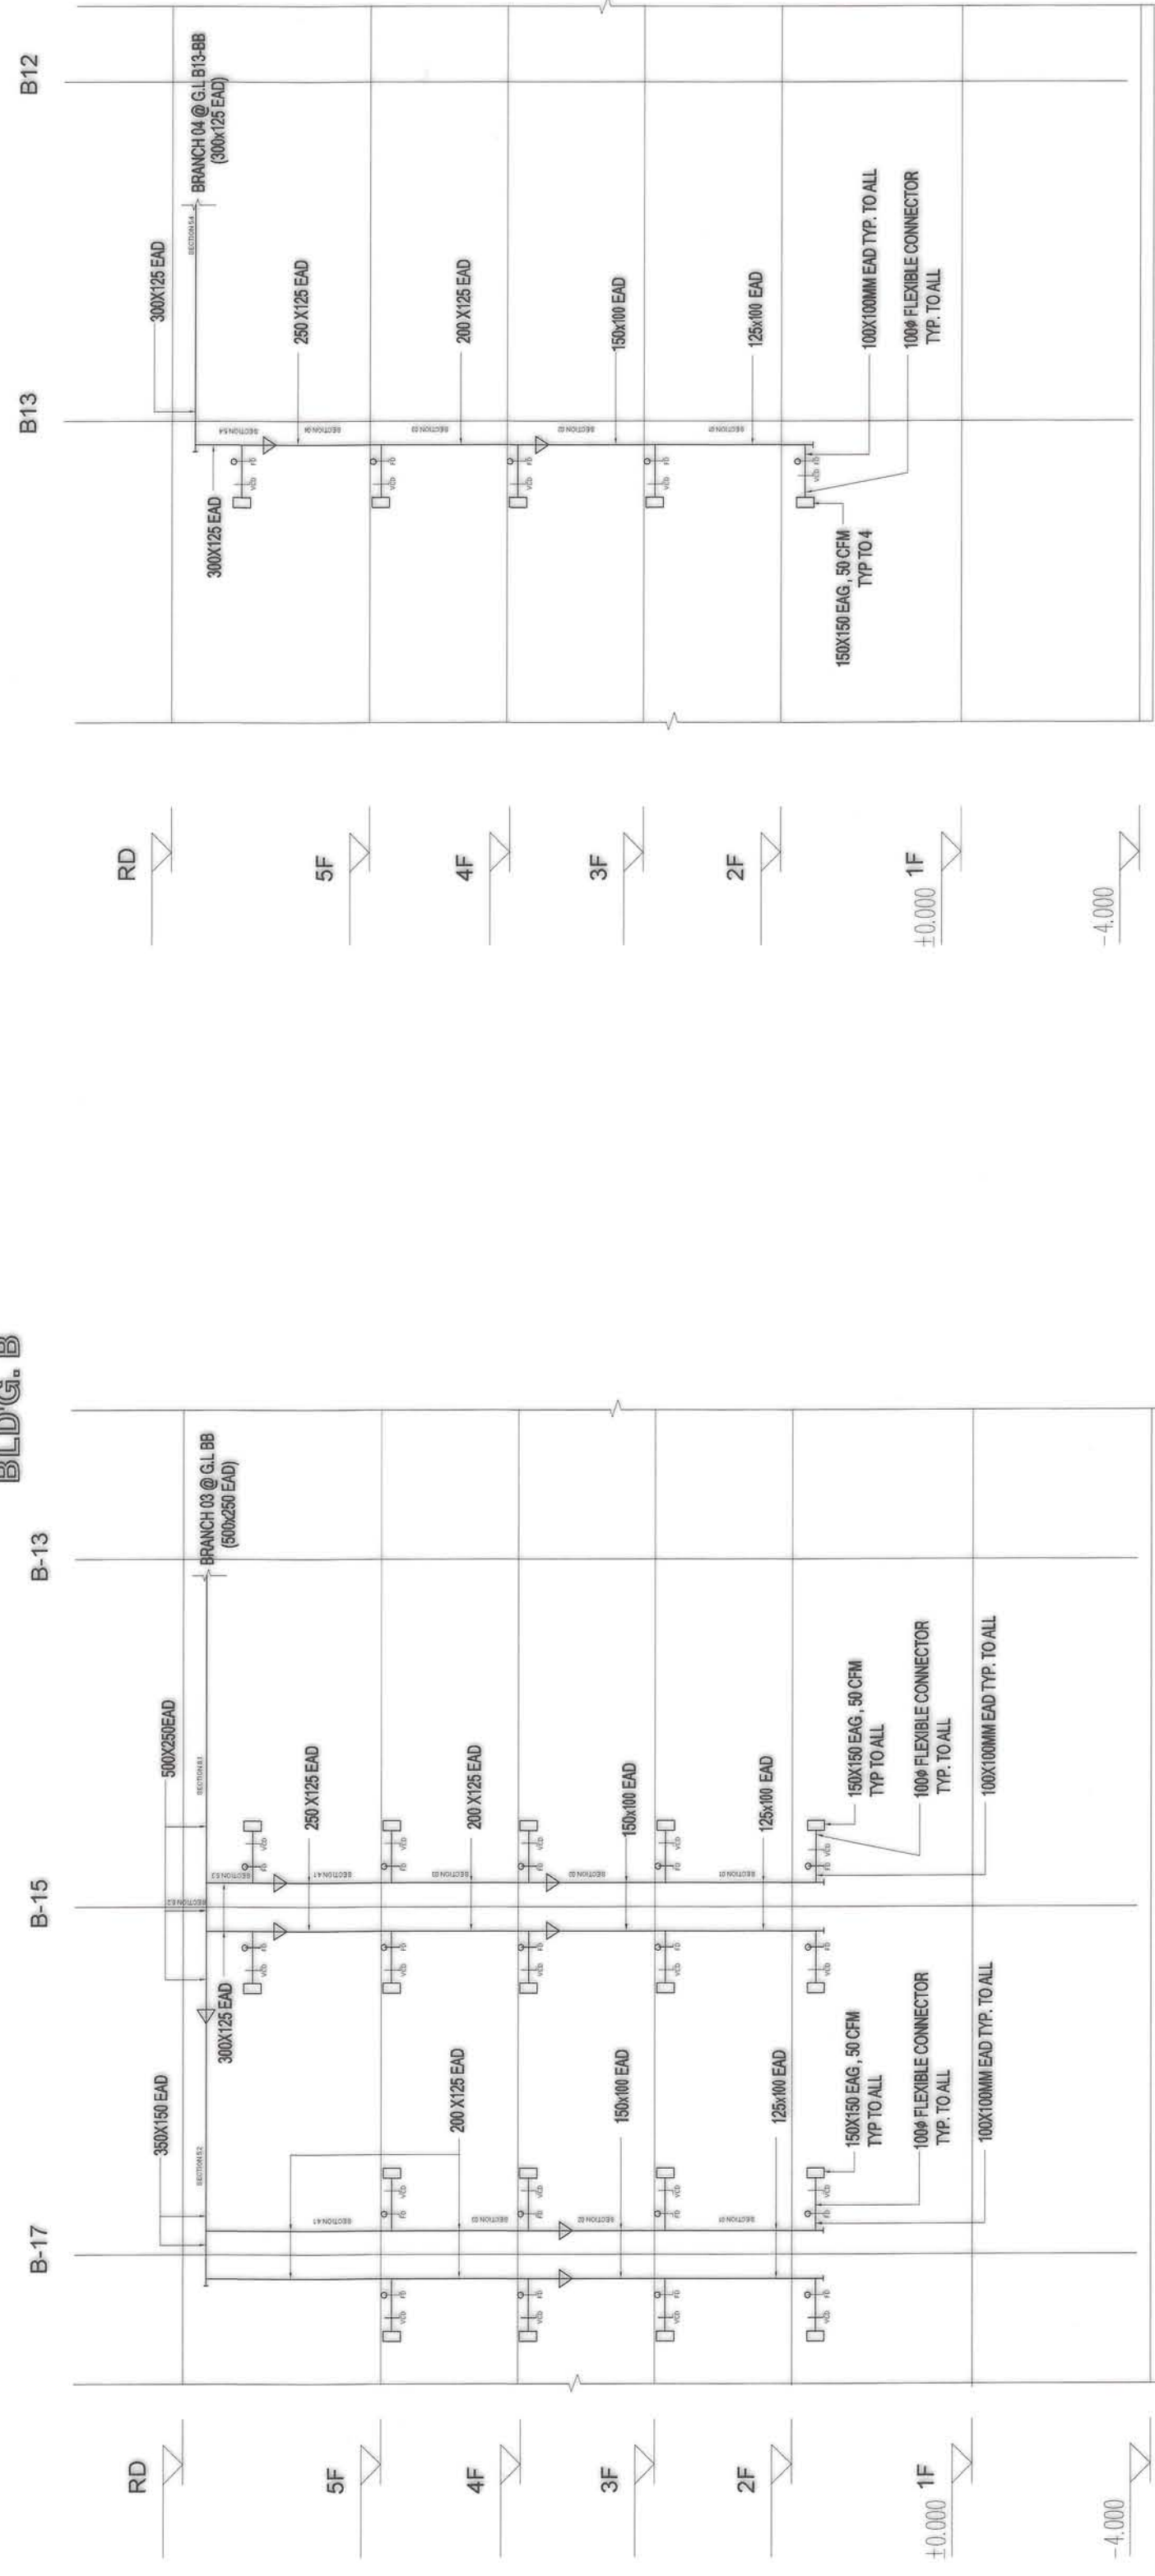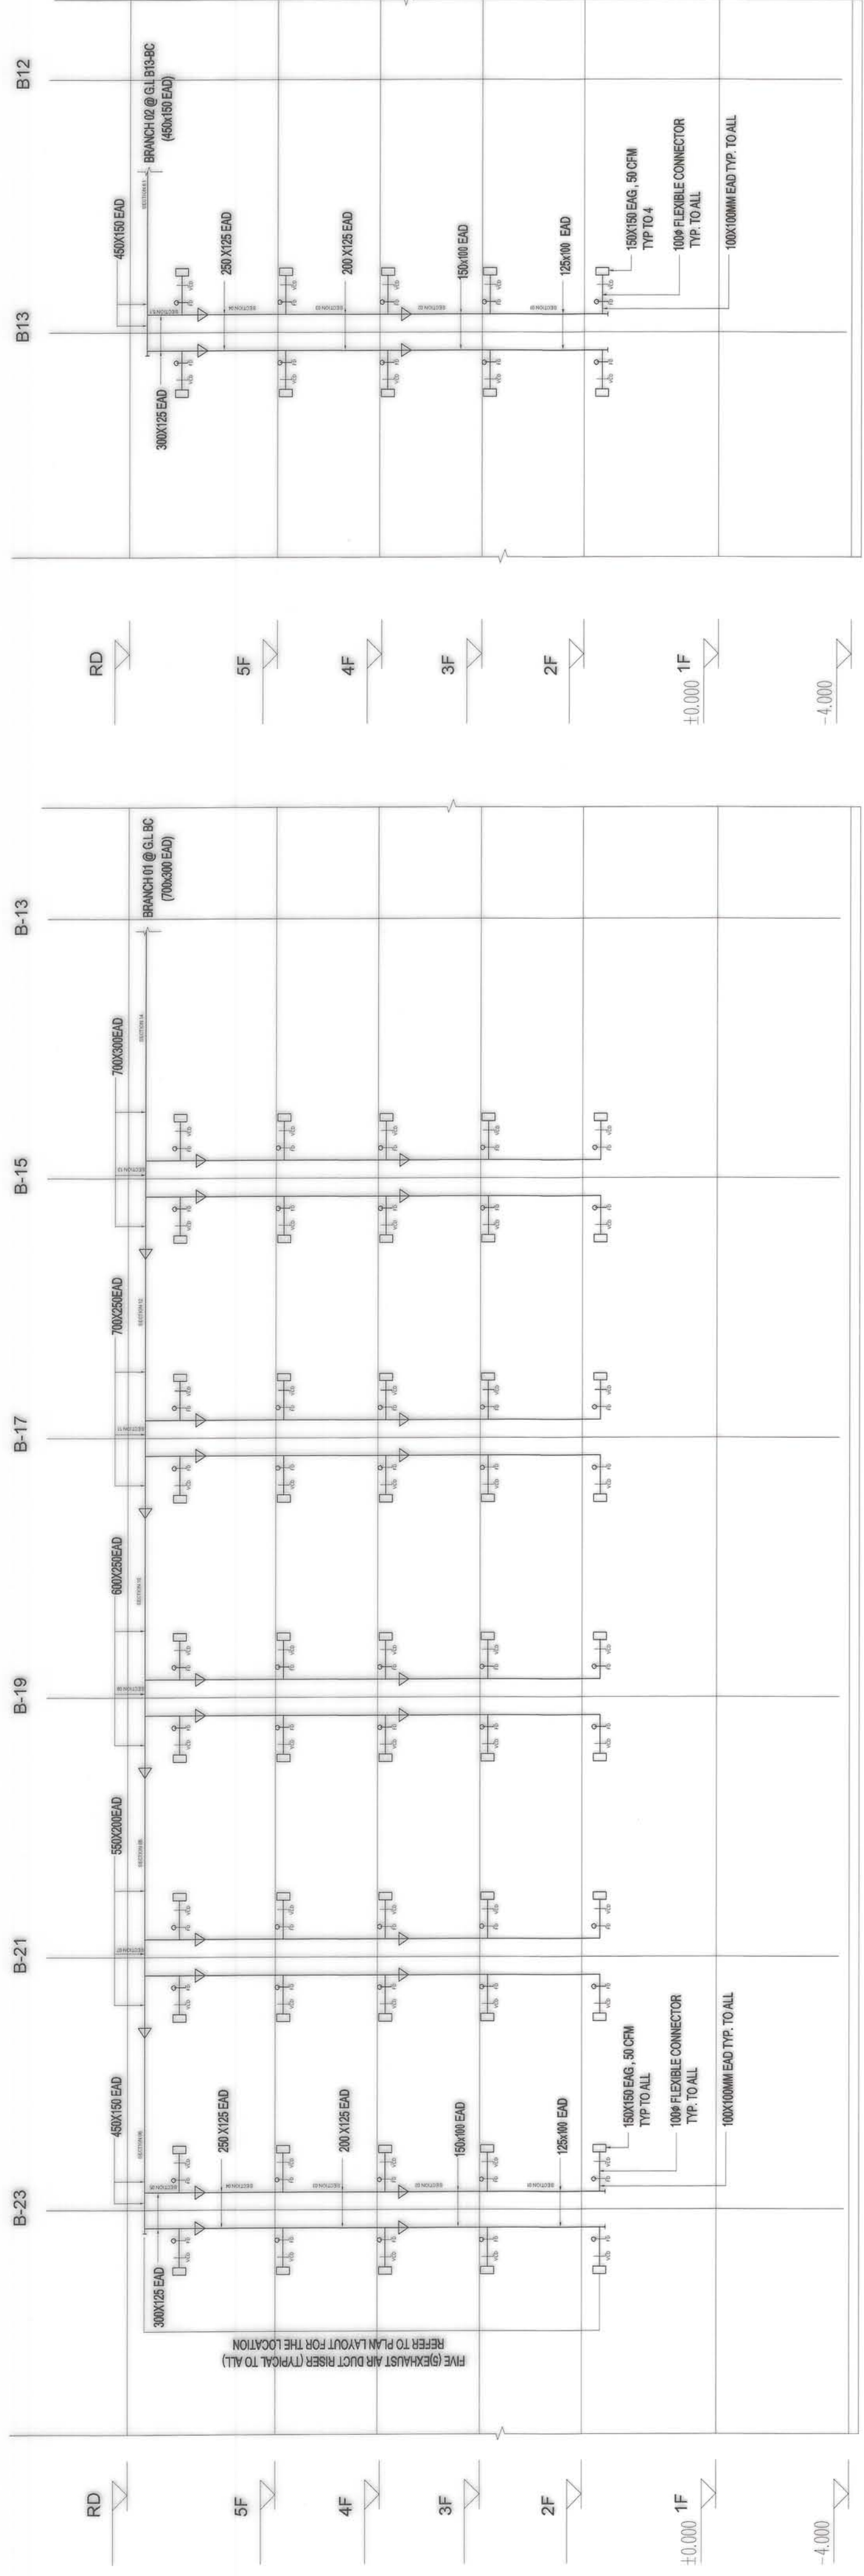


1 ME SCALE: WTS  
EXHAUST AIR DUCT RISER DIAGRAM - SYSTEM 04 - BLD'G. B


OWNER :	NGAC PHASE I JV COMPANY	PREPARED BY:	 <p><b>FREY-FIL CORPORATION</b> MANILA • DAVAO • CEBU • ILOILO 63 West end-559/Valera/JFIM Source City www.freyfil.com Tel. nos. 31-3466</p>	REVIEWED AND VALIDATED BY:	 <p><b>FILIPINAS DRAVO CORPORATION</b> Architectural &amp; Engineering Consultants 1117 S. OROQUIETA AVE., 3RD FLOOR, CEBU CITY TEL. 311-1111 FAX 311-1112 1117 S. OROQUIETA AVE., 3RD FLOOR, CEBU CITY TEL. 311-1111 FAX 311-1112</p>	SUBMITTED BY:	 <p><b>BANDAR HEBAT BUILDERS, INC.</b> <i>Isaac S. David</i> ISAAC S. DAVID PRESIDENT</p>	CERTIFIED BY:	 <p><b>TCGI ENGINEERS</b> 889 Pte. Palmer Road, 10th L/A, Palmer St., Legazpi City 5500 Mobile City, 1228 Pampanga - 1st. Flr. No. 6150571 to 76</p>	PROJECT TITLE:	<p><b>AS-BUILT DRAWING</b> NGAC PHASE I/A ATHLETES VILLAGE - BUILDING B (AIR CONDITIONING &amp; VENTILATION SYSTEM)</p> <p>New Clark City, Capas, Tarlac</p>	SHEET NO.	M-29
 <p><b>BCDA</b> Bureau of Construction, Design and Architecture Republic of the Philippines</p>	AND	 <p><b>JTD</b> JTD Corp Inc.</p>	 <p><b>PATRICK NICHOLAS P. DAVID</b> PRESIDENT</p>	 <p><b>VIVENCIO B. PIZON</b> PRESIDENT</p>									

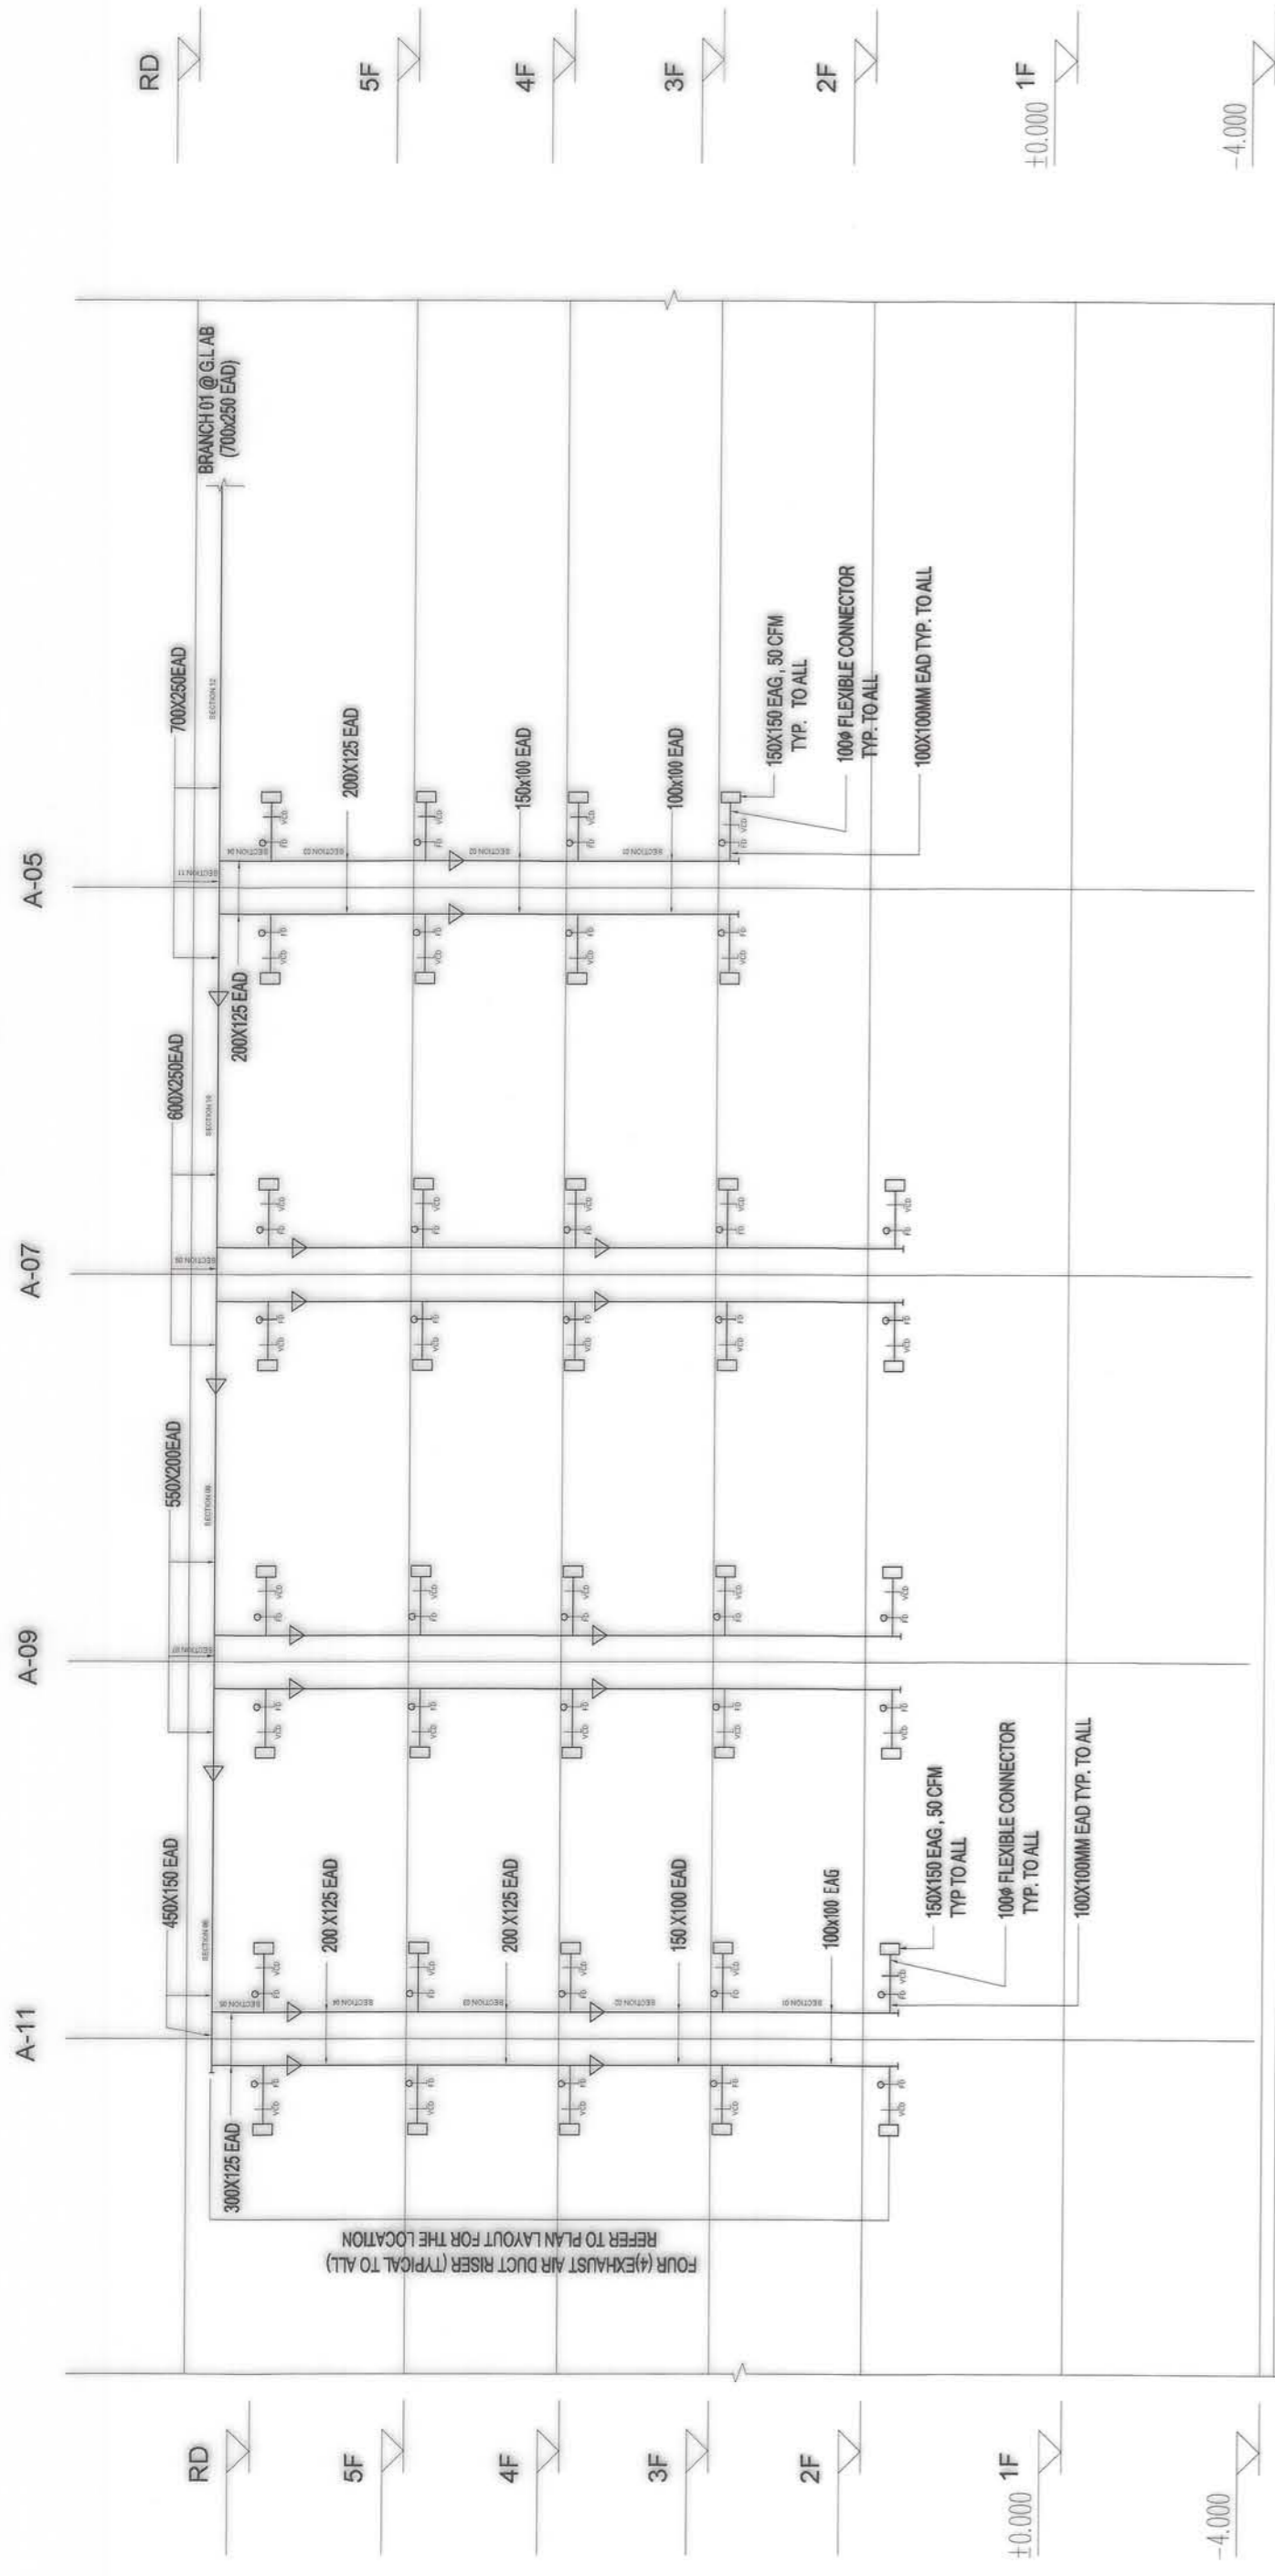


SYSTEM 05 - EAD RISER DIAGRAM  
BRANCH 01 - 1,900.0 CFM  
BLD'G. A

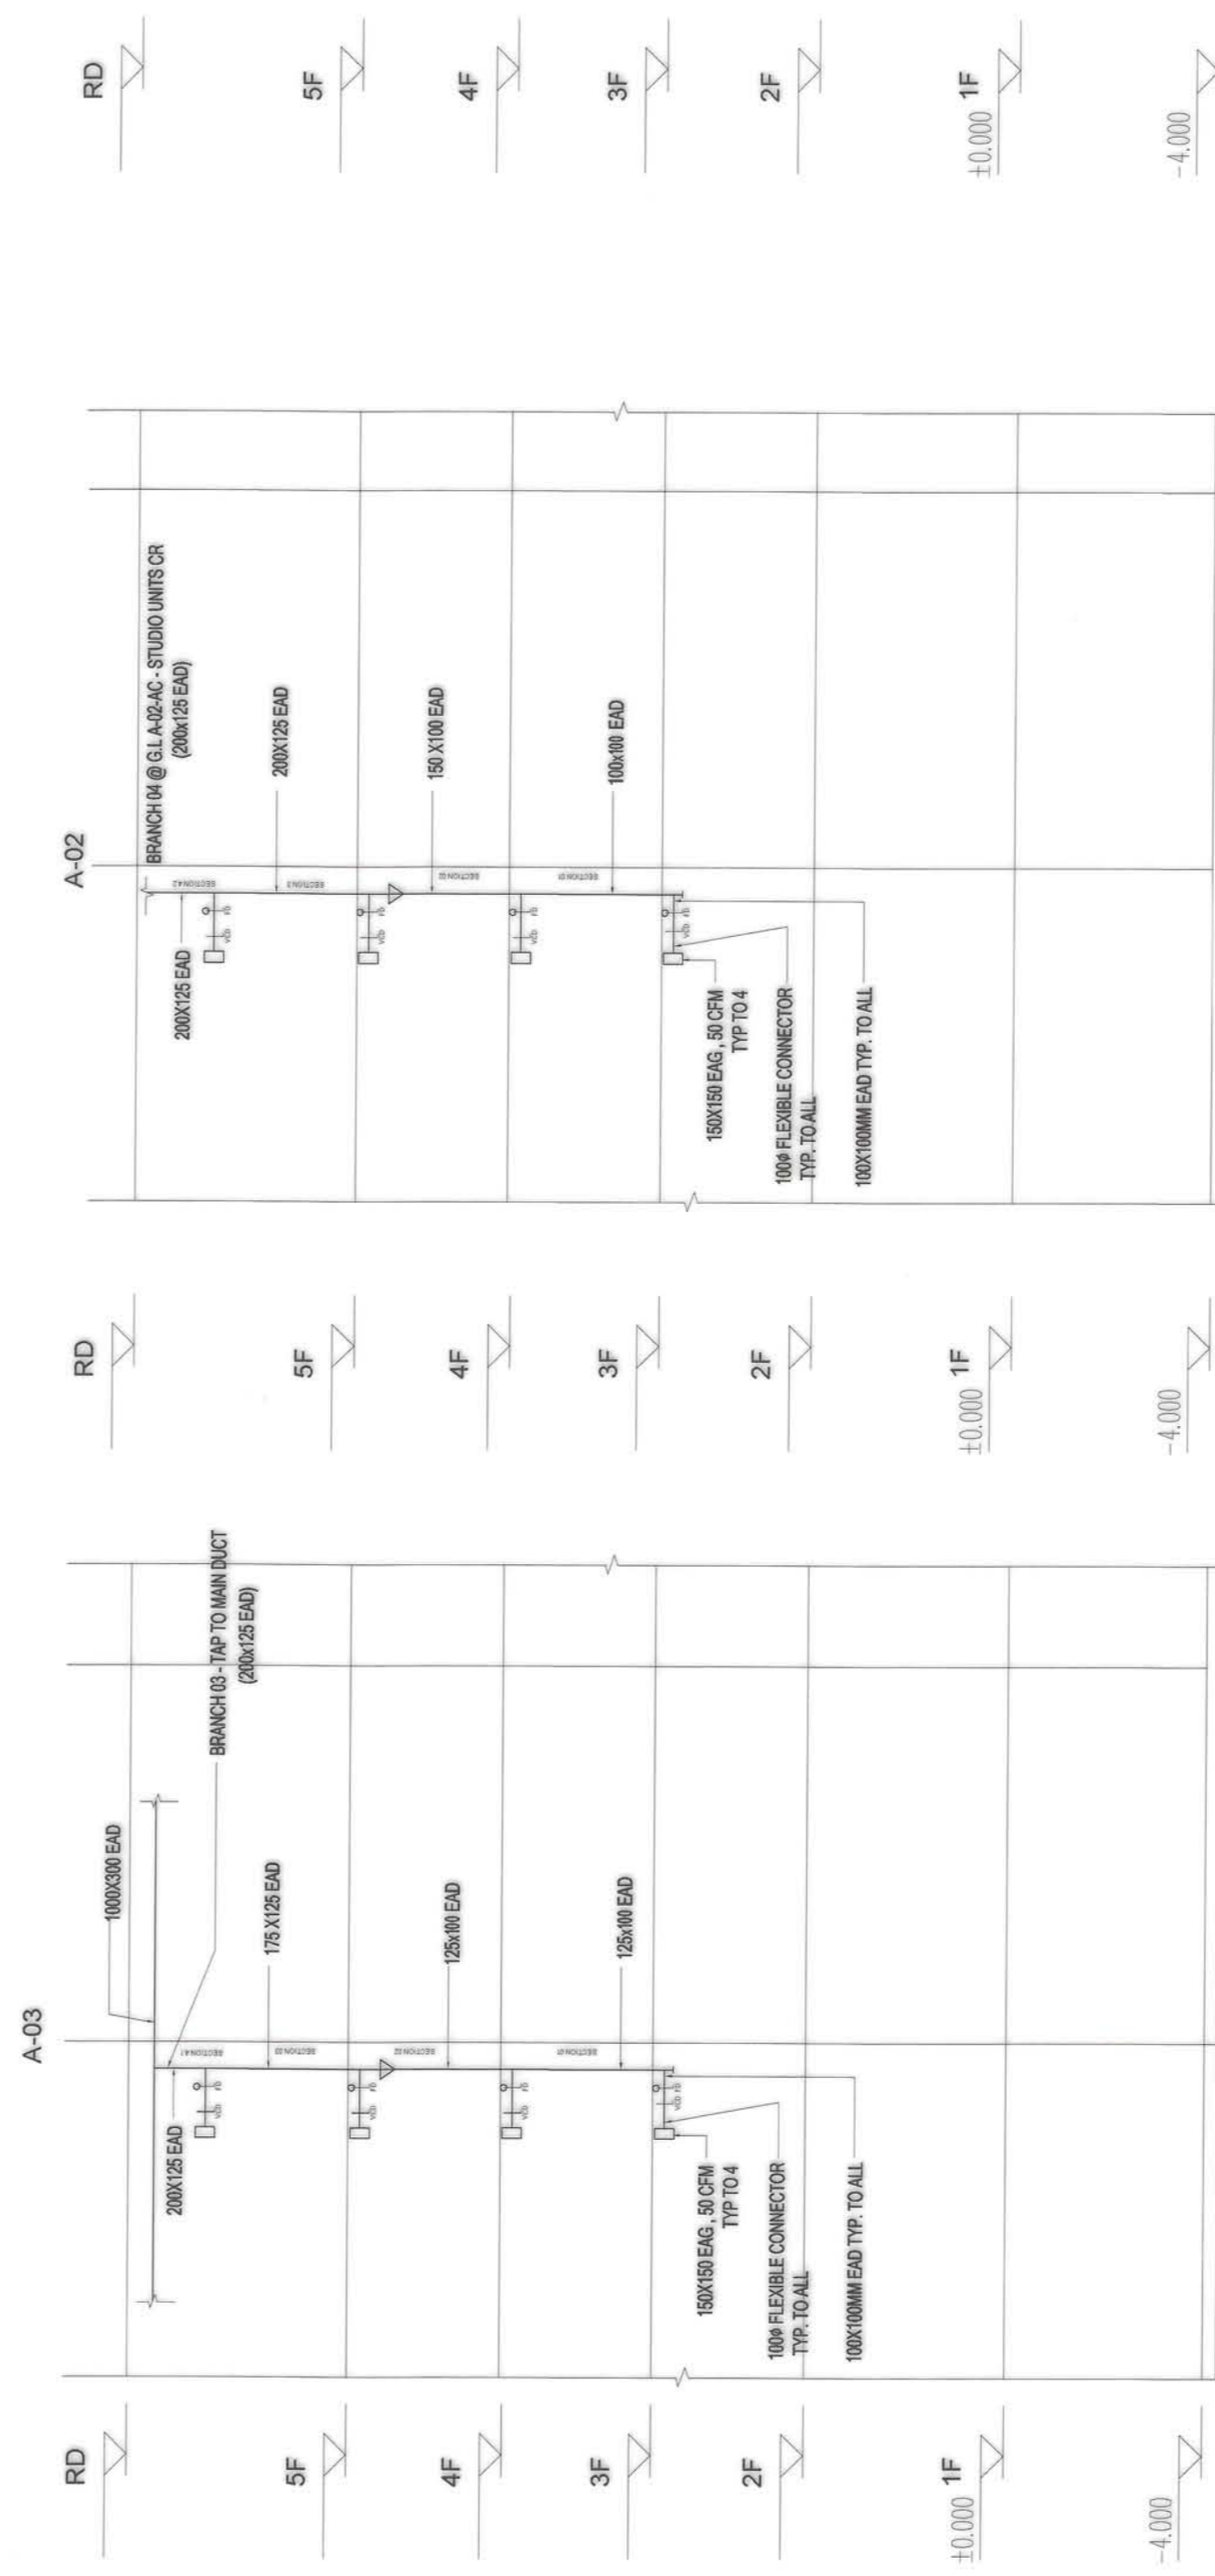

**SYSTEM 05 - EAD RISER DIAGRAM**  
**BRANCH 03 - 200.0 CFM**  
**BLD'G. A**

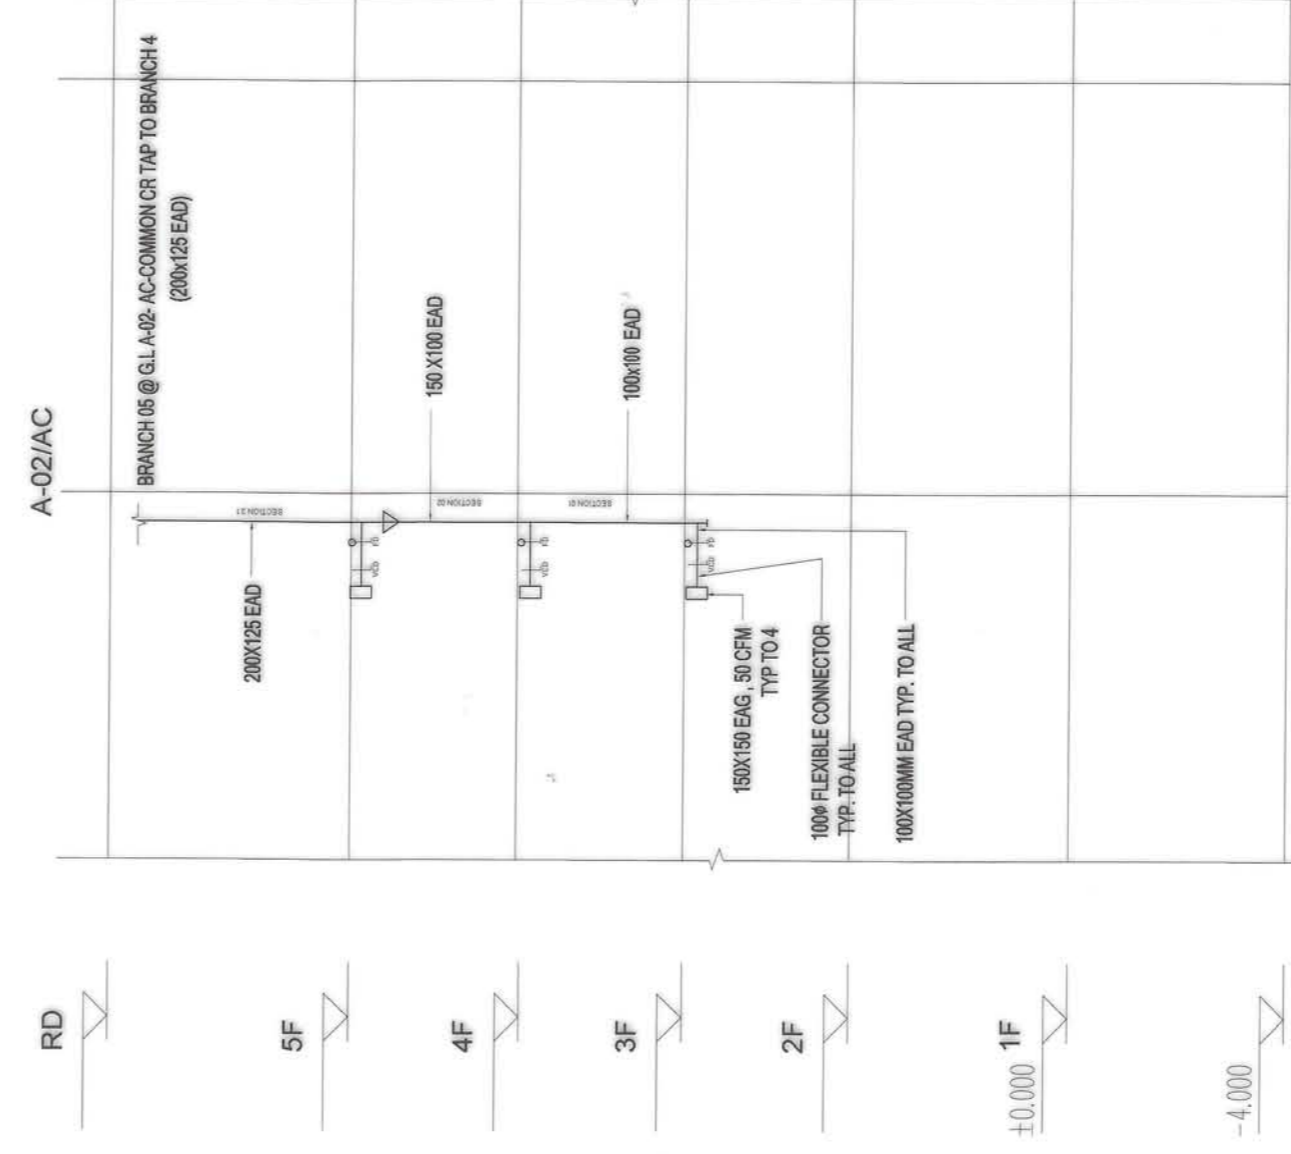


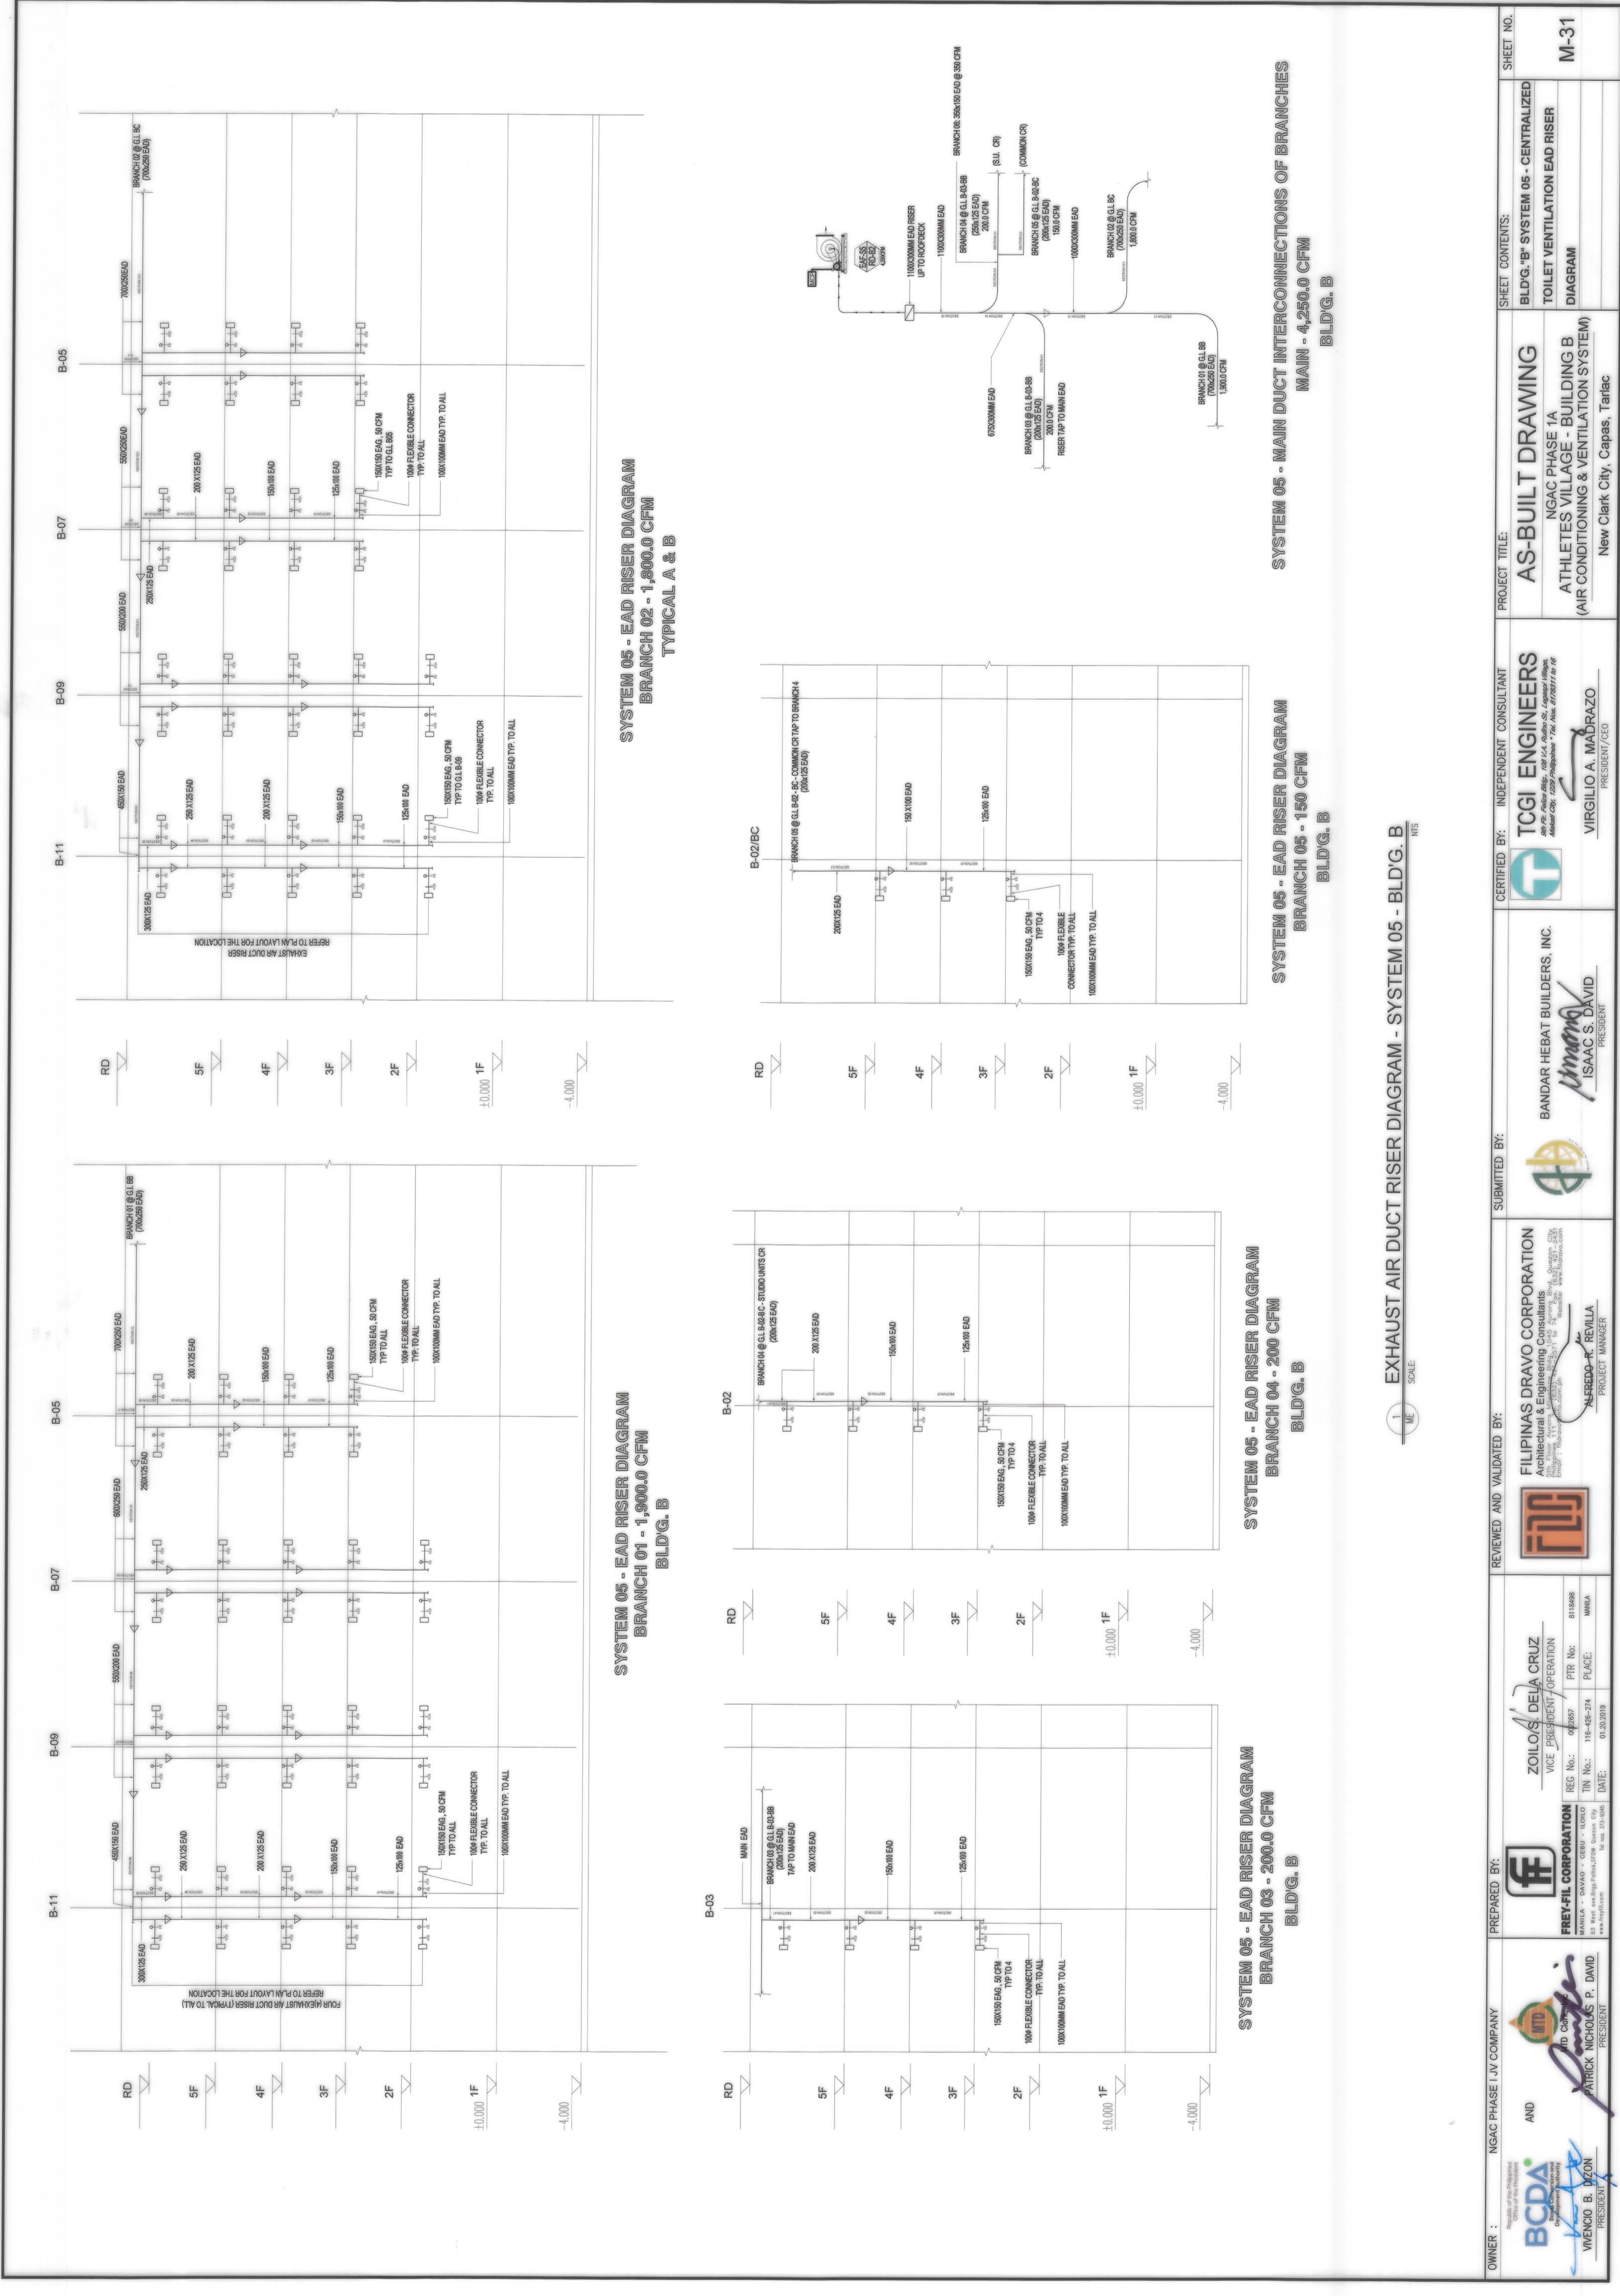
**SYSTEM 05 - EAD RISER DIAGRAM**  
**BRANCH 05 - 150 CFM**  
**BLD'G. A**

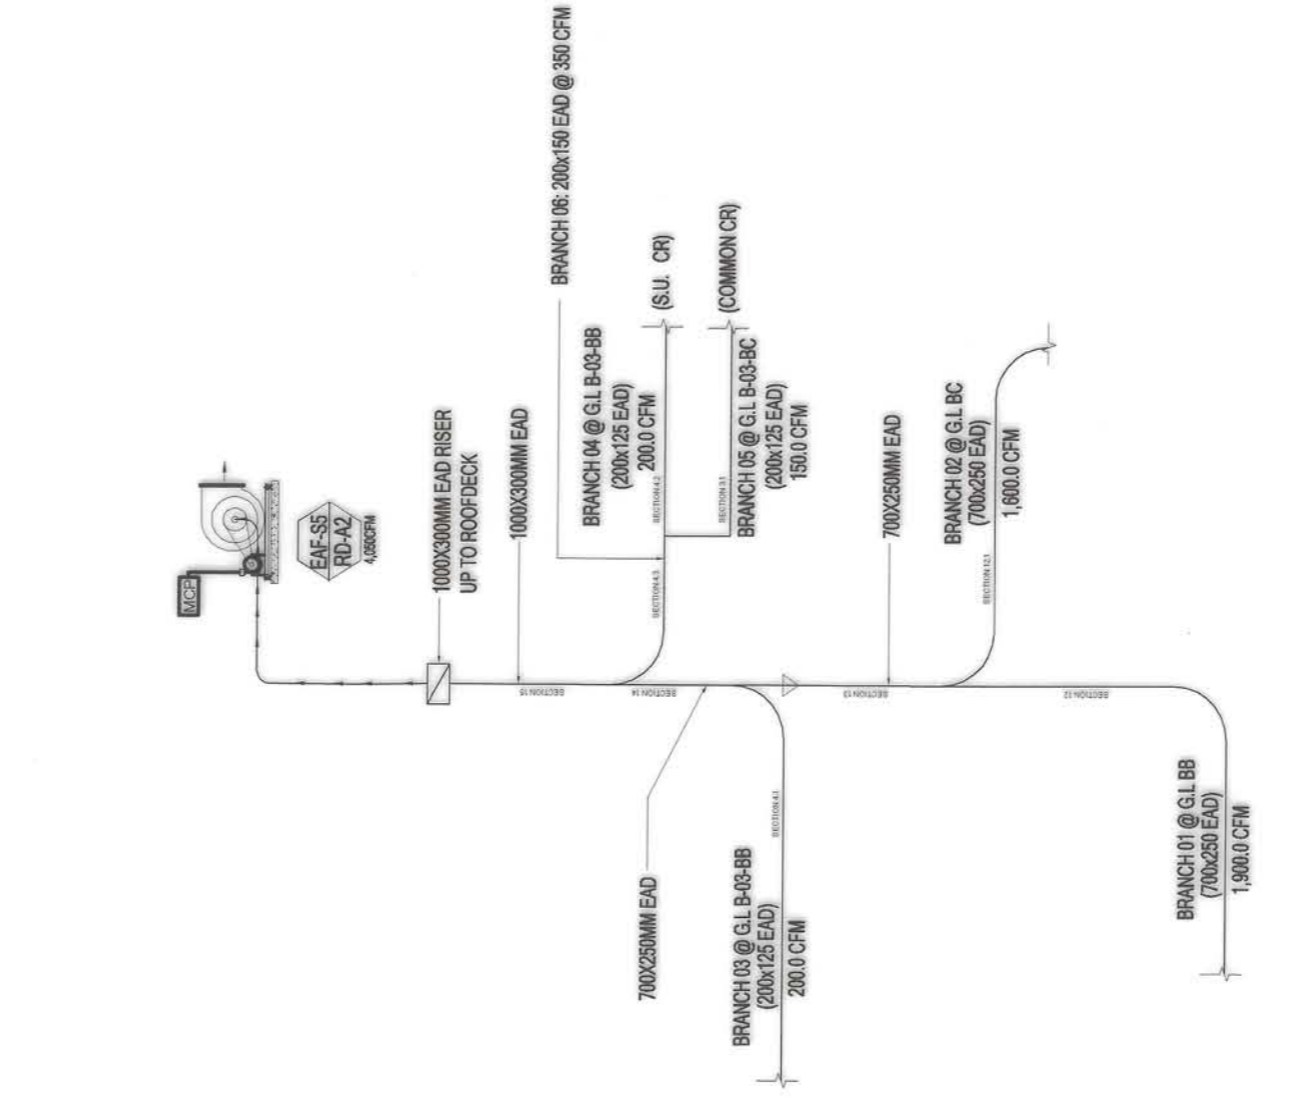


SYSTEM 05 - MAIN DUCT INTERCONNECTIONS OF BRANCHES  
MAIN - 4,050.0 CFM  
BLD'G. A

EXHAUST AIR DUCT RISER DIAGRAM - SYSTEM 05 - BLD'G. A




OWNER :	NGAC PHASE 1 JV COMPANY	PREPARED BY:	 <b>FREY-FIX CORPORATION</b> MANILA - BAYAN - CEBU - CORDO 83 West end Bay Palaro, Palaro, Cebu City Tel. 031-251-0466 www.freyfix.com	REVIEWED AND VALIDATED BY:	 <b>FILIPINAS DRAVO CORPORATION</b> Architectural & Engineering Consultants 2nd Floor, 11th Avenue, Bldg. 442, Ayala Center, 1200 Manila, Philippines Email: "Tel: 02-88620000, 88620001, 88620002, 88620003, 88620381,
---------	-------------------------	--------------	---	----------------------------	--



EXHAUST AIR DUCT RISER DIAGRAM - SYSTEM 05 - BLDG. B



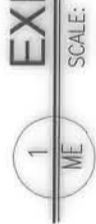


<b>OWNER :</b> NGAC PHASE I JV COMPANY  WENCIO B. DIZON PRESIDENT	<b>PREPARED BY:</b>  FREY-FIL CORPORATION MANILA - BARAYO - CEBU - ILOILO 153 West Ave Bldg. 10th Floor Cebu City Tel. nos. 375-5945 www.frey-fil.com	<b>REVIEWED AND VALIDATED BY:</b>  ZOLA'S DELA CRUZ VICE PRESIDENT / OPERATION REC. No.: 09-2857 TIN No.: 116-406-274 DATE: 01/23/2019	<b>SUBMITTED BY:</b>  BANDAR HEBAT BUILDERS, INC. ISAAC S. DAVID PRESIDENT	<b>CERTIFIED BY:</b> INDEPENDENT CONSULTANT  TCGI ENGINEERS 200 P. O. Box 888, 1st Floor, N. E. N. Bldg. 1st Floor Manila City, 1228 Philippines "Tel. Nos. 8778877 to 88"	<b>PROJECT TITLE:</b> <b>AS-BUILT DRAWING</b> NGAC PHASE 1A ATHLETES VILLAGE - BUILDING B (AIR CONDITIONING & VENTILATION SYSTEM) New Clark City, Capas, Tarlac	<b>SHEET CONTENTS:</b> BLDG. B" SYSTEM 05 - CENTRALIZED TOILET VENTILATION EAD RISER DIAGRAM	<b>SHEET NO.</b> M-31

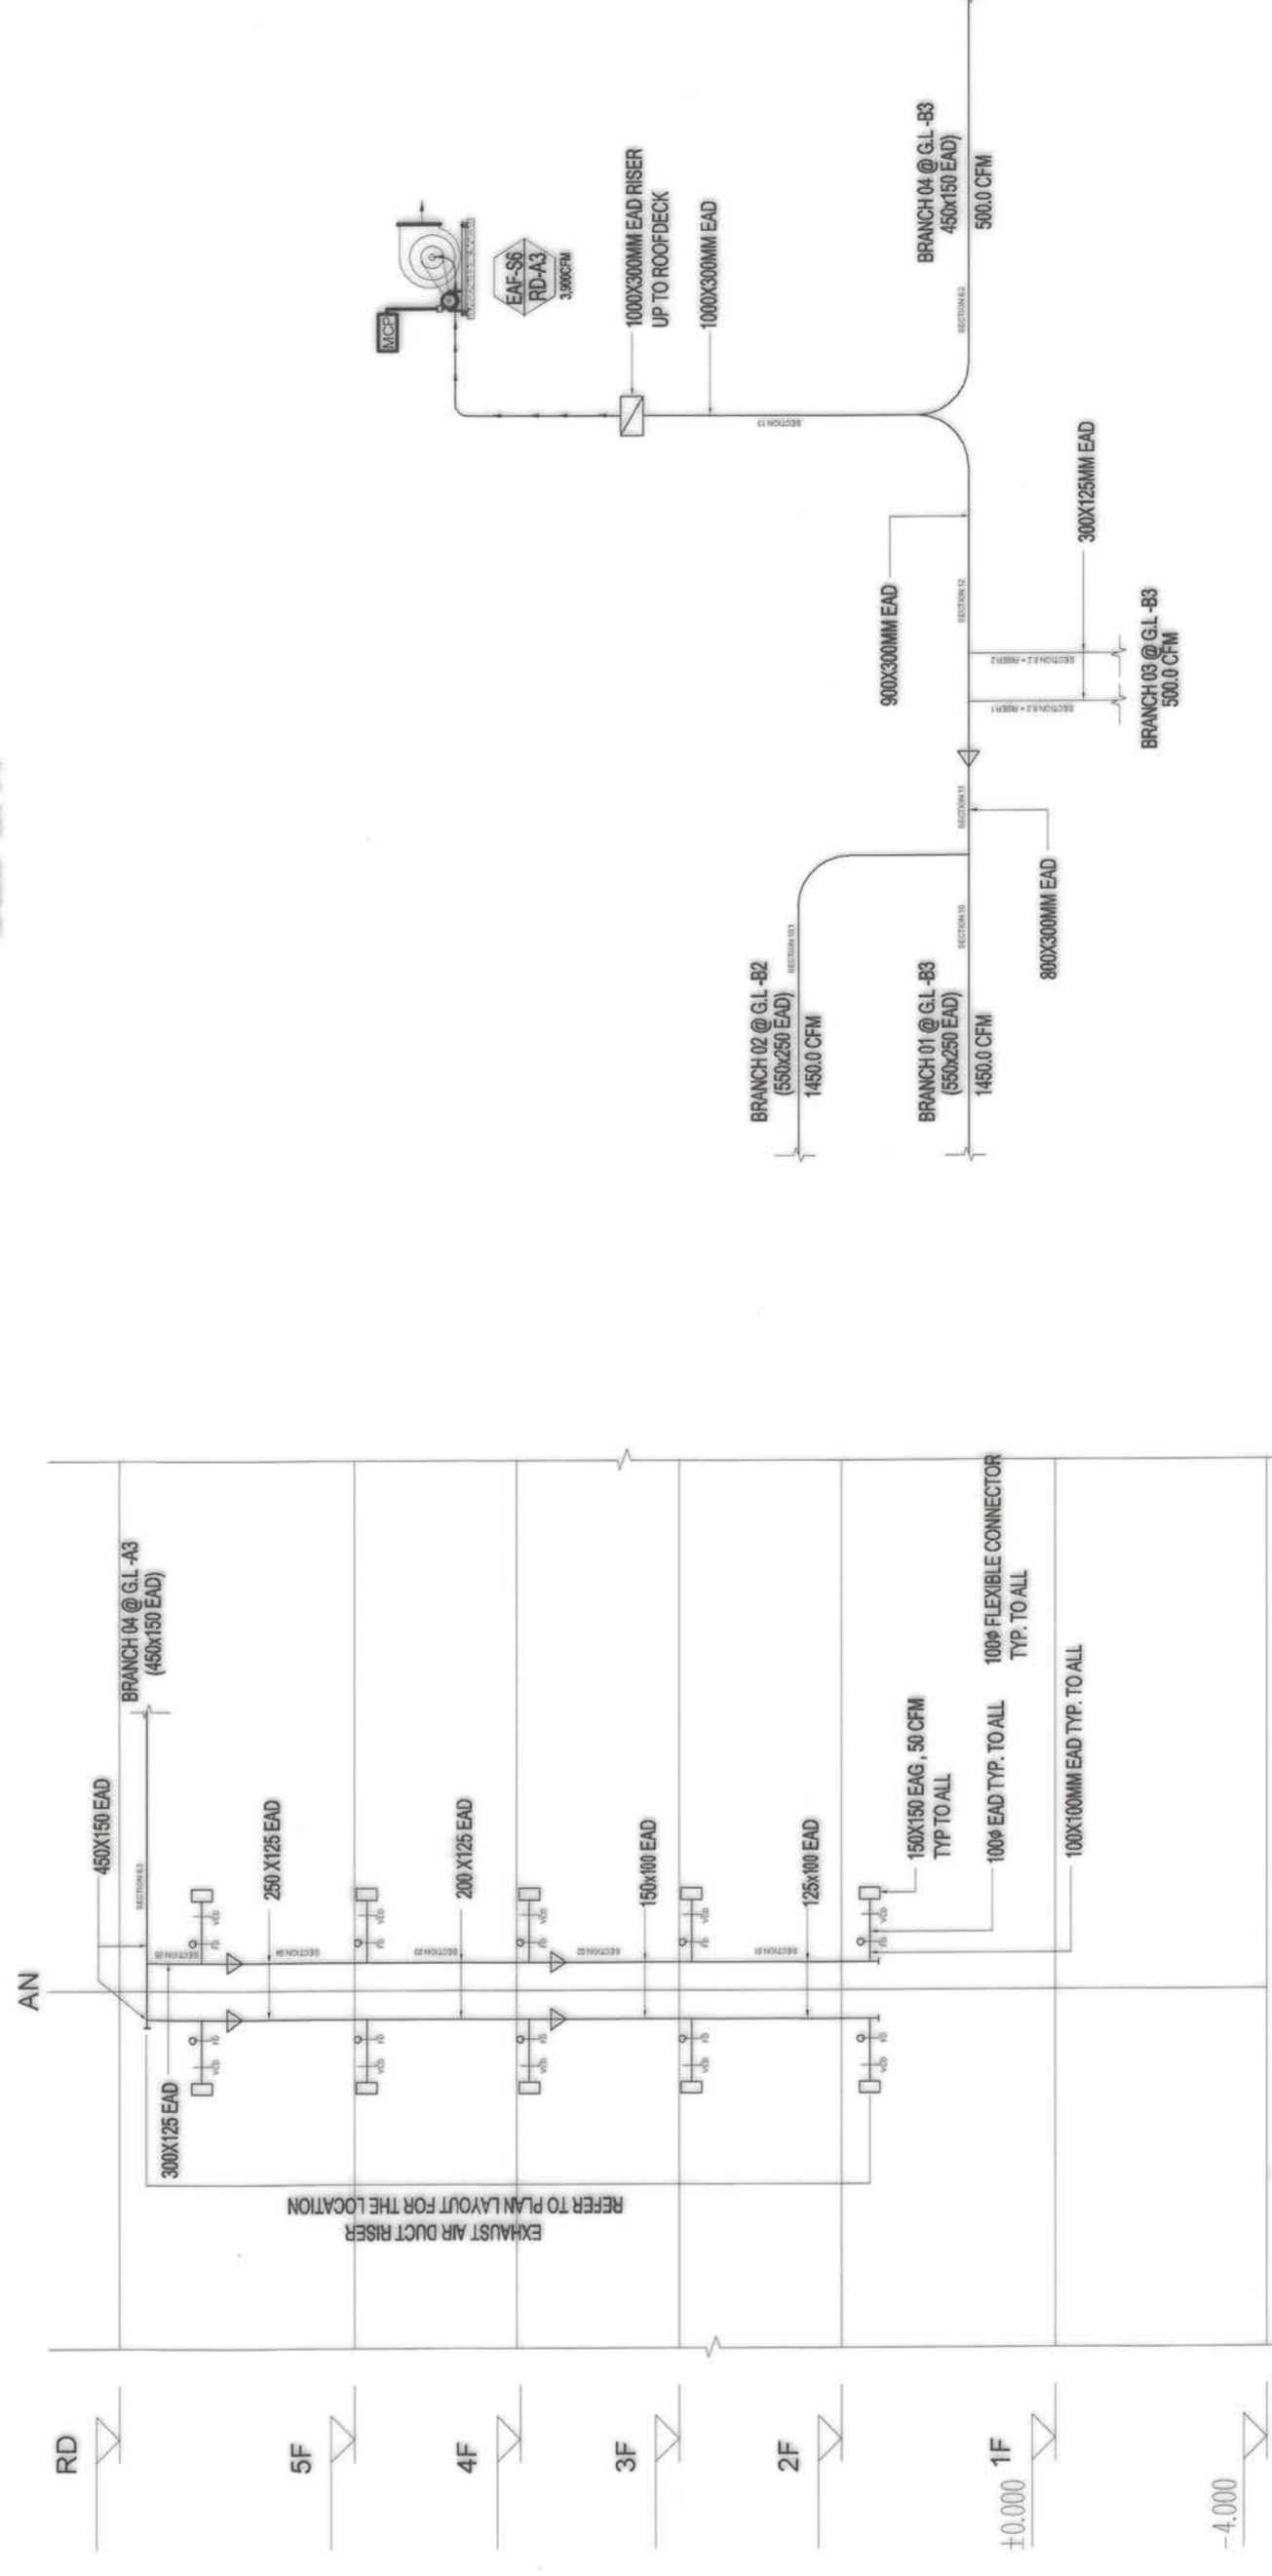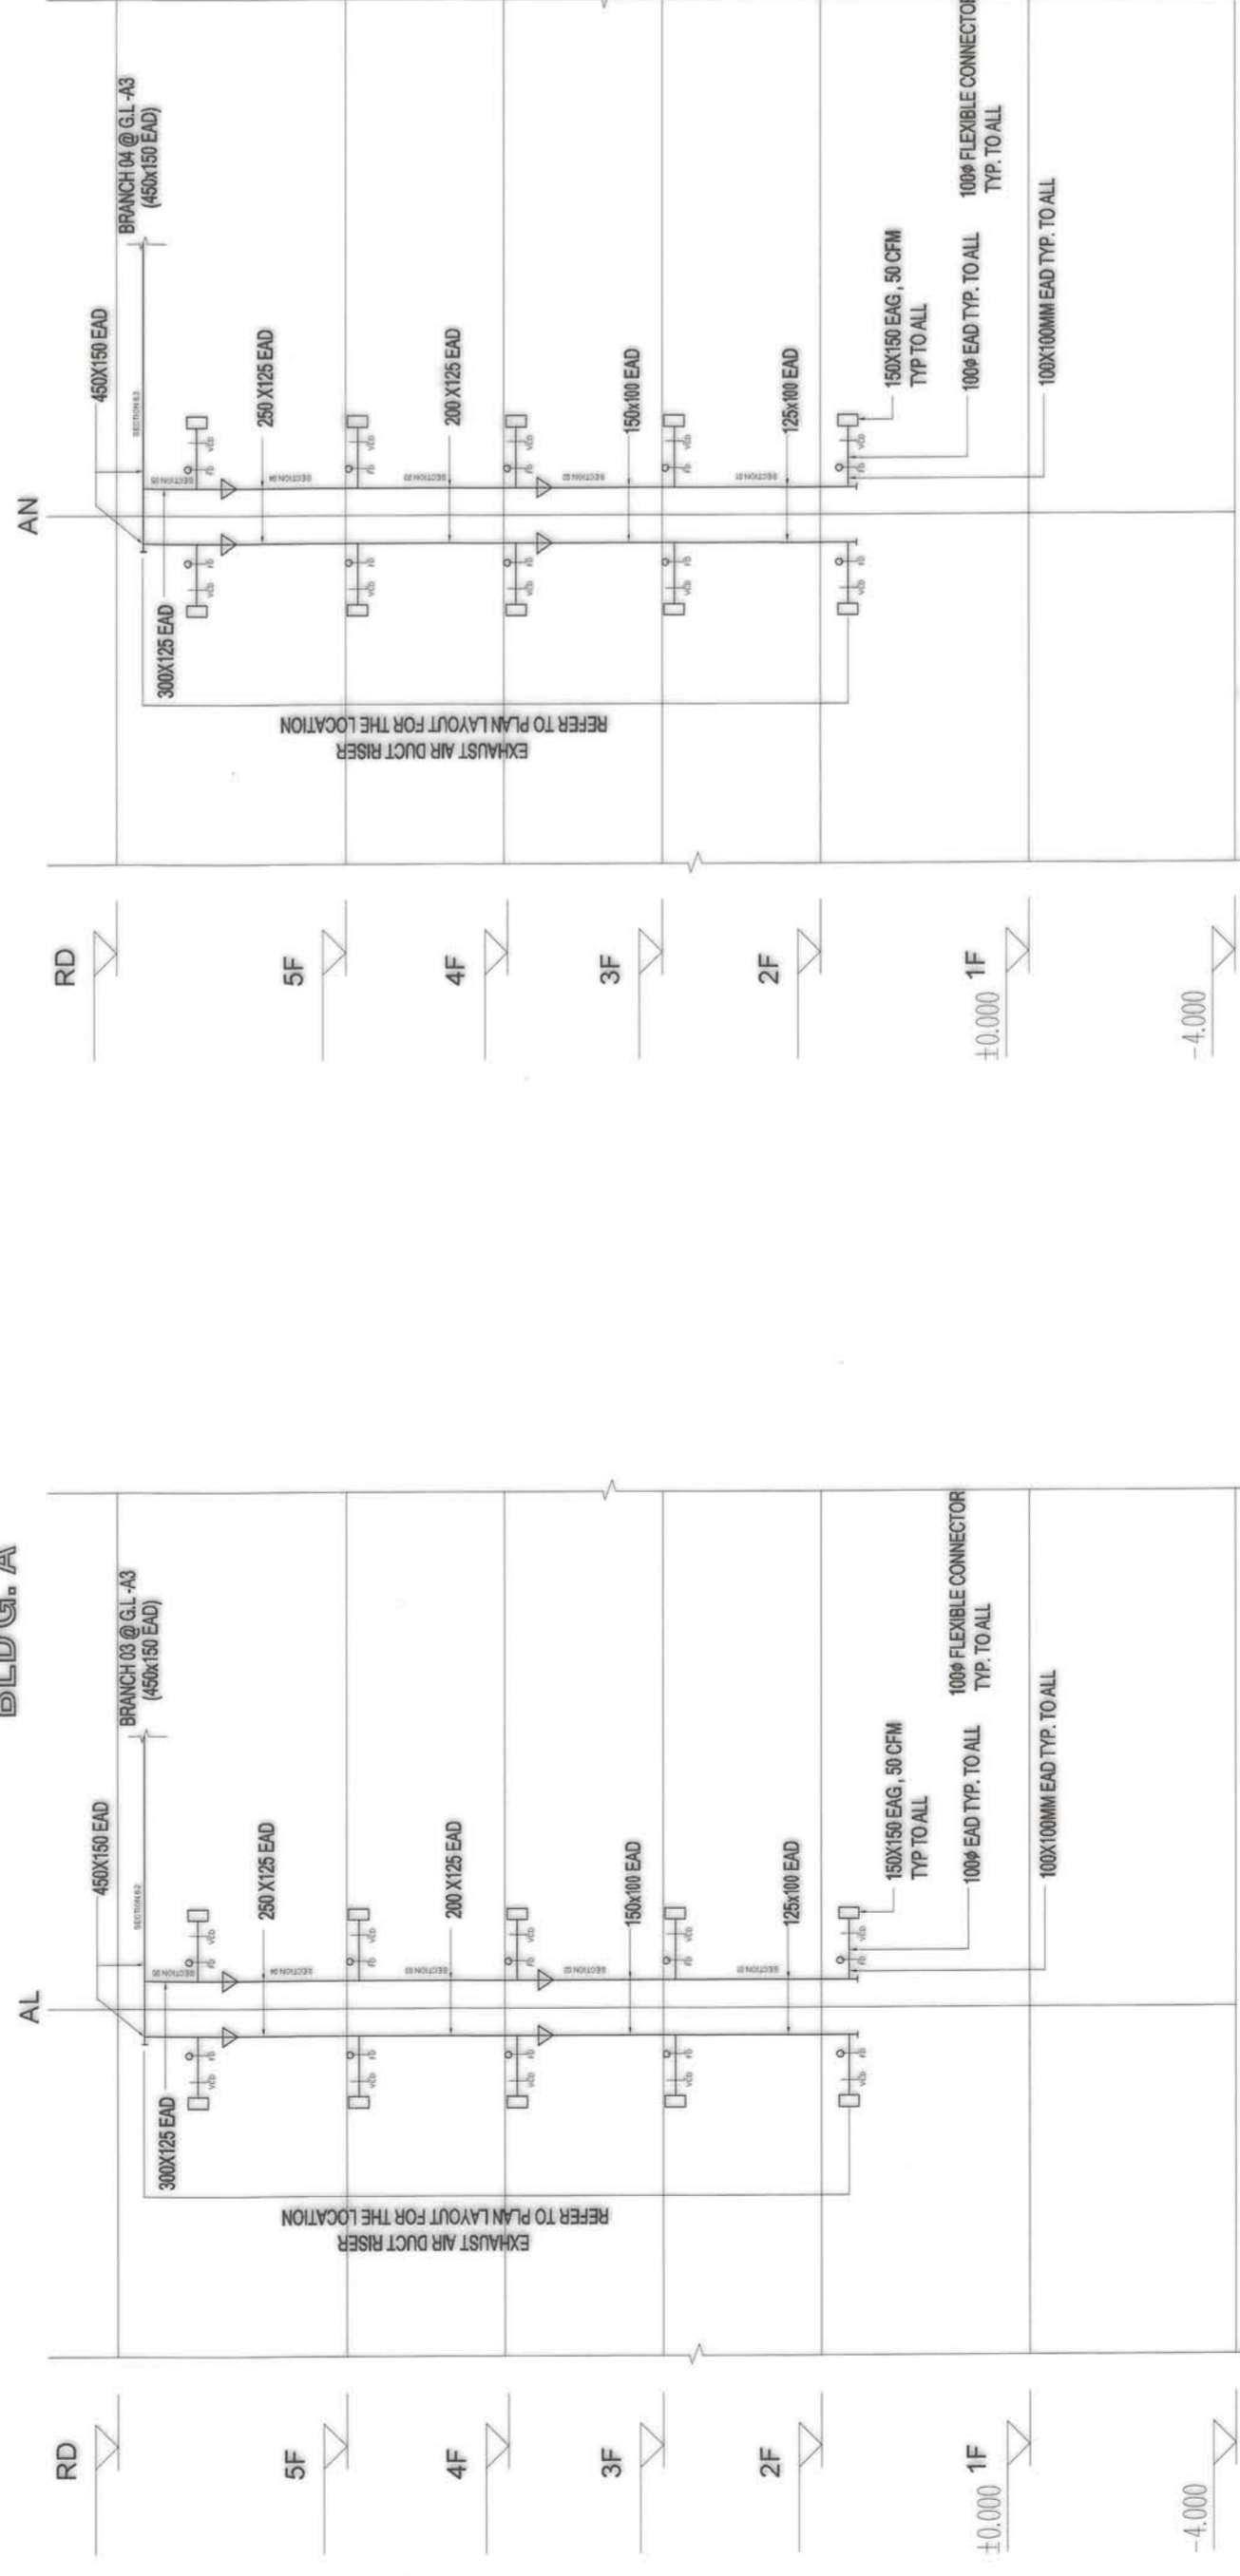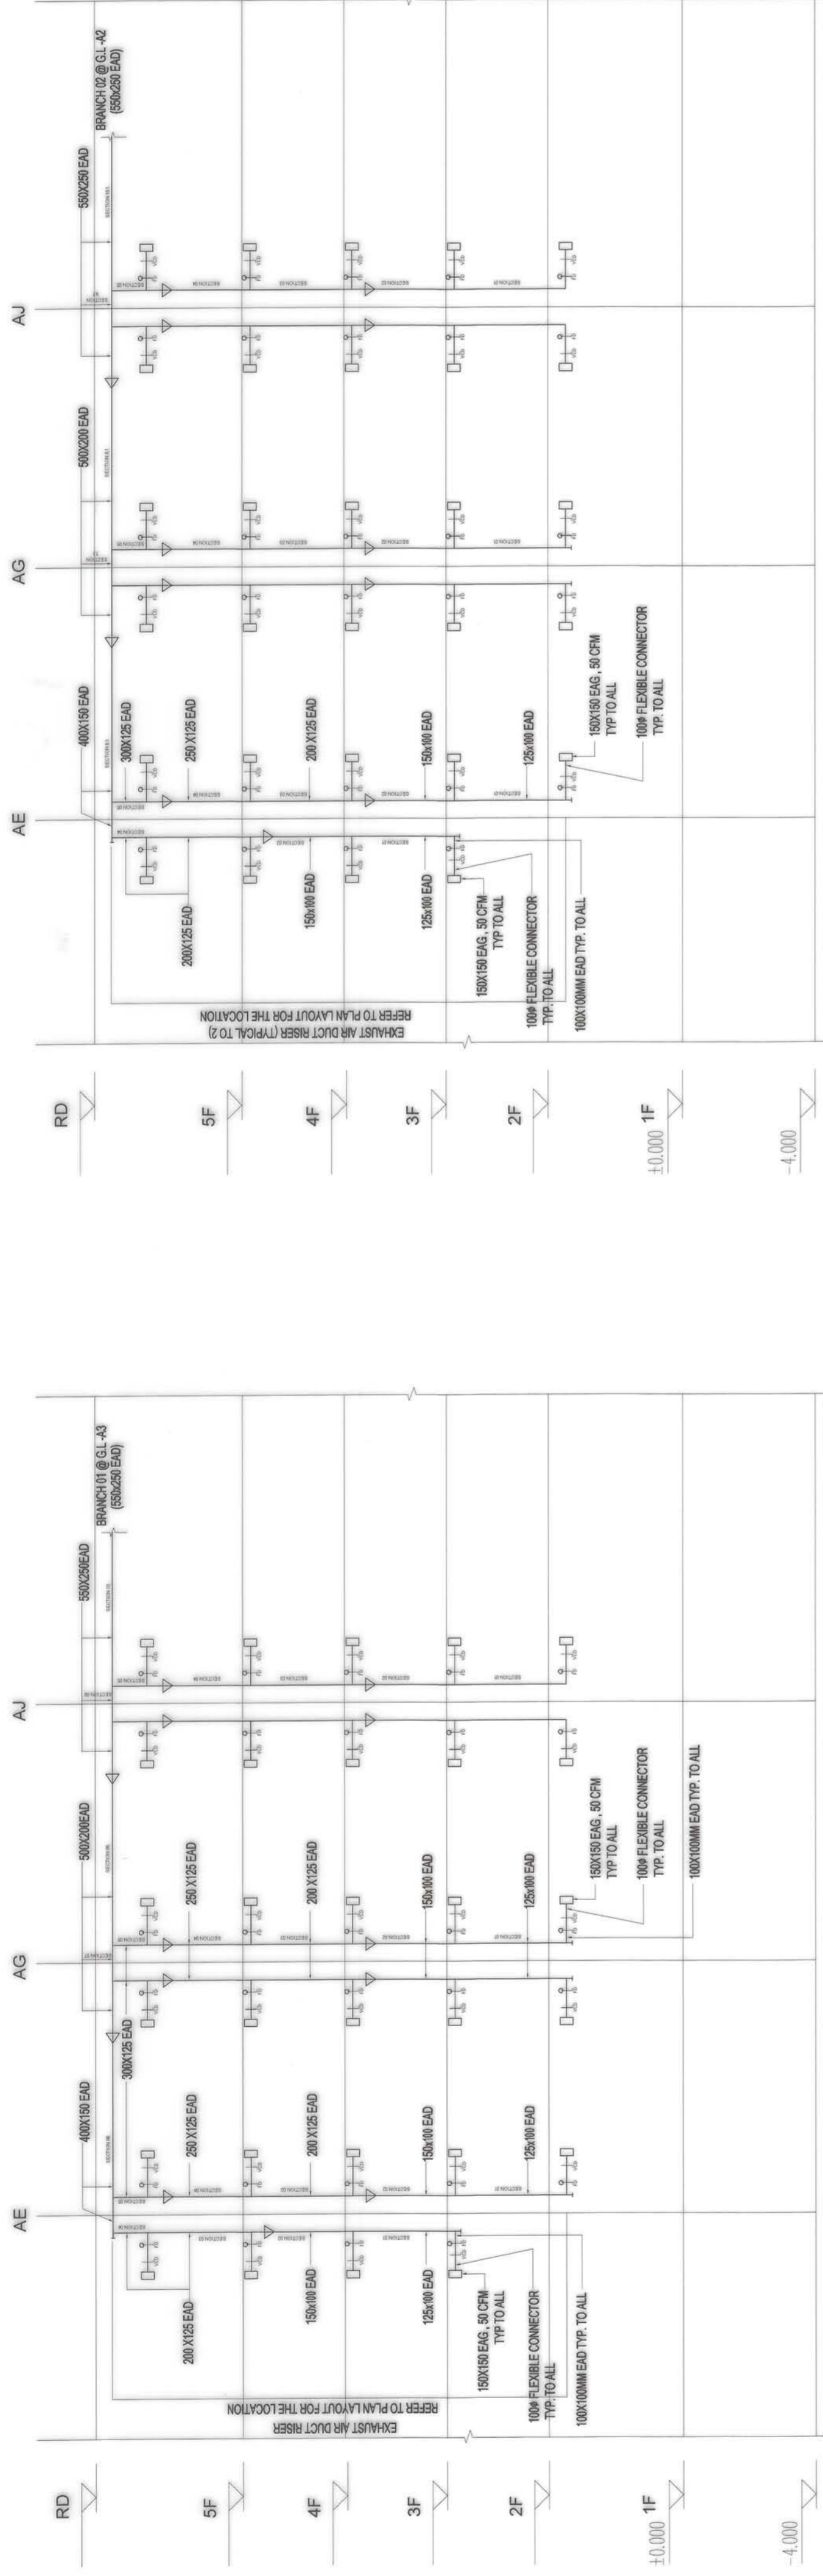

1 ME SCALE: NS  
EXHAUST AIR DUCT RISER DIAGRAM - SYSTEM 06 - BLD'G. A

OWNER :	NGAC PHASE 1 JV COMPANY	PREPARED BY:	 <b>FREY-FIL CORPORATION</b> MANILA • SAVAJO • CEBU • ILOILO 43 West end of Alibon, 270M Surban City Tel. 801-5346 www.freyfil.com	REG. No.: 0223507 PIR No.: 8118498 PLACE: MANILA	TIN No.: 116-468-274 DATE: 01-20-2019	 <b>FILIPINAS DRAVO CORPORATION</b> Architectural & Engineering Consultants 11th Floor, 1115 North Ave., Suite 1100, New York, NY 10017-1010 Tel: (212) 692-5334 Fax: (212) 692-5334 Email: info@filipinasdravo.com	REVIEWED AND VALIDATED BY:  <b>ALFREDO R. REVILLA</b> PROJECT MANAGER	SUBMITTED BY:  <b>BANDAR HEBAT BUILDERS, INC.</b>  <b>ISAAC S. DAVID</b> PRESIDENT	CERTIFIED BY:  <b>TCGI ENGINEERS</b> 5899 Pw. Alibon Rd., Unit 1-A, Alibon St., Leganes, Iloilo Mindoro City, 5200 Philippines Tel. No. 4770571 to 7108	VIRGILIO A. MADRAZO PRESIDENT / CEO	PROJECT TITLE: <b>AS-BUILT DRAWING</b> NGAC PHASE 1A ATHLETES VILLAGE - BUILDING A (AIR CONDITIONING & VENTILATION SYSTEM) New Clark City, Capas, Tarlac	SHEET CONTENTS: BLD'G.'A' SYSTEM 06 - CENTRALIZED TOILET VENTILATION EAD RISER DIAGRAM	SHEET NO. <b>M-32</b>
---------	-------------------------	--------------	--	--	--	--	---	--	--	--	---	---	--------------------------

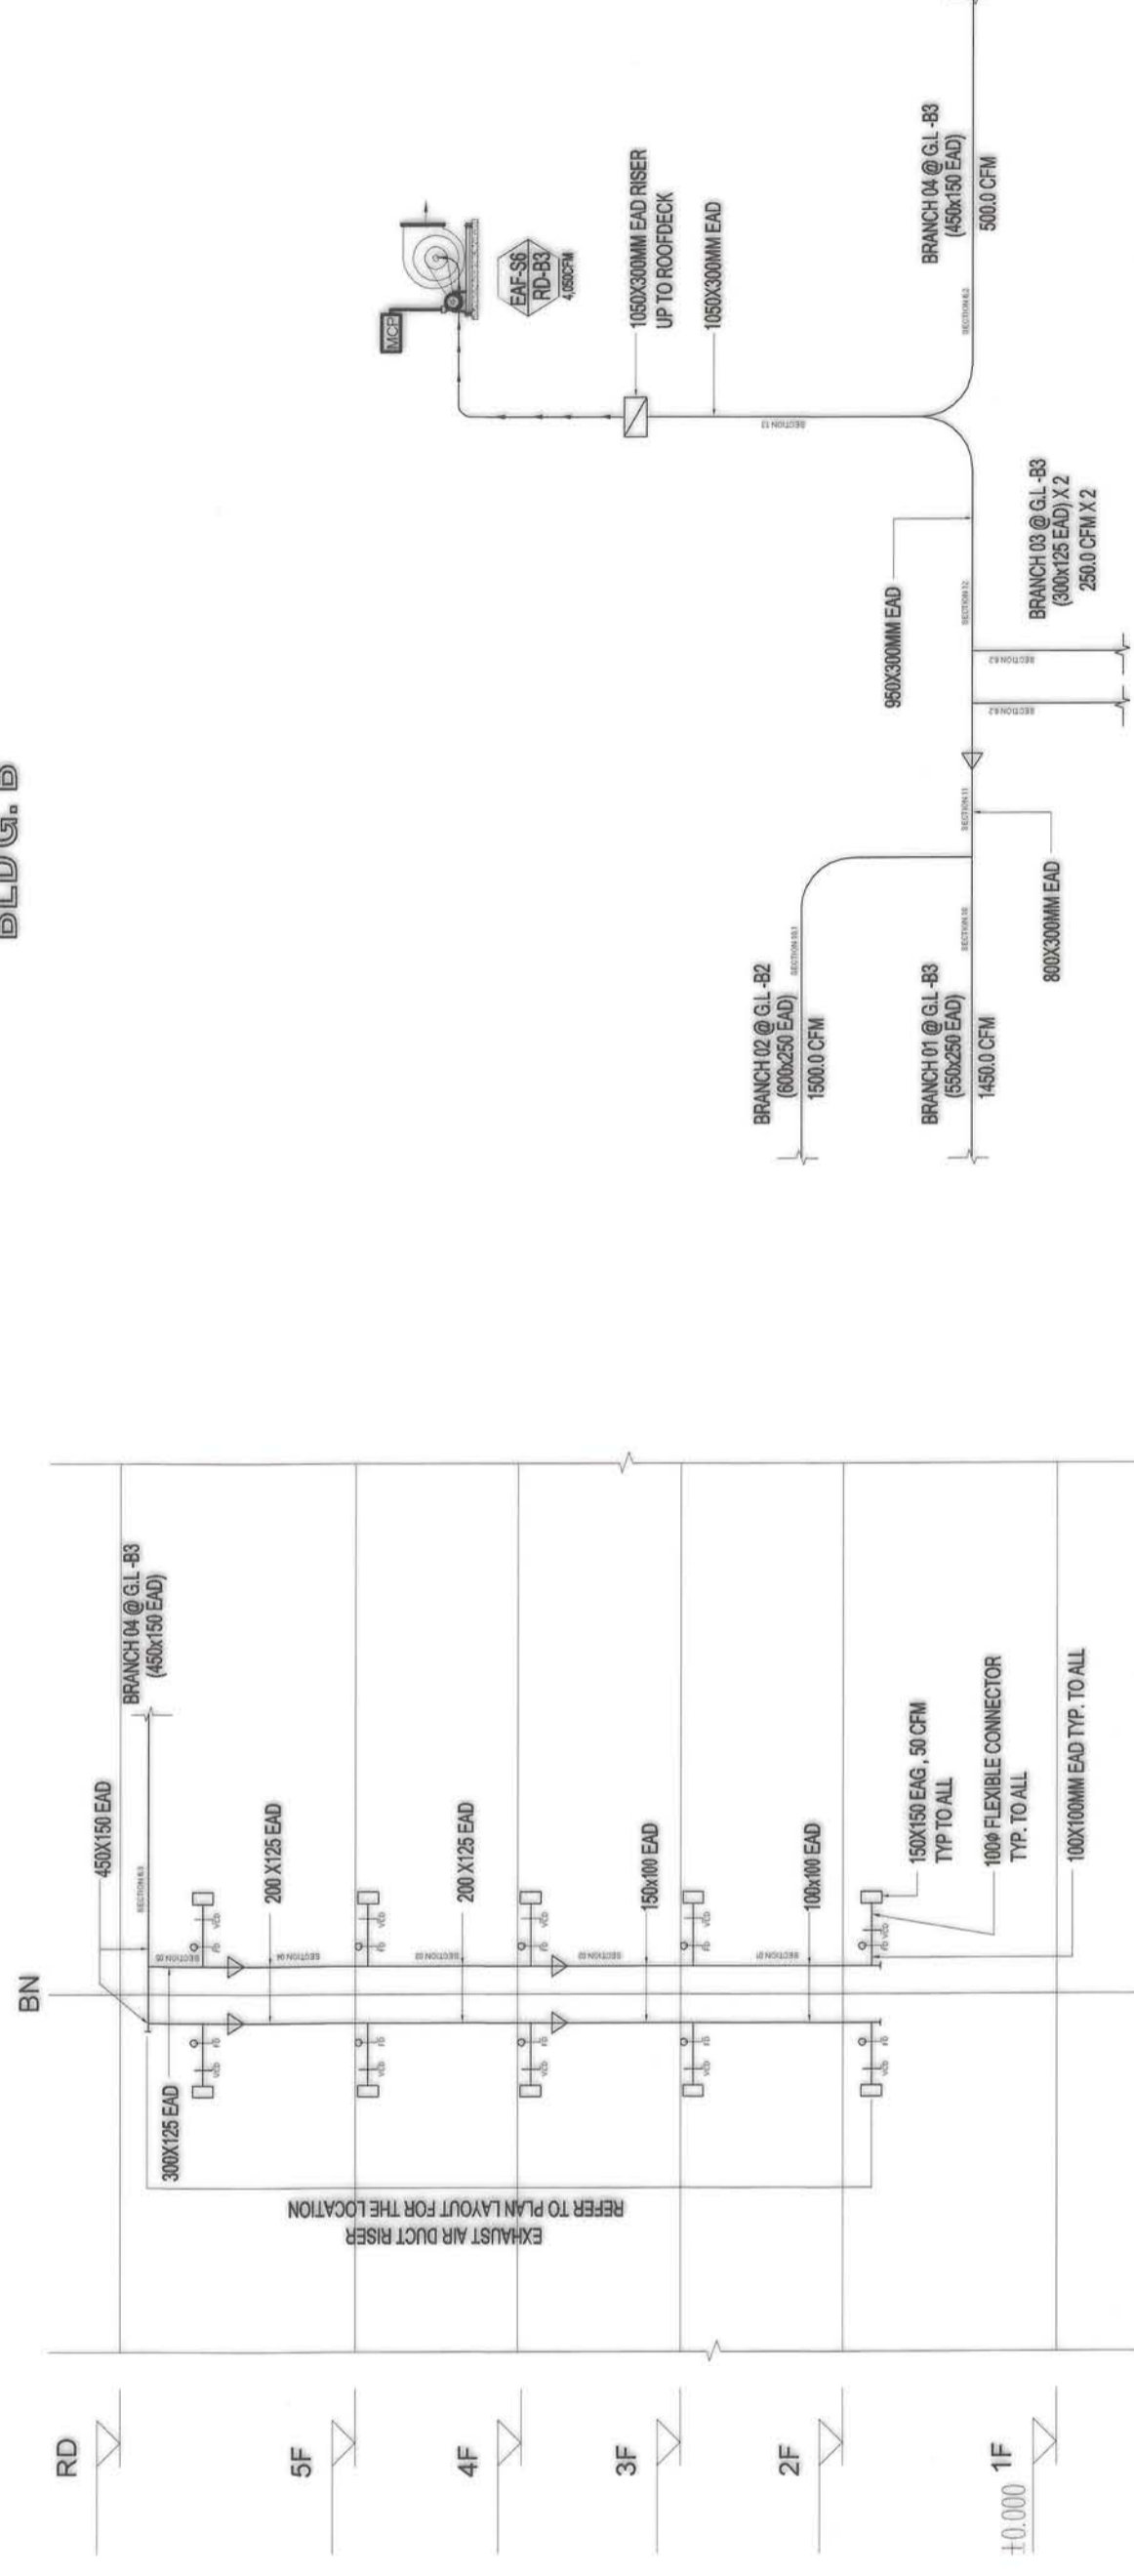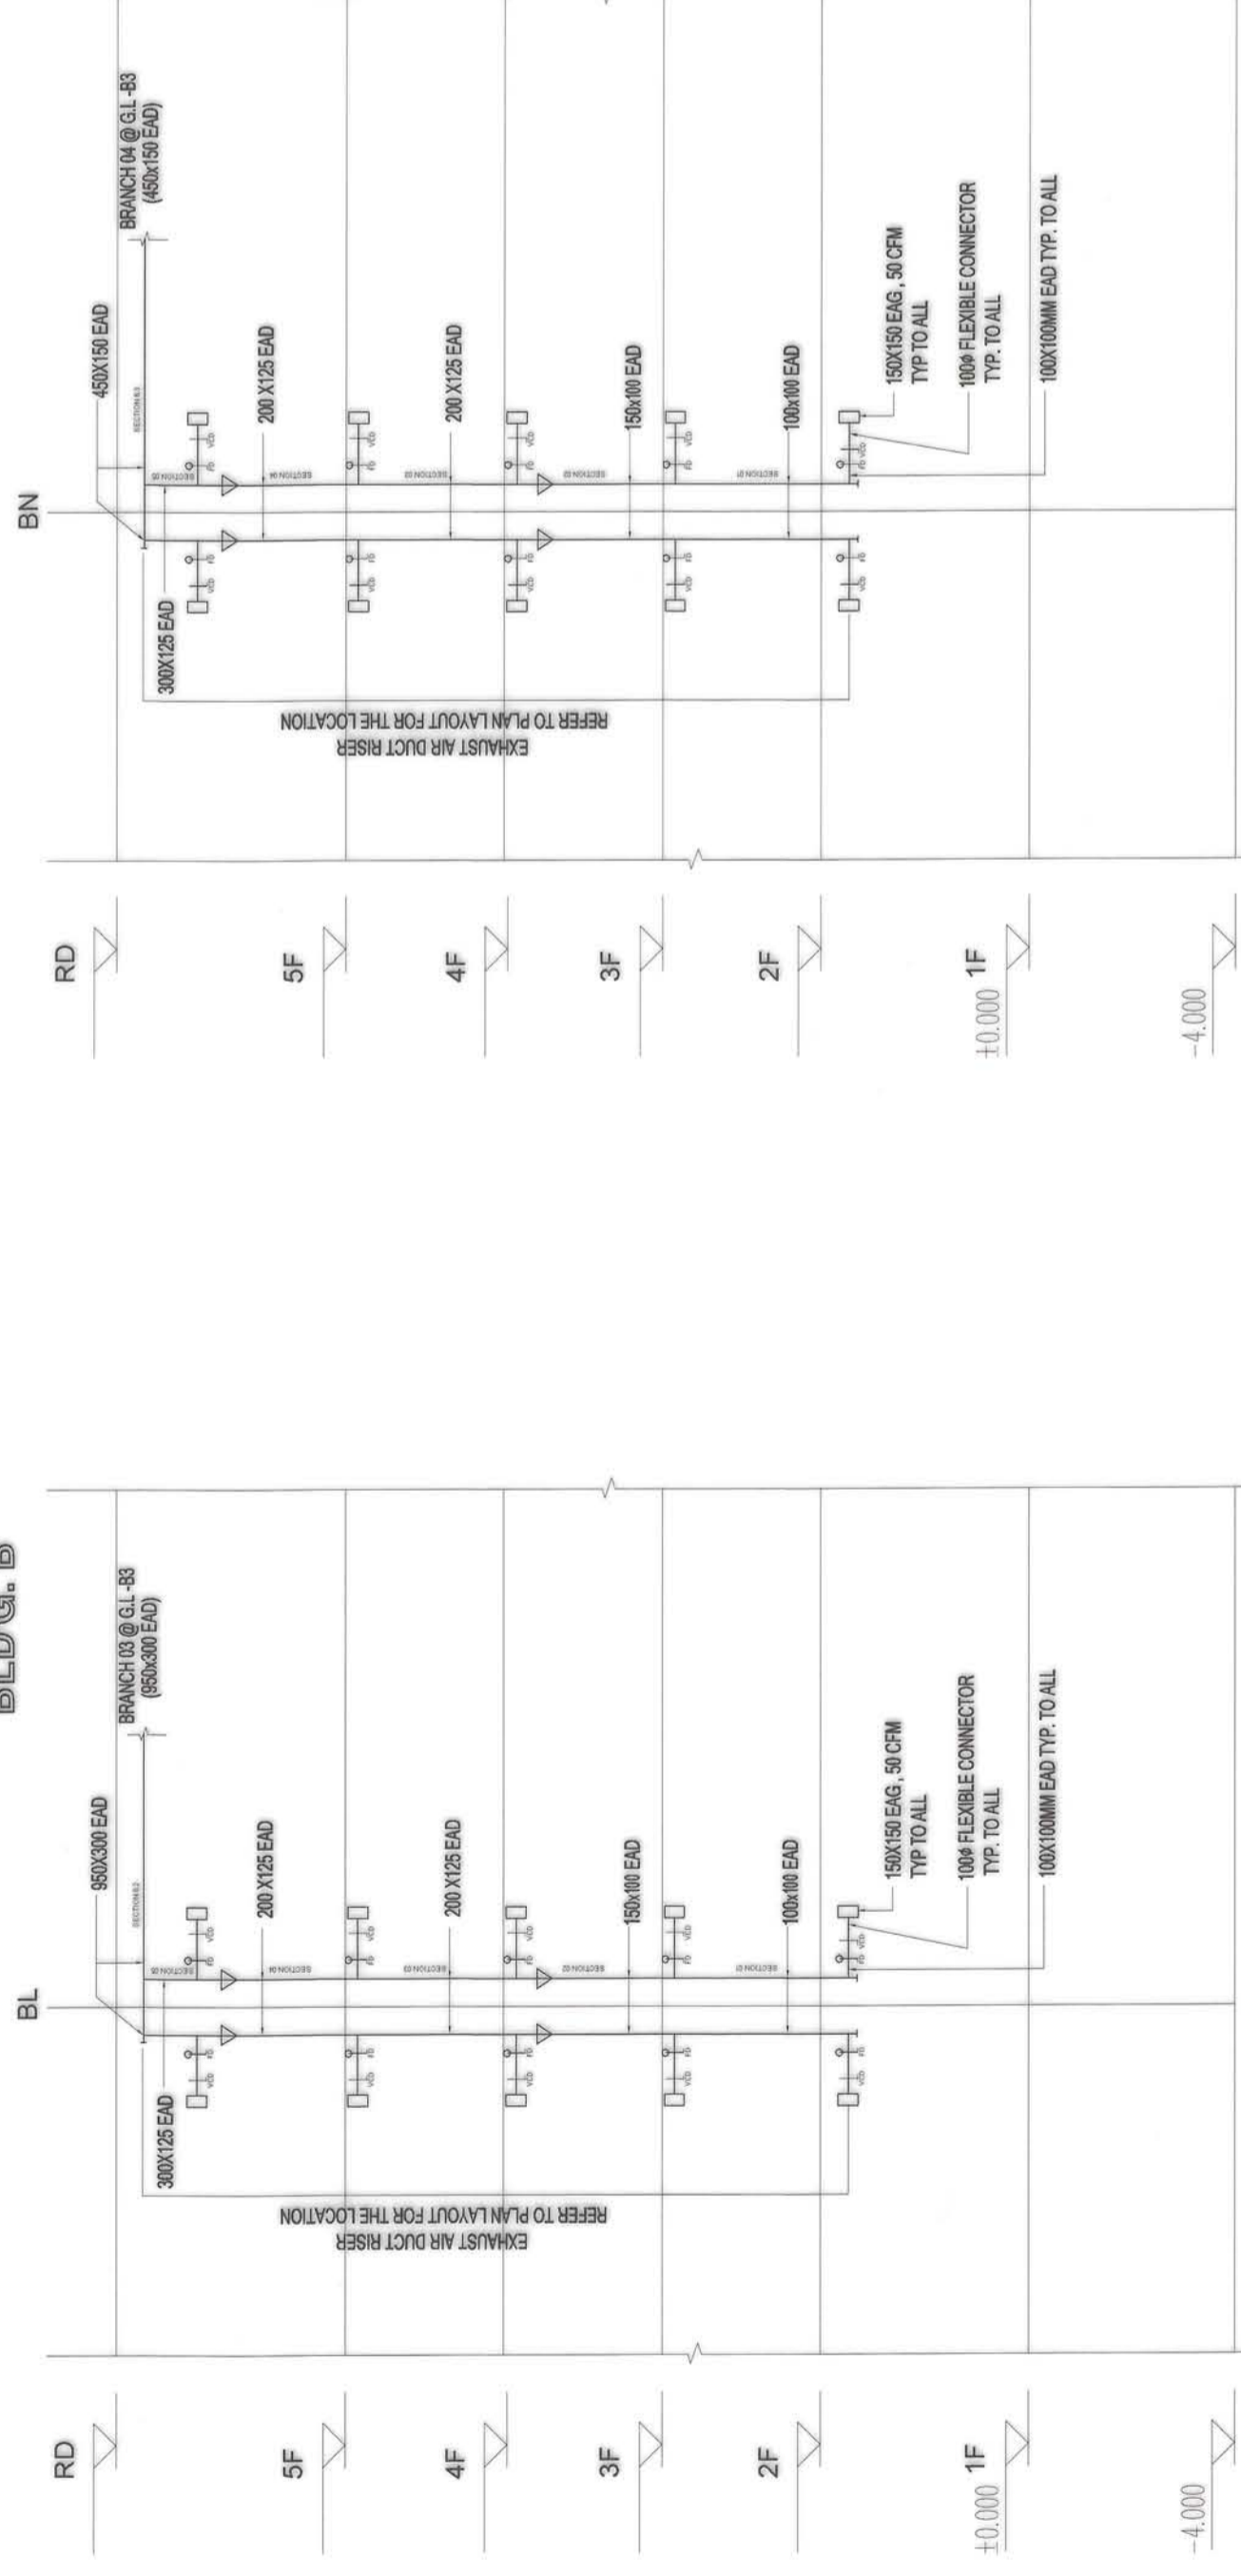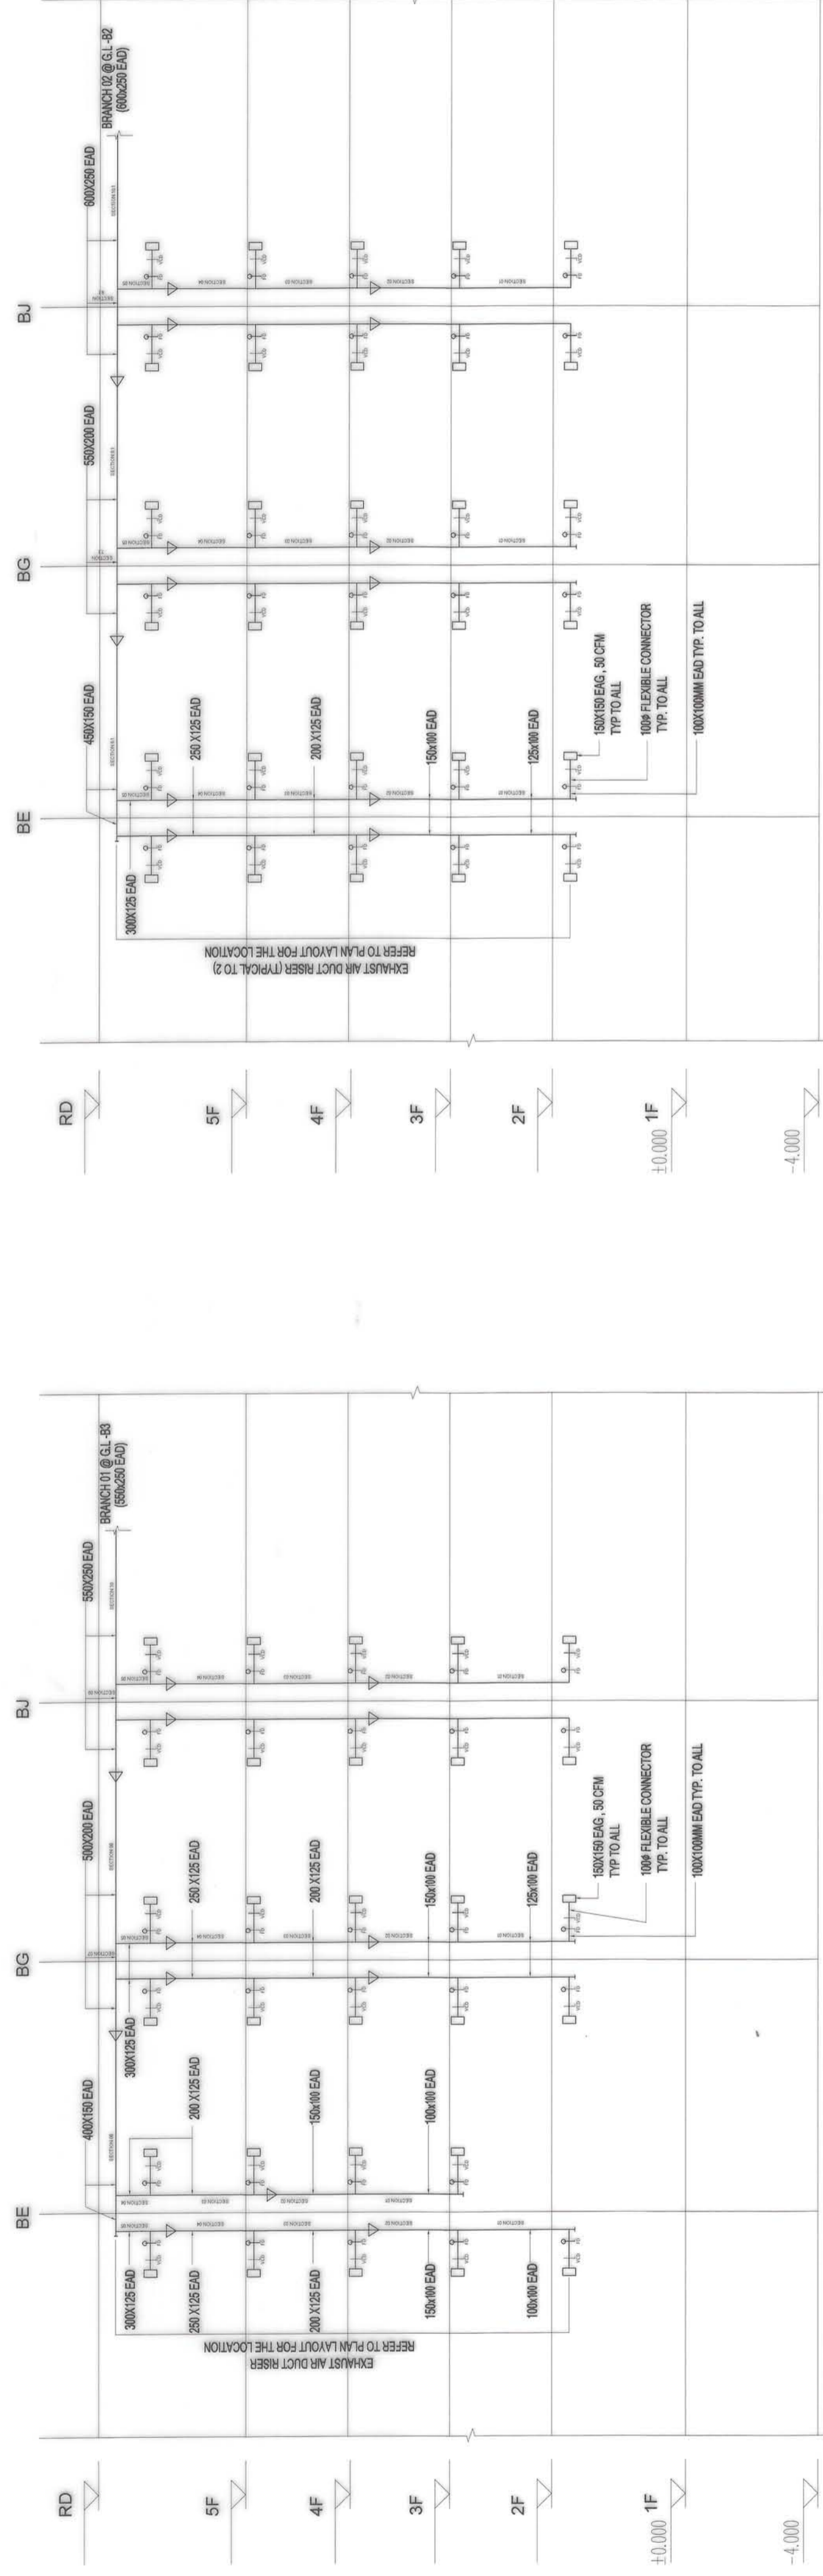

1 ME SCALE: NS  
EXHAUST AIR DUCT RISER DIAGRAM - SYSTEM 06 - BLD'G. B




 







[illegible]














01.) ALL PRESSURIZATION AIR FANS (PAF) AND SMOKE EXTRACTION FANS (SEF) WILL AUTOMATICALLY ENERGIZED/RUN ONCE IT RECEIVE SIGNAL FROM FDAS OR FIRE ALARM CONTROL PANEL (FACP.)

- LEGEND:

**DPC** = DIFFERENTIAL PRESSURE CONTROLLER  
**DPS** = DIFFERENTIAL PRESSURE SENSOR  
**M** = MOTORIZED RELIEF DAMPER




OWNER :	NGAC PHASE I JV COMPANY	PREPARED BY:	 <b>FREY-FIL CORPORATION</b> MANILA • DAVAO • CEBU • ILOILO 83 West Ave. Bldg. 10th Fl. JFE Tower, Quezon City www.freyfil.com.ph Tel. no. 335-5865	REVIEWED AND VALIDATED BY:	 <b>FILIPINAS DRAVO CORPORATION</b> Architectural & Engineering Consultants 1111 11th Avenue, 11th Floor, 11th Avenue, Quezon City Phone: 886-8868 • Fax: 886-8868 • Email: info@fdravo.com.ph	SUBMITTED BY:	 <b>BANDAR HEBAT BUILDERS, INC.</b>  <b>ISAAC S. DANO</b> PRESIDENT	CERTIFIED BY:	 <b>TCGI ENGINEERS</b> 899 P.F. Palanca Bldg., 108 P.A. Palanca St., Legaspi Village Makati City, 1229 Philippines Tel. No. 7752771 to 7760	PROJECT TITLE:	<b>AS-BUILT DRAWING</b> NGAC PHASE 1A ATHLETES VILLAGE - BUILDING A & B (AIR CONDITIONING & VENTILATION SYSTEM)	SHEET CONTENTS:	BLD'G. "A" AND "B" SMOKE EVACUATION RISER DIAGRAM	SHEET NO.	M-34
OWNER :	 <b>BCDA</b> Bureau of Commonwealth Development and Administrative Services 1000 Commonwealth Avenue, 10th Floor, Quezon City	 <b>MTD</b> MTD Group, Inc. 1000 Commonwealth Avenue, 10th Floor, Quezon City	 <b>PATRICK NICHOLAS P. DAVID</b> PRESIDENT	 <b>FREY-FIL CORPORATION</b> MANILA • DAVAO • CEBU • ILOILO 83 West Ave. Bldg. 10th Fl. JFE Tower, Quezon City www.freyfil.com.ph Tel. no. 335-5865	 <b>FILIPINAS DRAVO CORPORATION</b> Architectural & Engineering Consultants 1111 11th Avenue, 11th Floor, 11th Avenue, Quezon City Phone: 886-8868 • Fax: 886-8868 • Email: info@fdravo.com.ph	 <b>BANDAR HEBAT BUILDERS, INC.</b>  <b>ISAAC S. DANO</b> PRESIDENT	 <b>TCGI ENGINEERS</b> 899 P.F. Palanca Bldg., 108 P.A. Palanca St., Legaspi Village Makati City, 1229 Philippines Tel. No. 7752771 to 7760	<b>AS-BUILT DRAWING</b> NGAC PHASE 1A ATHLETES VILLAGE - BUILDING A & B (AIR CONDITIONING & VENTILATION SYSTEM)	BLD'G. "A" AND "B" SMOKE EVACUATION RISER DIAGRAM	New Clark City, Capas, Tarlac	SHEET NO.	M-34			

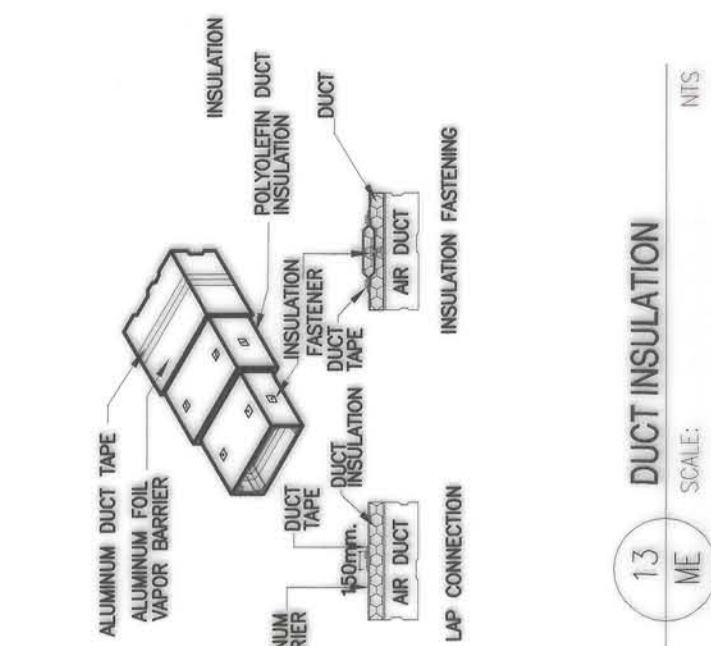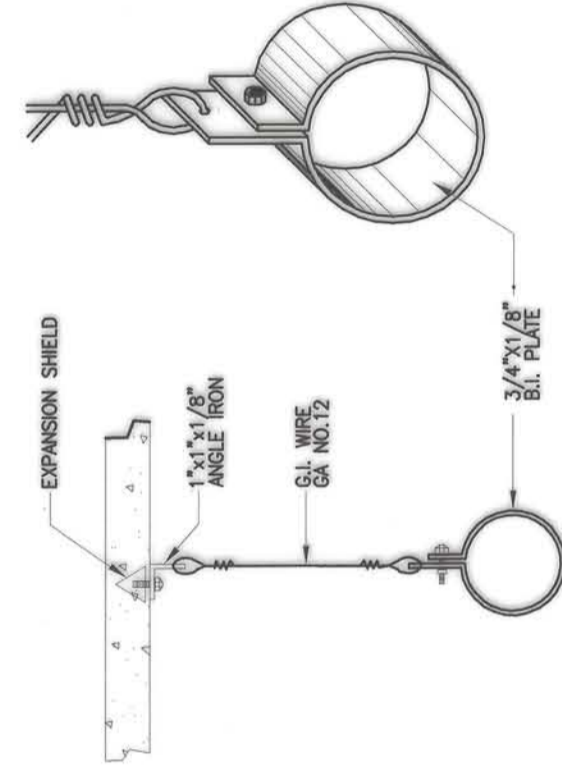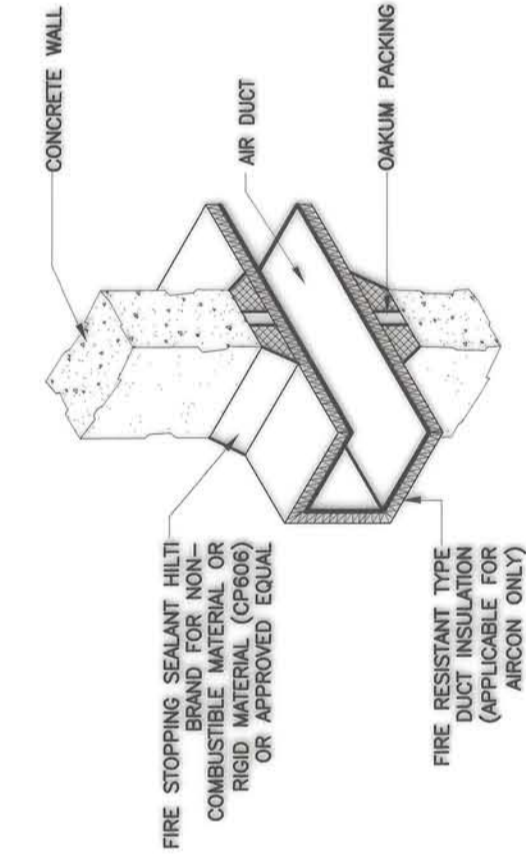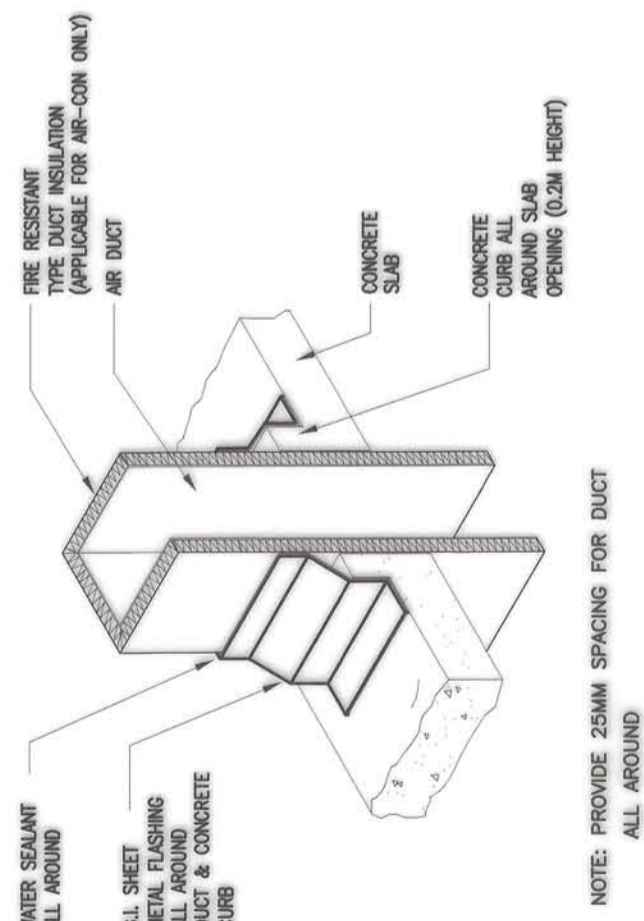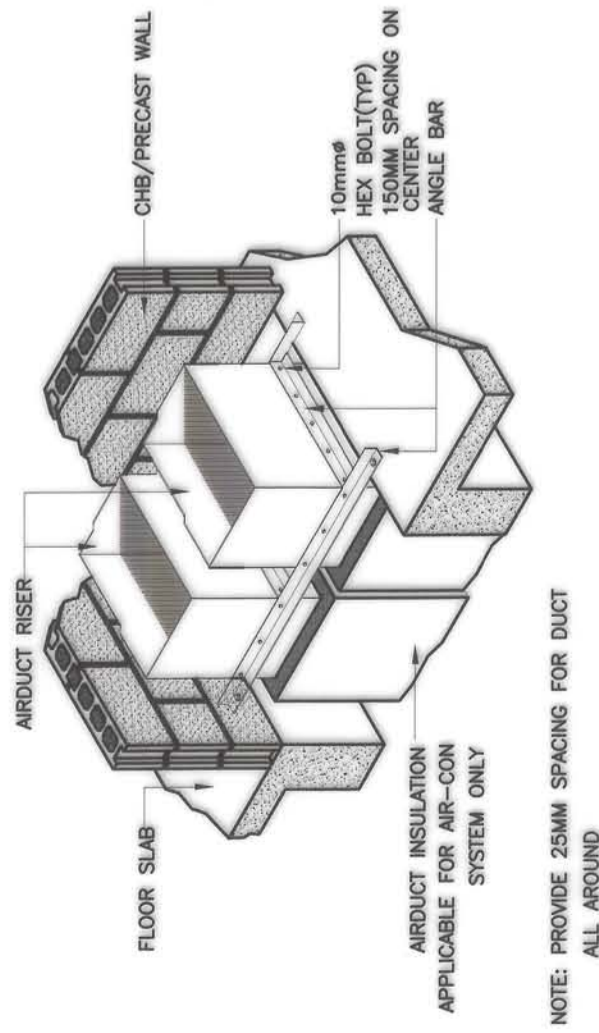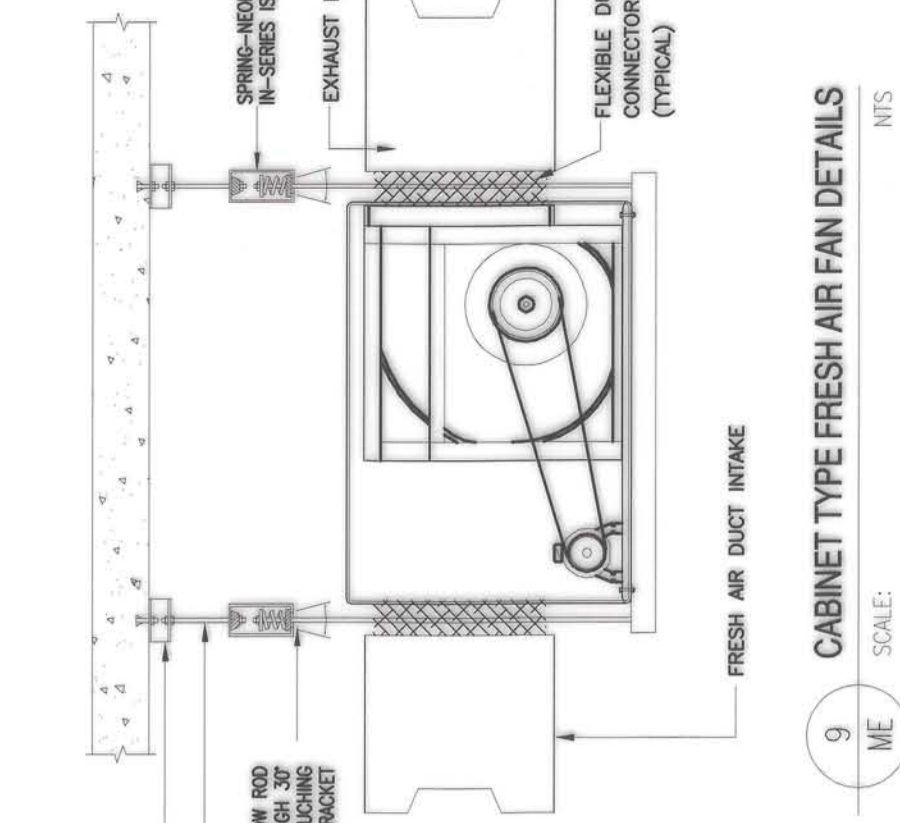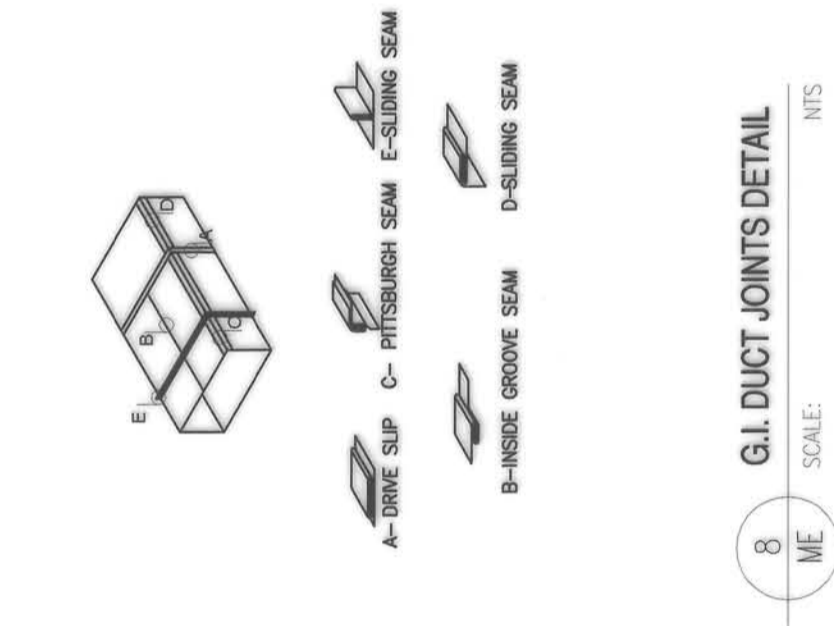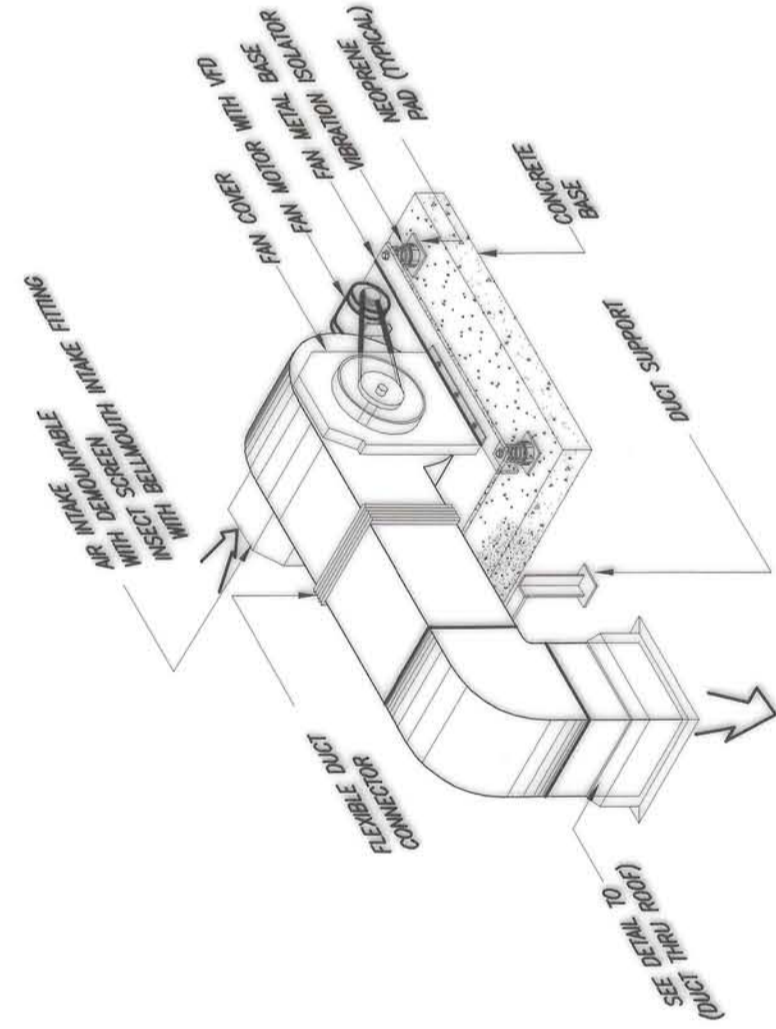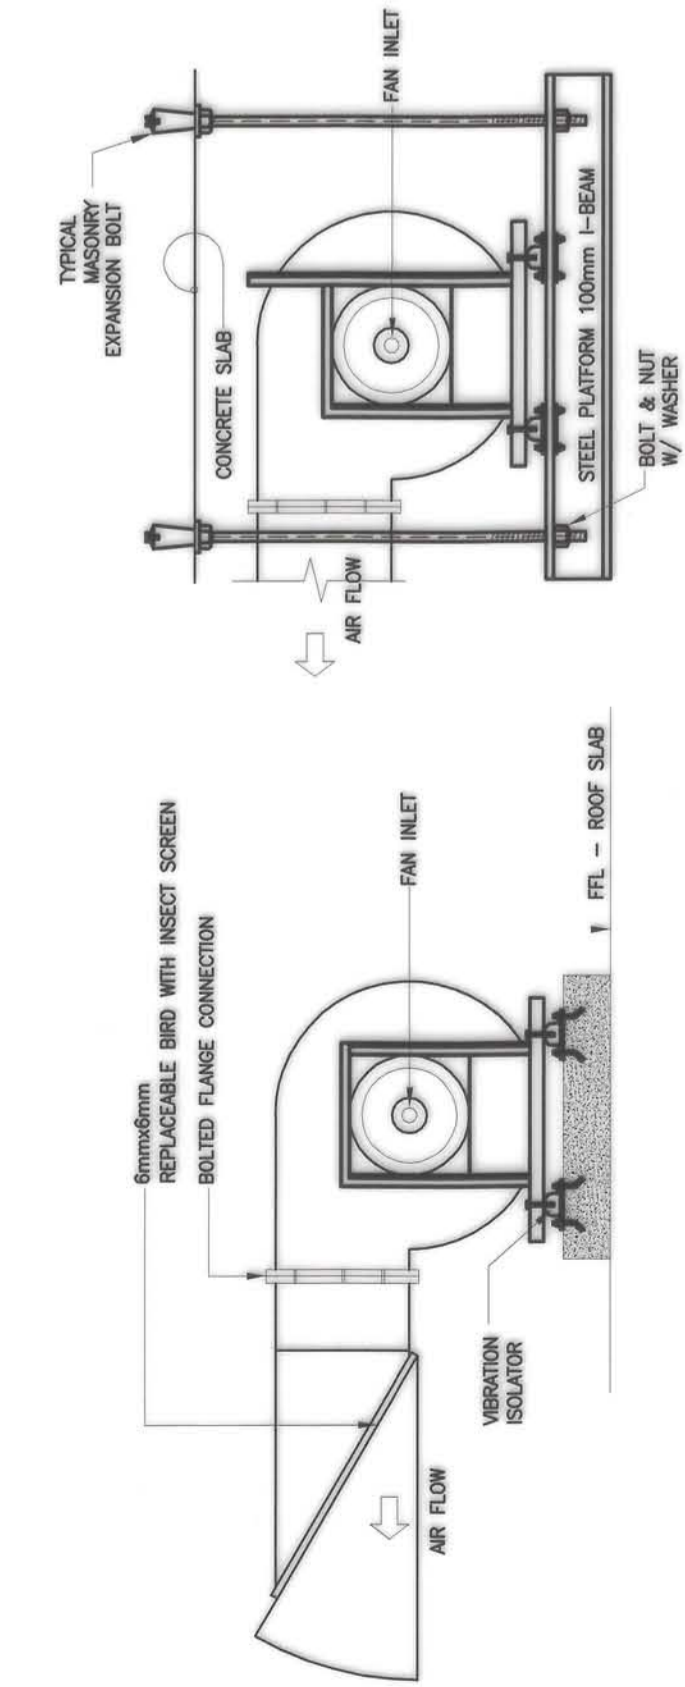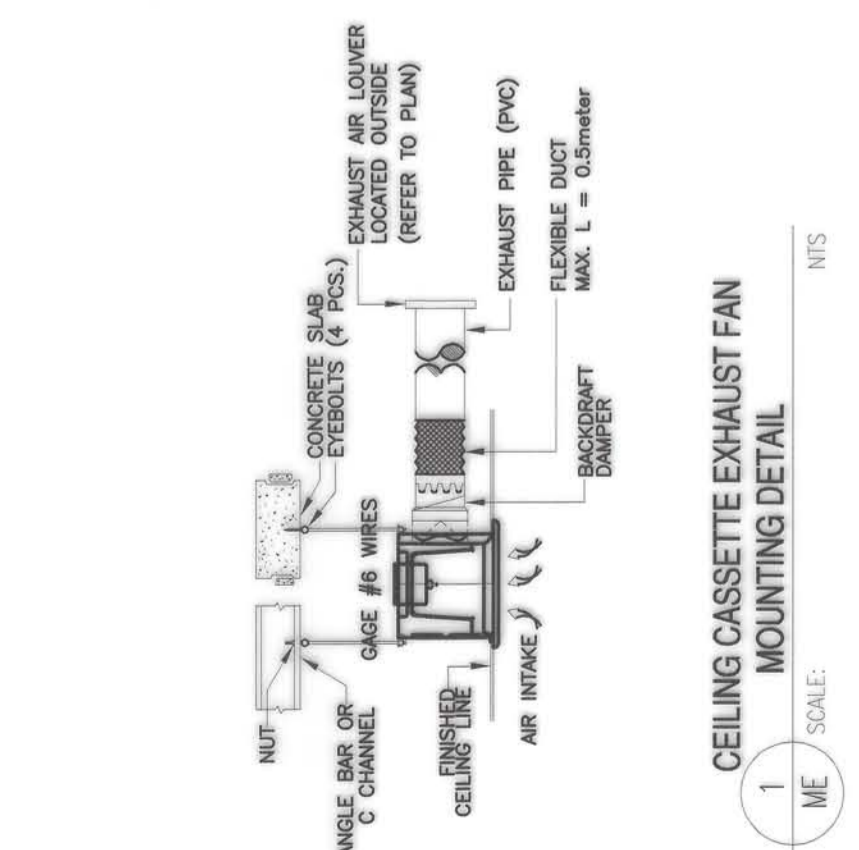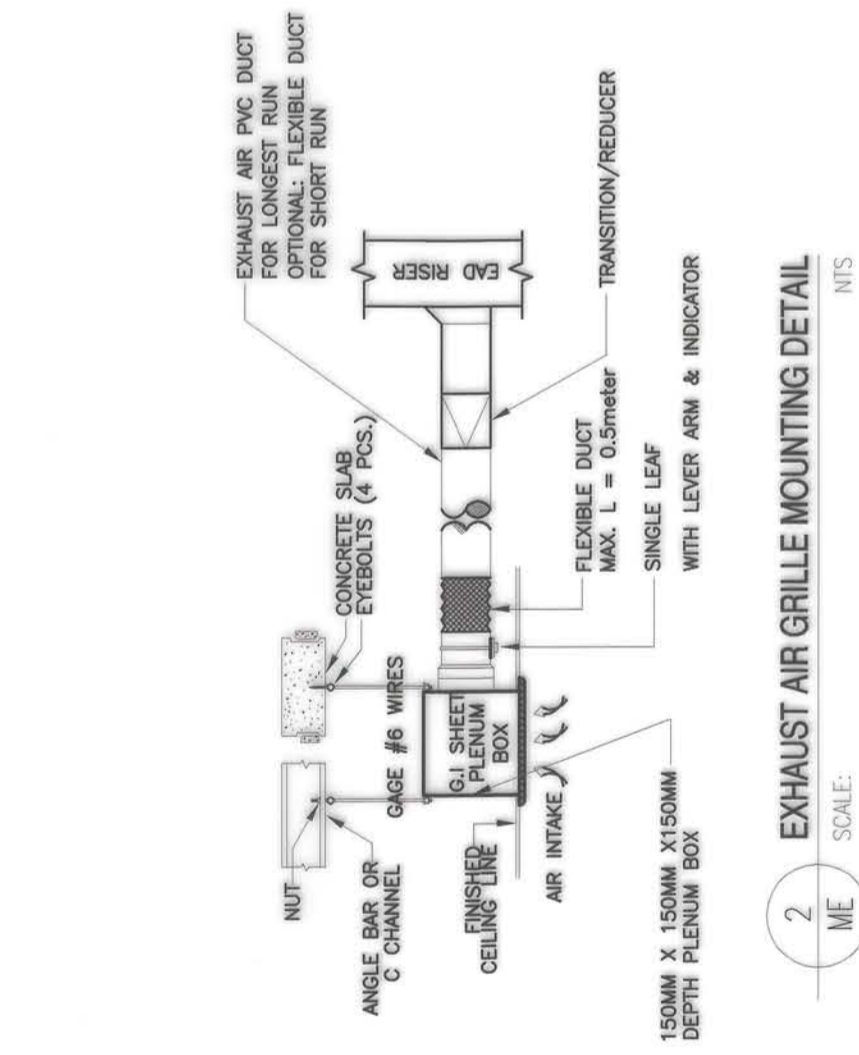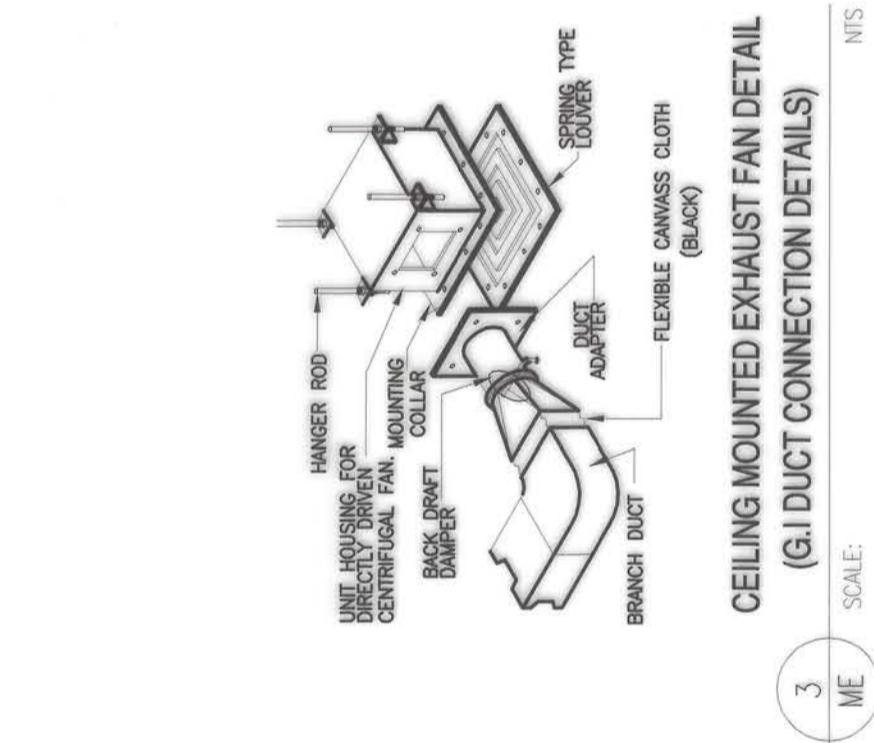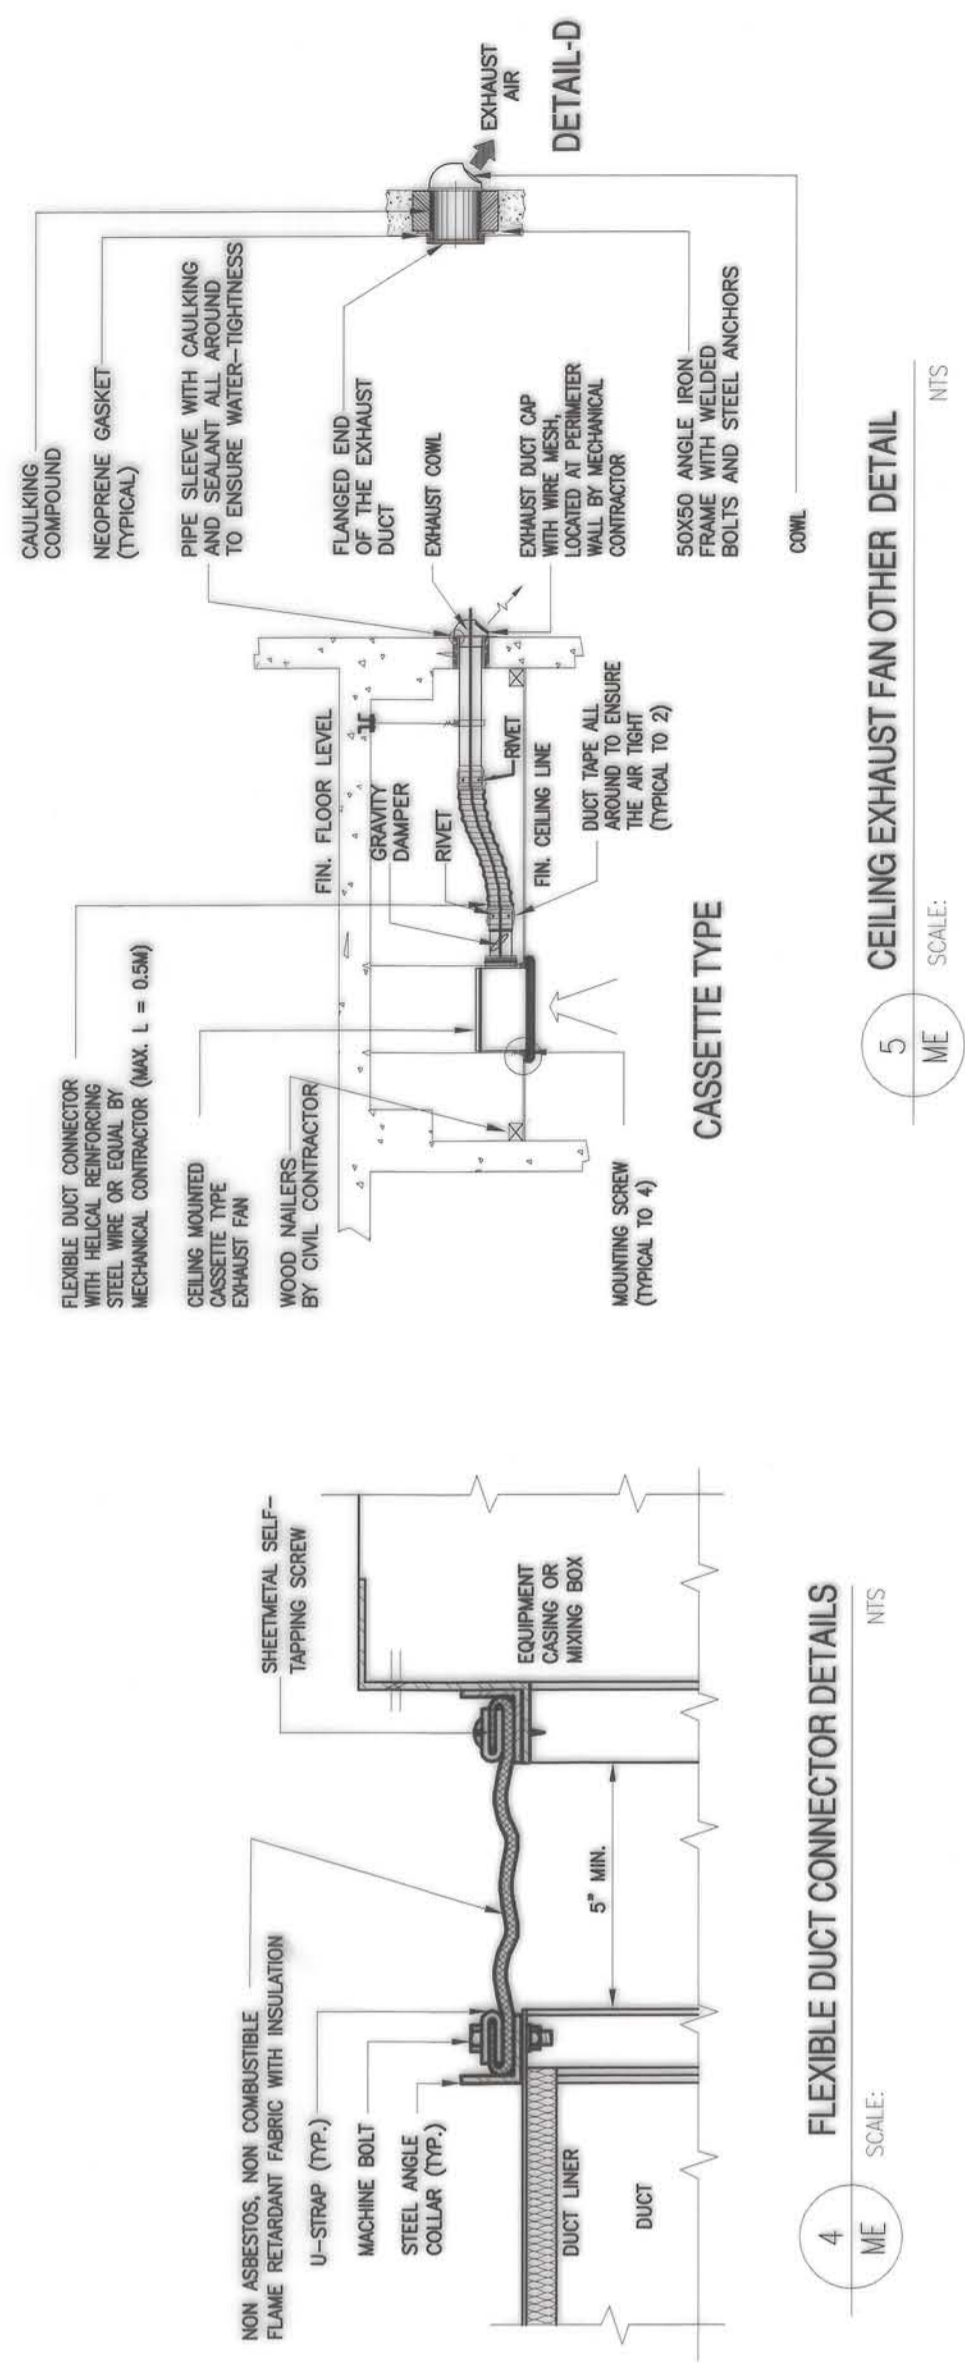

	DOOR SIZE (MM)	NO. HINGES	NO. LOCKS	METAL GAGE		
				FRAME (MM)	DOOR (MM)	BACK (MM)
500 Pa STATIC AND LESS	350 X 350	2	1-S	0.85	0.95	0.55
	408 X 508	2	2-S	0.70	0.70	0.55
	610 X 610	3	2-S	0.85	0.85	0.55
	610 X 610	3	1-S	0.85	0.85	0.55
750 Pa STATIC	350 X 350	2	1-S, T-1-B	1.00	1.00	0.55
	408 X 508	2	2-S, T-1-B	1.00	1.00	0.70
	610 X 610	3	2-S, T-1-B	1.00	1.00	0.70
	610 X 610	3	1-S, T-1-B	1.00	1.00	0.55
1000 Pa AND 2000 Pa	350 X 350	2	1-S, T-1-B	1.00	1.00	0.55
	408 X 508	3	2-S, T-1-B	1.00	1.00	0.70
	610 X 610	3	2-S, T-1-B	1.00	1.00	0.70
	610 X 610	3	2-S, T-2-B	1.31	1.31	0.70


S = SIDE OPPOSITE HINGES, T = TOP, B = BOTTOM

NOTE : CONSTRUCTION AND AIRTIGHTNESS MUST BE SUITABLE FOR THE DUCT PRESSURE CLASS USED.

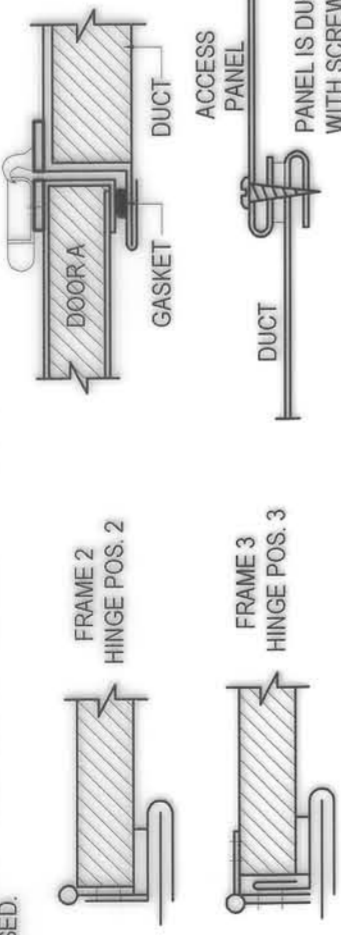

17 DUCT ACCESS DOORS AND PANELS DETAIL

NTS

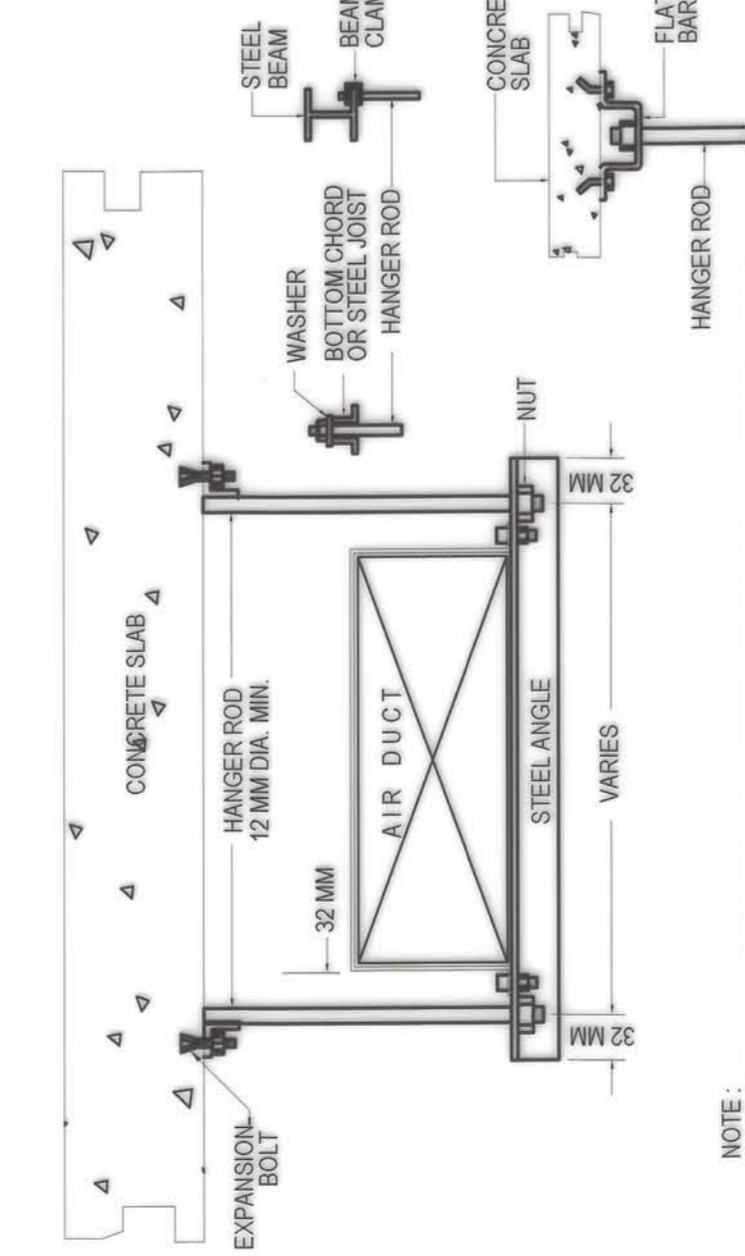


**NOTE:**

1. FOR A/C & VENTILATION, MAX HANGER SPACING SHALL BE 1500 MM. PROVIDE 32X32X4MM STL ANGLE DUCT SUPPORT. FOR KITCHEN EXHAUST, MAX SPACING SHALL BE 1000 MM. PROVIDE 50X50X6 MM STL ANGLE DUCT SUPPORT.
2. ANGLE BAR SUPPORT SHALL CONFORM WITH SMACNA 5TH EDITION, TABLE 5-3.
3. HANGER ROD SHALL CONFORM WITH SMACNA 5TH EDITION, TABLE 5-1.


### DUCT HANGER DETAIL

NTC

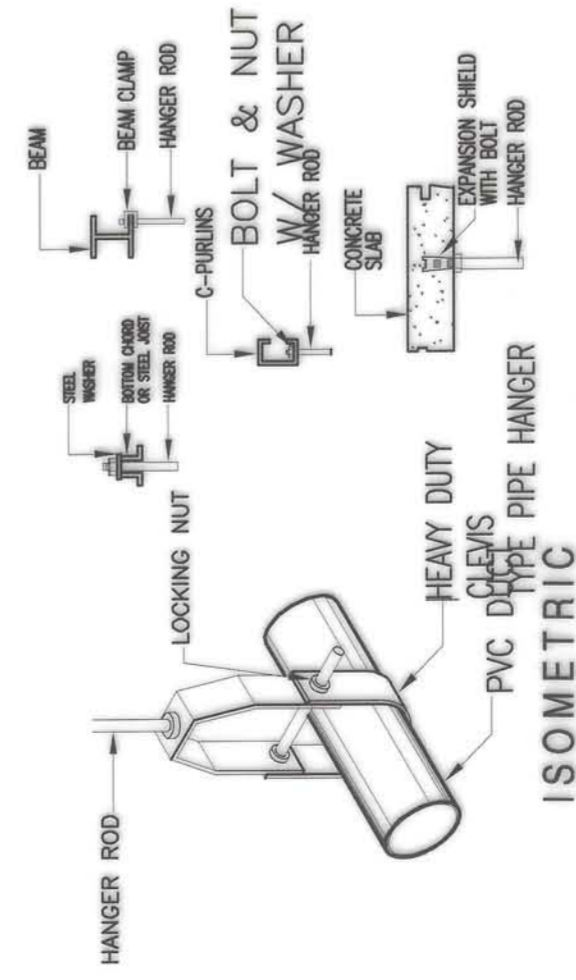


24 SPIRAL DUCT HANGER DETAIL

NTS

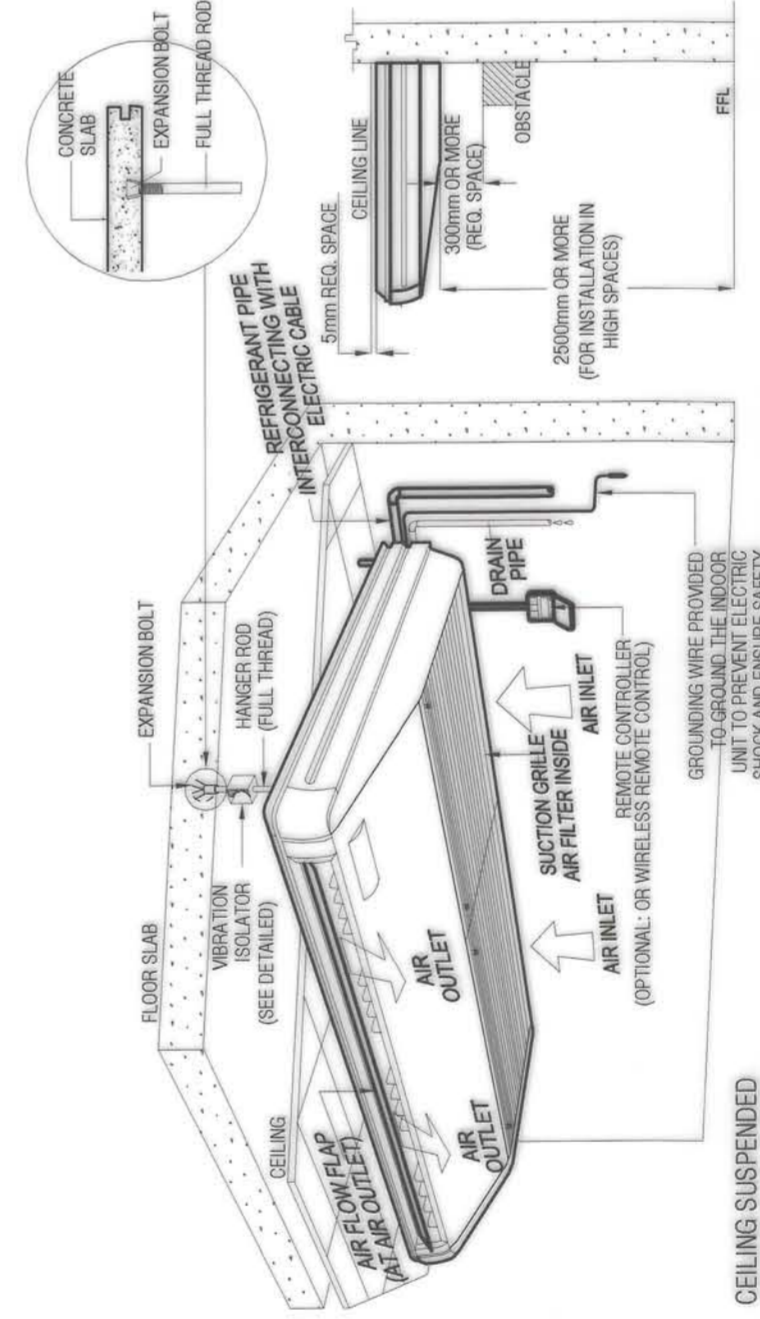


## 25 FAN COIL UNIT MOUNTING DETAILS

NTS

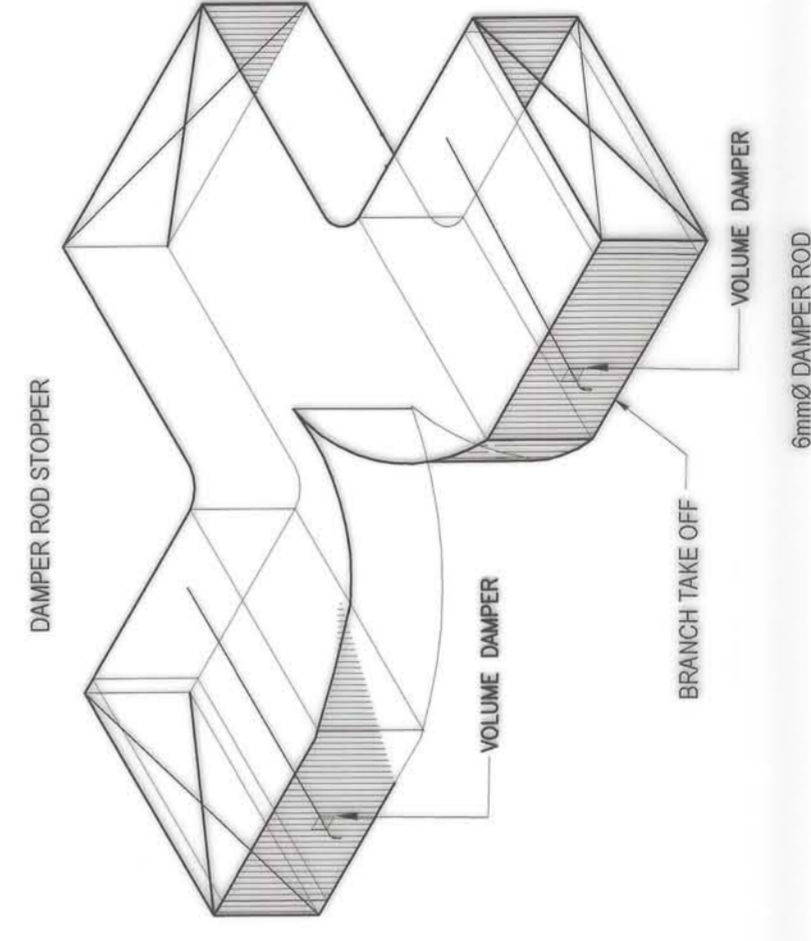



BRANCH TAKE OFF DETAIL

NTS

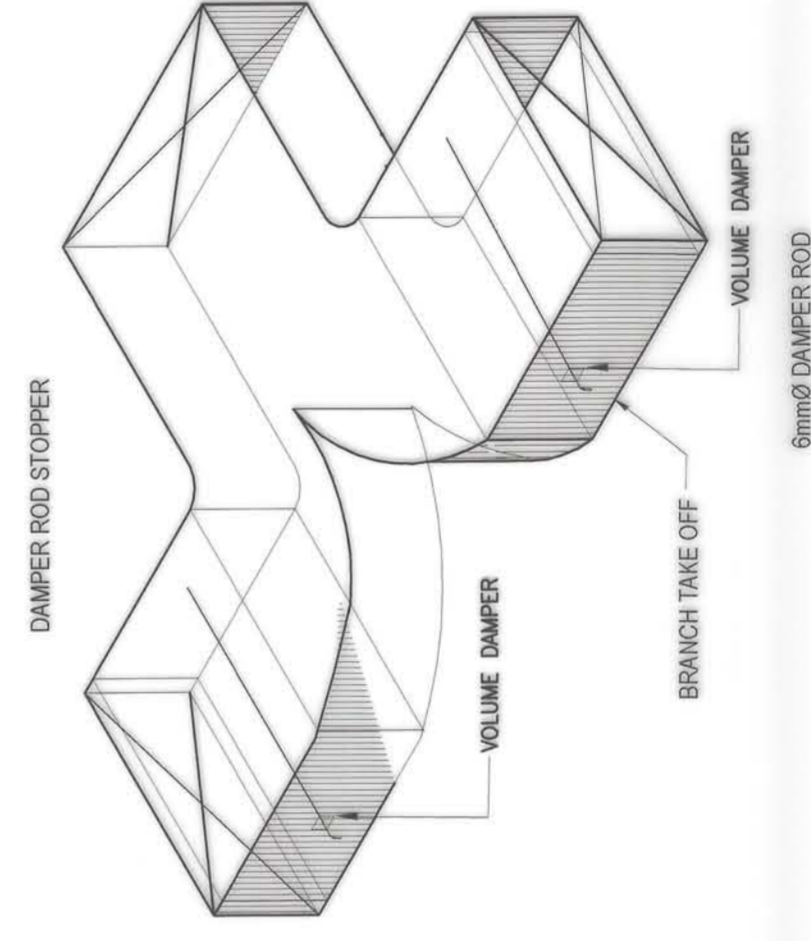


LOUVER MOUNT TO WALL DETAIL

NTS

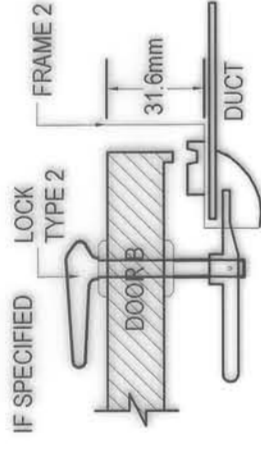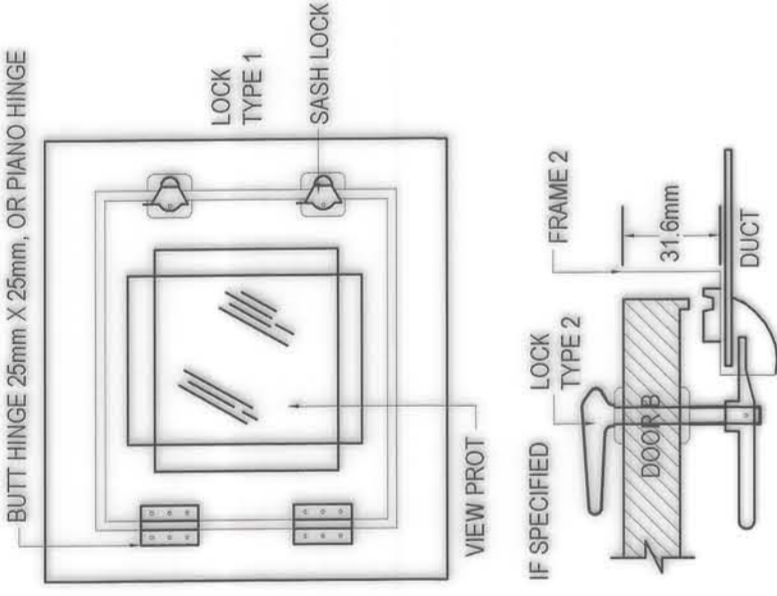


18 TYPICAL RISER DUCT CONNECTIONS

NTS

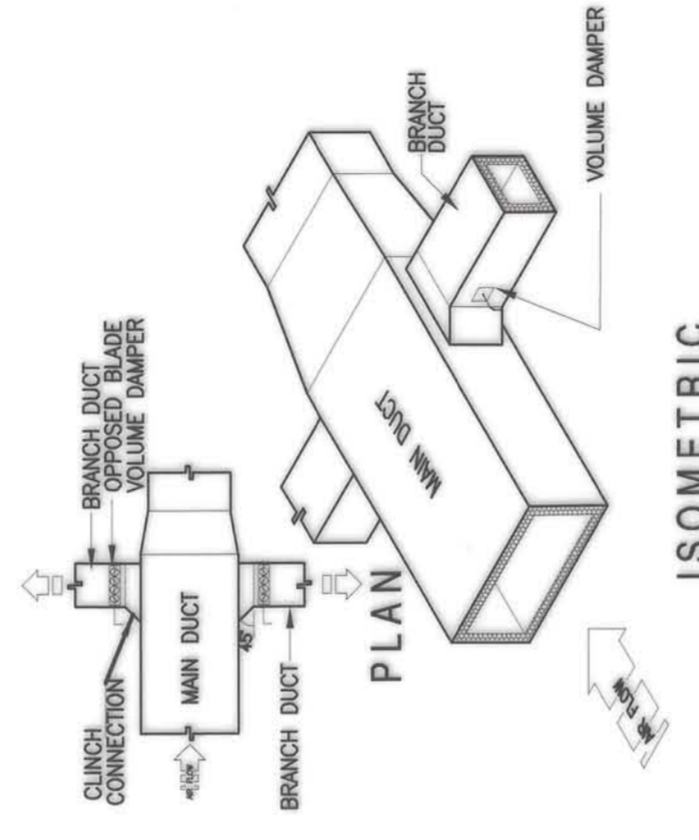


22 TYPICAL BRANCH DUCT TAKE-OFF

NTS

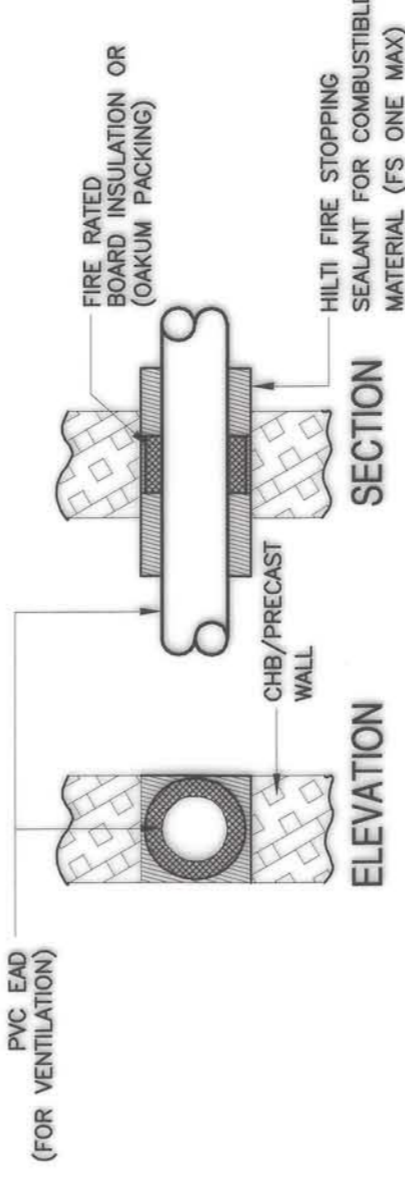

### PVC PIPE THRU WALL DETAIL

NTS:

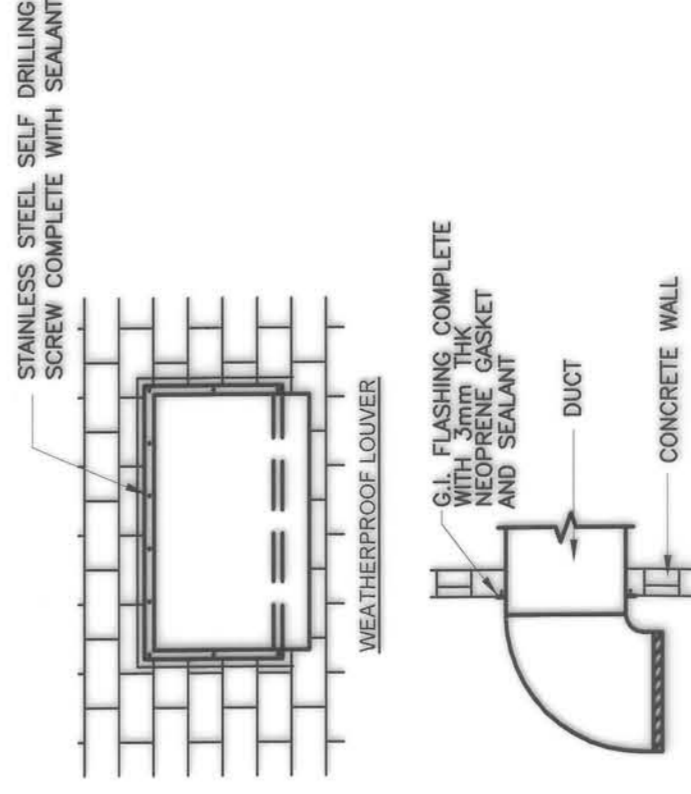


## 9 APPLICATION METHOD FOR DUCT INSULATION

NTS

LEGEND:

1. SHEET METAL DUCT SEALANT
2. 24 GAGE (MIN.) G.I. ASTM 653 DUCT SHEET METAL
3. INSULATION ADHESIVE (NO AIR GAPS)
4. DUCT INSULATION
5. SHEET METAL STRAPS 1m SPACING

OWNER :	NSGAC PHASE I JV COMPANY	PREPARED BY:	 <b>FREY-FIL CORPORATION</b> MANILA • CAVARAO • CEBU • LILOLO Tel. nos. 333-3456 www.frey-fil.com	SOILO S. DELA CRUZ VICE PRESIDENT-OPERATION REG. NO.: 002867 PTR. NO.: 8116498 TIN NO.: 118-408-274 PLACE: MANILA DATE: 01-20-2019	REVIEWED AND VALIDATED BY:	 <b>FILIPINAS DRAVO CORPORATION</b> Architectural & Engineering Consultants 11th Floor, 1115 S. Alameda St., Suite 1115, San Francisco, CA 94103-1115 Tel. nos. 415-774-2200 Fax. nos. 415-774-2201 www.filipinasdravo.com	SUBMITTED BY:	 <b>BANDAR HEBAT BUILDERS, INC.</b>  ISAAC S. DAVID PRESIDENT	CERTIFIED BY:	 <b>TCGI ENGINEERS</b> 4000 P.O. Box 1000, 1001 S. Alameda St., 10th Floor, San Francisco, CA 94103-1000 Tel. nos. 415-774-2200 Fax. nos. 415-774-2201 www.tcgiengineers.com	PROJECT TITLE:	<b>AS-BUILT DRAWING</b> NGAC PHASE 1A ATHLETES VILLAGE (AIR CONDITIONING & VENTILATION SYSTEM) New Clark City, Capas, Tarlac	SHEET CONTENTS:	MISCELLANEOUS DETAILS 02	SHEET NO.:	M-36
---------	--------------------------	--------------	--	--	----------------------------	--	---------------	---	---------------	---	----------------	--	-----------------	--------------------------	------------	------

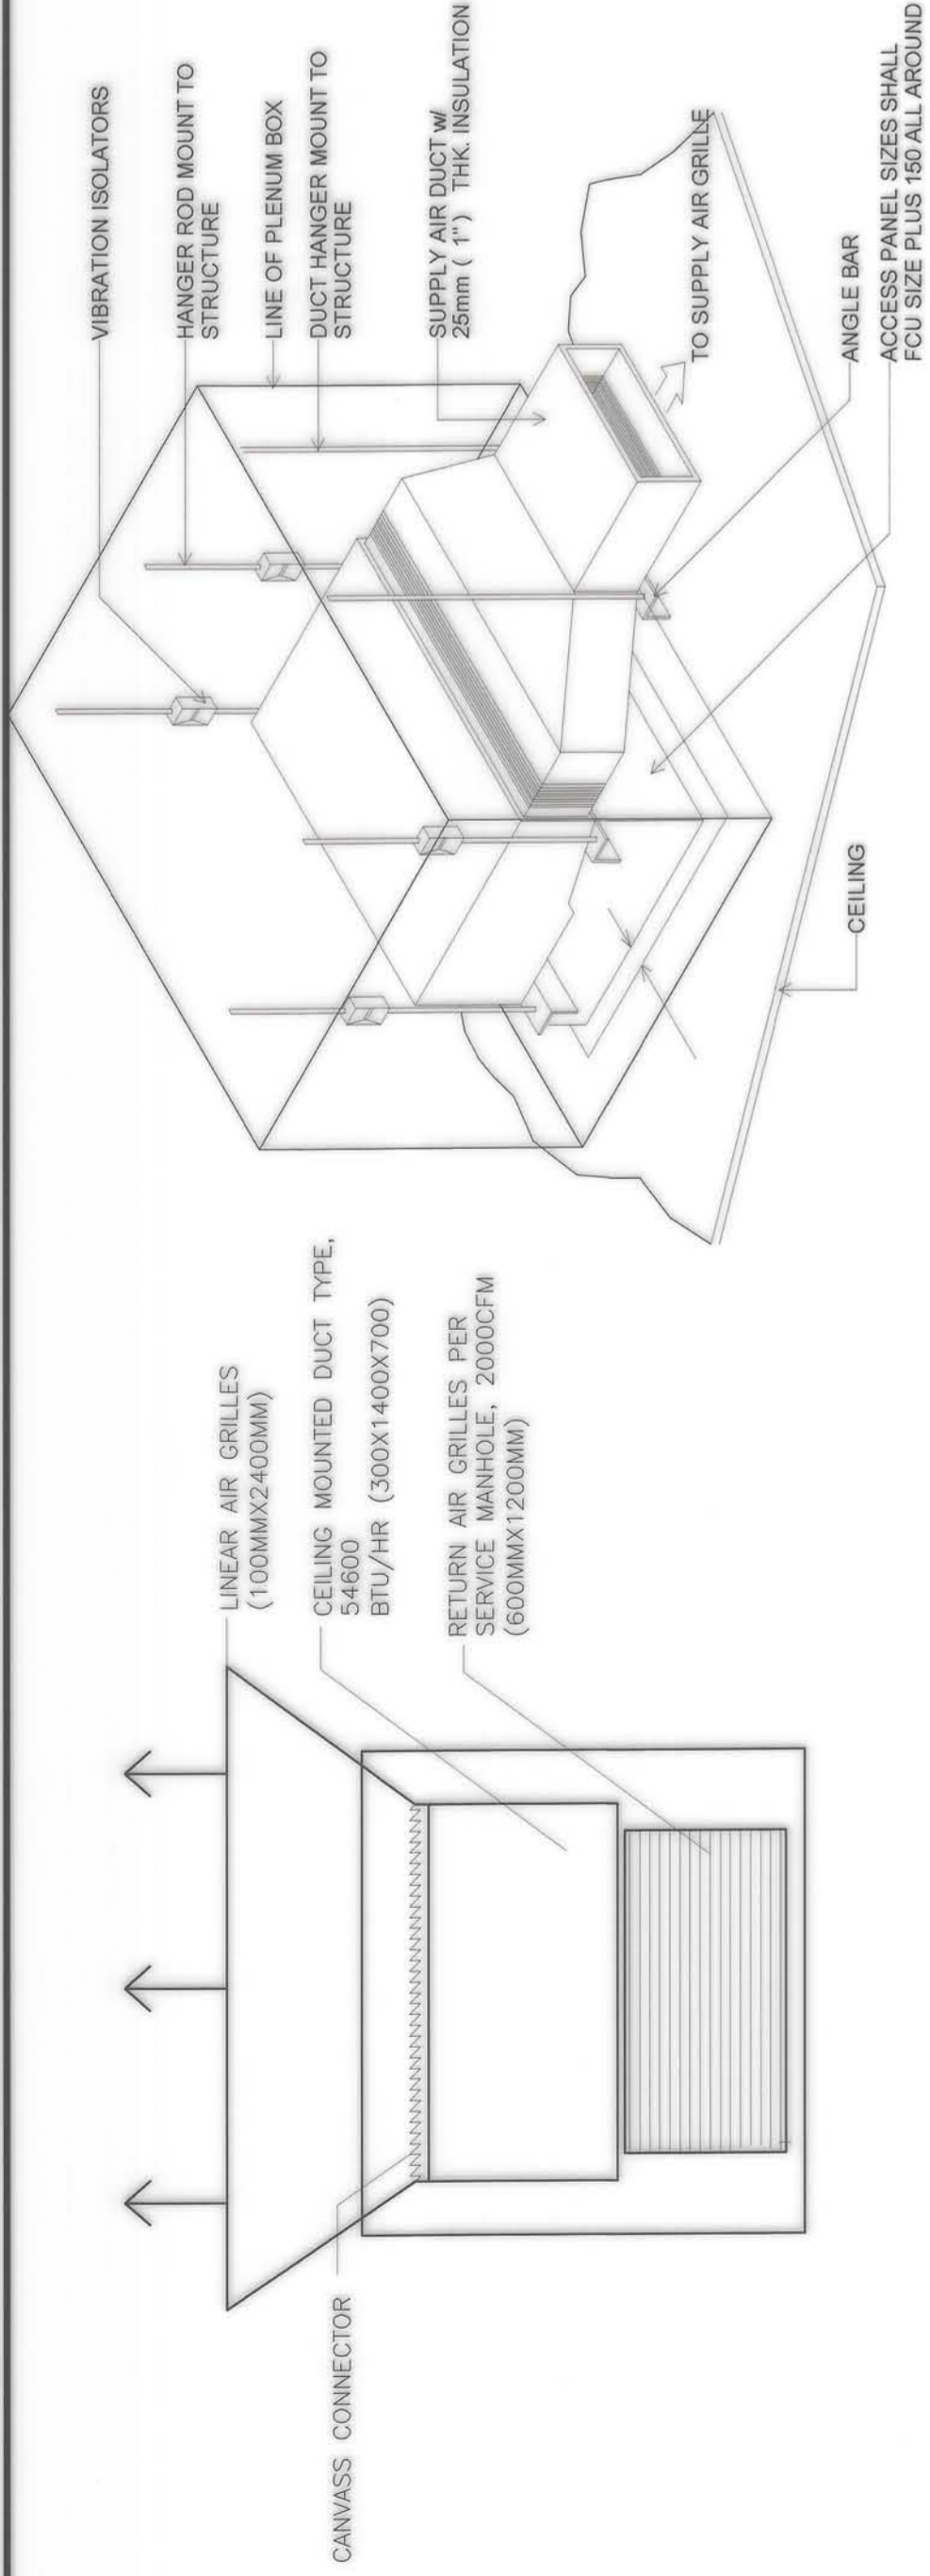

FAN COIL UNIT PLENUM BOX DETAIL


ME

ME

FAN COIL MOUNTING UNIT DETAIL

ME


ME

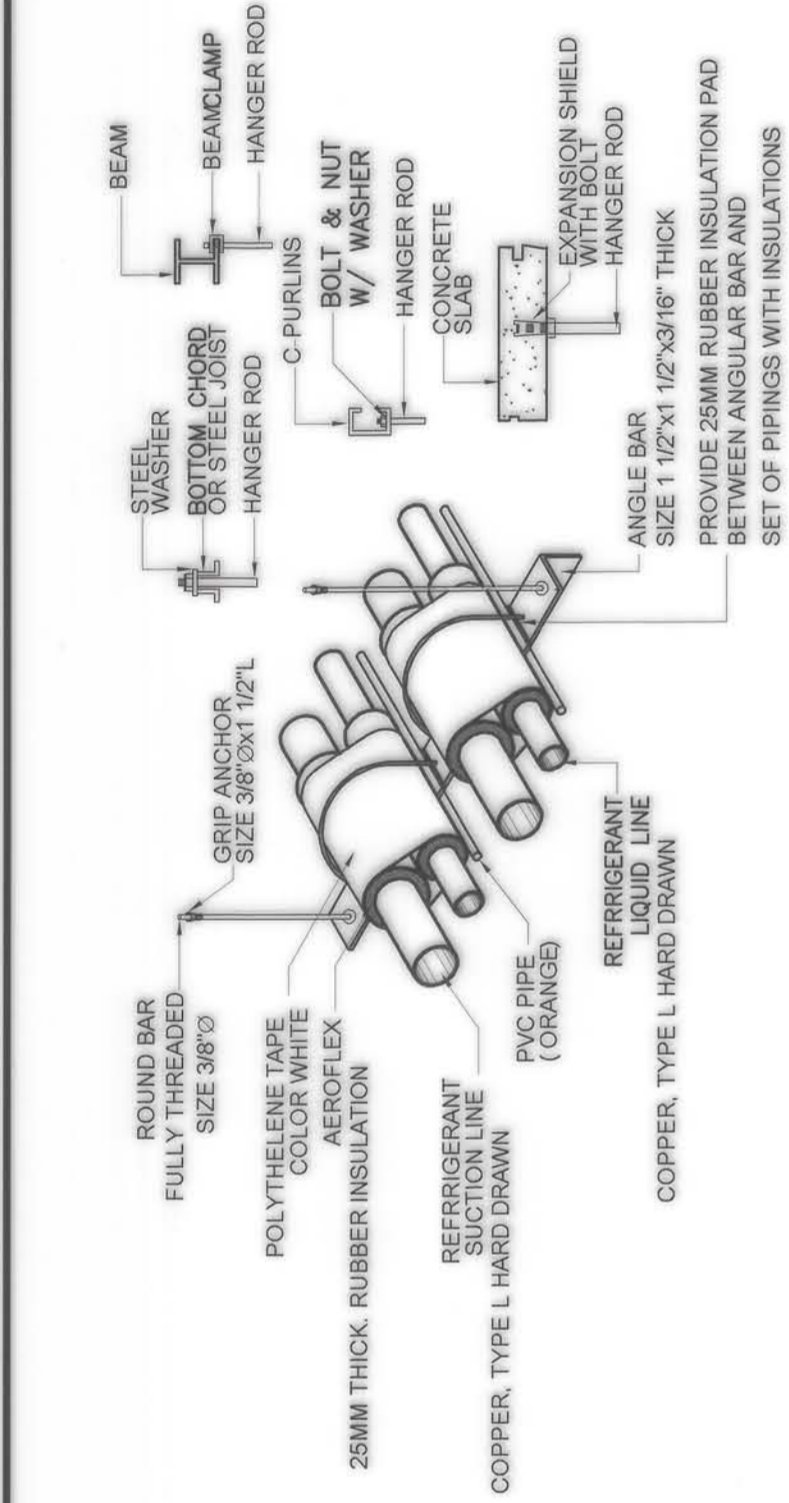

DETAIL OF HANGERS, REFRIGERANT PIPE AND RUBBER INSULATION

ME

ME

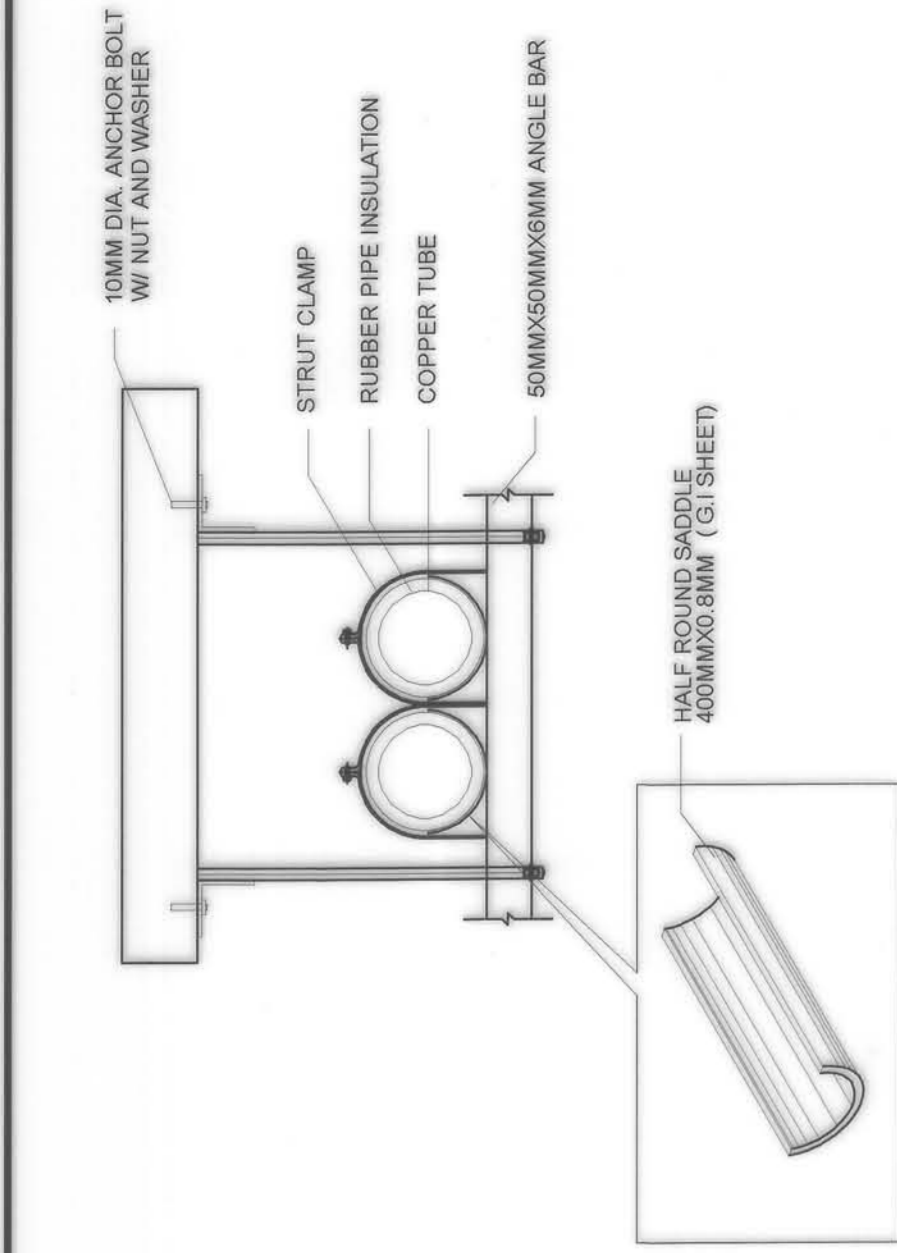


OTHER DETAILED INSTALLATION OF REFRIGERANT PIPE AND INSULATION

ME


ME

SCHEDULE OF DUCT GAGE AND HANGERS

DIMENSION LONGITUDINAL (mm)	G1 SHEET No.	SIZE OF ANGLE (mm)	DISTANCE BETWEEN HANGERS (mm)	MIN SIZE OF HANGER (mm)
UP TO 300	26	25 x 25 x 3	1000	10
325 TO 750	24	38 x 38 x 5	1000	12
750 TO 1500	22	38 x 38 x 5	2000	12
1500 TO 2285	20	38 x 38 x 5	2000	12
2310 UP	18	38 x 38 x 5	2000	12

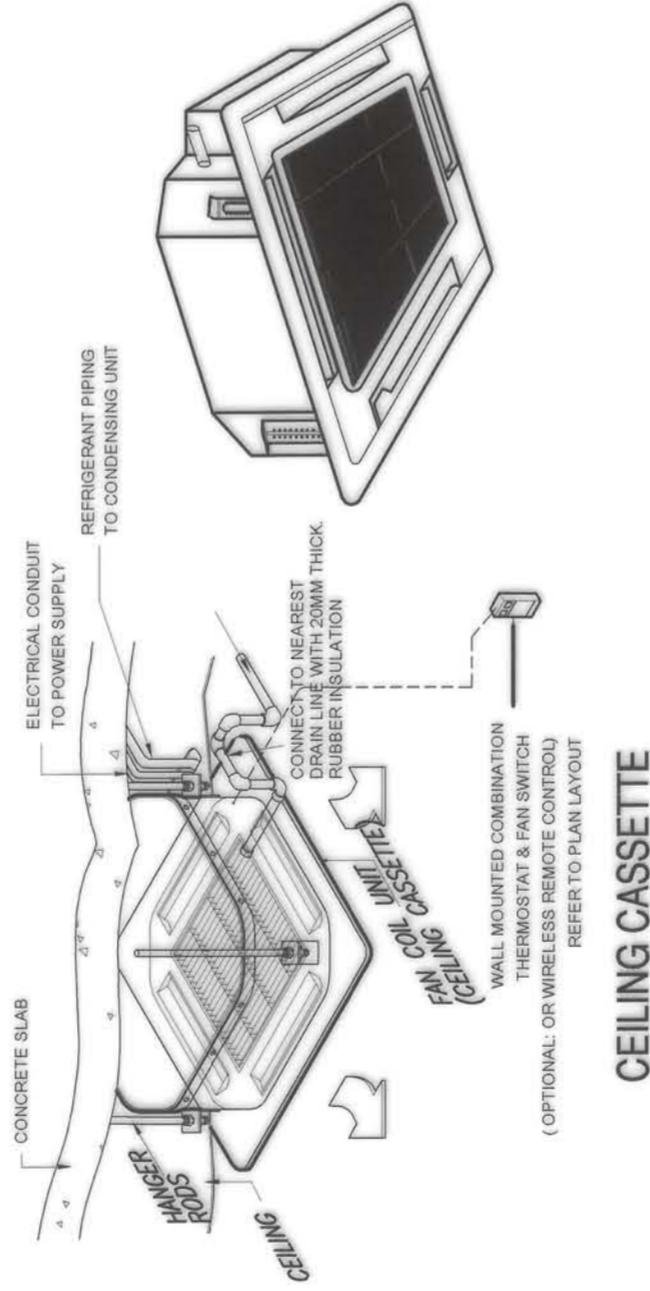

CEILING CASSETTE

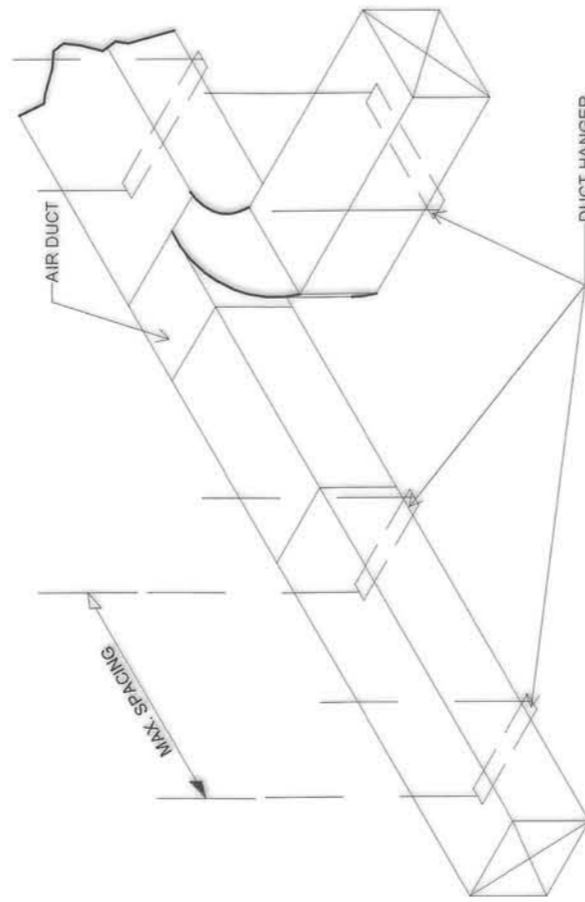

DUCT SCHEDULE AND NOTES


ME

ME

DETAILED INSTALLATION OF CASSETTE UNIT

ME

ME

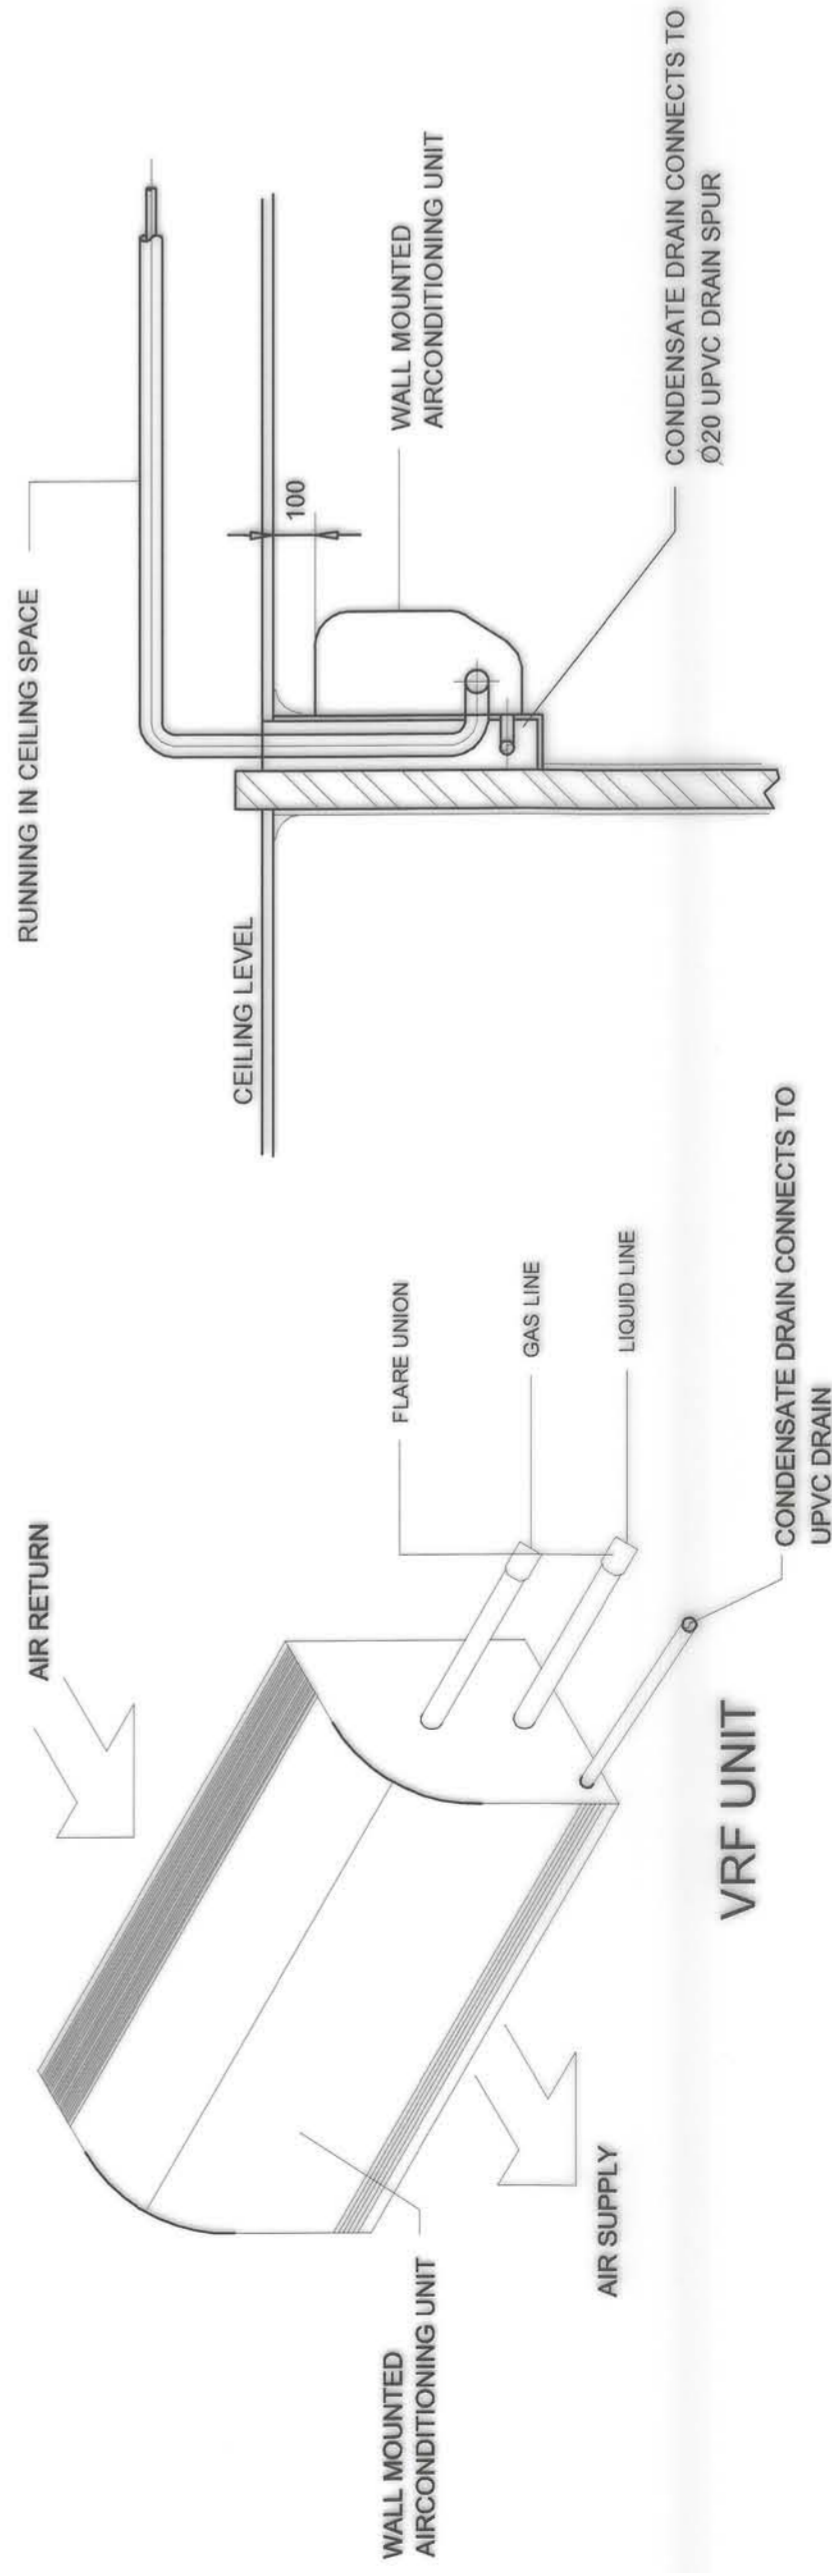

PIPING HOOK-UP DETAIL FOR FCUs AND COOLING COILS


ME

ME

REFRIGERANT PIPE RISER DETAIL

ME


ME

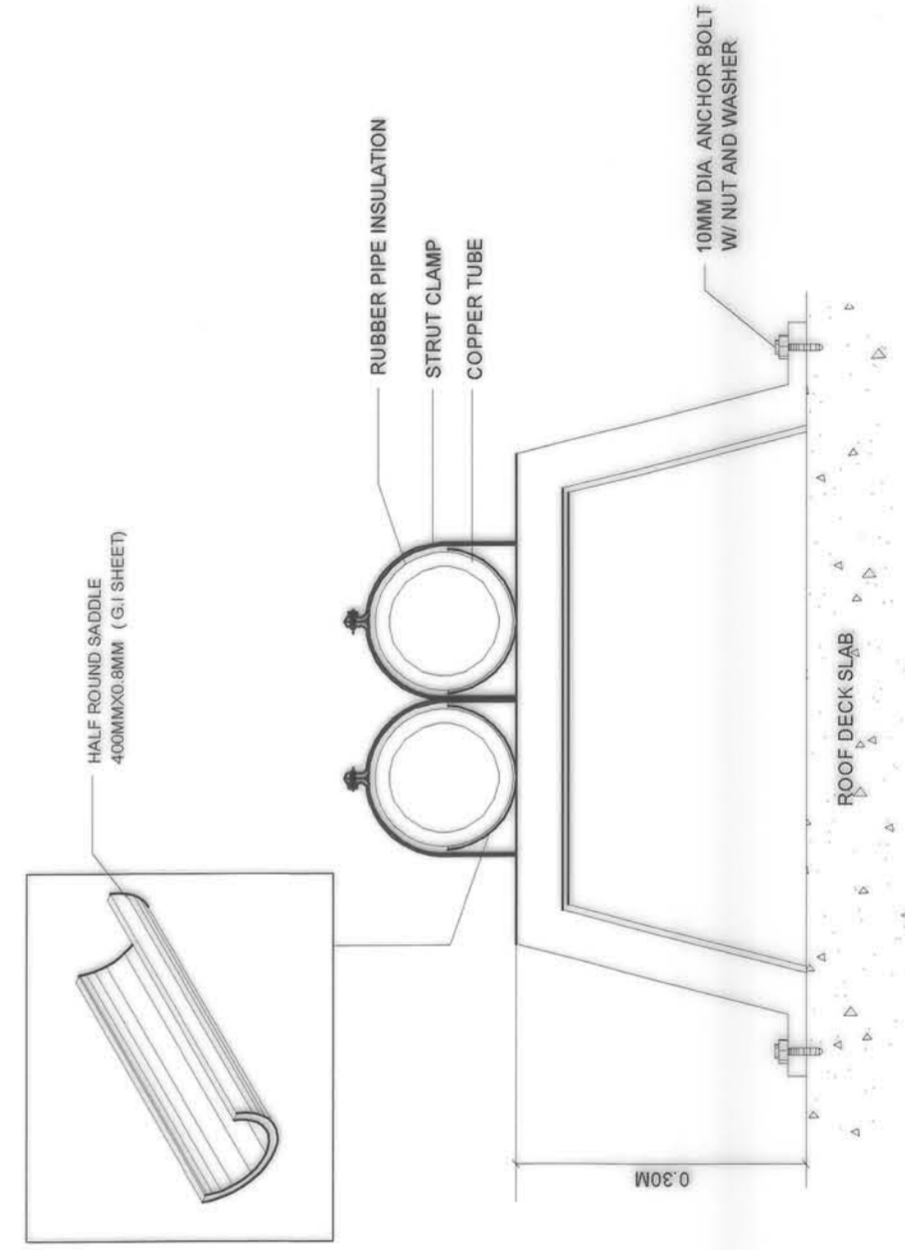

DETAIL OF SECONDARY SAFETY DRIP TRAY

ME

ME

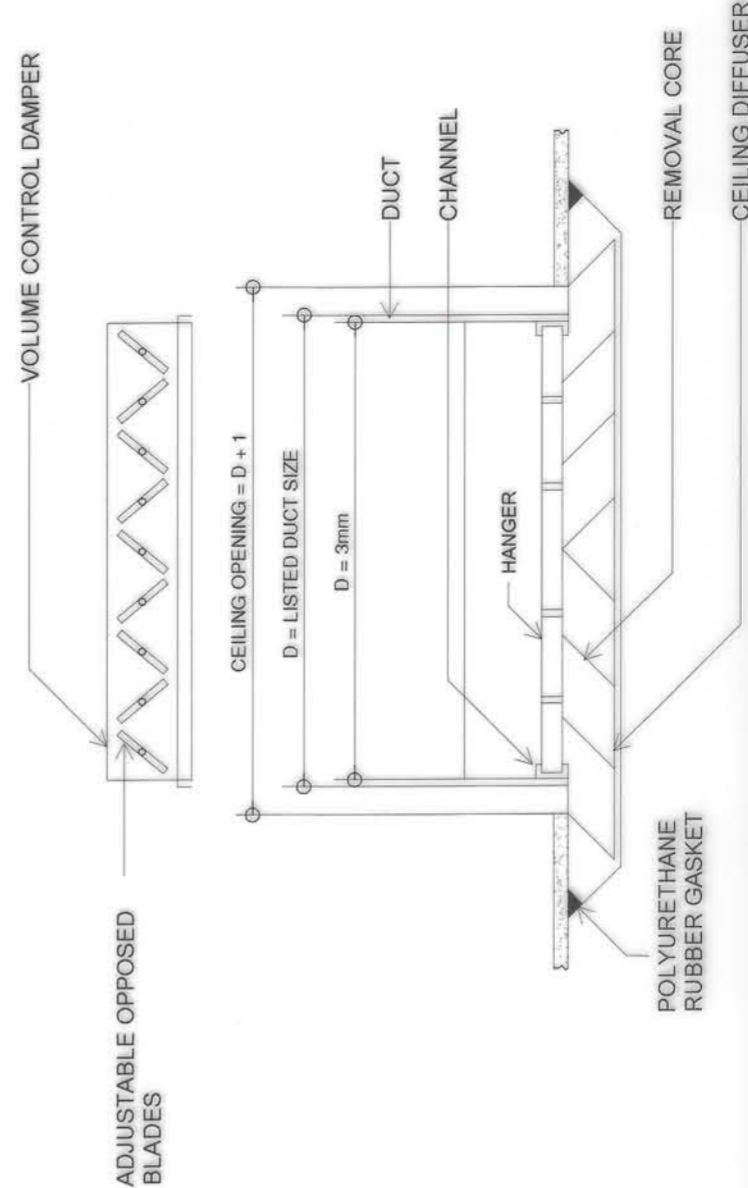

V. DIFFUSER DETAIL

DETAILED INSTALLATION OF ROOF DECK REFRIGERANT PIPE AND INSULATION

ME

ME

DETAILED INSTALLATION OF ROOF DECK REFRIGERANT PIPE AND INSULATION

ME

ME

OWNER : NGAC PHASE 1 JV COMPANY

AND

BCDA

WENCIO B. DION

PATRICK NICHOLAS P. DAVID

PRESIDENT

REVIEWED AND VALIDATED BY:

FILIPINAS DRAVO CORPORATION

Architectural & Engineering Consultants

ALFREDO B. REVILLA

PROJECT MANAGER

PREPARED BY:

FREY-FIL CORPORATION

REG. No.: 002-897 PTR No.: 816986

TIN No.: 116-465-274 PLACE: MANILA

DATE: 01-20-2018

SUBMITTED BY:

BANDAR HEBAT BUILDERS, INC.

ISAAC S. DAVID

PRESIDENT

CERTIFIED BY:

TCGI ENGINEERS

NGAC PHASE 1A

ATHLETES VILLAGE

(AIR CONDITIONING & VENTILATION SYSTEM)

VIRGILIO A. MADRAZO

PRESIDENT/CEO

PROJECT TITLE:

AS-BUILT DRAWING

NGAC PHASE 1A

ATHLETES VILLAGE

(AIR CONDITIONING & VENTILATION SYSTEM)

New Clark City, Capas, Tarlac

SHEET CONTENTS:

MISCELLANEOUS DETAILS 03

M-37

